



JZ
STRUCTURAL CONSULTING, INC.

43130 Amberwood Plaza
Suite 235
Chantilly, VA 20152
PH. (703) 327-9612
FAX (703) 327-8265

67 V Street, NW
Washington, DC

STRUCTURAL FRAMING

Job #

Date: Issue:


02/16/2015

REVISION

04/14/2015 REVIEW COMMENTS



Drawn: JZ
Checked: JZ
Scale: AS NOTED
Sheet Title: FOUNDATION & 1ST FLOOR FRAMING PLANS
© JZ 2015
ALL RIGHTS RESERVED
Sheet No.

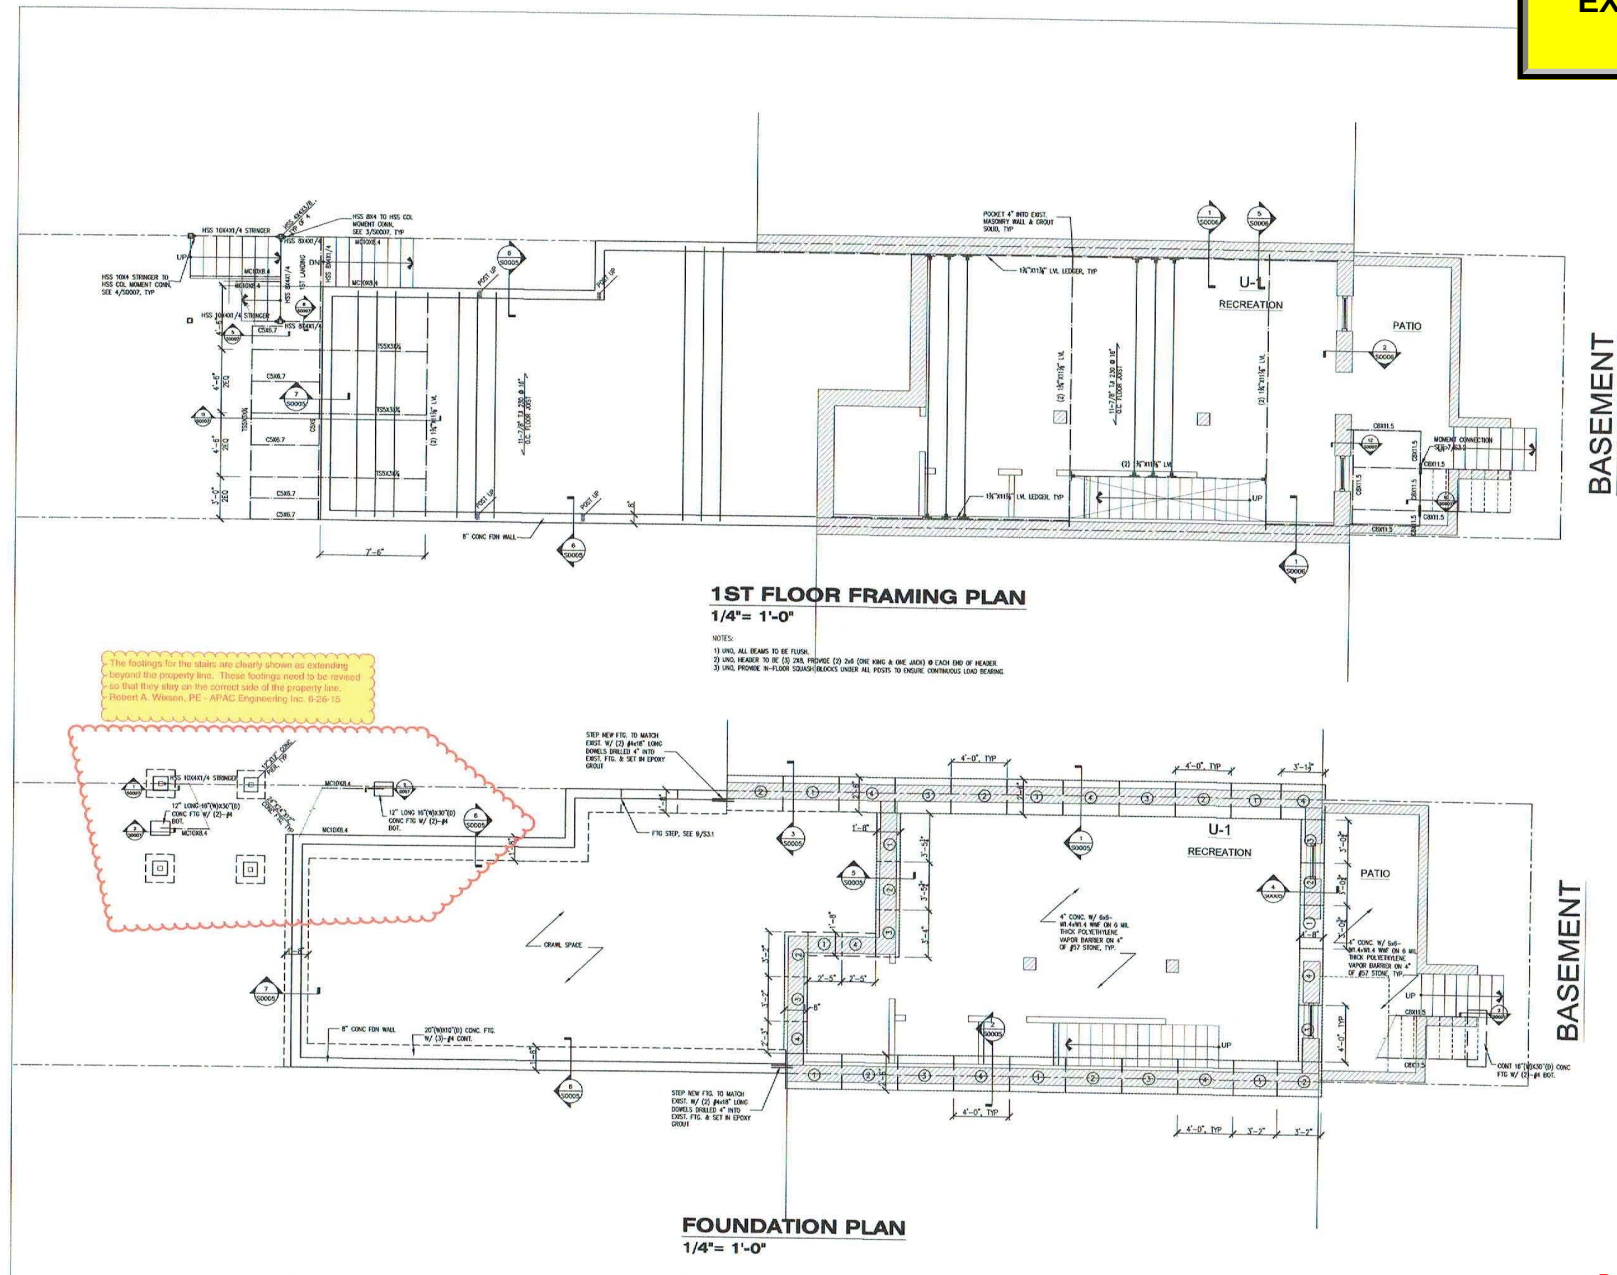

Board of Zoning Adjustments
District of Columbia
CASE NO.19106
EXHIBIT NO.211