

BUILDING PERMIT FOR: ADDITION TO S.F.D.

LIST OF DRAWINGS:

C-0 COVER SHEET
C-1 EROSION CONTROL DETAILS
S- FOUNDATION PLAN
S-2 FOUNDATION DETAILS
A-1 FLOOR PLAN
A-2 FLOOR PLAN
A-3 FLOOR PLAN
A-4 FLOOR PLAN
A-4.1 ELEVATION
A-5 SECTIONS DETAILS
A-5.1 FLOOR FRAMING
A-6 ROOF FRAMING
M-1 MECHANICAL
E-1 ELECTRICAL
P-1 PLUMBING
P-2 PLUMBING

LEGEND:

EXCAVATION QUANTITIES: 60 CUBIC YARDS
AREA OF L.O.D.: 4800 S.F.
VOLUME OF CUT: 65 CUBIC YARDS
VOLUME OF FILL: 55 CUBIC YARDS

----- L.O.D.

-5---5- SILT FENCE

S.C.E. STABILIZED CONSTRUCTION
ENTRANCE

----- EXISTING CONTOURS
----- PROPOSED CONTOURS

1233 MORSE STREET, NE SQUARE 4069 LOT WASHINGTON, DC 20002

ZONING ANALYSIS:

LOT AREA: 1863 S.F. (LOT 0816)
ADDED LOTS PER SUB:
1602 S.F. (LOT 0812)
6956 S.F. (LOT 0810)
TOTAL LOT AREA = 10,421 S.F. (LOT 130)

EXIST. S.F.D.
PROPOSED NO. OF UNITS = 11 UNITS
ZONE: R-4

PARKING PROVIDED: 10 SPACES EACH 9'X19'

NEW BUILDING FOOTPRINT = 4031 S.F.
LOT COVERAGE: $4031/10421 = 0.38 = 38\%$
ALLOWABLE: 40%

BOARD OF ZONING ADJUSTMENT
District of Columbia

CASE NO. 17657

EXHIBIT NO. 25

lot 816 (1863 s.f.)

lot 812 (1602 s.f.)

MORSE STREET, NE

A. NOTIFY DC WASA ONE WEEK PRIOR TO START OF CONSTRUCTION. UTILITY INSPECTION @ 202 787 2377
WATER SERVICES 202 787 3624 OF 3629.

B. DEVELOPERS, CONTRACTORS AND PLUMBERS MUST SUBMIT FINAL CONSTRUCTION AS-BUILT INFORMATION TO THE APPROPRIATE DCWASA INSPECTORS FOR REVIEW AND APPROVAL UPON COMPLETION OF NEW AND EXISTING UTILITIES TO BE ABANDONED IN PUBLIC SPACE; APPLICANT MUST SUBMIT THESE DRAWINGS AS BUILT DRAWINGS MUST SHOW DIMENSION, ELEVATION, RELOCATION OF ANY WASA UTILITIES AND PERTINENT INFORMATION.

C. ONCE THE WALK INSPECTOR APPROVES THE AS BUILT DRAWING, A COPY MUST BE SUBMITTED TO THE DOCUMENTS AND PERMITS OFFICE @ ROOM 203 AND THE WATER AND SEWER DESIGN SECTION @ 5000 OVERLOOK AVE, S.W. 5TH FLOOR

UNDER DCWASA CUSTOMER FEES AND CHARGES, CONTRACTORS, PLUMBERS, OWNERS ARE RESPONSIBLE FOR EXCAVATION, BACKFILLING, REPAVING AND RESTORATION OF PUBLIC SPACES FOR STREET AND SIDEWALK CUTS FOR NEW UTILITIES, CONNECTIONS AND TAPS. REMOVALS, ABANDONMENTS OF SERVICES MUST BE PERFORMED BY THE CONTRACTOR, AT THE WATER OR SEWER LINE WITHIN PUBLIC SPACE AND REPAIRED UNDER DC WASA INSPECTION. DC WASA IS NOT RESPONSIBLE FOR FINAL RESTORATION OF STREET AND SIDEWALK CUTS PERFORMED BY THE CONTRACTOR OR DEVELOPERS.

1 SITE PLAN

DCRA / OFFICE OF THE ZONING
ADMINISTRATOR / COMPLIES
WITH REQUIREMENTS OF DC
ZONING REGULATIONS (HDCR 27)

IN PUBLIC FILE

① 9' X 19' ② 9' X 19' ③ 9' X 19' ④ 9' X 19' ⑤ 9' X 19' ⑥ 9' X 19' ⑦ 9' X 19' ⑧ 9' X 19' ⑨ 9' X 19'

S.C.E.

PROPOSED BUILDING
1233 MORSE ST., NE

NEW 2" DOMESTIC LINE COPPER

NEW 2" ERE LINE COPPER

NEW 6" PVC PIPE

WASTE TO SEWER MAN

WASTE TO SEWER MAN


WASTE TO SEWER MAN

WASTE TO SEWER MAN

WASTE TO SEWER MAN

WASTE TO SEWER MAN

OFFICIAL
Inspection Division
District of Columbia

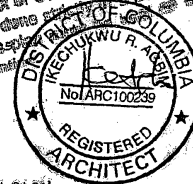

PROPOSED 2" WATER METERS
W/BACKFLOW PREVENTER (2 TYPICAL) 6" WIDE S/W

CONC. CURB

TREE SPACE

EXIST. 12" WATER MAIN


EXISTING 18" SEWER MAIN

CONNECTION INVERT ELEVATION 60.05'



MORSE STREET, NE

Board of Zoning Adjustment
District of Columbia
CASE NO. 17657
EXHIBIT NO. 25



C BUILDING PERMIT:
1233 MORSE STREET, NE
SQUARE 4069, LOT 130

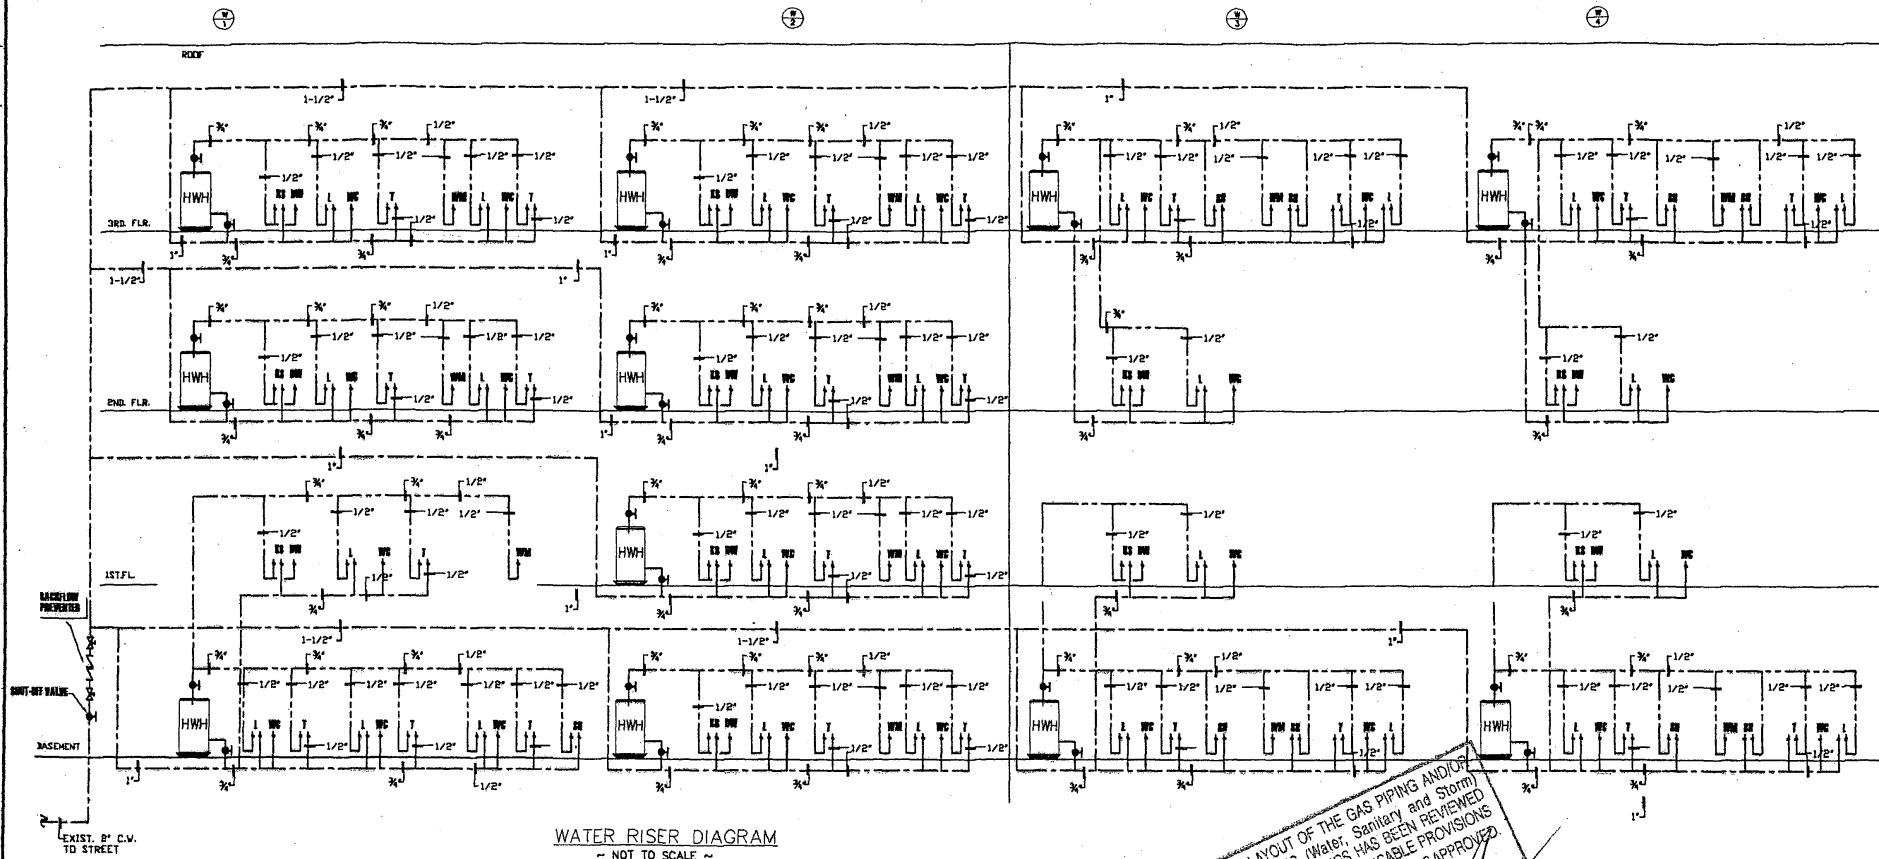

WATER RISER DIAGRAM
~ NOT TO SCALE ~

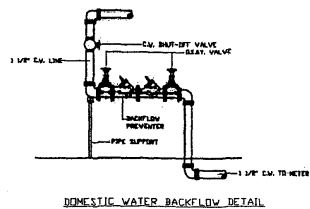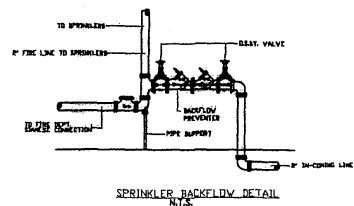


THE GENERAL LAYOUT OF THE GAS PIPING AND/OR PLUMBING SYSTEMS (Water, Sanitary and Storm) SHOWN ON THESE DRAWINGS HAS BEEN REVIEWED FOR COMPLIANCE WITH THE APPLICABLE PROVISIONS OF THE D.C. CONSTRUCTION CODES AND IS APPROVED
Date **AUG 16 2005**
Chinhezu Godwin (Signature)
Mechanical Engineering Section

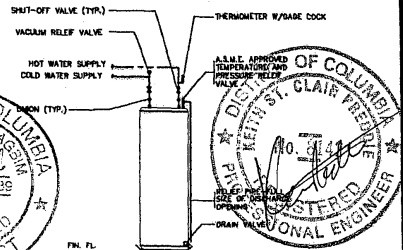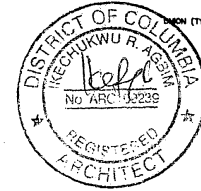

BUILDING PERMIT:
1233 MORSE STREET, NE
SQUARE 4089, LOT


P-1.2

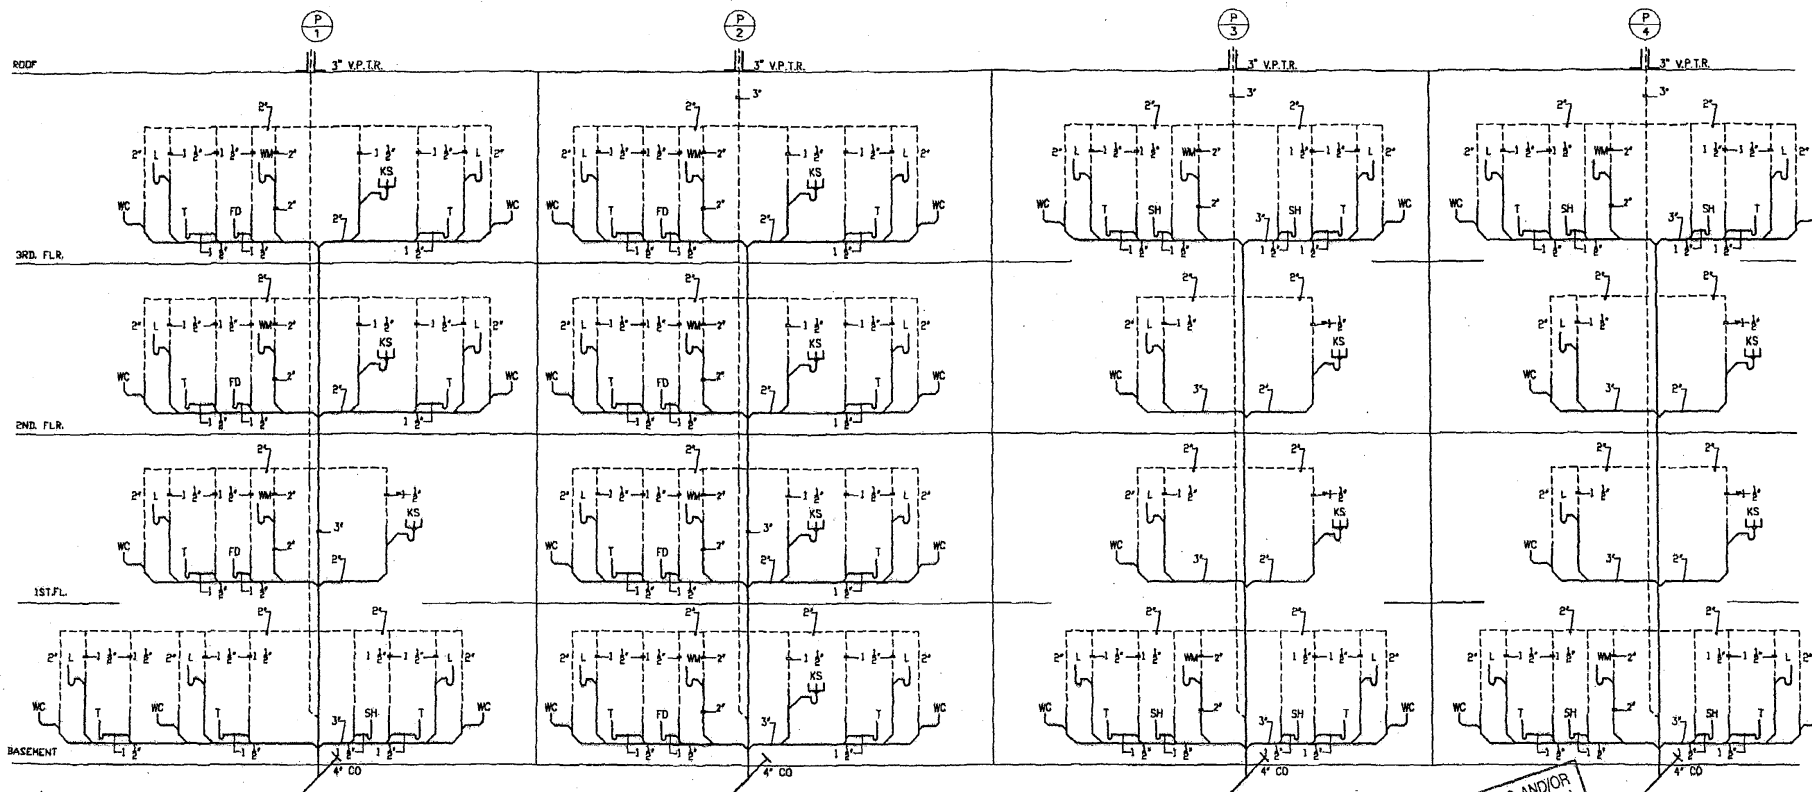

8" S.P. TO STREET


PLUMBING RISER DIAGRAM
-- NOT TO SCALE --


THE GENERAL LAYOUT OF THE GAS PIPING AND/OR PLUMBING SYSTEMS (Water, Sanitary and Storm) SHOWN ON THESE DRAWINGS HAS BEEN REVIEWED FOR COMPLIANCE WITH THE APPLICABLE PROVISIONS OF THE D.C. CONSTRUCTION CODES AND IS APPROVED.
Date AUG 16 2005
Chinedu Godwin Okwuani
Mechanical Engineering Section

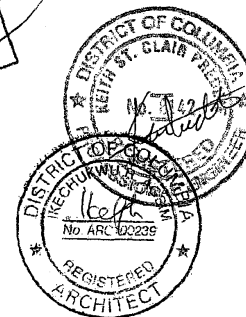

PLUMBING FIXTURE SCHEDULE						
ITEM	DESCRIPTION	C.V.	H.W.	DRAIN		REMARK
				DIR.	IND.	
1	WATER CLOSET	1/2"	1/2"	1/2"	1/2"	
2	WATER CLOSET	1/2"	1/2"	1/2"	1/2"	
3	SINK	1/2"	1/2"	1/2"	1/2"	
4	SHOWER PAN	1/2"	1/2"	1/2"	1/2"	
5	SHOWER PAN	1/2"	1/2"	1/2"	1/2"	
6	WATER CLOSET	1/2"	1/2"	1/2"	1/2"	
7	WATER CLOSET	1/2"	1/2"	1/2"	1/2"	

BUILDING PERMIT:
1233 MORSE STREET, NE
SQUARE 4069, LOT
P-1.1

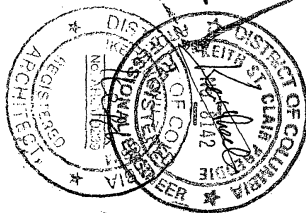[illegible]

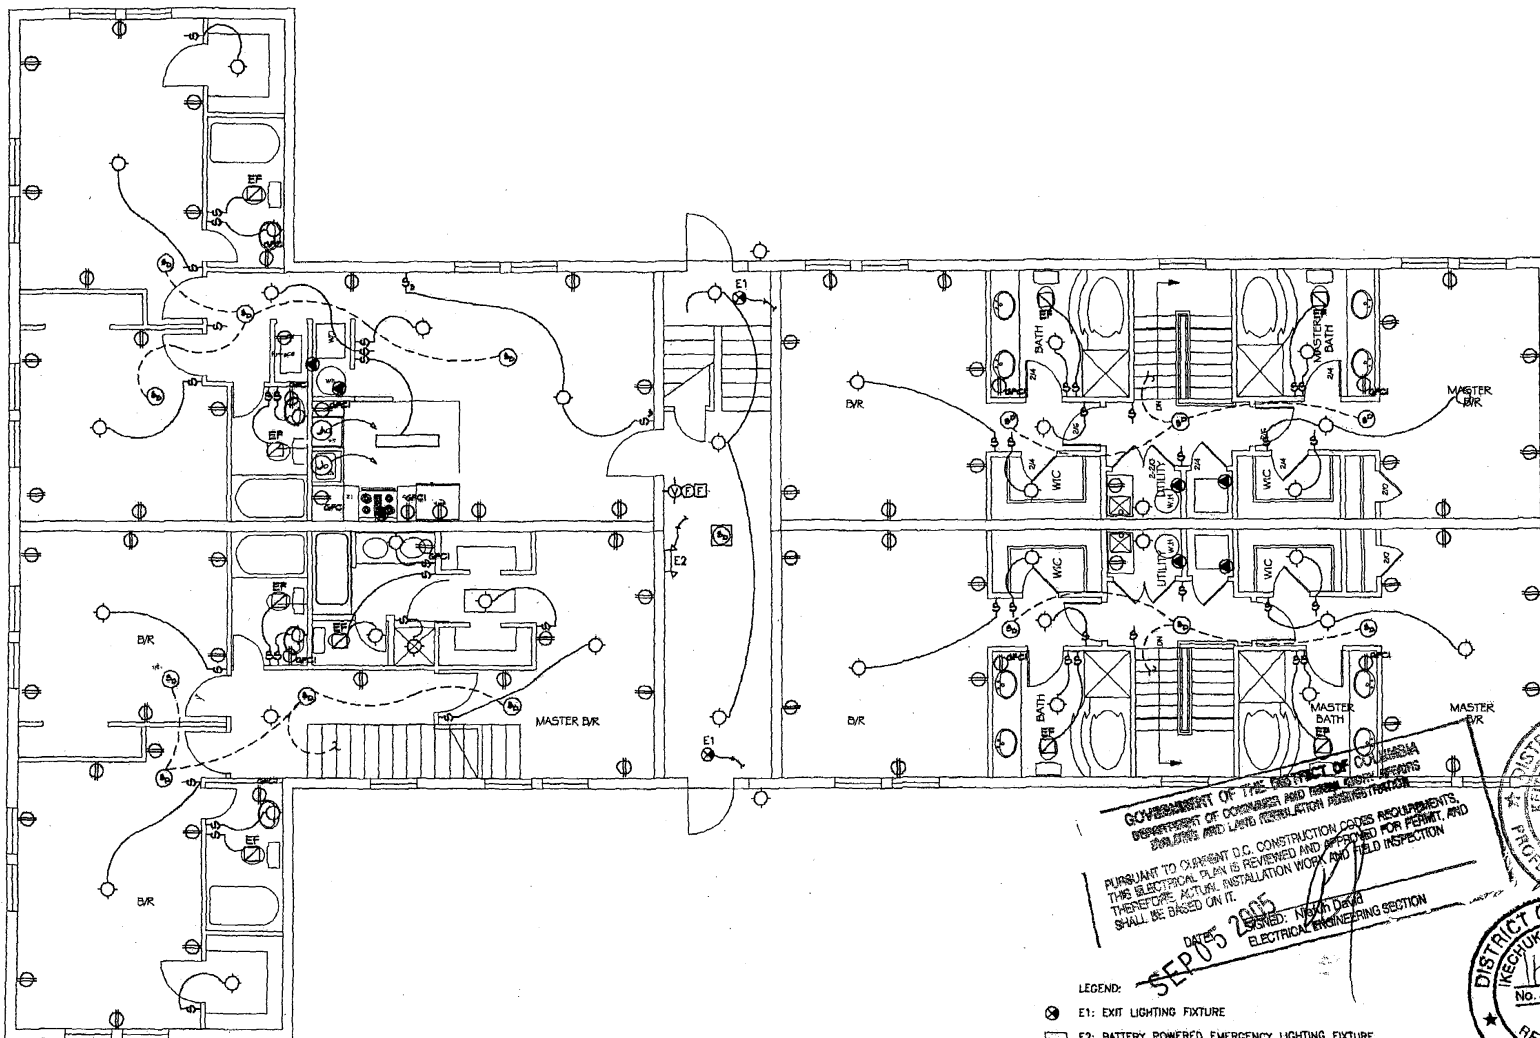


1 BASEMENT PLAN


- LEGEND:
- ⊙ E1: EXIT LIGHTING FIXTURE
 - ⬅ E2: BATTERY POWERED EMERGENCY LIGHTING FIXTURE
 - ⌘ MANUAL PULL STATION (MID. 48" AFF)
 - ⊙/⊙ HORN/VISUAL STROBE
 - ⌘ FUSED DISCONNECT SWITCH

GOVERNMENT OF THE DISTRICT OF COLUMBIA
 DEPARTMENT OF COMMERCE AND TRADE DEVELOPMENT
 BUILDING AND LIFE REGULATION DIVISION


PURSUANT TO CURRENT D.C. CONSTRUCTION CODES REQUIREMENTS,
 THIS ELECTRICAL PLAN IS REVIEWED AND APPROVED FOR PERMIT, AND
 THEREFORE, ACTUAL INSTALLATION WORK AND FIELD INSPECTION
 SHALL BE BASED ON IT.

DATE: 2005
 SIGNED: NISHU DEVI
 ELECTRICAL ENGINEERING SECTION

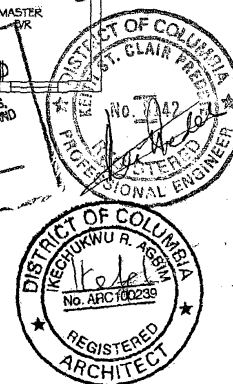

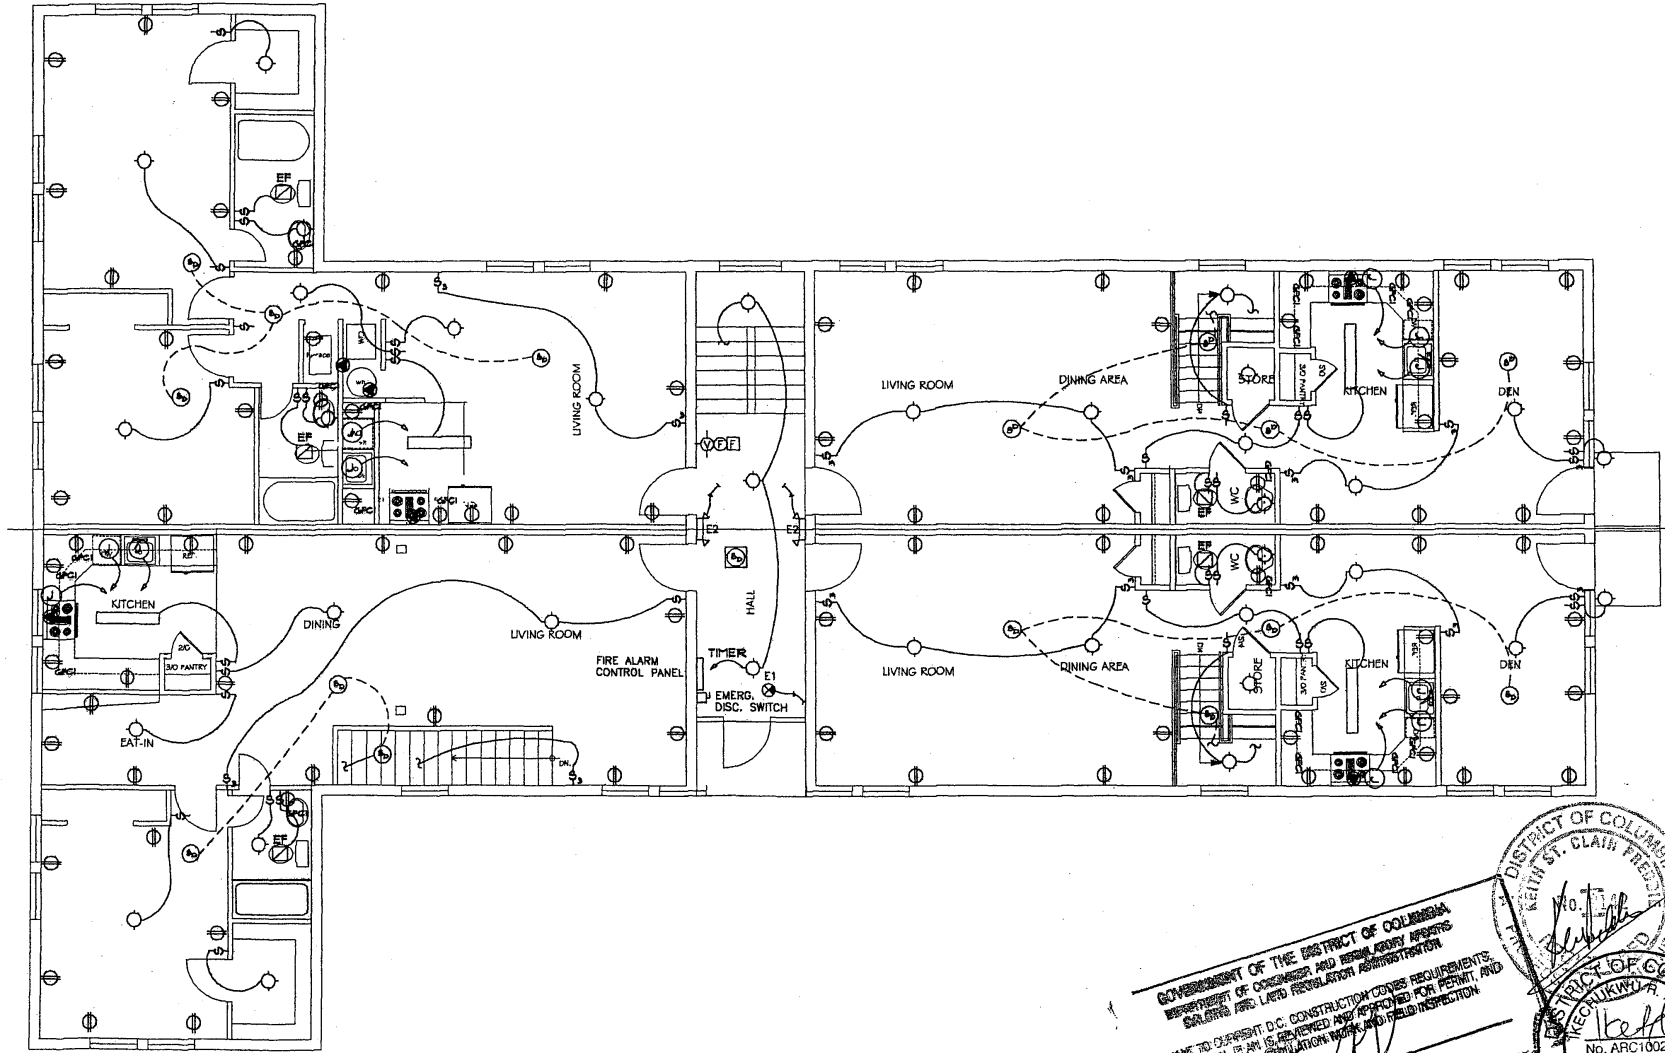

1 FIRST FLOOR PLAN

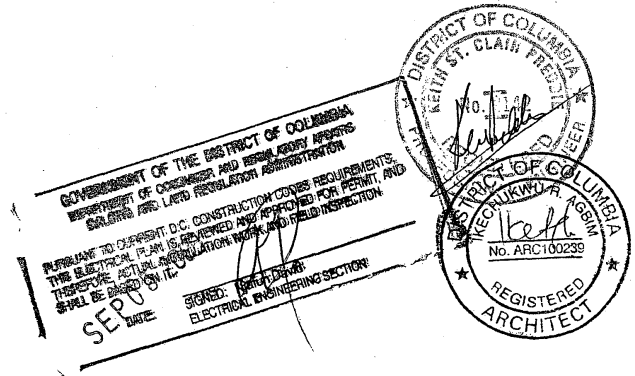

BUILDING PERMIT:
1233 MORSE STREET, NE
SQUARE 4089, LOT


ALL MECHANICAL SYSTEMS SHALL BE DESIGNED AND APPROVED BY A LICENSED MECHANICAL ENGINEER. THE GENERAL LAYOUT OF THE MECHANICAL SYSTEMS SHOWN ON THESE DRAWINGS HAS BEEN REVIEWED FOR COMPLIANCE WITH THE APPLICABLE PROVISIONS OF THE D.C. CONSTRUCTION CODES AND IS APPROVED.

THE GENERAL LAYOUT OF THE MECHANICAL SYSTEMS SHOWN ON THESE DRAWINGS HAS BEEN REVIEWED FOR COMPLIANCE WITH THE APPLICABLE PROVISIONS OF THE D.C. CONSTRUCTION CODES AND IS APPROVED.
Date **AUG 16 2005**
Chinedu Godwin Ukwuani
Mechanical Engineering Section


PROVIDE 4" PVC VENT TO EXTERIOR FOR NEW 60000 BTU 90" GAS FURNACE 1500 CFM AIR HANDLER

CONDENSER UNIT, 1
NOMINAL 3-TON AIR-COOLED UNIT W/CAPACITY TO DEVELOP THE COOLING OF THE DX COIL AT GRADE ON 4" THICK CONC. PAD

CU-2

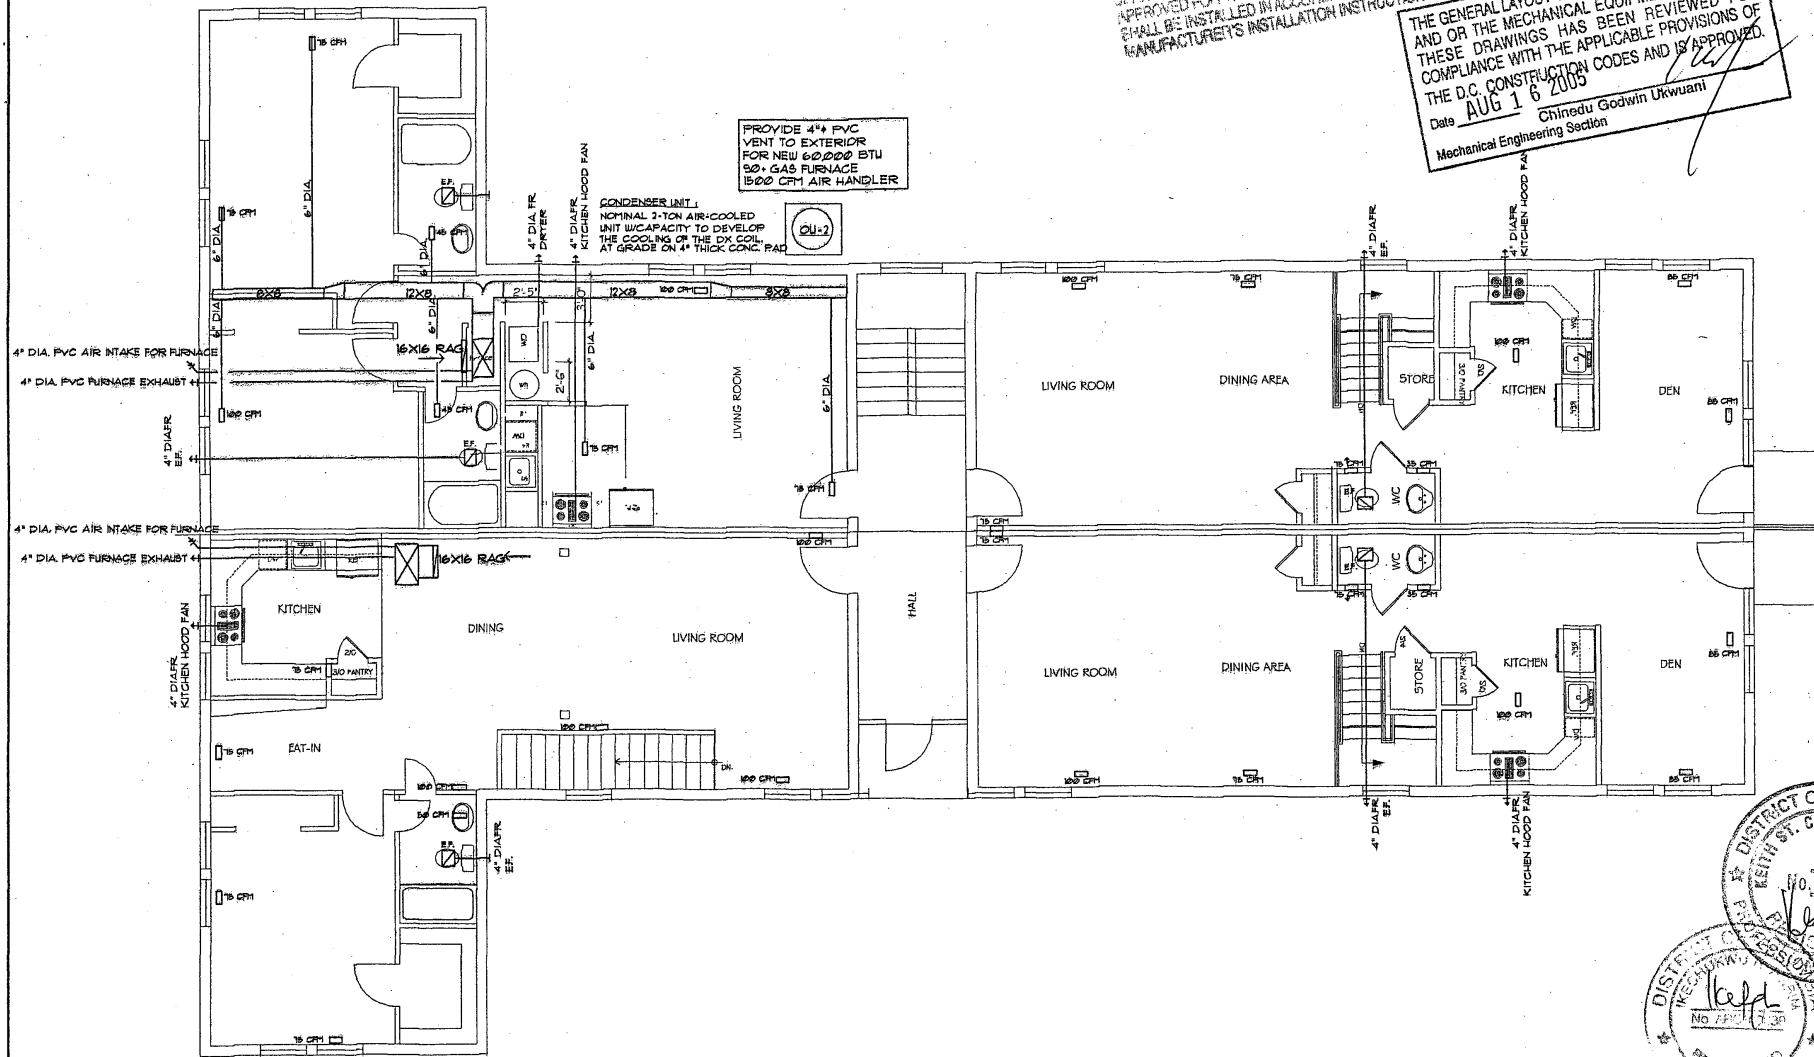


1 FIRST FLOOR PLAN

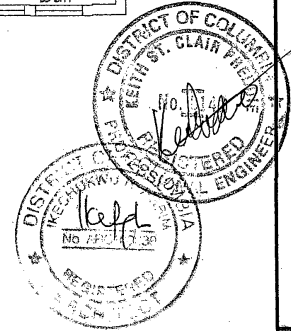

BUILDING PERMIT:
1235 MORSE STREET, NE
SQUARE 4069, LOT

M-2

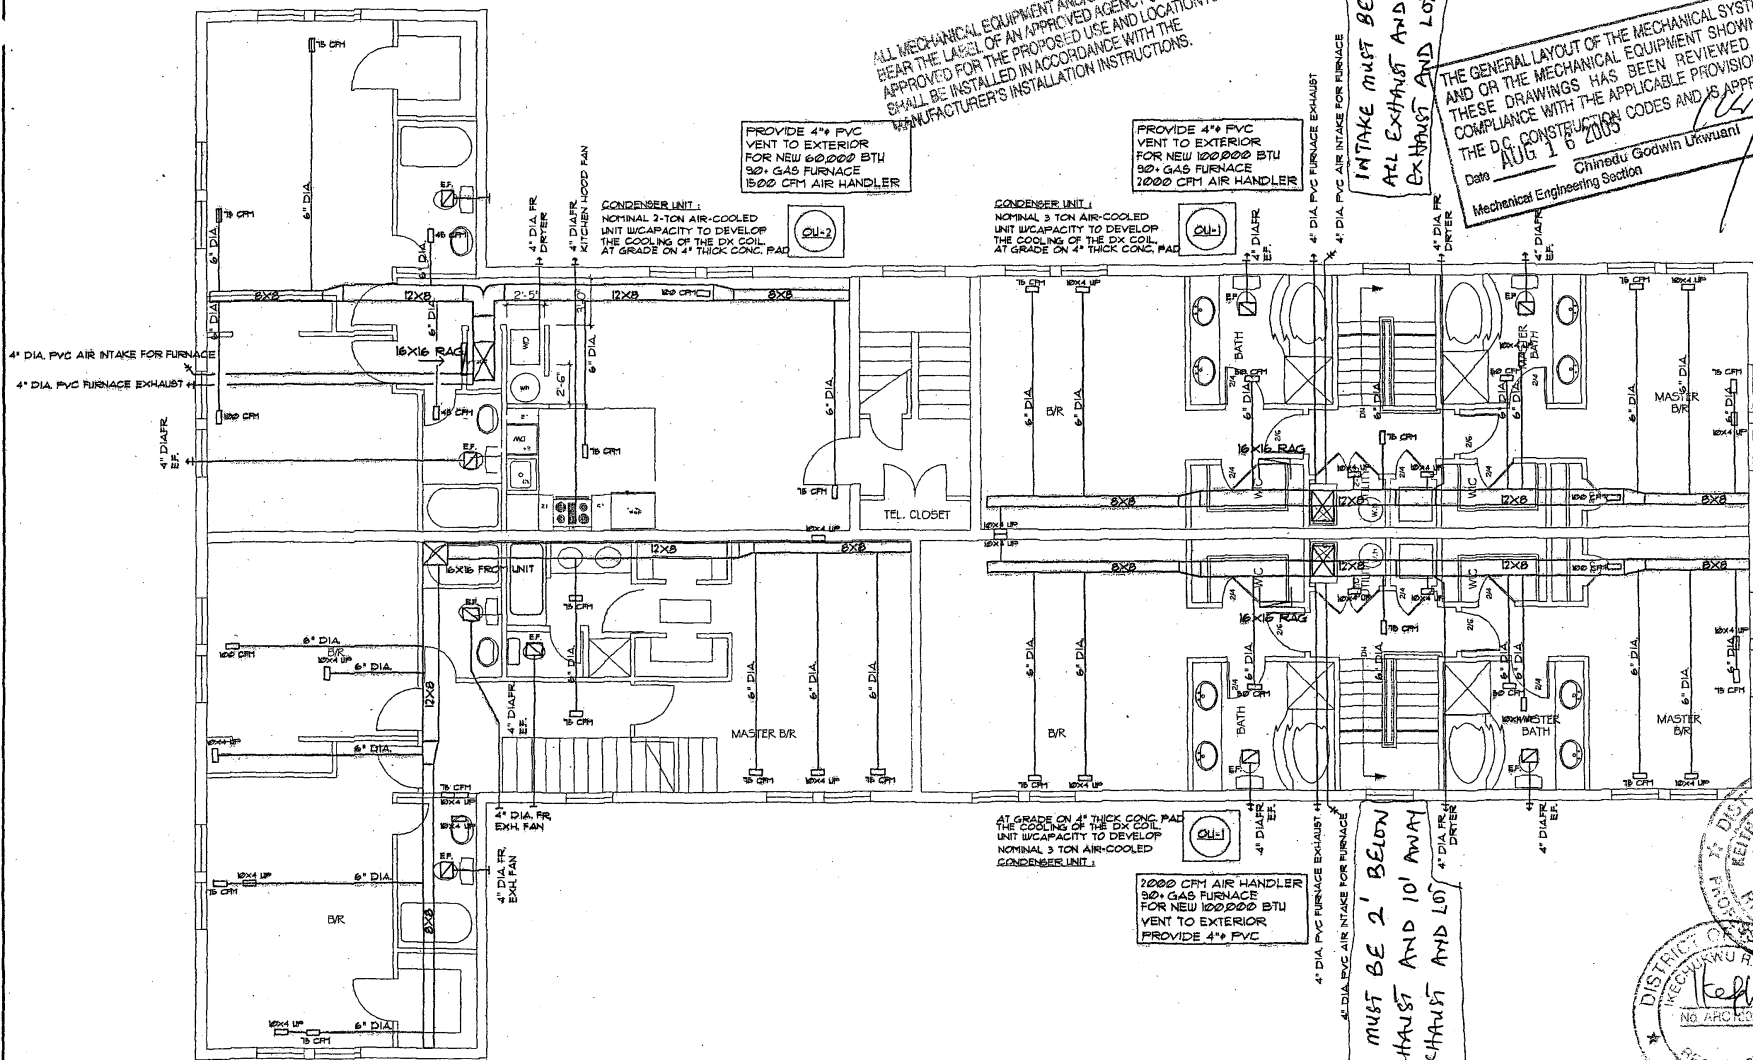

1 BASEMENT PLAN

ALL MECHANICAL EQUIPMENT AND/OR APPLIANCES SHALL BEAR THE LABEL OF AN APPROVED AGENCY SHALL BE APPROVED FOR THE PROPOSED USE AND LOCATION AND SHALL BE INSTALLED IN ACCORDANCE WITH THE MANUFACTURER'S INSTALLATION INSTRUCTIONS.

PROVIDE 4" PVC VENT TO EXTERIOR FOR NEW 60,000 BTU 90+ GAS FURNACE 1200 CFM AIR HANDLER

PROVIDE 4" PVC VENT TO EXTERIOR FOR NEW 100,000 BTU 90+ GAS FURNACE 1200 CFM AIR HANDLER

CONDENSER UNIT 1 NOMINAL 3 TON AIR-COOLED UNIT W/CAPACITY TO DEVELOP THE COOLING OF THE DX COIL AT GRADE ON 4" THICK CONC. PAD


AT GRADE ON 4" THICK CONC. PAD THE COOLING OF THE DX COIL. NOMINAL 3 TON AIR-COOLED CONDENSER UNIT 1

1200 CFM AIR HANDLER 90+ GAS FURNACE FOR NEW 100,000 BTU VENT TO EXTERIOR PROVIDE 4" PVC

INTAKE MUST BE 2' BELOW ALL EXHAUST AND 10' AWAY FROM EXHAUST AND LOT LINE


INTAKE MUST BE 2' BELOW ALL EXHAUST AND 10' AWAY FROM EXHAUST AND LOT LINE

THE GENERAL LAYOUT OF THE MECHANICAL SYSTEMS AND/OR THE MECHANICAL EQUIPMENT SHOWN ON THESE DRAWINGS HAS BEEN REVIEWED FOR COMPLIANCE WITH THE APPLICABLE PROVISIONS OF THE D.C. CONSTRUCTION CODES AND IS APPROVED.
Date AUG 16 2009
Chinedu Godwin Ukwuani
Mechanical Engineering Section

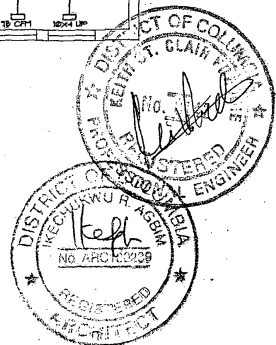

BUILDING PERMIT:
1235 MORSE STREET, NE
SQUARE 4089, LOT

M-1

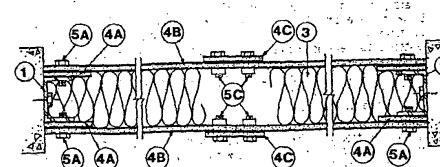


VERTICAL SECTION
(HORIZONTAL JOINTS)

1. Floor, Ceiling and Side Channels—Channel-shaped, nominal 3 in. wide with nominal 2 in. legs fabricated from 1/4 in. pressed mild steel.
2. Support Channels—Channel-shaped, nominal 3 in. wide with nominal 3-1/4 in. legs fabricated from 1/4 in. thick rolled mild steel.
3. Batts and Blankets*—Mineral wool batts, minimum 10 lb/cu ft and nominal 4 in. thick.

4. Units Partition Panels*—Nominal 3/8 in. thick insulated panels supplied as fillets, sheets, and cover profiles.
 - A. Fillets*—Nominal 3/8 in. thick by 3-1/2 in. wide insulated panels installed over the steel channels.
 - B. Sheets*—Nominal 3/8 in. thick by 36 in. wide insulated panels installed on both surfaces of the mineral wool.
 - C. Cover Profiles*—Nominal 3/8 in. thick by 4 in. wide insulated panels installed over the vertical and horizontal joints.
5. Fasteners—Various sizes, as described below, hex bolts used to secure the fillets, sheets, and cover profiles to the steel supports.
 - A. Countersunk Bolts—Nominal 1/4 in. diameter by 1 in. long steel countersunk bolts with nominal 1/4 in. diameter steel nuts used to secure the fillets and sheets to the steel channel.
 - B. Hex Bolts—Nominal 5/16 in. diameter by 1-3/8 in. long steel bolts with 5/16 in. diameter nuts spaced 12 in. O.C. used to secure the fillets and sheets to the steel channel. (Item No. 1)
 - C. Hex Bolts—Nominal 5/16 in. diameter by 1-3/4 in. long steel hex bolts with 5/16 in. diameter nuts spaced maximum 12 in. O.C. used to secure the fillets, sheets and cover profiles to the support channel. (Item No. 2)
 - D. Hex Bolts—Nominal 5/16 in. diameter by 1-3/8 in. long hex bolts with 5/16 in. diameter steel nuts spaced 6 in. O.C. used to secure the cover profiles into the sheets.

*Bearing the UL Classification Marking

Design No. U032
Bearing Wall Rating—1 HR.

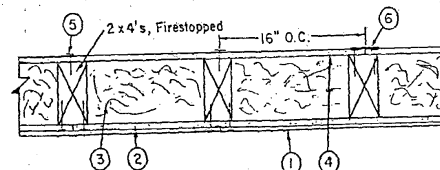

1. Hard board Paneling—Mineral and Fiber Boards*—Untreated panels nom 7/16 or 1/2 in. thick, 6 to 48 in. wide. Ship-lapped panel sidings are fastened to framing members with 10d rust-resistant nails thru the lap spaced 6 in. OC vertically. Butted panel siding fastened to framing members with 10d nails 3/8 in. from edge spaced 6 in. OC vertically. Lap sidings fastened to framing members with 12d nails 3/8 in. from edges spaced 16 in. OC horizontally. (Aluminum joint molding as required for lap products).

Masonite Corp.

- 1A. In lieu of Item 1, the following Molded Plastic* may be used: Solid vinyl siding mechanically secured to framing members in accordance with manufacturer's recommended installation instructions.

Associated Materials, Inc. Div. of Alside
Gentek Building Products Ltd.
Heartland Building Products.

Vytec Corp.

2. Wallboard, Gypsum*—Nom 5/8 in. thick gypsum sheathing supp min 2 ft wide sheets, installed horizontally. Attached to each wall with 2 in. long 6d nails spaced vertically 8 in. OC.
- See Wallboard, Gypsum (CKNX) category for nan manufacturers.
3. Batts and Blankets*—Min. 3 in. thick mineral or glass fiber ba
- See Batts and Blankets (BZJZ) category for nan manufacturers.
4. Wallboard, Gypsum*—Nom 5/8 in. thick wallboard, with b square or tapered edges. Wallboard nailed 7 in. O.C. with 6d nails in. long. When used in widths other than 48 in., wallboard is installed horizontally.
- See Wallboard, Gypsum (CKNX) category for nan manufacturers.
5. Nailheads—Covered with joint compound.
6. Joints—Covered with paper tape and joint compound.


*Bearing the UL Classification Marking

Design No. U036


Nonbearing Wall Rating—1 or 2 HR.

(See Item 2)

Finish Rating—13 min (See Item 2)

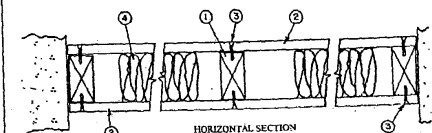

HORIZONTAL SECTION


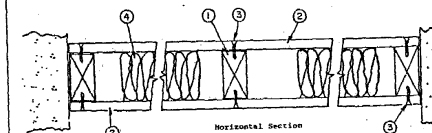


HORIZONTAL SECTION

1. Wood Studs—Nom 2 by 4 in., spaced 24 in. OC.
2. Mineral and Fiber Boards*—Board panels nom 0.394 in. (10 mm) for the 1 h assembly rating and nom 0.591 in. (15 mm) for the assembly rating, 48 in. (1220 mm) wide by 96 in. (2440 mm) long, butted on and fastened to wood studs. The finish rating is for the in. (15 mm) board only.
- Eternit Inc.—PROMAT-H.
3. Fasteners—No. 7 by 1-1/4 in. long self-tapping, bugle-head steel s to attach 0.394 in. (10 mm) thick board. No. 7 by 1-5/8 in. self-tapping bugle-head steel screws to attach 0.591 in. (15 mm) board. Screws located at 3/8 in. from edges and spaced 10 in. OC.
4. Batts and Blankets*—Min 3-1/2 in. thick, 4 lb per cu ft mineral batts.

*Bearing the UL Classification Marking

FLOOR-CEILING SYSTEMS, WOOD-FRAMED			
GA FILE NO. FC 5107	PROPRIETARY*	1 HOUR FIRE	55 to 59 FSTC SOUND
GYPSUM WALLBOARD, RESILIENT CHANNELS, WOOD JOISTS, GYPSUM FLOOR UNDERLAYMENT One layer 5/8" proprietary type X gypsum wallboard or gypsum veneer base applied at right angles to resilient furring channels 24" o.c. with 1" Type S drywall screws 12" o.c. Gypsum board end joints located midway between continuous channels and attached to additional pieces of channel 54" long with screws at 12" o.c. Resilient furring channels applied at right angles to 2 x 10 wood joists 16" o.c. with 1 1/4" Type W screws. Wood joists supporting 1 1/2" plywood subfloor and 3/4" 1000 psi sanded gypsum floor underlayment.			
PROPRIETARY GYPSUM BOARD BPB America Inc. - 5/8" ProFlo™ Type C Gypsum Panels G-P Gypsum - 5/8" ToughRock® Fireguard® C Lafarge North America Inc. - 5/8" Firecheck® Type C National Gypsum Company - 5/8" Gold Bond® Brand FIRE-SHIELD C™ Gypsum Wallboard PABCO Gypsum - 5/8" FLAME CURB® Super C Temple-Inland Forest Products Corporation - 5/8" TG-C United States Gypsum Company - 5/8" SHEETROCK® Brand Gypsum Panels, FIRECODE® C Core		Approx. Ceiling Weight: 3 psf Fire Test: UL R1319-65, 11-16-64, UL Design L514 Field Sound Test: INTEST 5-761-3, 12-5-77	
GA FILE NO. FC 5110	GENERIC	1 HOUR FIRE	50 to 54 °TC SOUND
WOOD JOISTS, GYPSUM LATH, GYPSUM PLASTER, RESILIENT CHANNELS 1/2" 1-2-1-3 gypsum-sand plaster applied over 3/8" type X gypsum lath applied at right angles to resilient furring channels 16" o.c. with three 3/8" Type S drywall screws at each furring channel 3" wide woven wire strips applied over gypsum lath and parallel to and directly over resilient channels with 7/8" Type S drywall screws with diamond washers 16" o.c. Resilient channels applied at right angles to 2 x 10 wood joists 16" o.c. with 6d coated nails, 1 7/8" long, 0.0915" shank, 1/4" heads. Wood joists supporting 1" nominal wood subfloor and 1" nominal wood finish floor.			
Sound tested with 3" glass fiber insulation batts in joist space, sound deadening felt, and carpet and pad. A face layer of 1/2" or 5/8" type X gypsum wallboard required to achieve 1 hour fire resistance rating when glass fiber insulation is used.		Approx. Ceiling Weight: 6.25 psf Fire Test: SFT-42, 5-7-66 Sound Test: CK 6712-5, 6-9-67 IIC & Test: (68 C & P) CK 6712-5, 6-9-67	
GA FILE NO. FC 5111	GENERIC	1 HOUR FIRE	50 to 54 STC SOUND
WOOD JOISTS, GYPSUM WALLBOARD, RESILIENT CHANNELS Base layer 1/2" type X gypsum wallboard applied at right angles to resilient channels 16" o.c. with 1 1/4" Type S drywall screws 12" o.c. Resilient channels applied at right angles to minimum 9/16" deep wood joists, with minimum 1 1/4" deep x 1 1/2" wide flanges and minimum 3/4" webs, 24" o.c. with 1 1/4" Type W drywall screws. Face layer 1/2" type X gypsum wallboard applied at right angles to channels with 1 1/4" Type S drywall screws 12" o.c. Face layer end joints located midway between channels and attached to base layer with 1 1/4" Type G screws 12" o.c. Edge joints offset 24" from base layer edge joints. Wood joists supporting 5/8" oriented strand board applied at right angles to joists with 8d common nails 12" o.c.			
STC and IIC tested with 40 oz carpet over 1/4" foam pad.		Approx. Ceiling Weight: 5 psf Fire Test: NRCC A-4440.1 (Revised), 6-24-97 Sound Test: NRCC B-3150.2, 6-30-00 IIC & Test: (68 C & P) NRCC B-3150.2, 6-30-00	

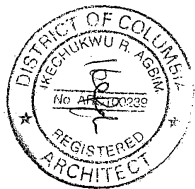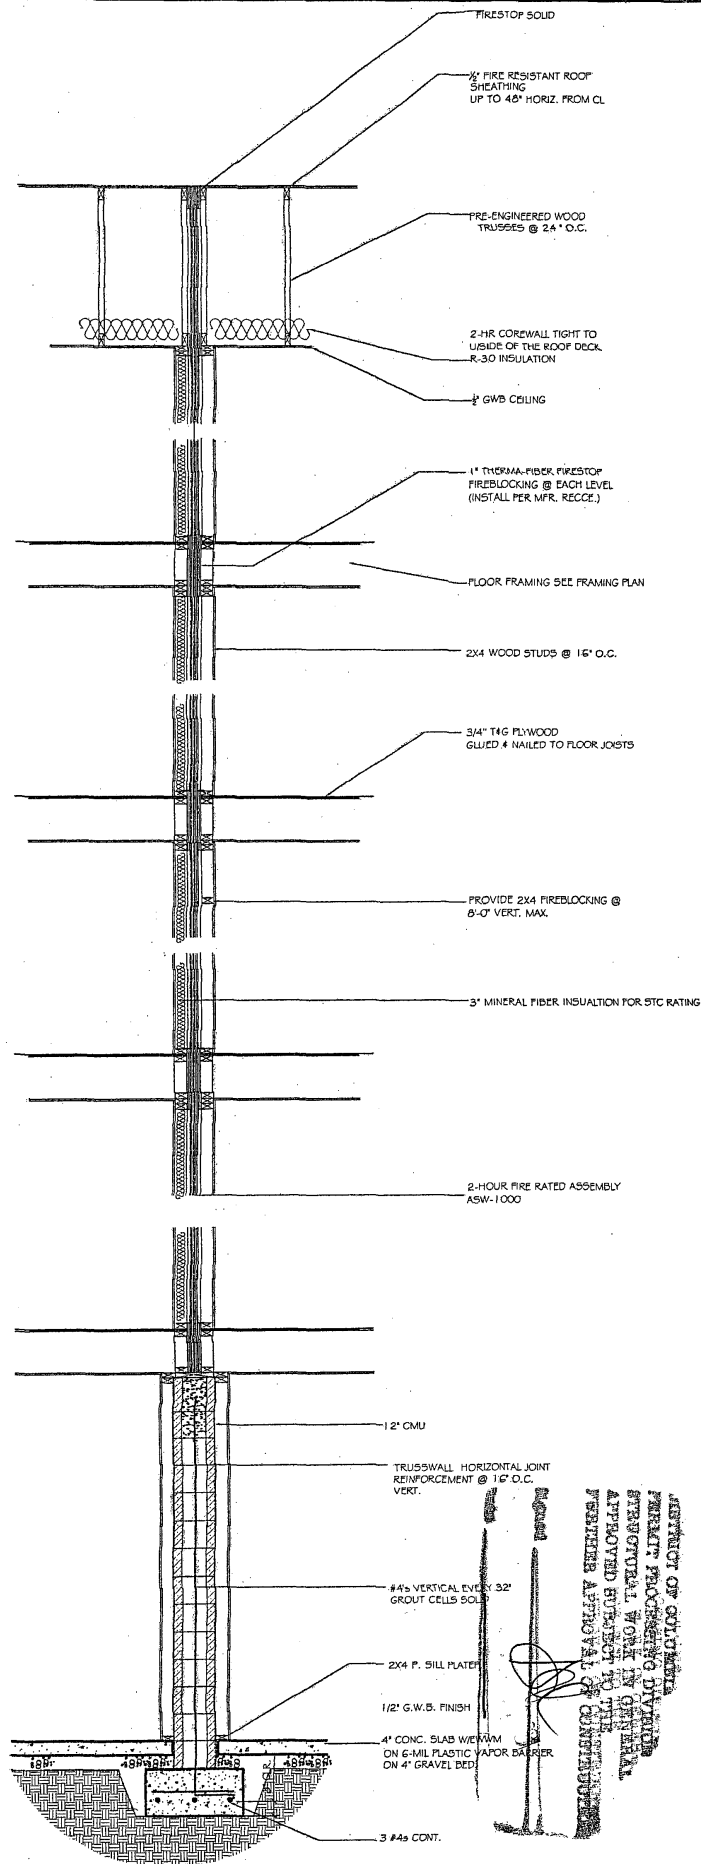

DETAIL @ PARTY WALL
U-336


DISTRICT OF COLUMBIA
PERMIT PROCESSING DIVISION
STRUCTURAL WORK IN GENERAL
APPROVED SUBJECT TO THE
FURTHER APPROVAL OF CONSTRUCTION

A-0

BUILDING PERMIT:
1233 MORSE STREET, NE
SQUARE 4069, LOT

12" O.H. TYP.

10'-2"

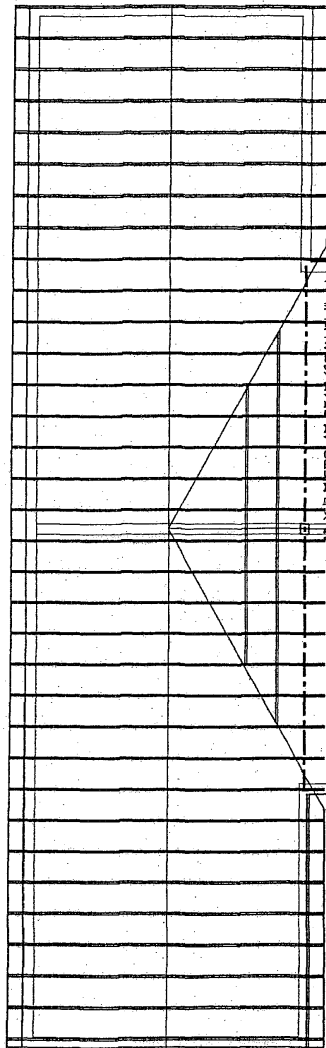

STICK FRAME BUILT-UP AREA
WITH 2X4 @ 24" O.C.

3/8" X 12" MICROLAT BEAM (SPAN 11'-11")

34'-7/4"

12 O.H. TYP.


ALL ROOF TRUSSES ARE PRE-ENGINEERED.

@ 24" O.C. BRACED PER MFR.

DISTRICT OF COLUMBIA
ARCHITECTURAL PROCESSING DIVISION
STRUCTURAL WORK IN GENERAL
APPROVED SUBJECT TO THE
FURTHER APPROVAL OF CONSTRUCTORS

Signed

Printed Name

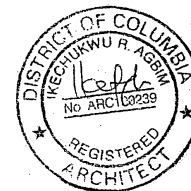

1 ROOF FRAMING


BUILDING PERMIT:
1233 MORSE STREET, NE
SQUARE 4089, LOT

A-6

DISTRICT OF COLUMBIA
PERMIT PROCESSING DIVISION
STRUCTURAL WORK IN GENERAL
APPROVED SUBJECT TO THE
FURTHER APPROVAL OF CONSTRUCTION

ALL FLOOR JOISTS ARE 2X12's @ 16" O.C.
Signed _____

[Signature]
03/24/11


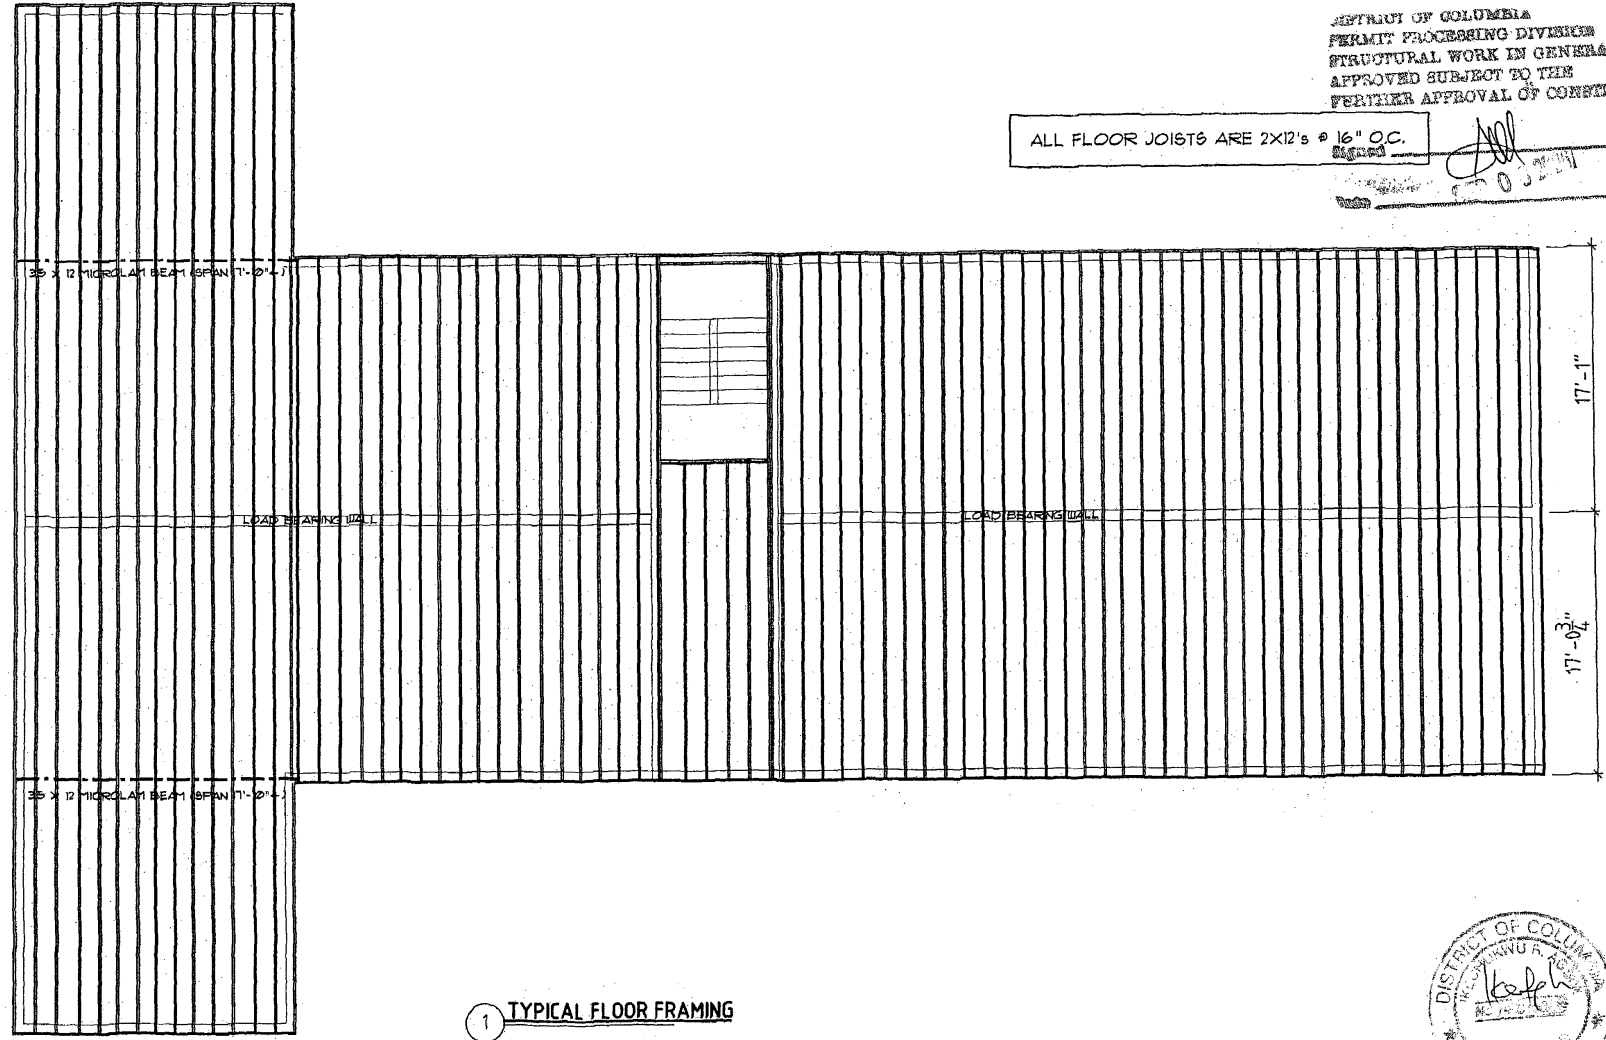


1 TYPICAL FLOOR FRAMING




BUILDING PERMIT:
1233 MORSE STREET, NE
SQUARE 4089, LOT

A-5.1

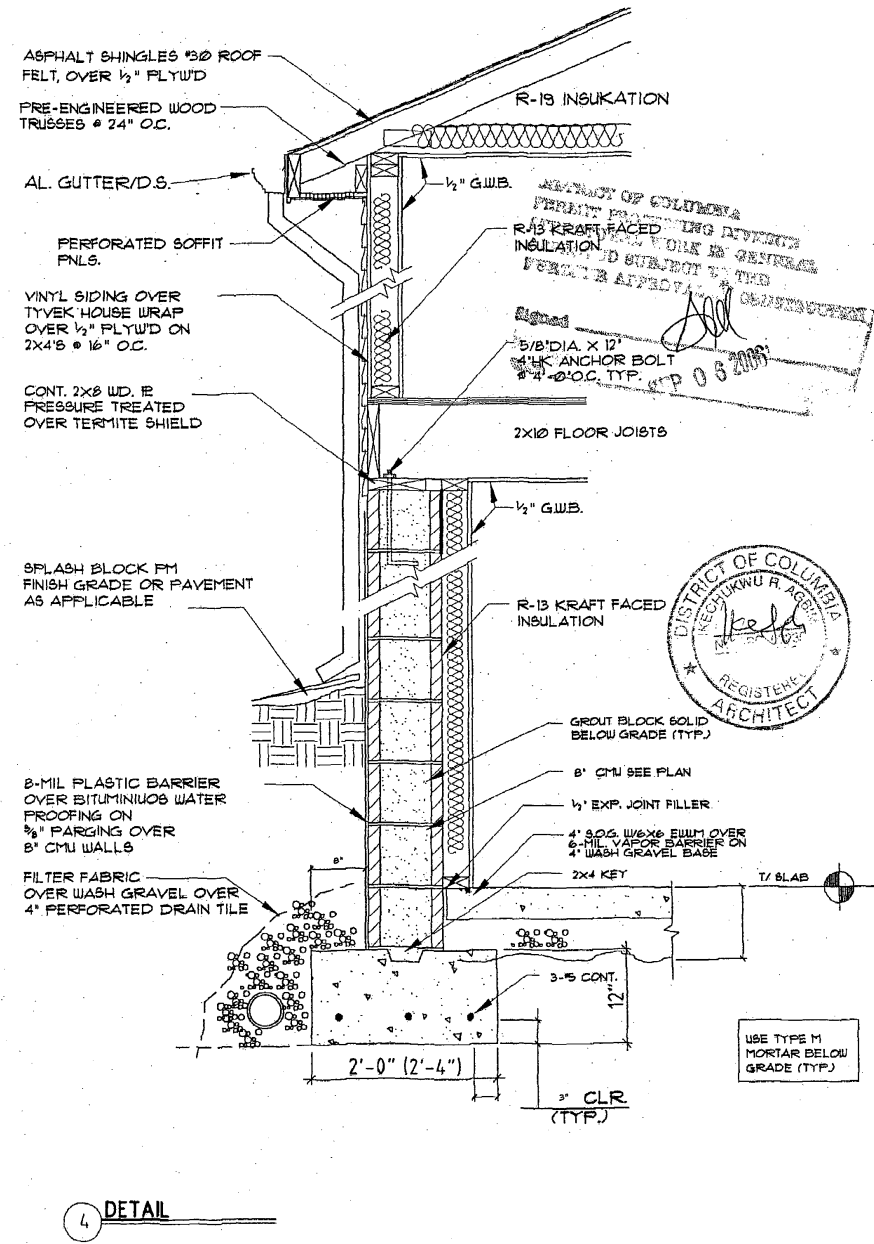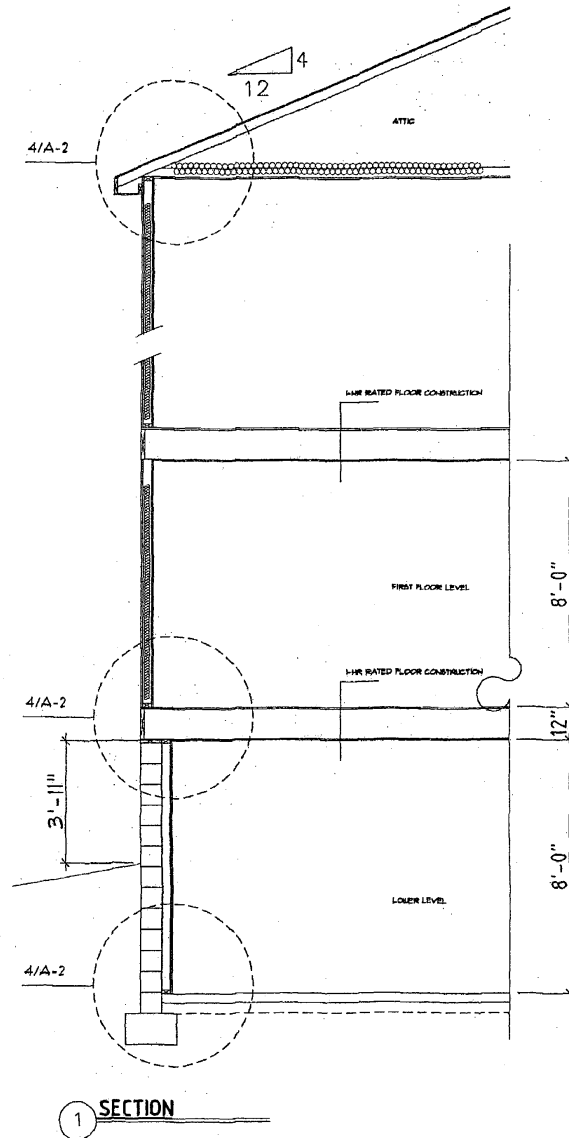


BUILDING PERMIT:
1233 MORSE STREET, NE
SQUARE 4069, LOT

A-5

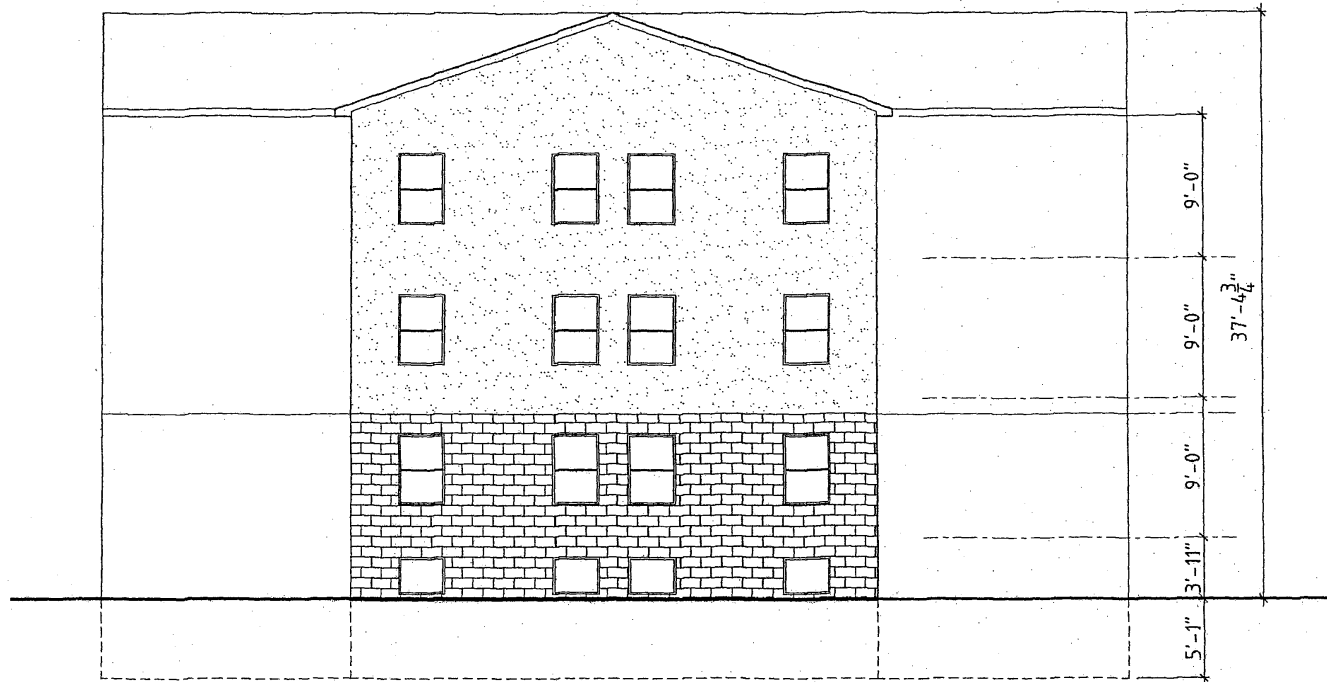


1 FRONT ELEVATION

DISTRICT OF COLUMBIA
 PERMIT PROCESSING DIVISION
 STRUCTURAL WORK IN GENERAL
 APPROVED SUBJECT TO THE
 FURTHER APPROVAL OF CONSTRUCTION
 SIGNED _____
 SEP 6 2005

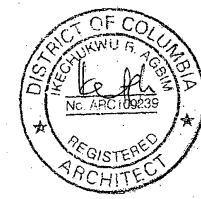


BUILDING PERMIT:
 1233 MORSE STREET, NE
 SQUARE 4069, LOT

A-4.1

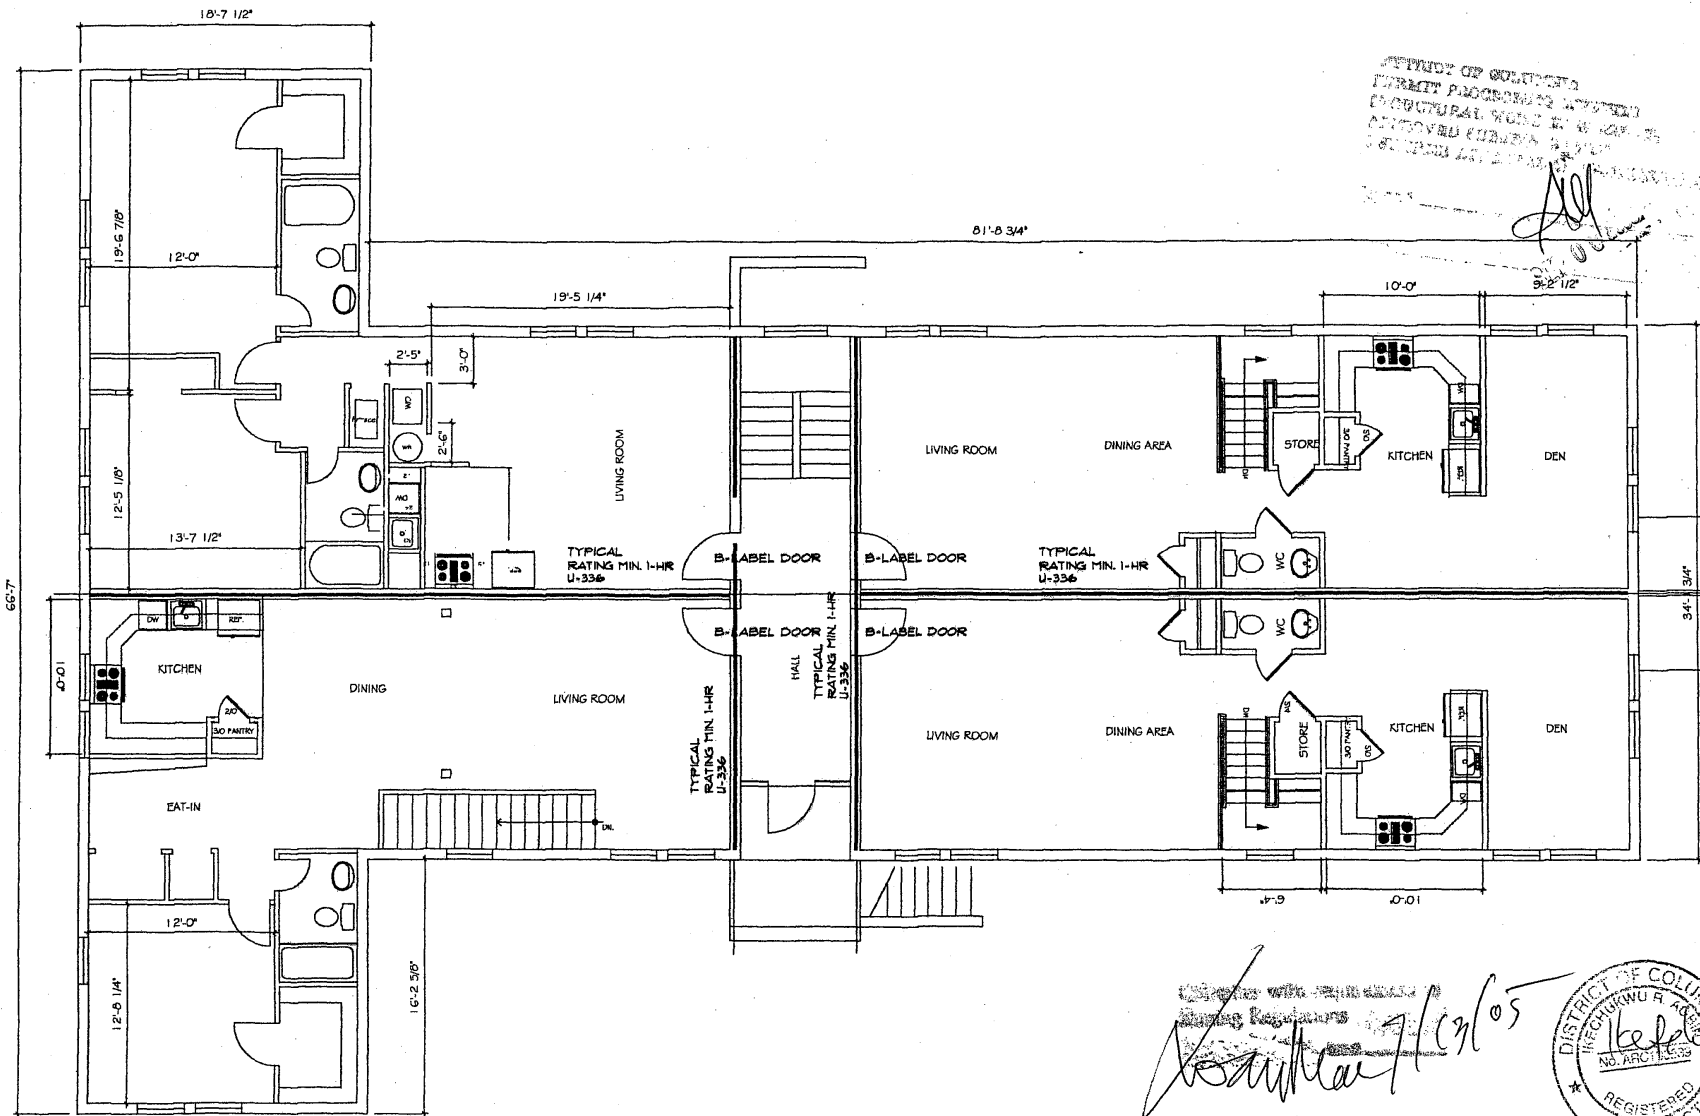

1 **FIRST FLOOR PLAN**

Handwritten signature and date: 7/1/05

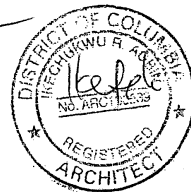

STAMP: PERMIT PROCEDURE APPROVED

BUILDING PERMIT:
 1233 MORSE STREET, NE
 SQUARE 4089, LOT

A-2

FOUNDATION NOTES

THE FOUNDATION DESIGN OF THIS BUILDING WAS BASED ON A MINIMUM ALLOWABLE SOIL BEARING PRESSURE OF 7500 psf

ANY FILL REQUIRED BELOW SLABS ON GRADE OR BELOW FOOTINGS SHALL BE COMPACTED AS REQUIRED.

ALL EXTERIOR FOOTINGS SHALL EXTEND BELOW THE MAXIMUM ANTICIPATED DEPTH OF FROST.

THE CONTRACTOR SHALL NOTIFY THE ARCHITECT IMMEDIATELY IN THE EVENT THAT THE SITE CONDITIONS ENCOUNTERED VARY FROM THOSE SHOWN ON PLANS.

CONCRETE AND REINFORCING




ALL CONCRETE SHALL BE IN ACCORDANCE WITH THE "AMERICAN CONCRETE INSTITUTE BUILDING CODE" (ACI 318) AND WITH "SPECIFICATIONS FOR STRUCTURAL CONCRETE FOR BUILDINGS" (ACI 301), LATEST EDITIONS.

ALL CONCRETE SUBJECT TO EXTERIOR EXPOSURE SHALL BE AIR ENTRAINED AS RECOMMENDED BY ACI 318.

REINFORCING BARS SHALL BE DEFORMED BARS OF NEW BILLET STEEL CONFORMING TO ASTM A-615, GRADE 60. WELDED WIRE FABRIC SHALL CONFORM TO ASTM A-185. ALL REINFORCING AND ACCESSORIES SHALL BE DETAILED AND PLACED IN ACCORDANCE WITH ACI STANDARD 315-80 AND 318R-80.


PROVIDE ALL ACCESSORIES NECESSARY TO SUPPORT REINFORCEMENT AT POSITIONS SHOWN ON THE PLANS AND DETAILS. PLASTIC COATED ACCESSORIES SHALL BE USED IN ALL EXPOSED CONCRETE WORK.

THE GENERAL CONTRACTOR SHALL CHECK WITH ARCHITECTURAL, MECHANICAL AND ELECTRICAL DRAWINGS AND THE SUB-CONTRACTORS FOR OPENINGS, SLEEVES, ANCHORS, HANGERS, INSERTS, SLAB DEPRESSIONS AND OTHER ITEMS RELATED TO THE CONCRETE WORK AND SHALL ASSUME RESPONSIBILITY FOR THEIR PROPER LOCATION.

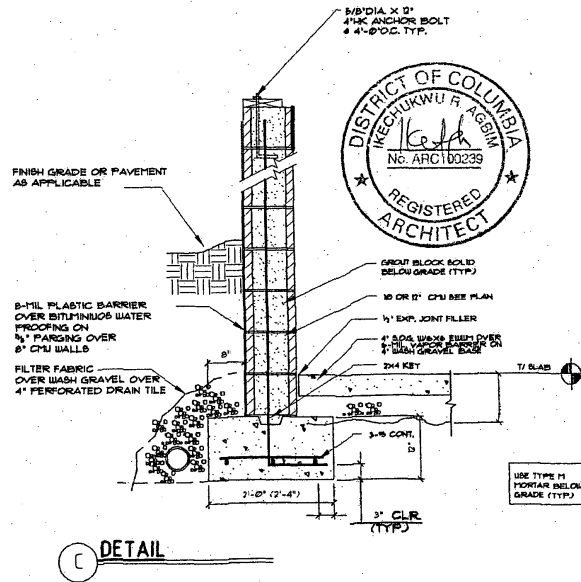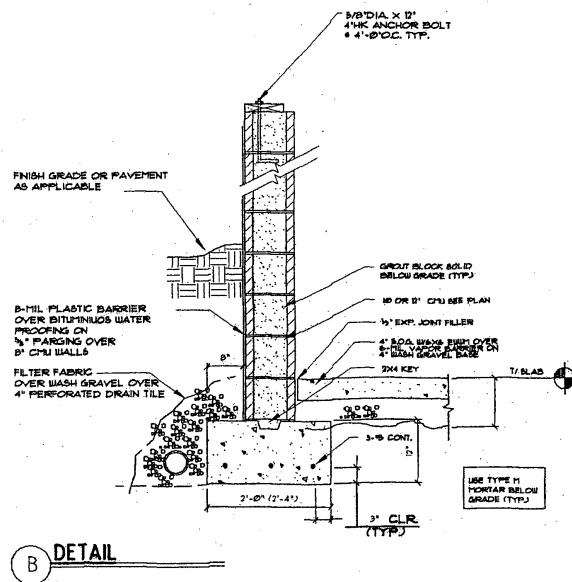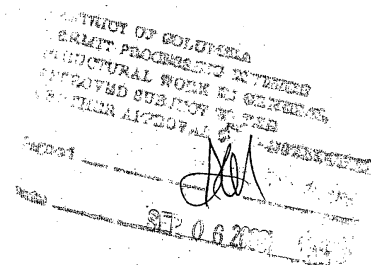


FOUNDATION PERMIT:
1235 MORSE STREET, NE
SQUARE 4089, LOTS 810, 812, & 816

S-2

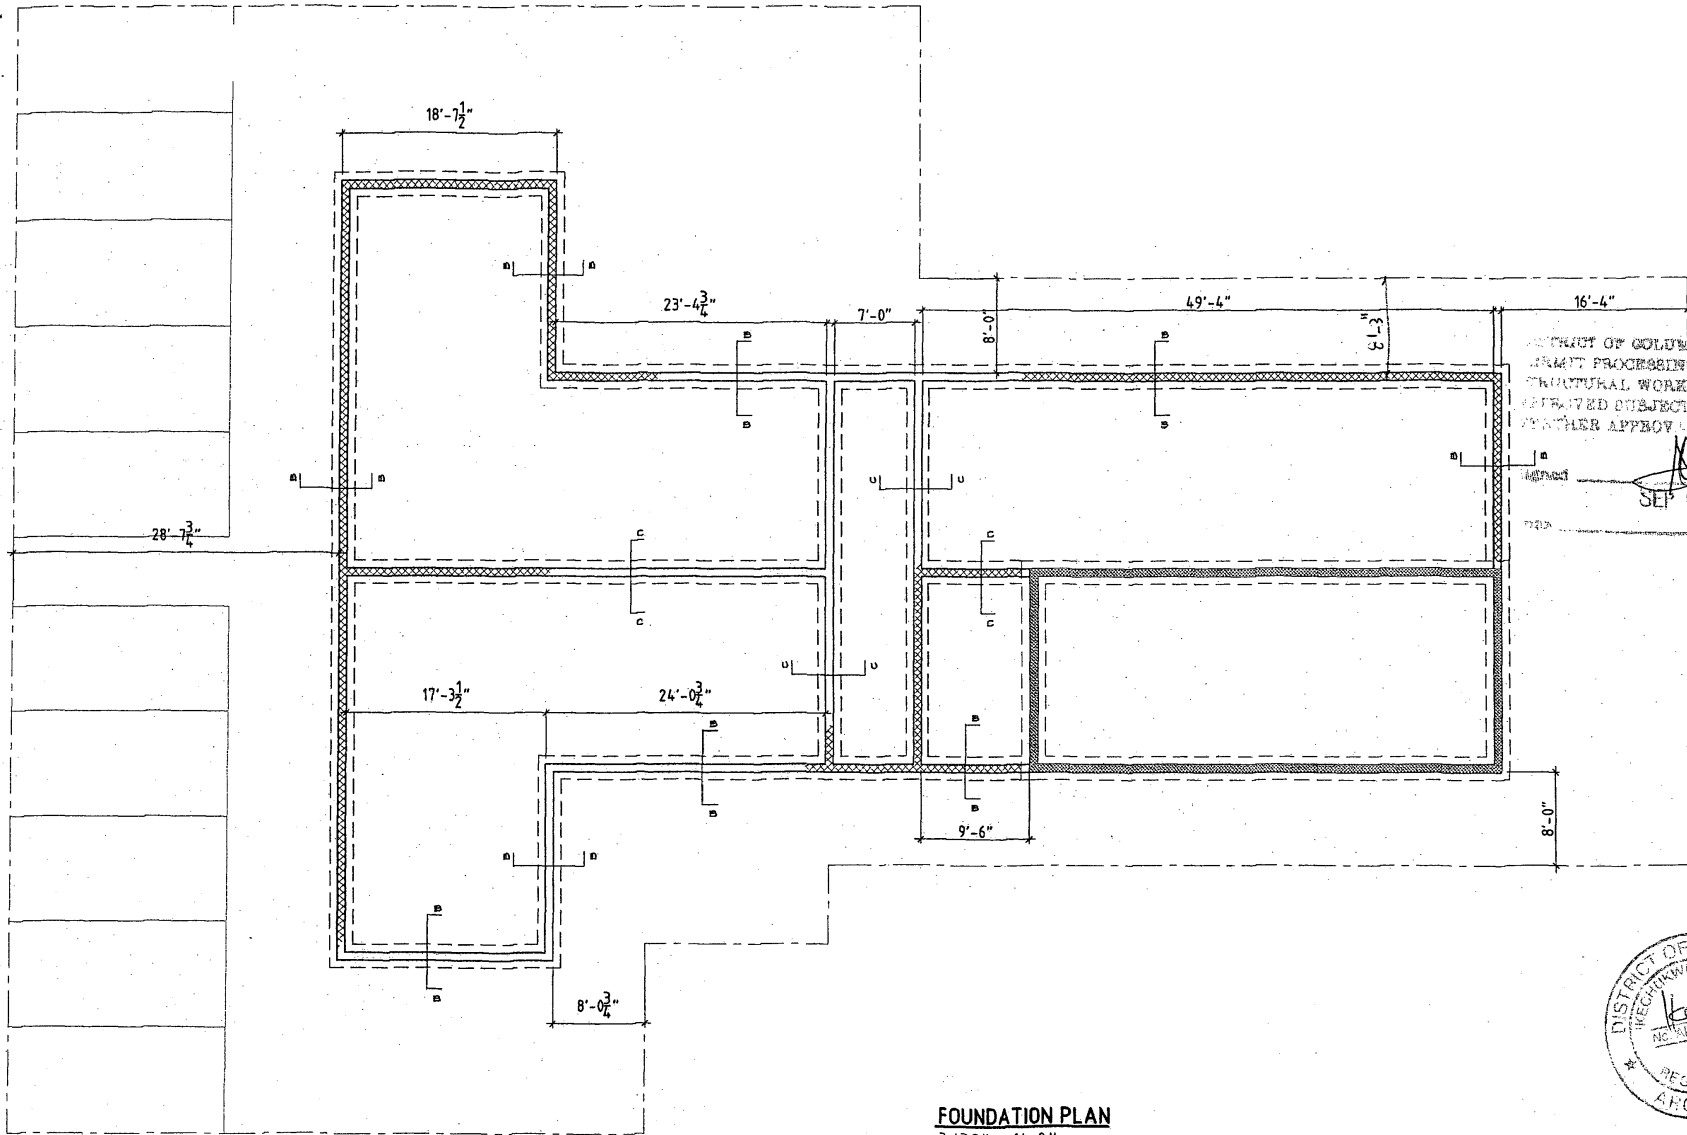

DISTRICT OF COLUMBIA
 PERMIT PROCESSING DIVISION
 STRUCTURAL WORK IN GENERAL
 PREPARED SUBJECT TO THE
 FURTHER APPROVAL OF CONSTRUCTION
 SEP 06 2006

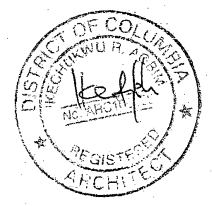


FOUNDATION PLAN
 3/32" = 1'-0"

FOUNDATION PERMIT:
 1233 MORSE STREET, NE
 SQUARE 4088, LOTS 810, 812, & 816
S-1

Diagram illustrating the gas supply line components and connections:

- DIRT TRAP POCKET
- TEE
- GAS COCK
- FROM GAS METER
- REGULATOR
- VENT LIMITER
- UNION
- APPLIANCE PRESSURE
- TO FURNACE (40MBH)
- TO STOVE (20MBH)
- TEE
- PLUG


- BLDG. SERVICE REGULATOR AND COCK SHALL BE SELECTED TO MATCH THE TOTAL LOAD (CFM) WITH OUTLET SET PRESSURE OF 5.5" W.C. @ 0.3" W.C. PRESSURE DROP.
- ALL METERS SHALL BE INSTALLED BY WASH. GAS CO.
- HORIZONTAL MAINS AND VERTICAL RISERS SHALL BE SCHEDULE 40 SWEETED BLACK STEEL.
- PROVIDE SLEEVES WHERE GAS PIPING PASSES THROUGH MASONRY WALLS, FLOORS AND CEILINGS.
- MASTER PLUMBER/GAS FITTER SHALL TEST ALL WORK.
- DORA SHALL INSPECT, APPROVE ALL WORK.

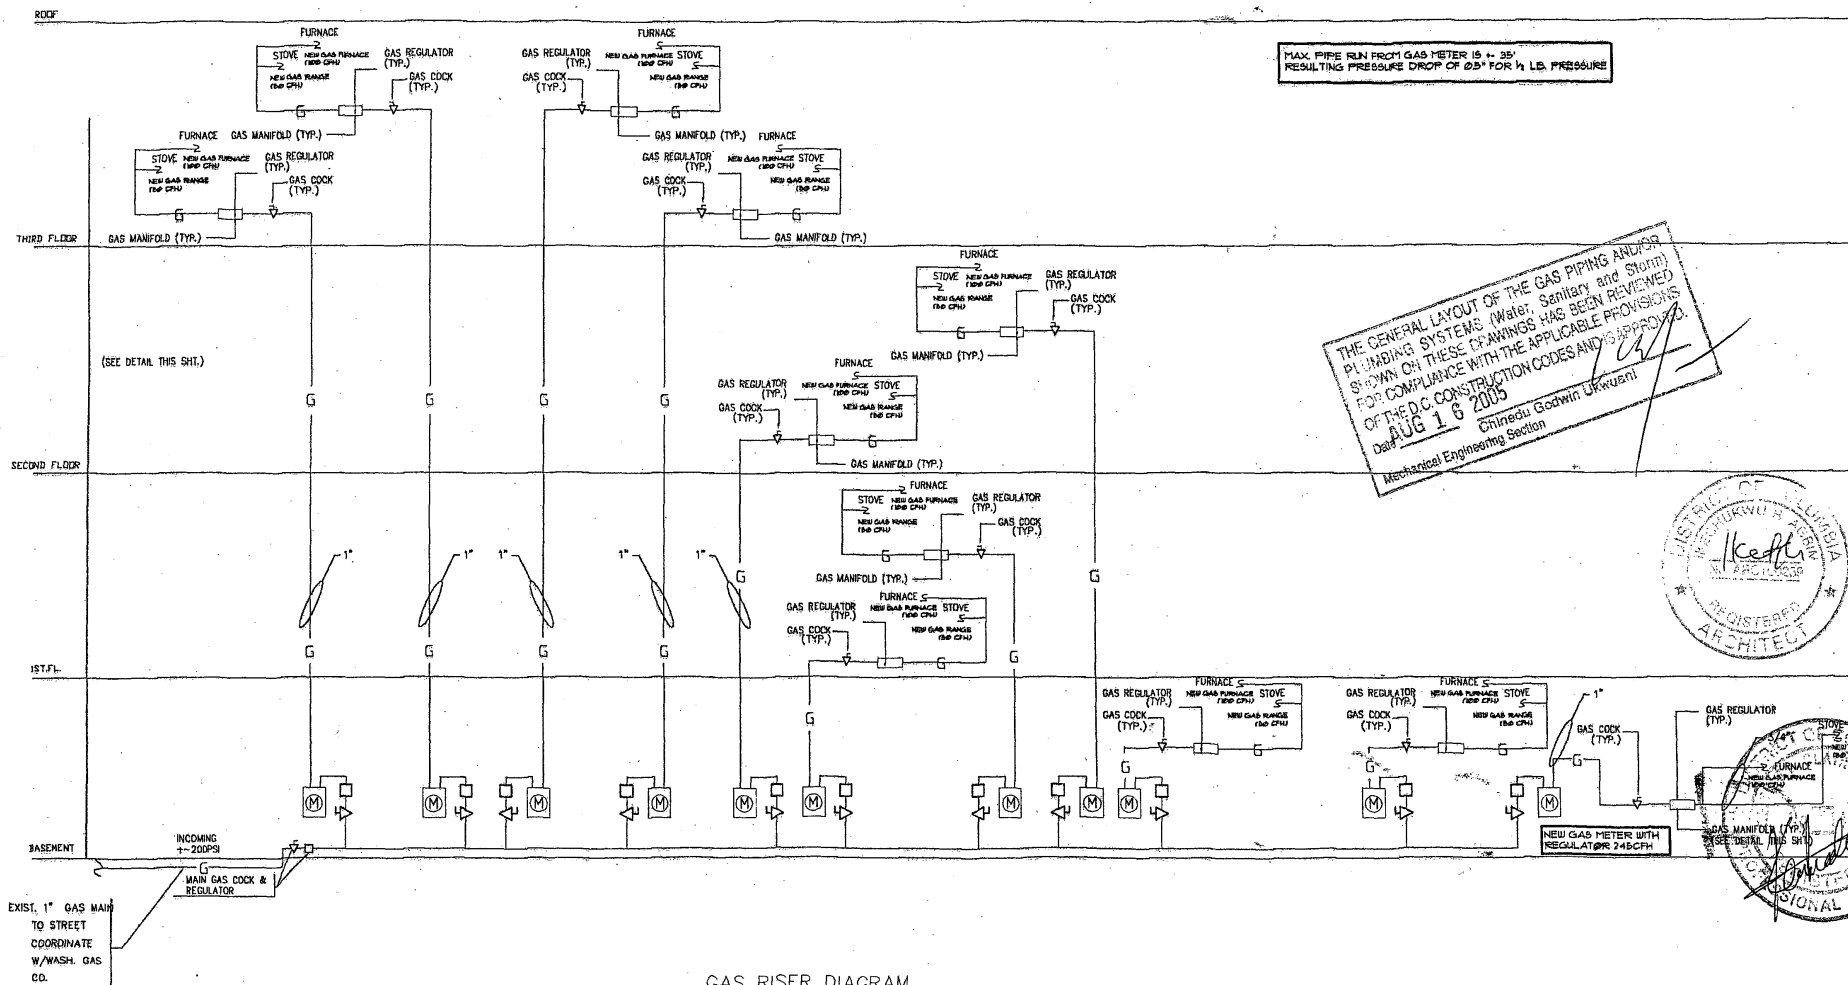

THE GENERAL LAYOUT OF THE GAS PIPING AND/OR PLUMBING SYSTEMS (Water, Sanitary and Storm) SHOWN ON THESE DRAWINGS HAS BEEN REVIEWED FOR COMPLIANCE WITH THE APPLICABLE PROVISIONS OF THE D.C. CONSTRUCTION CODES AND APPROVED.

[Signature]

AUG 16 2005 Ghinieda Godwin, Engineer
Mechanical Engineering Section

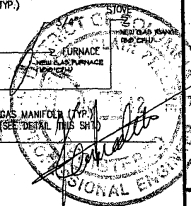

BUILDING PERMIT:
1233 MORSE STREET, NE
SQUARE 4069, LOT

P-2

DISTRICT OF COLUMBIA GOVERNMENT
OFFICE OF THE SURVEYOR

Washington, D.C., ~~DECEMBER 13, 2004~~

Plat for Building Permit of: SQUARE 4069 SITE PER SUB

Scale: 1 inch = 20 feet

Receipt No. 15967 21108

Furnished to: TAIWO DEMUREN

[Signature]
Surveyor, D.C.


By: B.D.M. *[Signature]*


I hereby certify that all existing Improvements shown hereon, are completely dimensioned, and are correctly platted; that all proposed buildings or construction, or parts thereof, including covered porches, are correctly dimensioned and platted and agree with plans accompanying the application; that the foundation plans as shown hereon is drawn, and dimensioned accurately to the same scale as the property lines shown on this plat; and that by reason of the proposed improvements to be erected as shown hereon the size of any adjoining lot or premises is not decreased to an area less than is required by the Zoning Regulations for light and ventilation; and it is further certified and agreed that accessible parking area where required by the Zoning Regulations will be reserved in accordance with the Zoning Regulations, and that this area has been correctly drawn and dimensioned hereon. It is further agreed that the elevation of the accessible parking area with respect to the Highway Department approved curb and alley grade will not result in a rate of grade along centerline of driveway at any point on private property in excess of 20% for single-family dwellings or flats, or in excess of 12% at any point for other buildings. (The policy of the Highway Department permits a maximum driveway grade of 12% across the public parking and the private restricted property.)

Date: 3/20/05


[Signature]
(Signature of owner or his authorized agent)

NOTE: Data shown for Assessment and Taxation Lots or Parcels are in accordance with the records of the Department of Finance and Revenue, Assessment Administration, and do not necessarily agree with deed description.

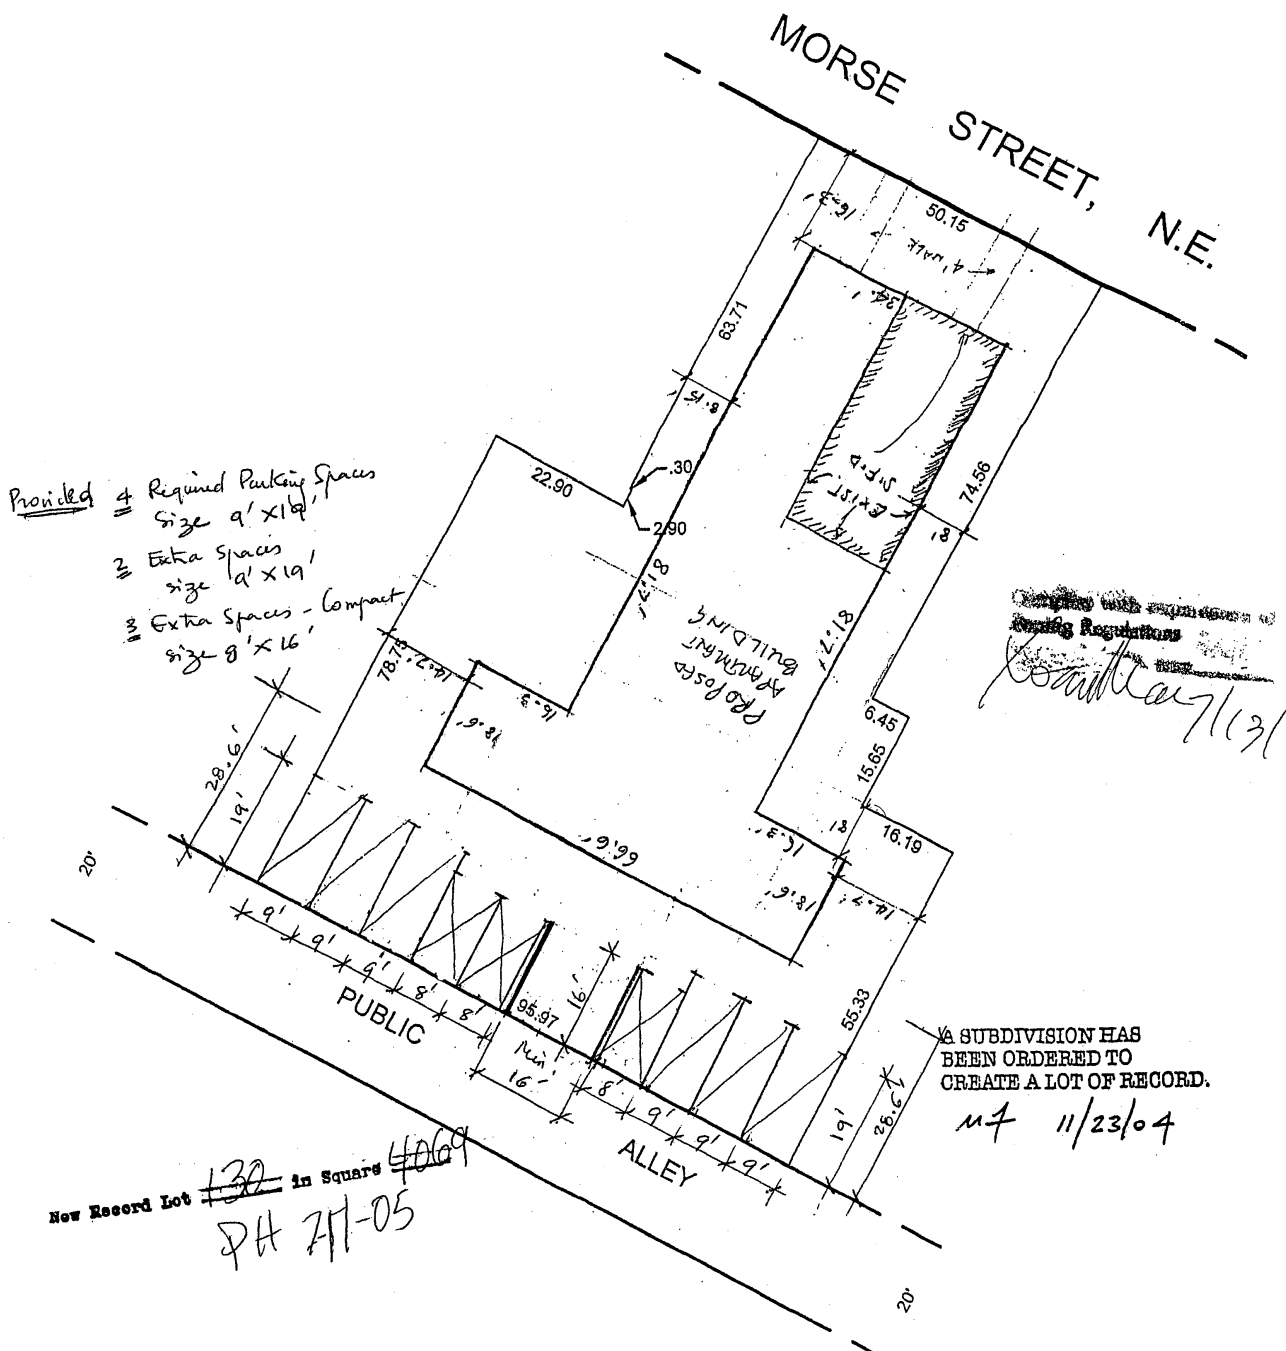

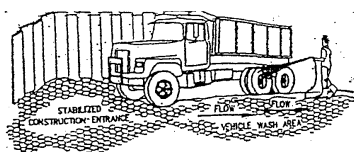


VEHICLE WASH DETAIL
(NOT TO SCALE)

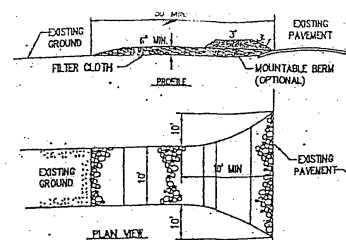

1 STABILIZED CONSTRUCTION ENTRANCE (NOT TO SCALE)


CONSTRUCTION RAMP SPECIFICATION

- STONE SIZE - USE 2" STONE, OR RECLAIMED OR RECYCLED CONCRETE EQUIVALENT.
- LENGTH - AS REQUIRED, BUT NOT LESS THAN 50 FEET (EXCEPT ON A SINGLE RESIDENCE LOT WHERE A 30 FOOT MINIMUM LENGTH WOULD APPLY).
- THICKNESS - NOT LESS THAN SIX (6) INCHES.
- WIDTH - TEN (10) FOOT MINIMUM, BUT NOT LESS THAN FULL WIDTH OF ALL POINTS OF INGRESS OR EGRESS OCCURS.
- FILTER CLOTH - WILL BE PLACED OVER THE ENTIRE AREA PRIOR TO PLACING OF STONE. FILTER WILL NOT BE REQUIRED ON A SINGLE FAMILY RESIDENCE LOT.
- SURFACE WATER - ALL SURFACE WATER FLOWING OR ORIENTED TOWARD CONSTRUCTION ENTRANCE SHALL BE PIRED ACROSS THE ENTRANCE. IF PIRING IS IMPRACTICAL, A MOUNTABLE BERM WITH 5:1 SLOPES WILL BE PERMITTED.
- MAINTENANCE - THE ENTRANCE SHALL BE MAINTAINED IN CONDITION WHICH WILL PREVENT TRACKING OR FLOWING OF SEDIMENT ONTO PUBLIC RIGHTS-OF-WAY. THIS MAY REQUIRE PERIODIC TOP DRESSING WITH ADDITIONAL STONE AS CONDITIONS DEMAND AND REPAIR AND/OR CLEANOUT OF ANY MEASURES USED TO TRAP SEDIMENT. ALL SEDIMENT SPILLED, DROPPED, WASHED OR TRACKED ONTO PUBLIC RIGHTS-OF-WAY MUST BE REMOVED IMMEDIATELY.
- WASHING - WHEELS SHALL BE CLEANED TO REMOVE SEDIMENT PRIOR TO ENTRANCE ONTO PUBLIC RIGHTS-OF-WAY. WHEN WASHING IS REQUIRED, IT SHALL BE DONE ON AN AREA STABILIZED WITH STONE WHICH DRAINS INTO AN APPROVED SEDIMENT TRAPPING DEVICE.
- PERIODIC INSPECTION AND NEEDED MAINTENANCE SHALL BE PROVIDED AFTER EACH RAIN.

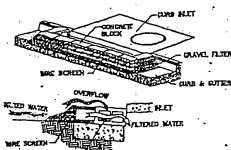

2 CURB INLET SEDIMENT FILTER (NOT TO SCALE)

- TWO CONCRETE BLOCKS SHALL BE PLACED ON THEIR SIDES ABUTTING THE CURB AT EITHER SIDE OF THE INLET OPENING.
- A 2 INCH BY 4 INCH STUD SHALL BE CUT AND PLACED THROUGH THE OUTER HOLES OF EACH SPACER BLOCK TO HELP KEEP THE FRONT BLOCKS IN PLACE.
- CONCRETE BLOCKS SHALL BE PLACED ON THEIR SIDES ACROSS THE FRONT OF THE INLET AND ABUTTING THE SPACER BLOCKS AS ILLUSTRATED.
- WIRE MESH SHALL BE PLACED OVER THE OUTSIDE VERTICAL FACE (NEBBING) OF THE CONCRETE BLOCKS TO PREVENT STONE FROM BEING WASHED THROUGH THE HOLES IN THE BLOCKS. CHECKED WIRE OR HANDMADE CLOTH WITH 1/2-INCH OPENINGS SHALL BE USED.
- TWO TO THREE INCH STONE SHALL BE PILED AGAINST THE WIRE TO THE TOP OF THE BARRIER AS SHOWN.
- IF THE STONE FILTER BECOMES CLOGGED WITH SEDIMENT SO THAT IT NO LONGER ADEQUATELY PERFORMS ITS FUNCTION, THE STONE MUST BE PULLED AWAY FROM THE BLOCKS, CLEANED AND REPLACED.

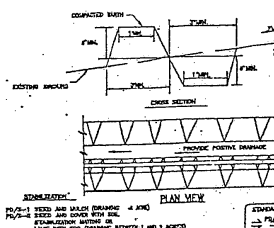


3 EARTH DIKE DETAIL (NOT TO SCALE)

Construction Specifications

- All perimeter dike/swales shall have an uninterrupted positive grade to an outlet. Spot elevations may be necessary for grades less than 1%.
- Runoff diverted from a disturbed area shall be conveyed to a sediment trapping device.
- Runoff diverted from an undisturbed area shall outlet into an undisturbed stabilized area of a non-erosive velocity.
- The swale shall be excavated or shaped to line, grade, and cross-section as required to meet the criteria specified in the standard.
- Fill shall be compacted by earth moving equipment.
- Stabilization with seed and mulch or as specified of the area disturbed by the dike and swale shall be completed within 7 days upon removal.
- Inspection and required maintenance shall be provided after each rain event.



Note: The maximum drainage area for this practice is 2 acres.
U.S. DEPARTMENT OF AGRICULTURE
SOIL CONSERVATION SERVICE

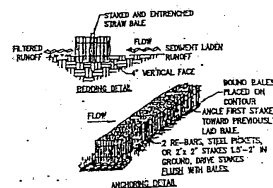

CONSTRUCTION SPECIFICATIONS

- BALES SHALL BE PLACED AT THE TOP OF A SLOPE OR ON THE CONTIGUOUS AND IN A ROW WITH ENDS TIGHTLY ABUTTING THE ADJACENT BALES.
- EACH BALE SHALL BE EMBOSSED IN THE SOIL A MINIMUM OF (4) INCHES, AND PLACED SO THAT BROWNS ARE HORIZONTAL.
- BALES SHALL BE SEQUENTIALLY ANCHORED IN PLACE BY OTHER TWO STAKES OR 16-GAUGE DRIVEN THROUGH THE BALE. THE FIRST STAKE IN EACH BALE SHALL BE DRIVEN TOWARD THE PREVIOUSLY Laid BALE AT AN ANGLE TO FORCE THE BALES TOGETHER. STAKES SHALL BE DRIVEN WITHIN THE BALE.
- WORKING SHALL BE FREQUENT AND REPAIR REPLACEMENT SHALL BE MADE PROMPTLY AS NEEDED.
- BALES SHALL BE REMOVED WHEN THEY HAVE SERVED THEIR USEFULNESS SO AS NOT TO BLOCK OR IMPED STORM FLOW OR DRAINAGE.

6 STRAW BALE DIKE DETAIL (NOT TO SCALE)

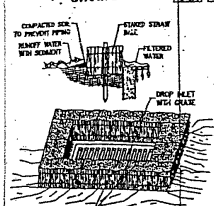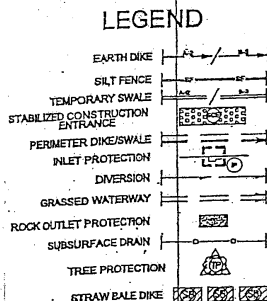

5 STRAW BALE DROP INLET SEDIMENT FILTER (NOT TO SCALE)

SPECIAL APPLICATION


THIS METHOD OF INLET PROTECTION IS APPLICABLE WHERE THE INLET AREA IS RELATIVELY SMALL AND FLOWS ARE NOT EXCEEDING 0.5 CFS PER FOOT OF WIDTH. THE METHOD SHOULD NOT BE APPLIED TO THE FLOW OF CONCENTRATED FLOWS, SUCH AS IN STREET OR HIGHWAY DRAINAGE.

SEDIMENT CONTROL NOTES

- ALL SEDIMENT AND EROSION CONTROL MEASURES SHALL BE INSTALLED BEFORE THE START OF ANY EXCAVATION AND/OR CONSTRUCTION AS PER STANDARDS AND SPECIFICATIONS FOR SOIL EROSION AND SEDIMENT CONTROL FOR THE DISTRICT OF COLUMBIA. IF AN ON-SITE INSPECTION REVEALS FURTHER EROSION CONTROL MEASURES ARE NECESSARY, THE SAME SHALL BE PROVIDED.
- ALL DEBRIS IS TO BE REMOVED FROM THE SITE.
- ALLEY AND / OR STREET SHALL BE SWEEP CLEAN AT ALL TIMES DURING EXCAVATION AND CONSTRUCTION.
- ALL SEDIMENT AND EROSION CONTROL MEASURES TO BE INSPECTED DAILY BY THE CONTRACTOR. ANY DAMAGED DEVICE OR MEASURE WILL BE REPAIRED OR REPLACED BY THE CLOSE OF DAY OR AS DIRECTED BY THE ARCHITECT.
- ALL VEHICLES LEAVING THE SITE SHALL EXIT THROUGH THE CONSTRUCTION ENTRANCE ONLY AND SHALL BE WASHED DOWN TO REMOVE MUD FROM TIRES BEFORE ENTERING THE STREET. CONSTRUCTION ENTRANCE TO BE MAINTAINED IN GOOD WORKING CONDITIONS.
- ALL CATCH BASINS AND AREA DRAINS SHALL BE PROTECTED DURING EXCAVATION AND CONSTRUCTION.
- IF ANY CATCH BASIN OR DRAIN BECOMES CLOGGED AS A RESULT OF EXCAVATION OR CONSTRUCTION, THE CONTRACTOR SHALL BE RESPONSIBLE FOR ITS IMMEDIATE CLEANING.
- ALL DISTURBED AREAS WITHIN THE LIMIT OF DISTURBANCE BOUNDARY NOT SHOWN TO BE PAVED SHALL BE SEED OR SOODED AS PER DC SPECIFICATIONS WITHIN SEVEN DAYS OF DISTURBANCE.
- ANY STOPPING, REGARDLESS OF LOCATION ON SITE SHALL BE STABILIZED WITHIN 14 DAYS AND COVERED WITH PLASTIC OR CANVAS. AFTER ITS ESTABLISHMENT AND FOR THE DURATION OF THE PROJECT.
- AFTER RAZE OR DEMOS, THERE IS NEED FOR GROUND COVER TO PREVENT EROSION AND SEDIMENT RUNOFF FROM OCCURRING, SUCH AS SEED, SOO, PAVING, BROCKBARK OR MULCH, ETC.
- AT THE COMPLETION OF CONSTRUCTION PROJECT AND AFTER THE D.C. EROSION AND SEDIMENT CONTROL INSPECTOR APPROVAL, ALL TEMPORARY STABILIZATION AND SEDIMENT CONTROL MEASURES AND DEVICES SHALL BE REMOVED AND ALL DISTURBED AREAS SHALL BE PERMANENTLY STABILIZED.

SEQUENCE OF CONSTRUCTION

- ALL EROSION AND SEDIMENT CONTROL MEASURES SHALL BE PLACED PRIOR TO OR AS THE FIRST STEP IN GRADING.
- PROVIDE TEMPORARY STONE CONSTRUCTION ENTRANCE WHERE SHOWN, PROVIDE WATER SOURCE AND FLOW TO.
- INSTALL SILT FENCE AROUND PERIMETER OF SITE.
- NO DISTURBED AREA WILL BE EXPOSED FOR MORE THAN 7 CALENDAR DAYS. INSTALL THE NECESSARY TEMPORARY OR PERMANENT VEGETATIVE STABILIZATION MEASURES TO ACHIEVE ADEQUATE EROSION AND SEDIMENT CONTROL.
- ALL CONSTRUCTION TO BE INSPECTED DAILY BY THE CONTRACTOR, AND ANY DAMAGED SITUATION OR EROSION CONTROL DEVICES OR MEASURES WILL BE REPAIRED AT THE CLOSE OF THE DAY.
- ALL SILT FENCE TO BE MAINTAINED IN WORKING CONDITION.
- STABILIZED CONSTRUCTION ENTRANCES TO BE PERIODICALLY SUPPLEMENTED WITH ADDITIONAL STONE AS NEEDED.
- CONTROLS WILL BE REMOVED AFTER THEIR CONTRIBUTING BASINS HAVE BEEN PERMANENTLY STABILIZED.

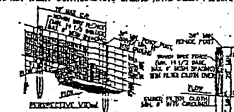

4 STABILIZED CONSTRUCTION ENTRANCE (NOT TO SCALE)

CONSTRUCTION NOTES FOR FABRICATED SILT FENCE

- WOVEN WIRE FENCE TO BE FASTENED SECURELY TO FENCE POSTS WITH WIRE TIES OR STAPLES.
- FILTER CLOTH TO BE FASTENED SECURELY TO WOVEN WIRE FENCE WITH TIES SPACED EVERY 24" AT TOP AND MID SECTION.
- WHEN TWO SECTIONS OF FILTER CLOTH ADJOIN, EACH OTHER THEY SHALL BE OVER-LAPPED BY SIX INCHES AND TIED.
- MAINTENANCE SHALL BE PERFORMED AS NEEDED AND MATERIAL REMOVED WHEN "BULGES" DEVELOP IN THE SILT FENCE.

POSTS: STEEL EITHER T OR U TYPE OR 2" HARDWOOD
FENCE: WOVEN WIRE, 14 1/2 GAUGE 6" MAX. MESH OPENING
FILTER CLOTH: FILTER X, W/400 100X, STAINLESS STEEL OR APPROVED EQUIV
PREFABRICATED UNIT: GEOTAF, ENVIROFENCE, OR APPROVED EQUIV

PLAN NUMBER

THIS APPROVAL IS FOR GRADING AND SEDIMENT CONTROL ONLY. PERMITTEE/CONTRACTOR IS REQUIRED TO CONSTRUCT DESIGN FEATURE SHOWN HEREON. HE SHALL NOTIFY THIS OFFICE AT (202)637-4100 AT LEAST 24 HOURS BEFORE START OF GRADING ACTIVITY AND WITHIN TWO WEEKS AFTER COMPLETION OF PROJECT FOR FINAL INSPECTION.


SEDIMENT AND EROSION CONTROL PLAN & DETAILS

FOUNDATION PERMIT:

1233 MORSE STREET, NE
SQUARE 4089, LOTS 810, 812, & 816

C-1

2 of 5

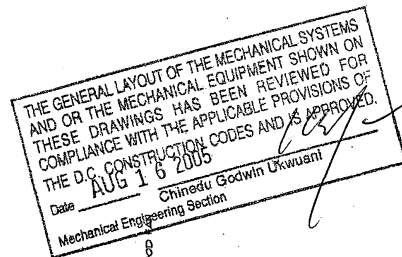

M-3

