



20' PUBLIC ALLEY

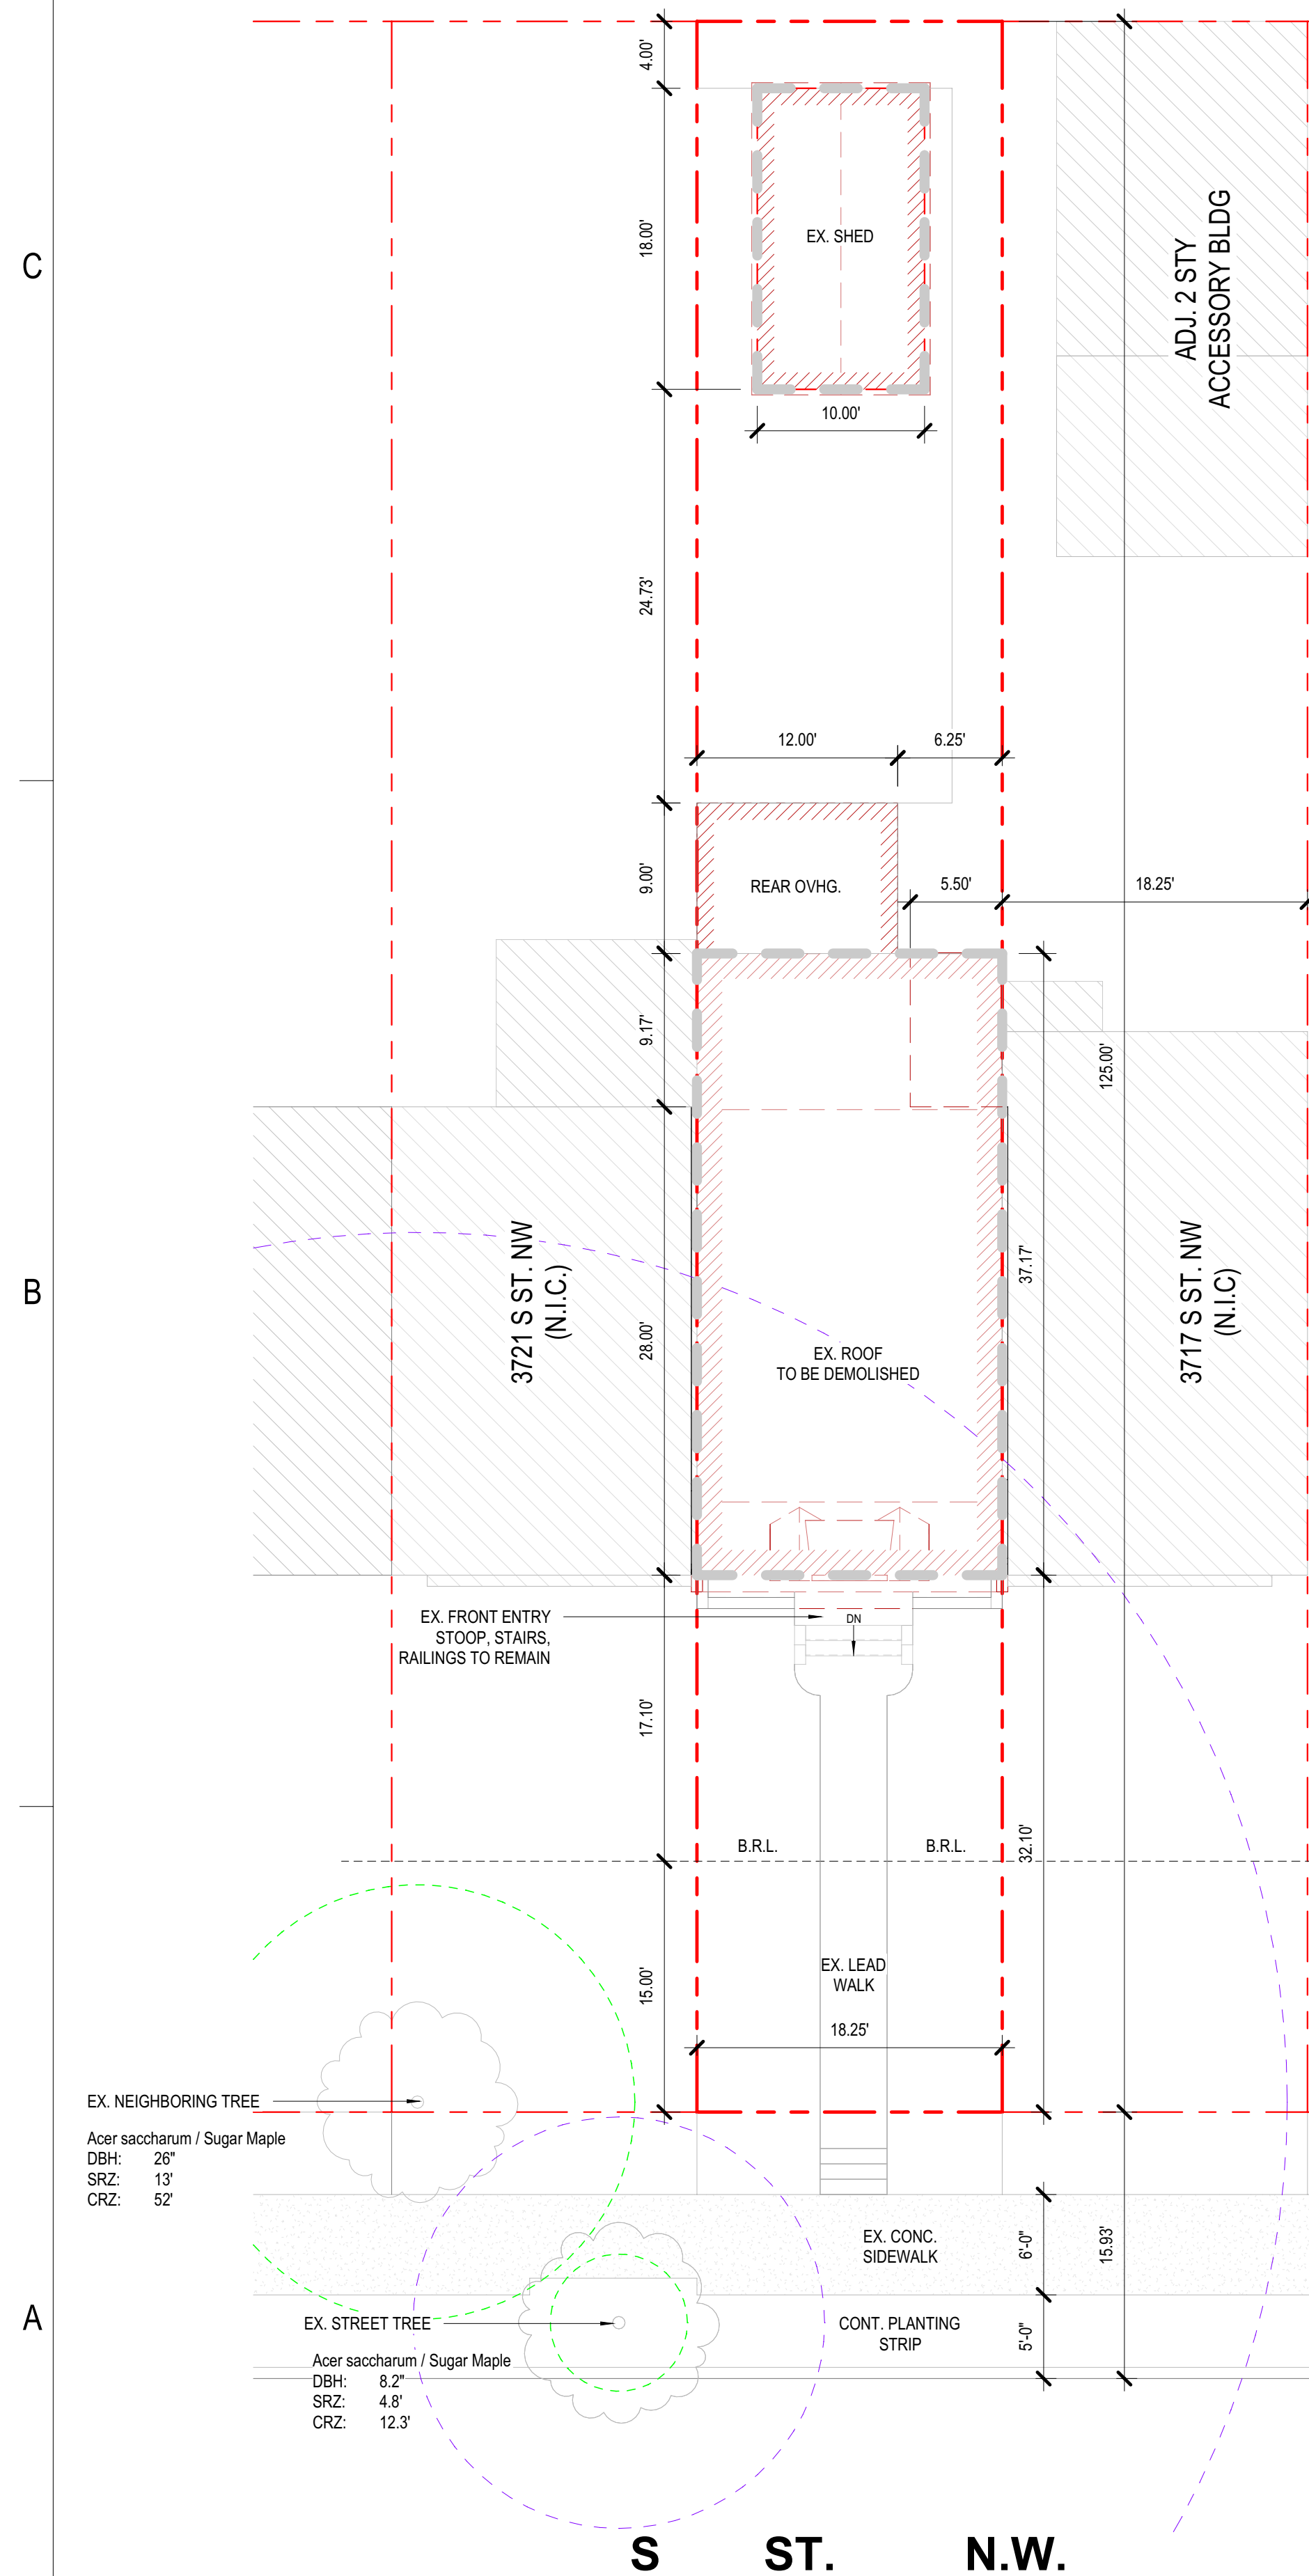

1 EXISTING SITE PLAN

20' PUBLIC ALLEY

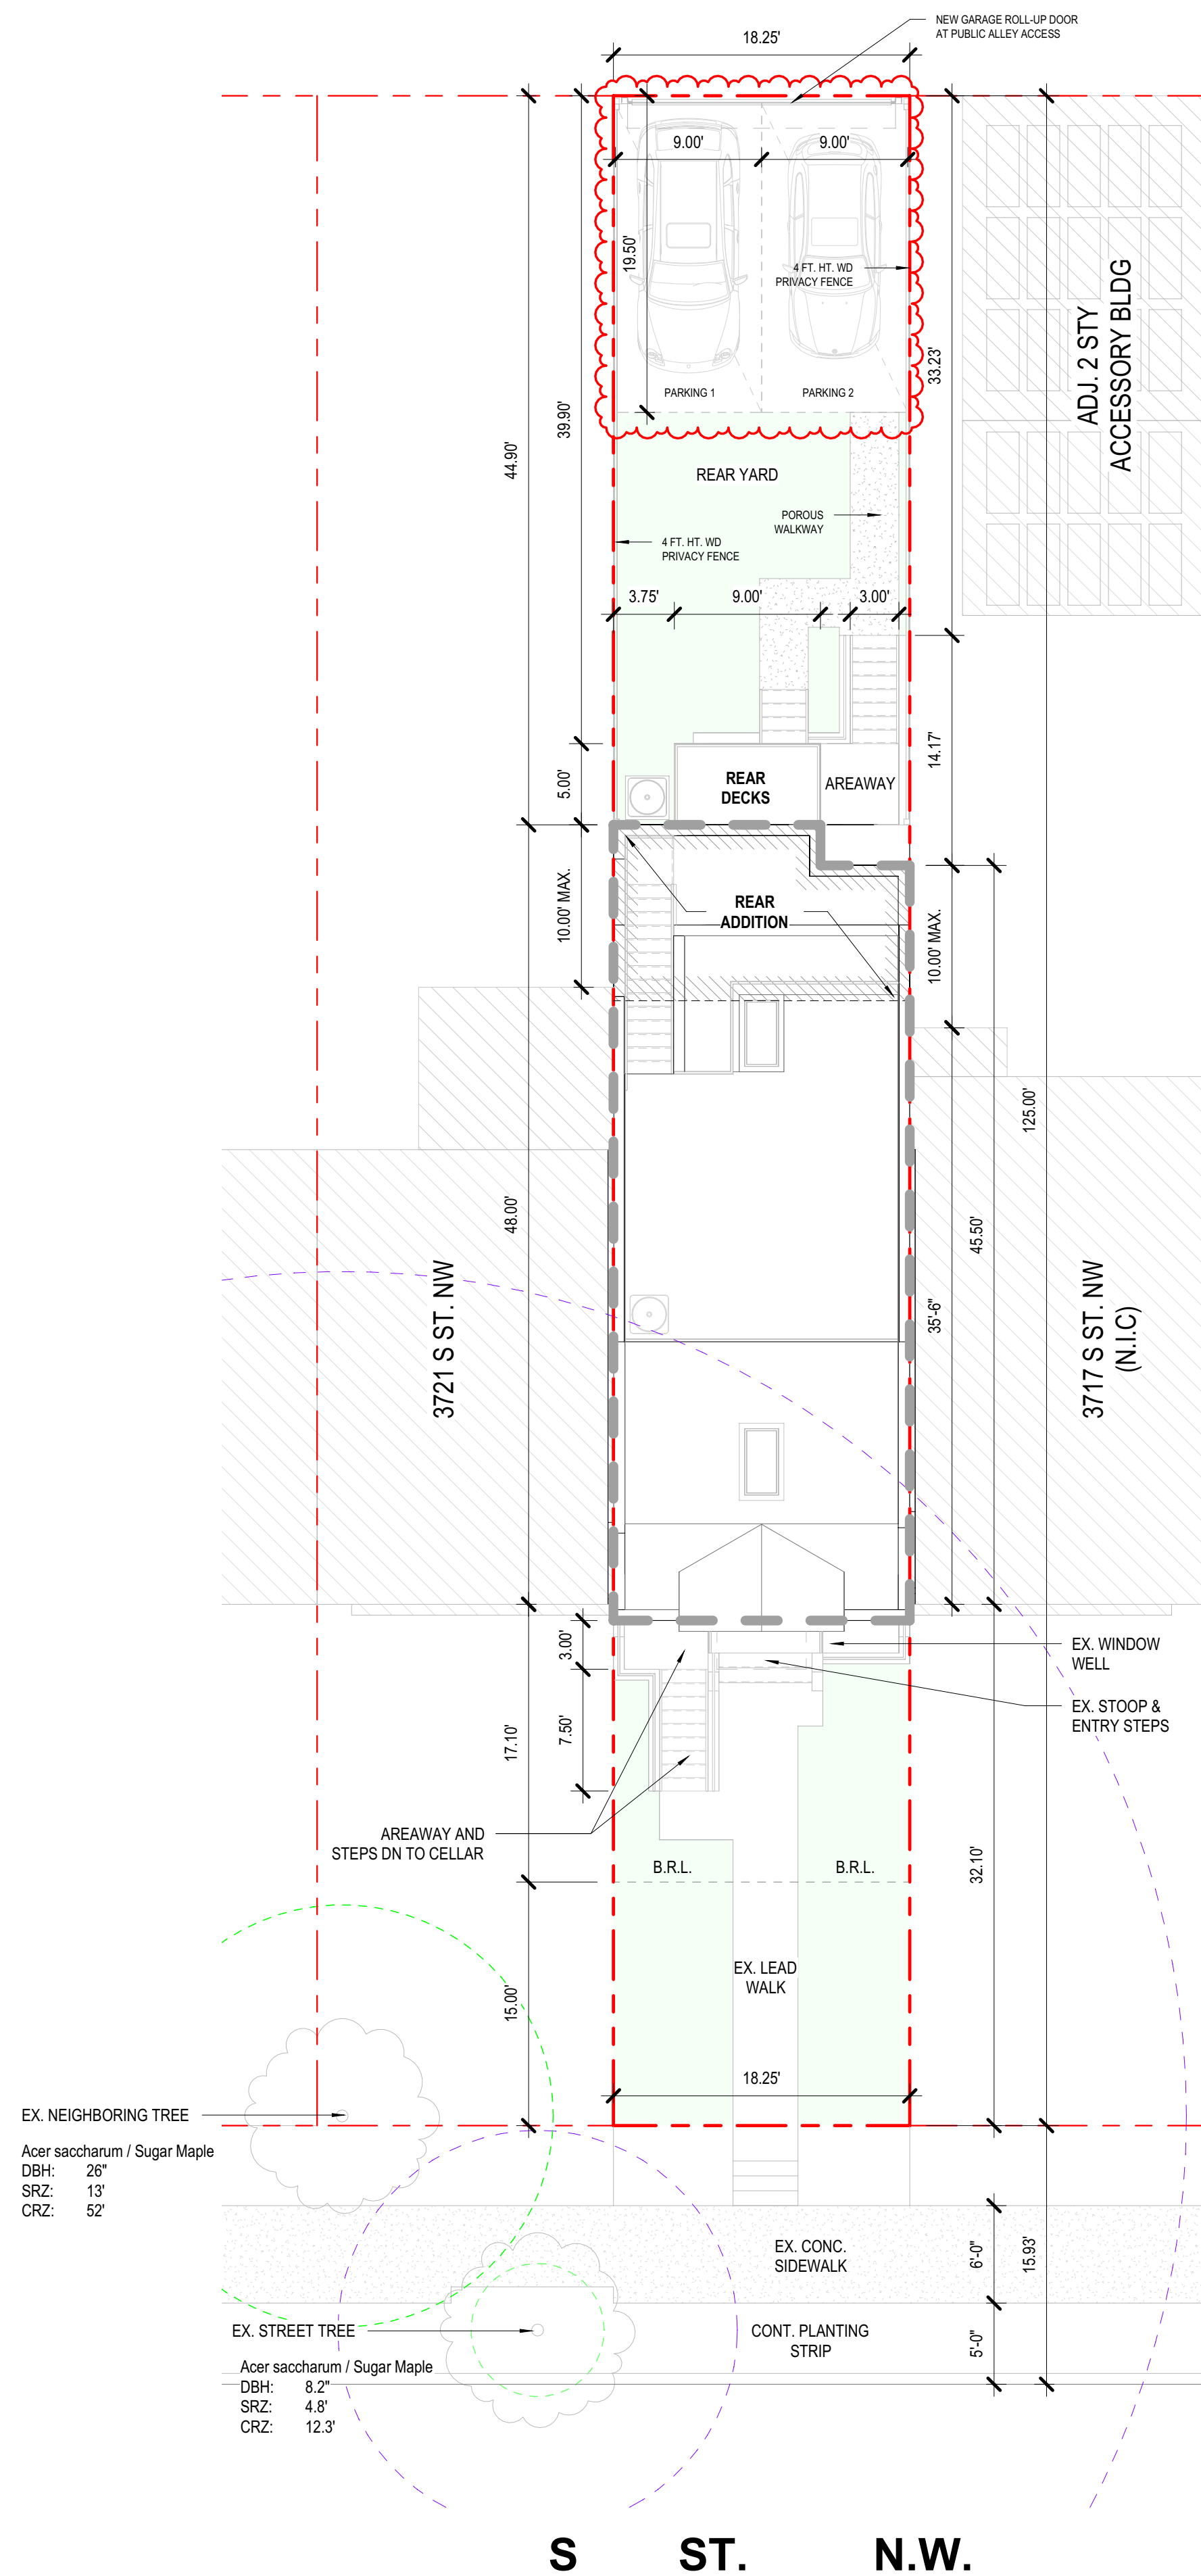

2 PROPOSED SITE PLAN

BUILDING LOCATION
3719 S STREET N.W.



A - VICINITY MAP

BUILDING INFORMATION

BUILDING AREA AND INFO

ADDRESS: 3719 S ST NW
SQ / LOT: 1380 / 0063
ZONING: R-3/GT

EX. LOT AREA: 2,281 SF

EX. MAIN BLDG:	678 SF
REAR ADDITION:	184 SF
REAR DECK:	45 SF

LOT COVERAGE: 907 SF (39.76%)

BUILDING AREA

MAIN BUILDING AREAS BY FLOOR:

CELLAR	876 SF (NOT INCLUDED IN G.F.A.)
1ST FLOOR	862 SF
2ND FLOOR	862 SF
3RD FLOOR	763 SF

.....

GROSS FLOOR AREA (G.F.A.)	2,487 SF
---------------------------	----------

TOTAL SF W/ CELLAR	3,363 SF
--------------------	----------

1ST FLR REAR DECK	45 SF
2ND FLR REAR DECK	45 SF
3RD FLR ROOF TERR.	98 SF
ROOF DECK	430 SF

ZONING INFO / ANALYSIS

MISC

BUILDING HEIGHT: MAX. ALLOWED: 35'-0"
PROPOSED: 33'-1"

STORIES: ALLOWED: 3
PROPOSED: 3 (PLUS CELLAR)

FRONT YARD: MIN. REQUIRED: CONST. W/ 1 ADJ. PROP.
PROPOSED: N/A - NO CHANGE

SIDE YARD: MIN. REQUIRED: N/A - EX. ROW DWELLING
PROPOSED: N/A

REAR YARD: MIN. REQUIRED: 20'-0"
PROPOSED: 39'-11" TO REAR DECKS

LOT OCCUPANCY: MAX ALLOWED: 60% (1,368.6 SF)
PROPOSED: 1,202 SF (52.70%)

PERVIOUS AREA: MIN. REQUIRED: 20% (457 SF)
PROVIDED: 29.99% (684 SF)

PARKING:	REQUIRED:	N/A
	PROVIDED:	2 SPACES VIA PUBLIC ALLEY

DISTRICT OF COLUMBIA
 OPERATIONS DIVISION
 HAS APPROVED
 Date 03/07/24

These plans are conditionally approved as submitted or noted during plan review and are subject to field inspection. Approved plans must be kept on-site and are needed for all inspections. No changes or modifications to these plans. Changes require a revision permit with the revised plans. Trade Permits are required for trade work, e.g. Electrical or plumbing

07 2024
07 2024
3719 S ST NW
SINGLE-FAMILY ROWHOUSE
ADDITION & ALTERATION

	DATE	DESCRIPTION
	2023-1-31	PERMIT SET
1	2023-12-07	REV 01
2	2024-02-20	REV 02

DRAWING TITLE
**SITE PLAN AND ZONING
INFO**

STAMP

PROJECT NO.
FS200061

DRAWN BY:
Author

SCALE:
As indicated

DATE:
2023-10-31

DWG. NO.


0006

Board of Zoning Adjustment
District of Columbia
CASE NO.21202
EXHIBIT NO.6

SINGLE-FAMILY ROWHOUSE ADDITION & ALTERATION


DESCRIPTION

STAMP

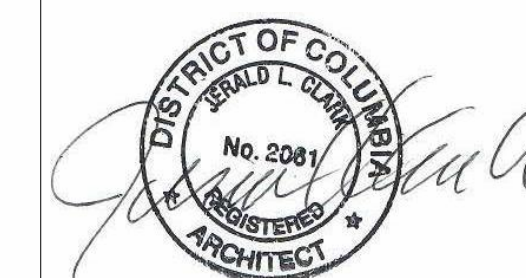

A


A504

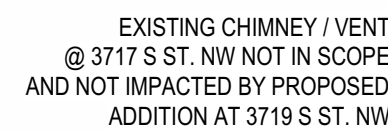

2



1

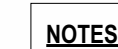

1