




DOOR TYPE

REFER TO ENERGY REQUIREMENT SHEET FOR EXTERIOR WINDOW SHGC VALUE

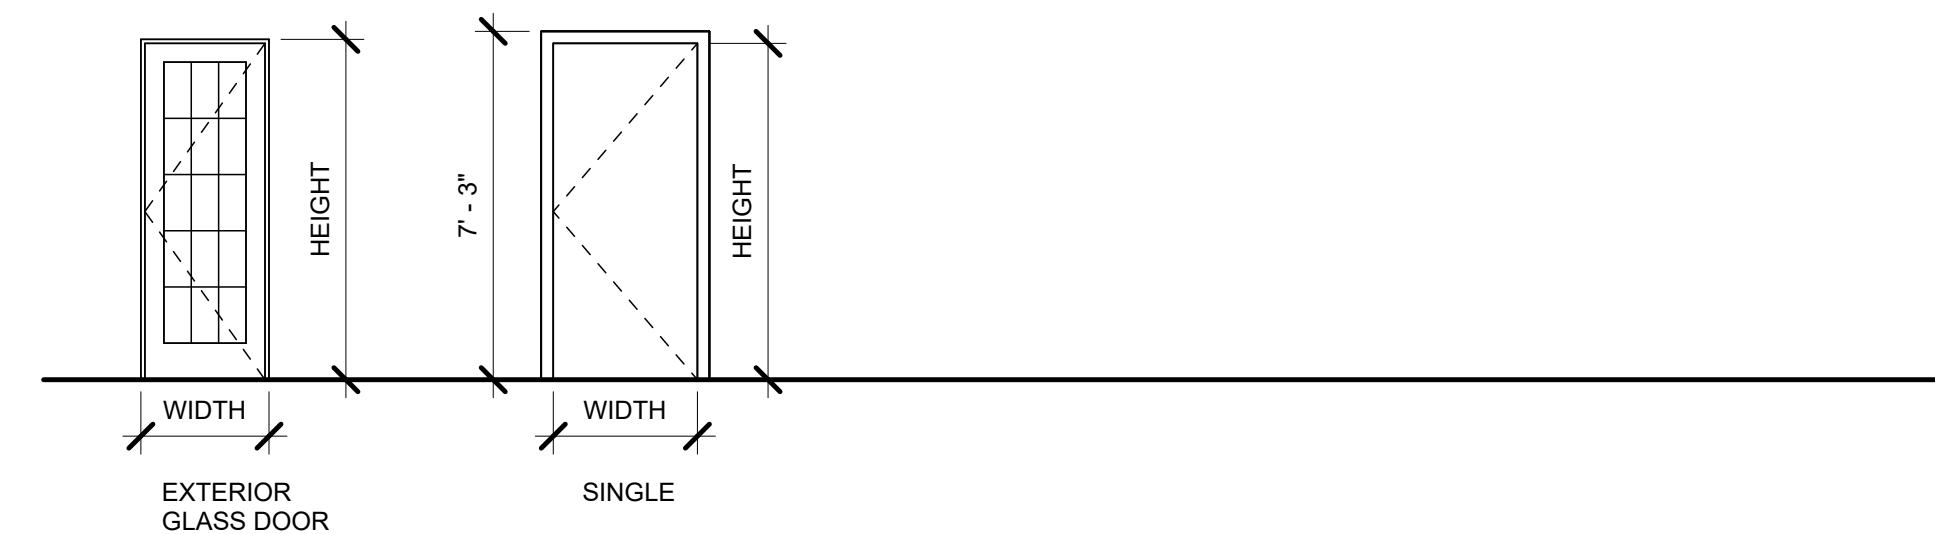

WINDOW TYPE

REFER TO ENERGY REQUIREMENT SHEET FOR WINDOW SHGC: VAI

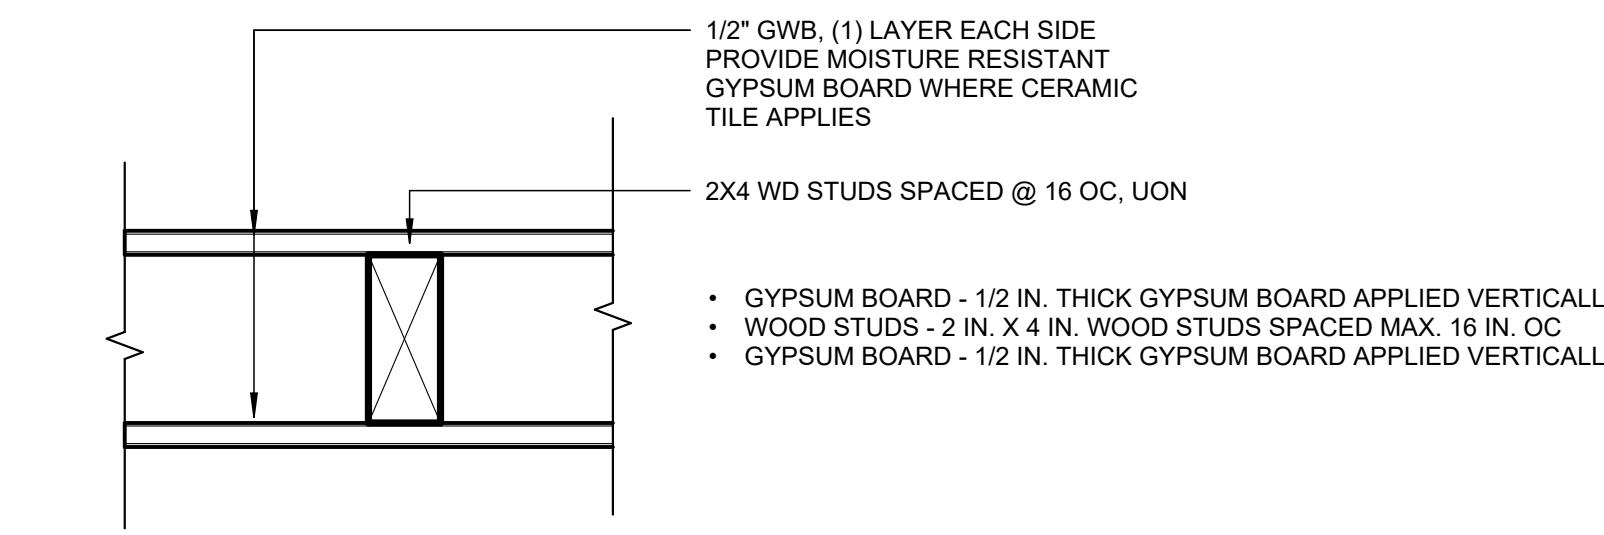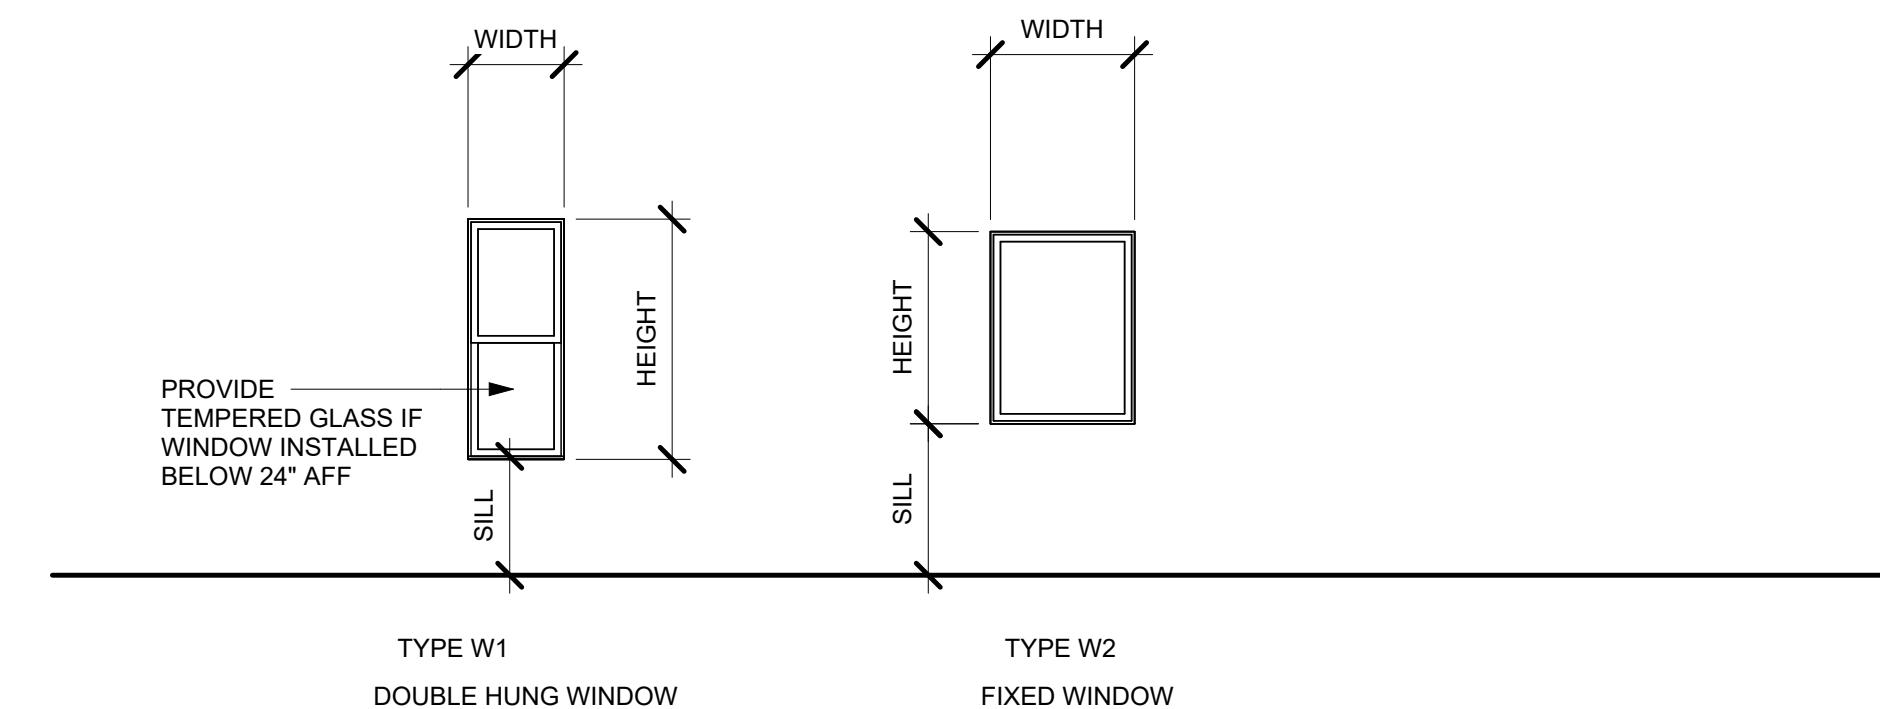

WALL TYPE 0A
PARTITION TYPE 0

FIRE RATING: 0 HOUR
INTERIOR PARTITIONS - WOOD ST

Room Schedule

WT	Name	Number	Area	Wall Finish	Floor Finish
BASEMENT	LIVING	B101	335 SF		
BASEMENT	KIT	B102	196 SF		
BASEMENT	HALL	B103	132 SF		
BASEMENT	MECH	B104	8 SF		
BASEMENT	HEATER	B105	6 SF		
BASEMENT	POWDER	B106	19 SF		
BASEMENT	W/D	B107	10 SF		
BASEMENT	WIC	B108	32 SF		
BASEMENT	BEDROOM	B109	157 SF		
BASEMENT	BATHROOM	B110	47 SF		
BASEMENT	BEDROOM	B111	208 SF		
BASEMENT	CL	B112	6 SF		
BASEMENT	CL	B113	6 SF		
BASEMENT	BATHROOM	B114	53 SF		
BASEMENT	PUMP	B115	8 SF		


DOOR SCHEDULE

DOOR SCHEDULE								
WT	ROOM NAME	Mark	Width	Height	Sill Height	Family	Phase Created	Remark
BASEMENT	LIVING	B101	3' - 0"	7' - 0"	0' - 0"	SINGLE	Existing	
BASEMENT	HALL	B104	3' - 0"	7' - 0"	0' - 0"	Bifold-4 Panel	Existing	
BASEMENT	HALL	B105	3' - 0"	7' - 0"	0' - 0"	Bifold-4 Panel	Existing	
BASEMENT	POWDER	B106	2' - 6"	7' - 0"	0' - 0"	Single-Pocket	Existing	
BASEMENT	HALL	B107	4' - 0"	7' - 0"	0' - 0"	Double-Panel 2	Existing	
BASEMENT	BEDROOM	B108	2' - 6"	7' - 0"	0' - 0"	SINGLE	Existing	
BASEMENT	BEDROOM	B109	4' - 0"	7' - 0"	0' - 0"	Double-Panel 2	Existing	
BASEMENT	BATHROOM	B110	2' - 6"	7' - 0"	0' - 0"	SINGLE	Existing	
BASEMENT	BEDROOM	B111	2' - 6"	7' - 0"	0' - 0"	SINGLE	Existing	
BASEMENT	BEDROOM	B111	2' - 6"	6' - 8"	1' - 0"	SINGLE	Existing	
BASEMENT	BEDROOM	B112	3' - 0"	7' - 0"	0' - 0"	Bifold-4 Panel	Existing	
BASEMENT	BEDROOM	B113	3' - 0"	7' - 0"	0' - 0"	Bifold-4 Panel	Existing	
BASEMENT	BEDROOM	B114	2' - 6"	7' - 0"	0' - 0"	SINGLE	Existing	
BASEMENT	LIVING	B115	2' - 0"	7' - 0"	0' - 0"	SINGLE	Existing	
BASEMENT	LIVING	B115A	2' - 0"	7' - 0"	0' - 0"	SINGLE	Existing	

WINDOW SCHEDULE

Floor	Type Mark	Family	Width	Height	Sill Height	Phase Created	Notes
BASEMENT	101	Double Hung	2' - 9"	4' - 5"	3' - 5"	Existing	
BASEMENT	101	Double Hung	2' - 9"	4' - 5"	3' - 5"	Existing	
BASEMENT	103	Fixed	3' - 0"	1' - 0"	6' - 0"	Existing	
BASEMENT	103	Fixed	3' - 0"	1' - 0"	6' - 0"	Existing	
BASEMENT	103	Fixed	3' - 0"	1' - 0"	6' - 0"	Existing	

Grand to

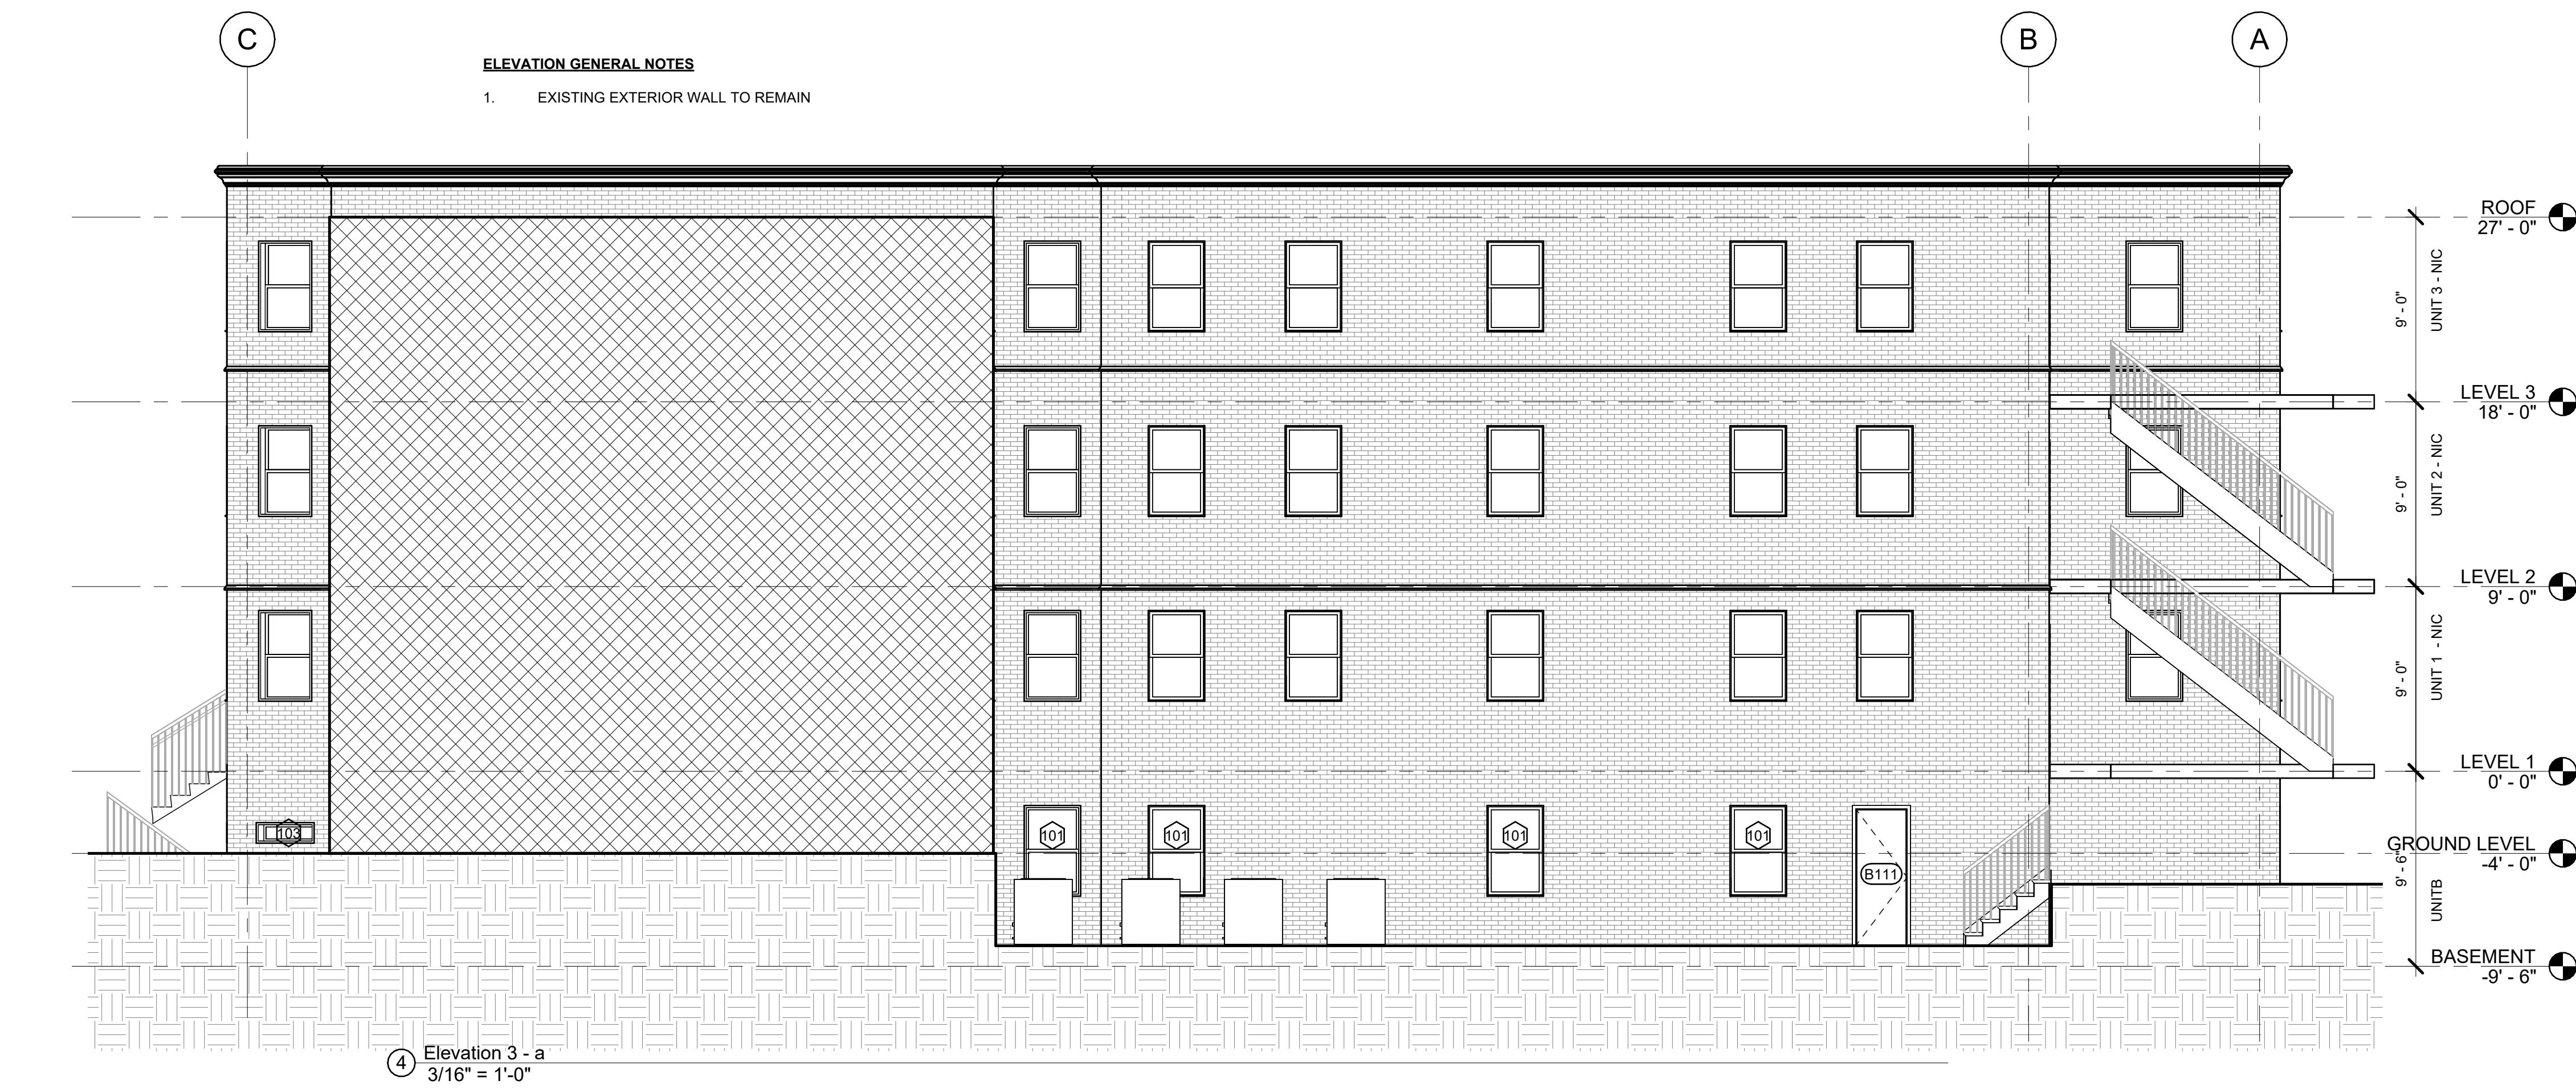

A&I Design


Architecture & Interiors planning
7373 McWhirter Pl.
Annandale, VA 22003
WWW.AldesignDC.com
703-507-3146

AS BUILT SET




3 Story Town Home

1332 Harvard St NW,
Washington, DC 20009

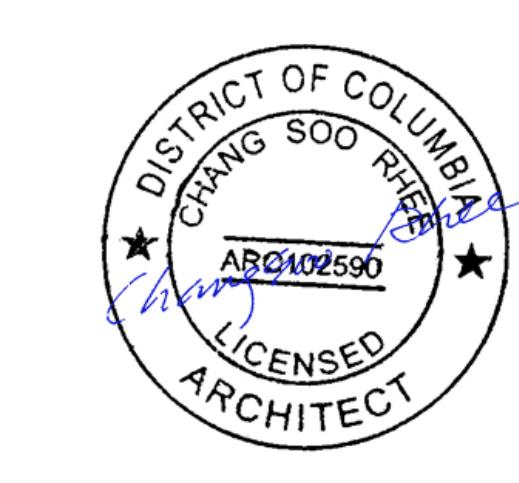

ELEVATIONS / SCHEDULES

Project number		
Date		
Drawn by	Auth	
Checked by	Check	
A301		
Scale	As indicated	

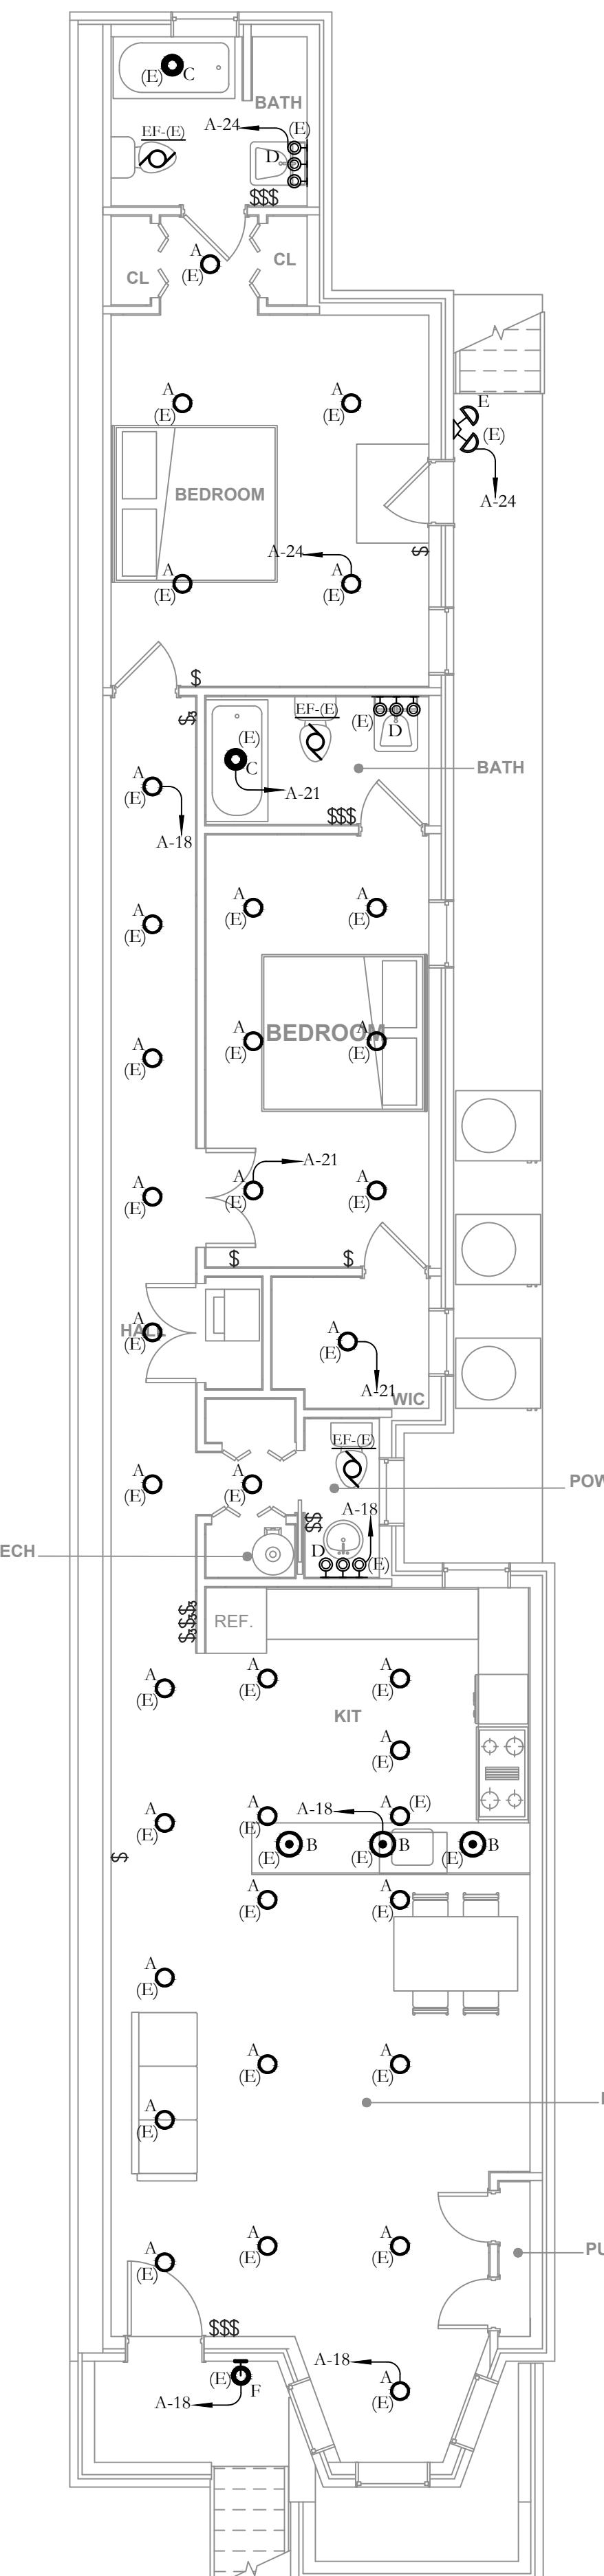

1 AS-BUILT BASEMENT FLOOR LIGHTING PLAN

SCALE: 3/16"=1'-0"

SCALE: 3/16"=1'-0"

LIGHTING FIXTURE SCHEDULE																				
AFF	ABOVE FINISHED FLOOR	EB	EMERGENCY BATTERY	P	PENDANT	R	RECESSED													
BFC	BELOW FINISHED CEILING	F	FLUORESCENT								S	SURFACE								
C	CEILING	PL	POLE								U	UNIVERSAL								
DL	DOWN LIGHT										W	WALL								
Fixture Type	Manufacturer	Catalog No.	LAMP No.	Volts	Mounting	Location	Remarks			Limens	Lumens/W	High Efficiency(Y,N)	Quantity	Total Watts						
A		EXISTING	-	1	24W LED	120	R	STAIRCASE	LED AIRTIGHT FIXED RECESSED DOWNLIGHT			2395	108	Y	36	864				
B		EXISTING	-	1	9W LED	120	P	KITCHEN	PENDANT LED			410	52	Y	3	27				
C		EXISTING	-	1	11W LED	120	R	AS SHOWN	LED WAFER LIGHT			790	72	Y	2	22				
D		EXISTING	-	3	14W LED	120	W	TOILETS	VANITY LED LIGHT			400	29	Y	3	42				
E		EXISTING	-	2	25W LED	120	W	EXTERIOR	LED OUTDOOR FLOOD LIGHT			2750	110	Y	1	25				
F		EXISTING	-	1	9W LED	120	W	EXTERIOR	LED SECURITY LIGHT			623	69	Y	1	9				
												TOTAL FIXTURES:	46							
												TOTAL ENERGY EFFICIENCY FIXTURES:	46							
												EFFICIENCY FIXTURES:	100%							
												TOTAL: 989 W								
												989 W / 1614 SF = 0.61 W/SF								

DESIGN NOTES:

A. ALL EXISTING LIGHTS MARKED WITH (E) ARE EXISTING TO REMAIN INTACT INCLUDING THEIR CIRCUITRY. UNLESS NOTED OTHERWISE.

A&I Design

**Architecture & Interiors planning
7373 McWhirter Pl.
Annandale, VA 22003
WWW.AldesignDC.com
703-507-3146**

AS BUILT SET



3 Story Town Home

1332 Harvard St NW,
Washington, DC 20009




11/26/2024



ENGINEERS LLC
Design - Consultants - Management - Permit
ADDRESS: 8318 LIBERIA AVE. MANASSAS VA, 20110
E : KHALID@LAMAENGINEERS.COM
LAMAENGINEERS@OUTLOOK.COM
TEL : 571-833-8357

AS-BUILT BASEMENT FLOOR LIGHTING PLAN

Project number	H096
Date	11/26/2024
Drawn by	S
Checked by	K
E200	
Scale	3/16" = 1'-0"

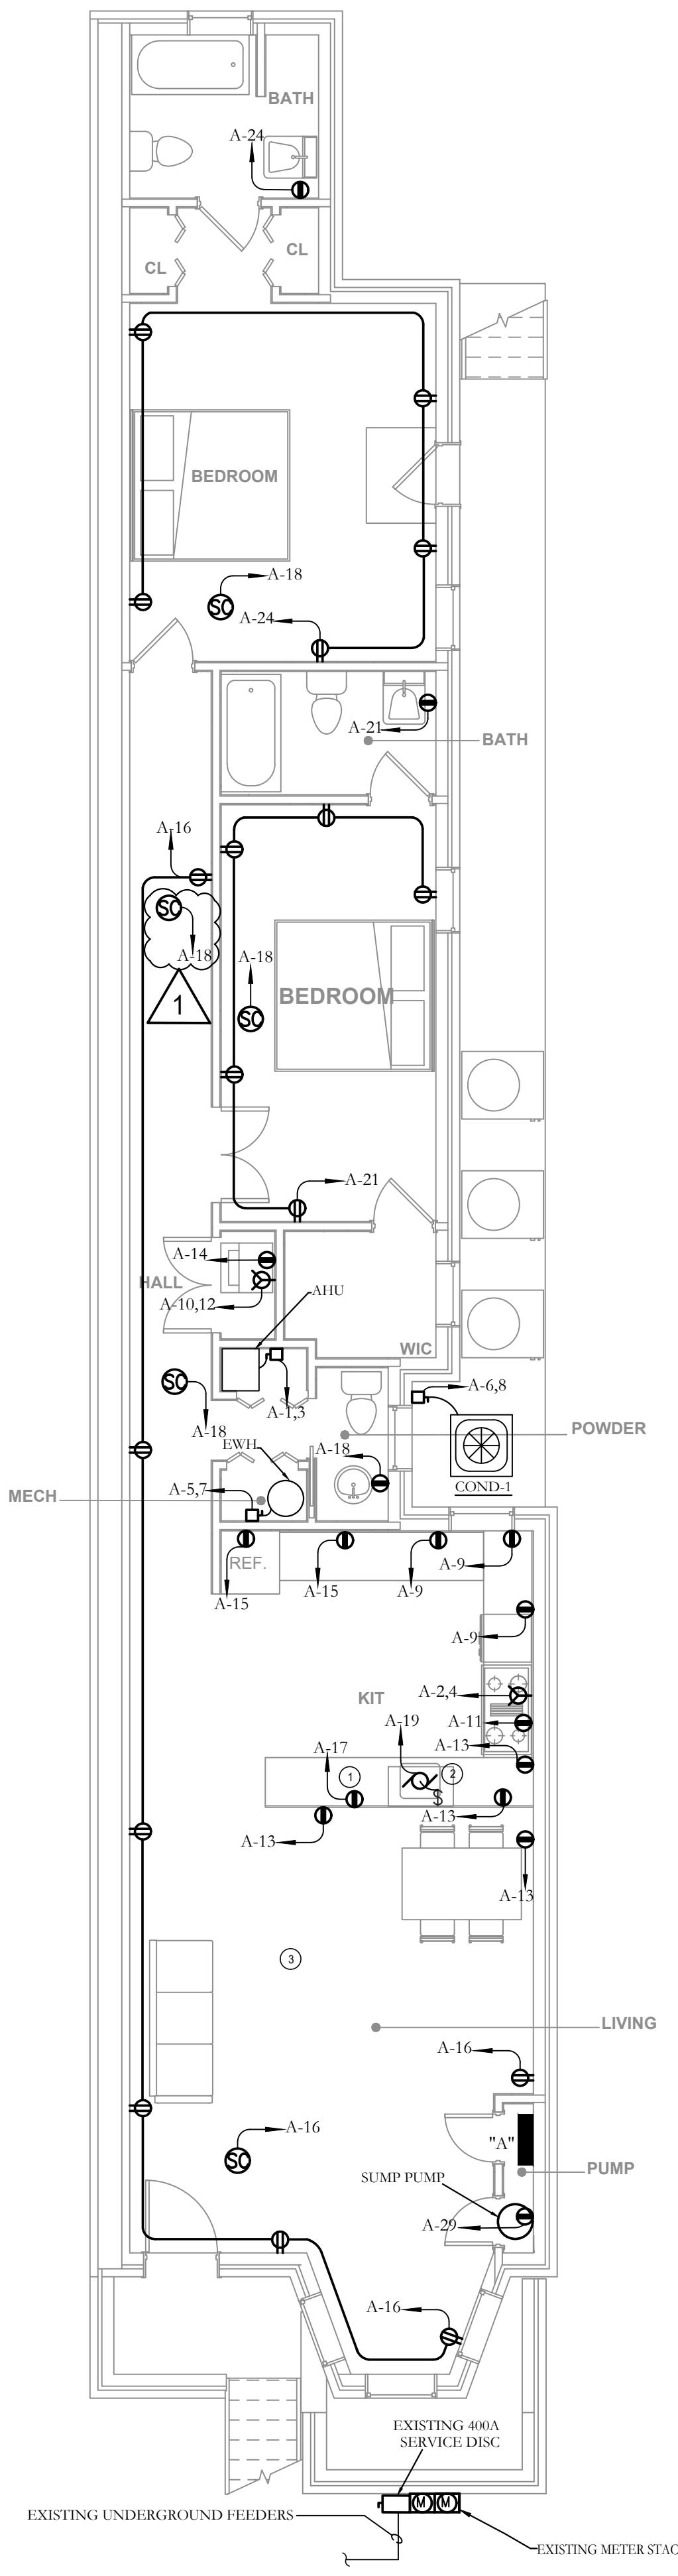

1 BASEMENT FLOOR POWER PLAN

SCALE: 3/16"=1'-0"

■ SCALE: 3/16"=1'-0"

MECHANICAL EQUIPMENT SCHEDULE

LOAD	V	PH	FLA	MCA	MOCP	FUSE	DISC.SWITCH	NEMA
COND-1	240	1	12	15	25	25	30	3R
AHU	240	1	42.4	53	60	60	60	1

GENERAL NOTES


- A. ALL 120 VOLT, 15 AND 20 AMP BRANCH CIRCUITS SUPPLYING OUTLETS OR DEVICES INSTALLED IN DWELLING UNIT KITCHENS, FAMILY ROOMS, DINING ROOMS, LIVING ROOMS, PARLORS, LIBRARIES, DENS, BEDROOMS, SUNROOMS, RECREATION ROOMS, CLOSETS, HALLWAYS, LAUNDRY AREAS, OR SIMILAR ROOMS OR AREAS SHALL BE PROTECTED BY A LISTED ARC-FAULT CIRCUIT INTERRUPTER, OR COMBINATION- TYPE, INSTALLED TO PROVIDE PROTECTION OF THE BRANCH CIRCUITS.(NEC 2014 210.12.)
- B. TAMPER RESISTANT RECEPTACLES ARE REQUIRED IN DWELLING AT ALL LOCATIONS EXCEPT WHERE THEY ARE MOUNTED HIGHER THAN 5-1/2 FEET ABOVE THE FLOOR OR IN A SPACE DEDICATED TO A SPECIFIC APPLIANCE.
- C. IN SLEEPING ROOMS OF GROUP R-2 OCCUPANCIES, THE AUDIBLE ALARM ACTIVATED BY A FIRE ALARM SYSTEM SHALL BE A 520-HZ LOW-FREQUENCY SIGNAL.

POWER KEYED NOTES

- ① DISHWASHER RECEPTACLE MUST BE ACCESSIBLE UNDER THE SINK.
- ② DISPOSAL RECEPTACLE MUST BE ACCESSIBLE UNDER THE SINK.
- ③ FIRE RATED CEILING THROUGHOUT THE UNIT.

GENERAL LIGHTING & POWER NOTES:

1. ALL LIGHTS AND EXHAUST FAN ARE NEW EXCEPT OUTDOOR LIGHT IS EXISTING TO REMAIN.
2. ALL EXISTING RECEPTACLES MARKED WITH (ER) ARE EXISTING RELOCATED.
3. PER IECC 404.1 LIGHTING EQUIPMENT:
A MINIMUM OF 90 PERCENT OF THE LAMPS IN PERMANENTLY INSTALLED LIGHTING FIXTURES SHALL BE HIGH-EFFICACY LAMPS OR A MINIMUM OF 90 PERCENT OF THE PERMANENTLY INSTALLED FIXTURES SHALL CONTAIN ONLY HIGH-EFFICACY LAMPS.
4. LIGHTING & POWER DRAWINGS ARE PROVIDED FOR LAYOUT PURPOSES ONLY.
5. PROVIDE OUTLETS PER CODE.
6. ALL SMOKE DETECTORS TO BE HARDWIRED AND INTERCONNECTED.
7. ALL ELECTRICAL TO MEET OR EXCEED CURRENT ELECTRICAL CODES.
8. RECESSED LIGHTS ARE IC RATED AT SOUND INSULATION AT BEDROOMS & BATHROOMS.
9. IC-RATED RECESSED LIGHTING FIXTURES TO BE SEALED AT HOUSING/INTERIOR FINISH & LABELED TO INDICATE GREATER THAN OR AT 2.0 CFM LEAKAGE AT 75 PA.
10. PROVIDE WET LOCATION RECESSED LIGHTS, AS NECESSARY.
11. ALL SMOKE / CARBON MONOXIDE DETECTORS TO BE LOW VOLTAGE, HARD WIRED & INTERCONNECTED.
12. PROVIDE AFCI OUTLETS PER NEC.
13. WHERE A GAS CONNECTION EXISTS, CARBON MONOXIDE DETECTOR SHALL BE PROVIDED.

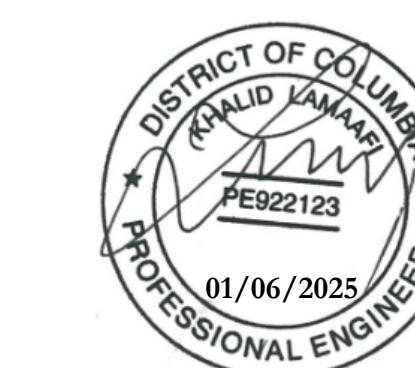

BASEMENT FLOOR POWER PLAN

Project number	H096
Date	11/26/2024
Drawn by	S
Checked by	K
E300	
Scale	3/16" = 1'-0"

E300

3/16" = 1'




3 Story Town Home

1332 Harvard St NW,
Washington, DC 20009



ENGINEERS LLC
Design - Consultants - Management - Permit
ADDRESS: 8318 LIBERIA AVE. MANASSAS VA, 20110
E : KHALID@LAMAENGINEERS.COM
LAMAENGINEERS@OUTLOOK.COM
TEL : 571-833-8357

TOTAL				LOAD CALCULATION							
				UNIT BASEMENT				TYPICAL UNIT 1,2,3			
I. A. GENERAL LOAD	6387S.F	x 3	VA	=	19161	I. A. GENERAL LOADSF	x 3	VA	1614 S.F x 3 VA = 4,842 VA
B. SMALL APPLIANCE LOADS	1,500 VA	x	8	=	12000	B. SMALL APPLIANCE LOADS	1,500 VA x 2 CIRCUITS	1,500	x 2	VA = 3,000 VA	1591 S.F x 3 = 4,773 VA
C. LAUNDRY LOAD	1,500 VA	x	4	=	6000	C. LAUNDRY LOAD	1,500 VA x 1	1500	x 1	VA = 1500 VA	1500 x 1 = 1,500 VA
-							SUBTOTAL				9,342 VA
							FIRST	3000 VA x 100%	3,000 VA		9,273 VA
							NEXT VA x 40%	6,342 VA x 40	% = 2,537 VA	3,000 VA x 40 % = 2,509 VA
								TOTAL			5,537 = 5,509
2. COOKING	8,000 VA	x	1	=	8,000	2. COOKING	8,000 VA x 1				8,000 VA
3. DRYER	5,000 VA	x	4	=	20,000	3. DRYER	5,000 VA x 1				5,000 VA
4. FIXED APPLIANCE LOADS						4. FIXED APPLIANCE LOADS					
DISPOSAL	800 VA	x	4	=	3,200	DISPOSAL	800 VA x 1				800 VA
MICROWAVE	1,000 VA	x	4	=	4,000	MICROWAVE	1,000 VA x 1				1,000 VA
REFRIGERATOR	800 VA	x	4	=	3,200	REFRIGERATOR	800 VA x 1				800 VA
DISHWASHER	1,000 VA	x	4	=	4,000	DISHWASHER	1,000 VA x 1				1,000 VA
SUMP PUMP	1,000 VA	x	1	=	1,000	SUMP PUMP	1,000 VA x 1				0 VA
WATER HEATER	3,500 VA	x	4	=	14,000	WATER HEATER	3,500 VA x 1				3,500 VA
5. HEATING OR COOLING LOAD						5. HEATING OR COOLING LOAD					
HEATING	8,500 VA	x	4	=	34,000	HEATING	8,500 VA x 1				8,500 VA
COOLING	2,000 VA	x	4	=	8,000	COOLING	2,000 VA x 1				2,000 VA
LARGEST LOAD						LARGEST LOAD					8,500 VA
6. LARGES MOTOR LOAD	400 VA					6. LARGES MOTOR LOAD	1,600 VA x 25%				400 VA
TOTALE	122,961 VA					TOTAL					400 VA
NECTABLE	220,84										
122,961 VA x 45% =	55,332 VA										
55,332 VA /240 V =	230.55 AMP										
EXISTING 400 AMP METER CENTER											

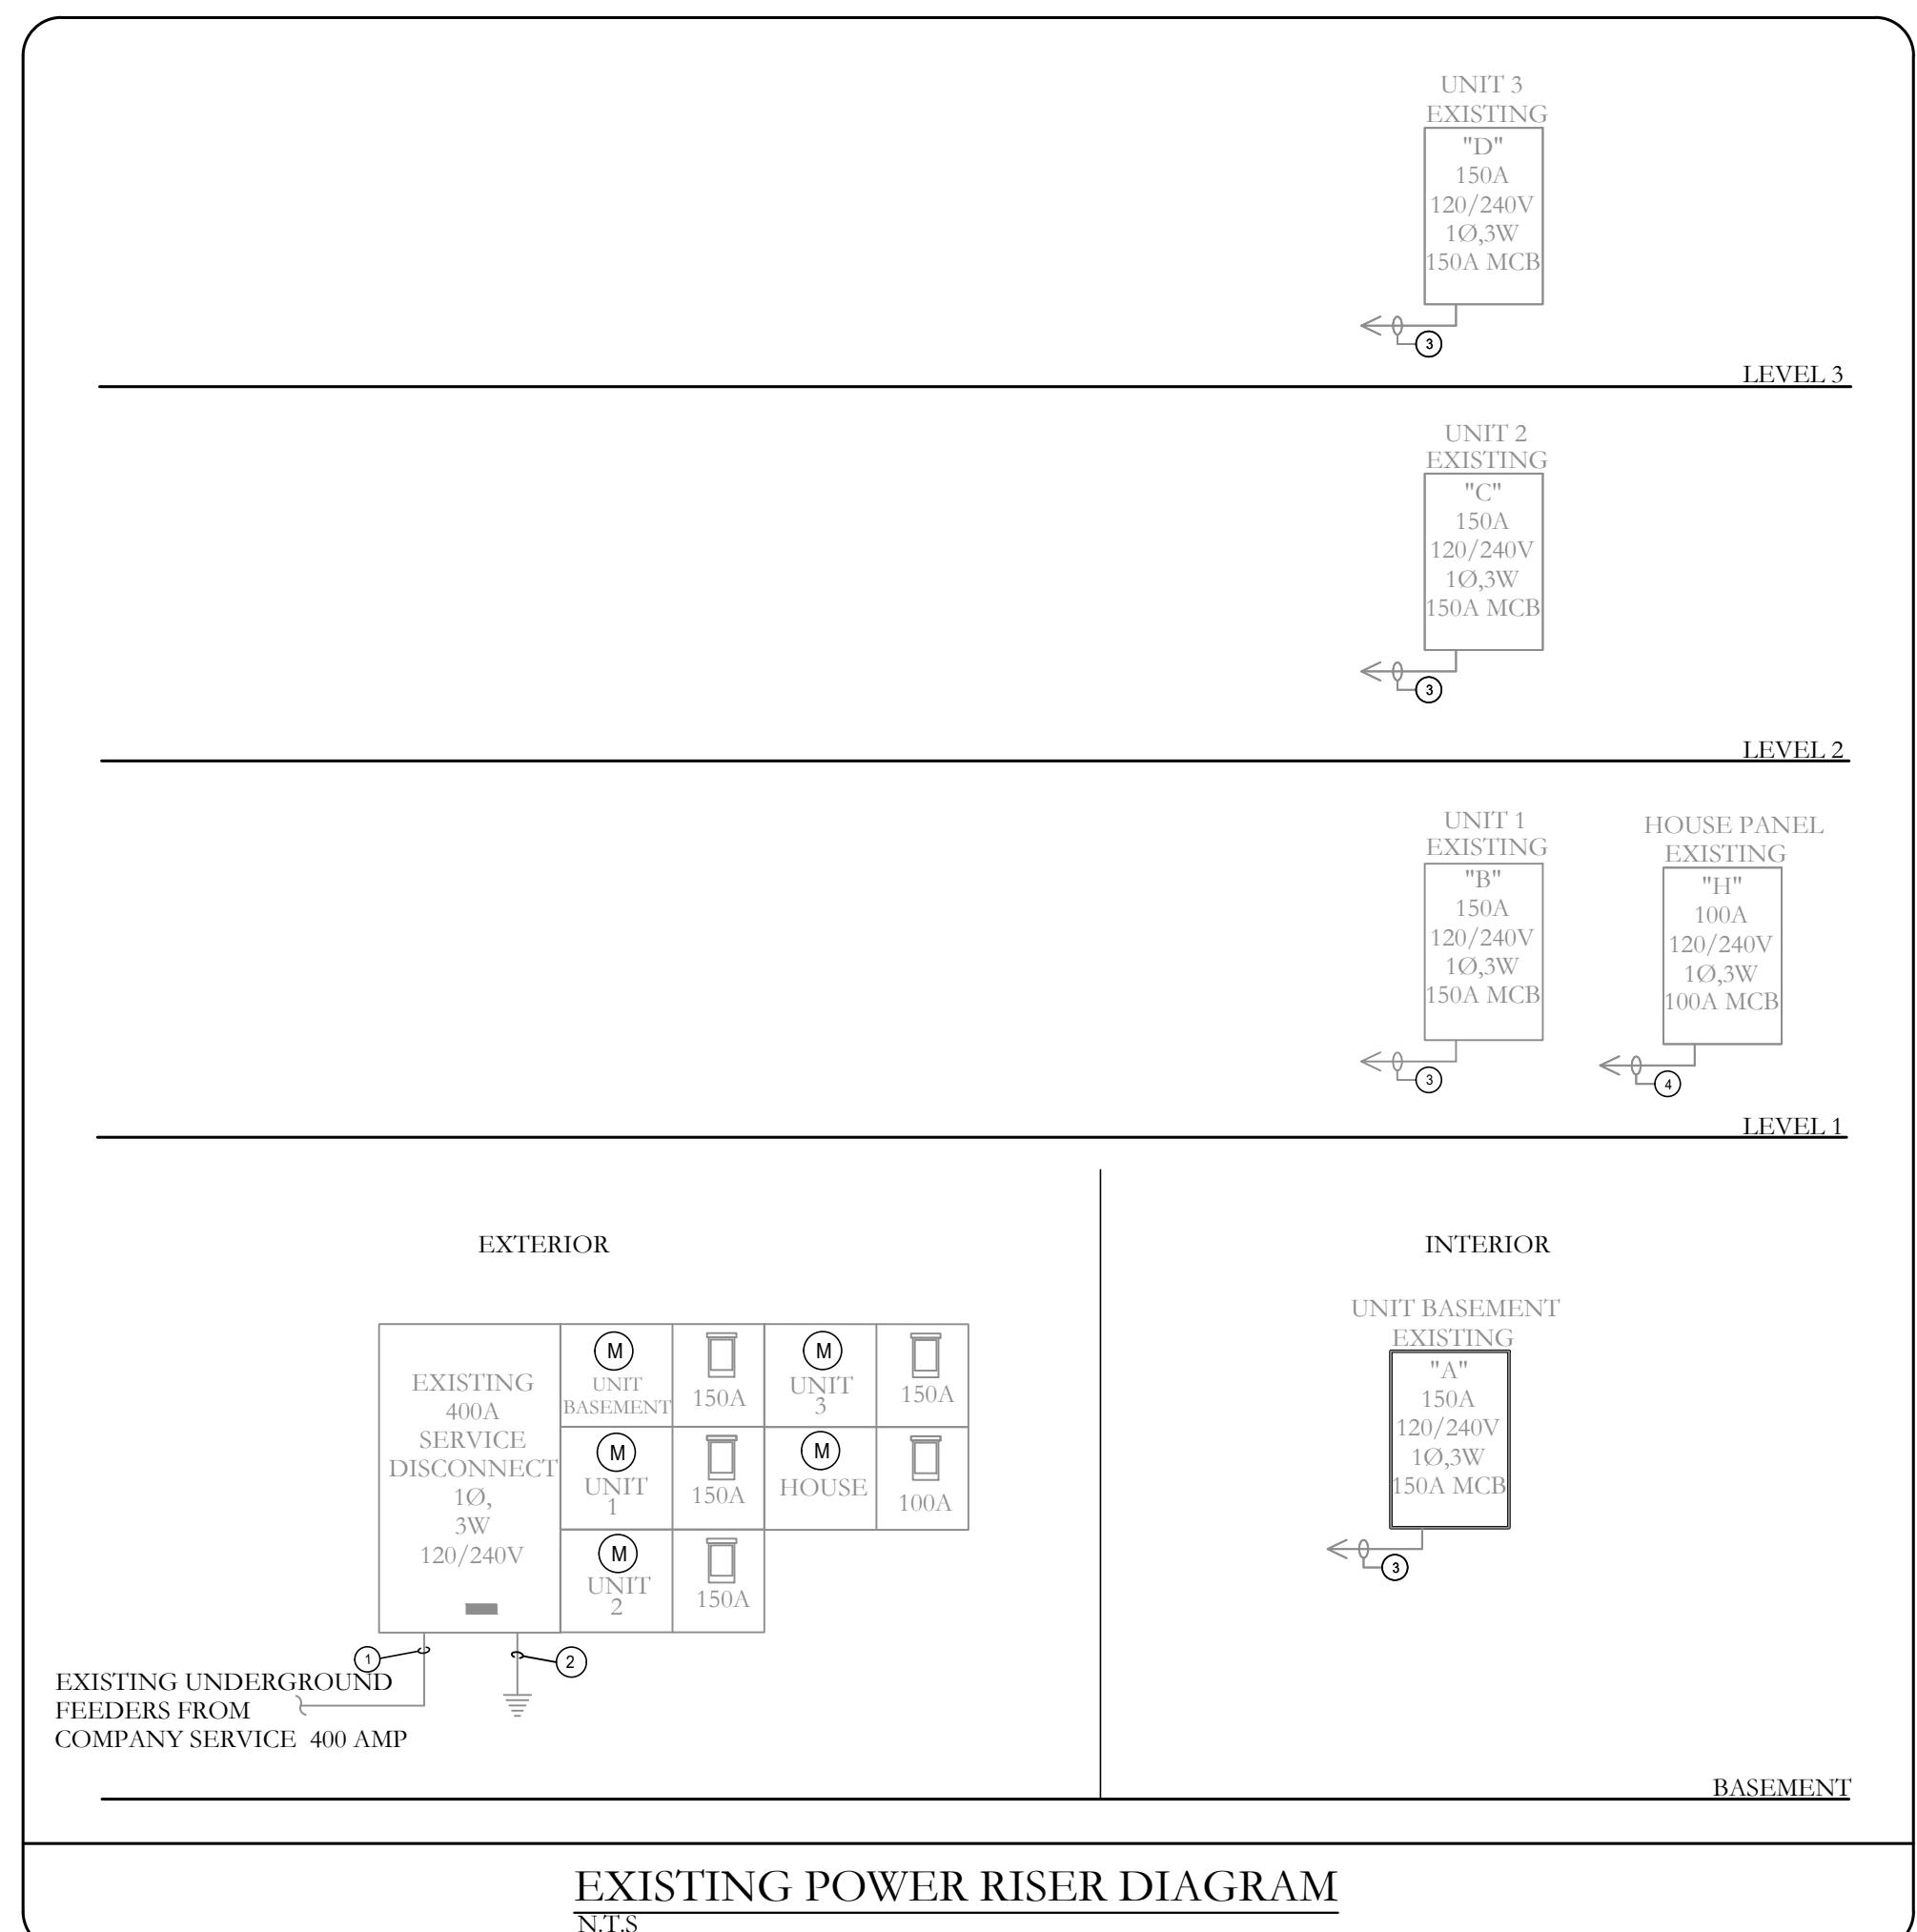

EXISTING PANELBOARD SCHEDULE												
T Y P E	VOLTAGE	PHASE	WIRE	MOUNTING		SIZE	LUG	TYPE	C.B. RATING: 22 K.A.I.C.		T Y P E	
				POLE	CIR	OA	OB	CIR	POLE			
USE and/or AREA SERVED												
E	240/120V	1	3	60/2	1	4.25	2	50/2	RANGE	E		
E				3	4.00			4.25				
E					5	1.75						
E				30/2	7	1.15		1.75	30/2	A/C	E	
E								1.15	8			
E				20/1	9	1.8		10				
E					11	2.5		1.00	12	DRYER	E	
E				20/1	13	1.5		14	20/1	WASHER	E	
E					15			1.6	20/1	KITCHEN	E	
E				15/1	17	1.00		18	15/1	LITE PLUX	E	
E				15/1	19			1.8	20	15/1	SPARE	E
E				15/1	21	1.7		22	15/1	SPARE	E	
E					23			1.7	24	15/1	LITE PLUX	E
E				15/1	25			26	15/1	SPARE	E	
E					27			28	15/1	SPARE	E	
N				15/1	29	1.00		30	-1/	SPACE	E	
									20/45	TOTAL LOAD PER PHASE		
FEEDER OCPD AND CONDUCTOR CALCULATION												
LOAD DESCRIPTION (LOAD IN KVA)				CONNECT	DEMAN	NOTES						
				LOAD	DEMAND							
TOTAL KVA				44	36							
TOTAL AMPS				183 A	148 A							

FEEDER SCHEDULE							
BASED ON 75°C TYPE THHW INSULATED CABLE							
CONDUT	CU OR AL	# OF SETS	# OF CONDUCTORS	EGC	GEC	MIN. PVC CONDUIT SIZE	MIN. EMT CONDUIT SIZE
50	CU	1	3 #8	#10	#8	1"	1"
	AL	1	3 #6	#8	#6	1 1/4"	1"
60	CU	1	3 #6	#10	#8	1 1/4"	1"
	AL	1	3 #4	#8	#6	1 1/4"	1 1/4"
75	CU	1	3 #4	#8	#8	1 1/4"	1 1/4"
	AL	1	3 #3	#6	#6	1 1/4"	1 1/4"
100	CU	1	3 #3	#8	#8	1 1/4"	1 1/4"
	AL	1	3 #1	#6	#6	2"	2"
125	CU	1	3 #1	#6	#6	2"	2"
	AL	1	3 #2/0	#4	#4	2"	2"
150	CU	1	3 #1/0	#6	#6	2"	2"
	AL	1	3 #3/0	#4	#4	2 1/2"	2 1/2"
175	CU	1	3 #2/0	#6	#4	2"	2"
	AL	1	3 #4/0	#4	#2	2 1/2"	2 1/2"
200	CU	1	3 #3/0	#6	#4	2 1/2"	2 1/2"
	AL	1	3 #250MCM	#4	#2	3"	2 1/2"
225	CU	1	3 #4/0	#4	#2	2 1/2"	2 1/2"
	AL	1	3 #300MCM	#2	#1/0	3"	2 1/2"
250	CU	1	3 #250MCM	#4	#2	3"	2 1/2"
	AL	1	3 #350MCM	#2	#1/0	3"	3"
300	CU	1	3 #350MCM	#4	#2	3"	3"
	AL	1	3 #500MCM	#2	#1/0	3 1/2"	3"
350	CU	1	3 #500MCM	#3	#1/0	3 1/2"	3"
	AL	2	3 #4/0				

MECHANICAL SPECIFICATION

DIVISION 23 - HEATING, VENTILATING AND AIR CONDITIONING

23A.1 GENERAL

A. THE GENERAL CONDITIONS, SUPPLEMENTARY CONDITIONS AND APPLICABLE PROVISIONS OF OTHER DIVISIONS, FORM A PART OF THIS SPECIFICATION AND CONTRACT, AND SHALL BE CAREFULLY EXAMINED BY EACH BIDDER BEFORE SUBMITTING HIS PROPOSAL.

B. COMPLIANCE WITH LOCAL JURISDICTIONS: ALL WORK PERFORMANCE UNDER THIS SECTION SHALL CONFORM TO THE REQUIREMENTS OF DRAWINGS AND SPECIFICATIONS AND TO THE CODES, ORDINANCES AND STANDARDS OF THE LOCAL JURISDICTION. IN CASE OF A CONFLICT BETWEEN DRAWINGS OR SPECIFICATIONS AND THE REQUIREMENT OF THE LOCAL JURISDICTION, THE MORE STRINGENT REQUIREMENTS SHALL APPLY.

C. THIS CONTRACTOR SHALL OBTAIN AND PAY FOR ALL PERMITS AND FEES FOR INSPECTIONS RELATED TO HIS WORK.

D. INSTALLATION SHALL BE GUARANTEED FOR WORKMANSHIP, MATERIALS AND EQUIPMENT AGAINST DEFECTS, LEAKS, SYSTEM PERFORMANCE OR NON-OPERATION FOR A PERIOD OF ONE YEAR AFTER DATE OF ACCEPTANCE. CONTRACTOR SHALL PAY ALL COSTS INVOLVING THE GUARANTEE OF ALL SYSTEMS.

E. BEFORE ANY MATERIALS OR EQUIPMENT IS PURCHASED, THIS CONTRACTOR SHALL SUBMIT TO THE OWNER FOR APPROVAL 6 SETS OF SUBMITTAL DATA. THIS DATA SHALL INCLUDE CATALOG NUMBERS, CUTS, DIAGRAMS, DRAWINGS AND OTHER DESCRIPTIVE DATA AS MAY BE REQUIRED FOR ALL EQUIPMENT TO BE INSTALLED. INCLUDE SHEET METAL FABRICATION, SHOP DRAWINGS AND LAYOUTS COORDINATED WITH EXISTING CONDITIONS.

F. THE WORD "PROVIDE" AS USED IN SPECIFICATIONS AND ON PLANS, SHALL MEAN FURNISH AND INSTALL COMPLETE AND READY FOR USE.

G. ALL WORK SHALL BE COORDINATED WITH ALL TRADES PRIOR TO INSTALLATION.

H. DO NOT CUT STRUCTURAL MEMBERS WITHOUT THE APPROVAL OF THE ARCHITECT, AND ALL SUCH CUTTING SHALL BE DONE IN A MANNER DIRECTED BY HIM.

I. IN GENERAL, DRAWINGS FOR THE WORK ARE DIAGRAMMATIC AND SHOW THE LOCATION, TYPE AND SIZE OF PIPING, EQUIPMENT, DUCTWORK AND ACCESSORY EQUIPMENT. THE CONTRACTOR SHALL FURNISH ALL ITEMS NECESSARY FOR THE PROPER INSTALLATION OF THE WORK. THE CONTRACTOR SHALL BE RESPONSIBLE FOR THE PREPARATION OF THE PLANS FOR THE WORK, AND SHALL CHECK HIS LAYOUTS TO ALLOW CLEARANCE REQUIRED FOR OTHER WORK AS SHOWN ON THE DRAWINGS. THE SCOPE OF WORK CONSISTS GENERALLY OF PROVIDING AND INSTALLING THE DUCTWORK DISTRIBUTION SYSTEM, AND FINAL PREPARATION/TESTING OF ALL SYSTEMS AND EQUIPMENT.

23A.2 PRODUCTS AND INSTALLATION

A. AIR DEVICES AND DUCTS:

1. MANUAL DAMPERS: PROVIDE MANUAL BALANCING DAMPERS AS MANUFACTURED BY RUSKIN OR APPROVED EQUAL WITH LOCKING QUADRANT ON DUCTS AT LOCATIONS SHOWN.

2. SPLITTER DAMPERS: AT ALL DUCT BRANCHES PROVIDE SPLITTER DAMPERS WITH ROD AND SET SCREW IN ACCORDANCE WITH SMACNA STANDARDS.

3. ALL LONGITUDINAL AND TRANSVERSE JOINTS, SEAMS AND CONNECTIONS OF SUPPLY AND RETURN DUCTS OPERATING AT A STATIC PRESSURE LESS THAN OR EQUAL TO 2 INCHES WATER GAUGE (W.G.) (500 PA) SHALL BE SECURELY FASTENED AND SEALED WITH WELDS, GASKETS, MASTICS (ADHESIVES), OR METAL-PLATE-EMBEDDED JOINT SYSTEMS. THE CONTRACTOR OR THE MANUFACTURER OF INSTALLATION, CONSTRUCTIONS OR CONTRACTOR CAN PROVIDE CONTINUOUSLY WELDED AND LOCKING-TYPE LONGITUDINAL JOINTS AND SEAMS ON DUCTS OPERATING AT STATIC PRESSURES LESS THAN 2 INCHES WATER GAUGE (W.G.) (500 PA) PRESSURE CLASSIFICATION.

4. AIR OUTLETS: ALL DIFFUSERS, REGISTERS, AND GRILLES SHALL BE THE SIZES AND TYPES SHOWN AND AS MANUFACTURED BY METALFAIRE OR APPROVED EQUAL AND SHALL HAVE FRAMES SUITABLE FOR THE SURFACES THEY ARE INSTALLED IN AND OF COLORS SELECTED BY THE ARCHITECT.

B. FLEXIBLE DUCT CONNECTION:

1. CONTRACTOR SHALL BRACE DUCTWORK (AS REQUIRED) AT ALL FLEXIBLE CONNECTIONS TO ENSURE THAT DUCTWORK IS KEPT IN ALIGNMENT.

2. FLEXIBLE DUCT: PROVIDE INSULATED UL LISTED CLASS 1 DUCT COMPLYING WITH NFPA 90A, FLEXMATEX, THERMATEX, WIREMOLD OR CLEVAFLEX. MAXIMUM LENGTH SHALL BE 8 FEET.

C. INSULATION

1. AIR CONDITIONING DUCTS REPAIR OR PROVIDED NEW INSULATION TO ALL OUTSIDE AIR SUPPLY AND RETURN AIR DUCTS WITH A 1-1/2" THICK, 3/4 POUND INSULATION FIBERGLASS, FLEXIBLE BLANKET, INSULATION, FACED WITH FIRE RESISTIVE VAPOR BARRIER JACKET WITH A 2" TAB ON ONE EDGE. INSULATION SHALL BE WRAPPED ON DUCTS WITH OVERLAPPING ALL JOINTS AT LEAST 2" AND HELD IN PLACE WITH 1/2" OUTWARD CLINCHING STAPLES ON 4" CENTERS. STAPLES AND SEAMS ARE TO BE SEALED WITH A BRUSH COAT OF VAPOR BARRIER MASTIC.

2. INSULATION OF DUCTWORK AND PIPING PASSING THROUGH NO-RATED WALLS SHALL BE CONTINUOUS THROUGH THE WALL PER NFPA 90A AND 3.5" DUCTS & PLenums SHALL BE INSULATED WITH A MINIMUM OF R-8 INSULATION WHERE LOCATED IN UNCONDITIONED SPACES & A MINIMUM OF R-8 INSULATION WHERE LOCATED OUTSIDE THE BUILDING, WHERE LOCATED WITHIN A BUILDING ENVELOPE ASSEMBLY, THE DUCT OR PLenum SHALL BE SEPARATED FROM THE BUILDING EXTERIOR OR UNCONDITIONED OR EXEMPT SPACES BY A MINIMUM OF R-8 INSULATION.

D. VIBRATION ISOLATORS:

4. PROVIDE NEOPRENE ISOLATION PADS FOR ALL EQUIPMENT 100 POUNDS OR GREATER.

5. QUANTITY AND LOCATION OF ISOLATORS SHALL BE AS RECOMMENDED BY THE EQUIPMENT MANUFACTURER.

6. AFTER INSTALLATION AND START-UP, CONTRACTOR SHALL THOROUGHLY CHECK THE SYSTEM FOR VIBRATION TRANSMISSION TO THE STRUCTURE OR EXCESSIVE NOISE, AND IF EITHER OCCURS, THE CONTRACTOR SHALL BE RESPONSIBLE FOR CORRECTING THE FAULTY SITUATION IMMEDIATELY.

E. REFRIGERANT PIPING:

1. INSULATE REFRIGERANT LINES TO A MINIMUM OF R-3. THE LIQUID LINE DOES NOT REQUIRE INSULATION.

2. PROTECTION OF PIPING INSULATION: PIPING INSULATION EXPOSED TO HEATERS, BLOWERS, AND OTHER DYNAMIC EQUIPMENT SHALL BE SEALED WITH SUNLIGHT, MOISTURE, EQUIPMENT MAINTENANCE, AND WIND, AND SHALL PROVIDE SHIELDING FROM SOLAR RADIATION THAT CAN CAUSE DEGRADATION OF THE MATERIAL. INSULATE ALL REFRIGERANT PIPING WITH 0.75" THICK CLOSED-CELL, ADHESIVE TAPE SHALL NOT BE PERMITTED. WRAP WITH ALUMINUM AND SEAL WITH MASTIC, ALTERNATIVELY USE PLASTIC, AIREX E-FLEX OR PVC SHIELDING.

3. REFRIGERANT PIPING: RUN FROM CHASE TO ROOF EQUIPMENT SHALL BE NEATLY SUSPENDED AND SUPPORTED ON UNITRUST OR WITH OTHER SUPPORTS TO BUILDING STRUCTURE AND SHALL NOT BE ATTACHED TO ROOF OR SEAL ON ROOF W/D INTERMENT WD OR METAL BLOCKING AND A SECONDARY ROOF MEMBRANE. PROTECTIVE SHEET SUPPLIED BY ROOF MEMBRANE MANUFACTURER.

MECHANICAL SPECIFICATION

23A.3 EXECUTION

A. PERFORM ALL OPERATIONS REQUIRED AND INSTALL ALL DUCTWORK, EQUIPMENT AND CONTROLS WITH ALL REQUIRED ACCESSORIES TO PRODUCE A COMPLETE HVAC INSTALLATION READY FOR USE.

1. INSTALL ALL DUCTWORK ABOVE CEILING AND HOLD TIGHT TO UNDERSIDE OF STRUCTURE ABOVE UNLESS OTHERWISE INDICATED.

2. CHANGES TO DUCT DUE TO FIELD CONDITIONS SHALL BE MADE ONLY IF THE DUCT SIZE FREE AREA IS MAINTAINED AND SHALL BE SUBMITTED TO ENGINEER FOR APPROVAL.

B. COMPLIANCE WITH LOCAL JURISDICTIONS: ALL WORK PERFORMANCE UNDER THIS SECTION SHALL CONFORM TO THE REQUIREMENTS OF DRAWINGS AND SPECIFICATIONS AND TO THE CODES, ORDINANCES AND STANDARDS OF THE LOCAL JURISDICTION. IN CASE OF A CONFLICT BETWEEN DRAWINGS OR SPECIFICATIONS AND THE REQUIREMENT OF THE LOCAL JURISDICTION, THE MORE STRINGENT REQUIREMENTS SHALL APPLY.

C. THIS CONTRACTOR SHALL OBTAIN AND PAY FOR ALL PERMITS AND FEES FOR INSPECTIONS RELATED TO HIS WORK.

D. INSTALLATION SHALL BE GUARANTEED FOR WORKMANSHIP, MATERIALS AND EQUIPMENT AGAINST DEFECTS, LEAKS, SYSTEM PERFORMANCE OR NON-OPERATION FOR A PERIOD OF ONE YEAR AFTER DATE OF ACCEPTANCE. CONTRACTOR SHALL PAY ALL COSTS INVOLVING THE GUARANTEE OF ALL SYSTEMS.

E. BEFORE ANY MATERIALS OR EQUIPMENT IS PURCHASED, THIS CONTRACTOR SHALL SUBMIT TO THE OWNER FOR APPROVAL 6 SETS OF SUBMITTAL DATA. THIS DATA SHALL INCLUDE CATALOG NUMBERS, CUTS, DIAGRAMS, DRAWINGS AND OTHER DESCRIPTIVE DATA AS MAY BE REQUIRED FOR ALL EQUIPMENT TO BE INSTALLED. INCLUDE SHEET METAL FABRICATION, SHOP DRAWINGS AND LAYOUTS COORDINATED WITH EXISTING CONDITIONS.

F. THE WORD "PROVIDE" AS USED IN SPECIFICATIONS AND ON PLANS, SHALL MEAN FURNISH AND INSTALL COMPLETE AND READY FOR USE.

G. ALL WORK SHALL BE COORDINATED WITH ALL TRADES PRIOR TO INSTALLATION.

H. DO NOT CUT STRUCTURAL MEMBERS WITHOUT THE APPROVAL OF THE ARCHITECT, AND ALL SUCH CUTTING SHALL BE DONE IN A MANNER DIRECTED BY HIM.

I. IN GENERAL, DRAWINGS FOR THE WORK ARE DIAGRAMMATIC AND SHOW THE LOCATION, TYPE AND SIZE OF PIPING, EQUIPMENT, DUCTWORK AND ACCESSORY EQUIPMENT. THE CONTRACTOR SHALL FURNISH ALL ITEMS NECESSARY FOR THE PROPER INSTALLATION OF THE WORK. THE CONTRACTOR SHALL BE RESPONSIBLE FOR THE PREPARATION OF THE PLANS FOR THE WORK, AND SHALL CHECK HIS LAYOUTS TO ALLOW CLEARANCE REQUIRED FOR OTHER WORK AS SHOWN ON THE DRAWINGS. THE SCOPE OF WORK CONSISTS GENERALLY OF PROVIDING AND INSTALLING THE DUCTWORK DISTRIBUTION SYSTEM, AND FINAL PREPARATION/TESTING OF ALL SYSTEMS AND EQUIPMENT.

J. THE WORD "PROVIDE" AS USED IN SPECIFICATIONS AND ON PLANS, SHALL MEAN FURNISH AND INSTALL COMPLETE AND READY FOR USE.

K. ALL JOINTS AND SEAMS OF AIR DUCTS AND CONNECTIONS ARE TO BE SEALED TO SMACNA CLASS A REGARDLESS OF PRESSURE CLASS.

L. AIR HANDLER LEAKAGE DESIGNED BY MANUFACTURER SHALL BE AT $\leq 2\%$ OF AIRFLOW, IN ACCORDANCE WITH ASHRAE 193.

M. TOTAL DUCT LEAKAGE TEST $\leq 4\text{ CFM}/100\text{ FT}^2$ WITH AIR-HANDLER INSTALLED.

N. MECHANICAL CAVITIES SHALL NOT BE USED AS DUCTS OR PLENUMS.

O. MECHANICAL SYSTEM PIPING CAPABLE OF CARRYING FLUIDS ABOVE 105°F (41°C) OR BELOW 55°F (13°C) SHALL BE INSULATED TO A MINIMUM OF R-3.

P. PIPING INSULATION EXPOSED TO WEATHER SHALL BE PROTECTED FROM DAMAGE, INCLUDING THAT CAUSED BY SUNLIGHT, MOISTURE, EQUIPMENT MAINTENANCE AND WIND, AND SHALL PROVIDE SHIELDING FROM SOLAR RADIATION THAT CAN CAUSE DEGRADATION OF THE MATERIAL. ADHESIVE TAPE SHALL NOT BE PERMITTED.

Q. HVAC PIPING INSULATION, WHERE EXPOSED TO THE OUTDOORS, SHALL BE FINISHED WITH TWO COATS OF MANUFACTURER'S FINISH COATING, VINYL-LACQUER COATING OR APPROVED EQUAL.

R. CONTRACTOR SHALL PROVIDE BACK DRAFT DAMPER ON OUTSIDE AIR INTAKE DUCTWORK.

S. THERMOSTAT SHALL INCLUDE THE CAPABILITY TO SET BACK OR TEMPORARILY OVERRIDE SYSTEMS. THE THERMOSTAT SHALL BE SET AT 55°F (13°C) UP TO 70°F (21°C). THE THERMOSTAT SHALL INITIALLY BE PROGRAMMED BY THE MANUFACTURER WITH A HEATING TEMPERATURE SET POINT NO HIGHER THAN 70°F AND A COOLING TEMPERATURE SET POINT NO LOWER THAN 75°F .

T. ALL THE CEILING TYPE BATHROOM EXHAUST FANS SHALL BE PROVIDED WITH GRAVITY BACK DRAFT DAMPERS.

U. NEW EQUIPMENT AND APPLIANCES SHALL BE SEALED COMBUSTION.

V. FOR EXACT LOCATION OF ALL AIR DEVICES, SEE REFLECTED CEILING PLAN ON ARCHITECTURAL DRAWINGS.

W. OUTDOOR AIR SHALL HAVE BACK DRAFT DAMPER & MEET THE MAXIMUM LEAKAGE RATES.

X. ALL DUCT JOINTS, SEAMS, AND CONNECTIONS ARE TO BE SEALED TO SMACNA CLASS A REGARDLESS OF PRESSURE CLASS.

Y. THE APPROVAL AND INSTALLATION OF FUEL GAS DISTRIBUTION PIPING AND EQUIPMENT, FUEL GAS APPLIANCES AND FUEL GAS-FIRED APPLIANCE VENTING SYSTEMS SHALL BE IN ACCORDANCE WITH INTERNATIONAL FUEL GAS CODE AND MANUFACTURER'S REQUIREMENTS.

Z. USE THERMATEX G-KW U.L. 18 CLASS 1 FACTORY-INSULATED TWO-Ply BONDED ALUMINUM FLEXIBLE DUCTWORK. THE INSULATION SHALL INCLUDE A VAPOR BARRIER JACKET, LIMIT FLEXIBLE DUCT TO A MAXIMUM LENGTH OF 14 FEET.

AA. FOR EXACT LOCATION OF OUTDOOR AIR CONDITIONING UNITS, SEE ARCHITECTURAL DRAWINGS.

AB. INSTALL GRADE MOUNTED OUTDOOR AIR CONDITIONING EQUIPMENT LEVEL ON 4" THICK REINFORCED CONCRETE PADS, EXTENDING 4" BEYOND UNIT PERIMETER.

AC. CONDENSATE DRAIN PIPING: SCHEDULE 40, CPVC PIPE AND FITTINGS: ASTM F-441/F-441 MINIMUM 1 PERCENT SLOPE. PROVIDE MINIMUM 2 INCH DEEP TRAP AT EACH A/C UNIT. INSULATE WITH 1/2 INCH THICK INSULATION.

AD. ALL WIRING, CONDUIT & POWER FOR ALL CONTROLS SHALL BE THE RESPONSIBILITY OF THE CONTROLS CONTRACTOR, INCLUDING COORDINATION WITH OTHER TRADES. THE CONTROLS CONTRACTOR, AT HIS/HER OWN COST, SHALL ENGAGE THE ELECTRICAL CONTRACTOR AS REQUIRED.

AE. ALL CONTROL WIRING AND CONDUIT SHALL COMPLY WITH THE ELECTRICAL SPECIFICATIONS OF THIS PROJECT.

AF. THERMOSTATS/SENSORS/CONTROLLERS/SWITCHES:

AG. TEMPERATURE SENSORS AND THERMOSTATS SHALL BE MOUNTED ON AN INSULATED SUB-BASE, IF LOCATED ON AN EXTERIOR WALL, OR COLUMN.

AH. SHALL BE MOUNTED SO THAT ANY LOCAL CONTROLS ARE 4'-0" (TOP) ABOVE FINISHED FLOOR, UNLESS OTHERWISE NOTED.

AI. ARE ALL SHOWN IN APPROXIMATE LOCATIONS ON THE MECHANICAL PLANS. COORDINATE FINAL LOCATIONS WITH THE ARCHITECTURAL DRAWINGS AND DETAILS.

AJ. AFTER THE SYSTEMS HAVE BEEN BALANCED AND ALL ADJUSTMENTS COMPLETED, RUN A SIX HOUR TEST ON BOTH THE APPLICABLE HEATING AND COOLING CYCLES TO DETERMINE IF THE SYSTEM IS RESPONDING TO TEMPERATURE CONTROLS. RECORD THERMOSTAT TEMPERATURE READING, PROVIDE AND RECORD AN INDEPENDENT TEMPERATURE MEASUREMENT AT EACH THERMOSTAT.

AK. PROVIDE TO THE OWNER A DEMONSTRATION OF THE PROGRAMMING AND OPERATION OF ALL NEW AUTOMATIC TEMPERATURE CONTROLS.

AL. SEQUENCE OF OPERATIONS:

AM. CONTROLS PROVIDED BY MANUFACTURER INSTALL CONTROLLER WHERE SHOWN ON PLANS AND WIRE PER MANUFACTURER'S WRITTEN REQUIREMENTS. ADJUST SETPOINTS AS FOLLOWS:

AN. 1) RESTART: AUTOMATIC

AO. 2) OUTDOOR TEMPERATURE RANGE: 74°F (23°C) - AUTOMATIC FAN OPERATION

AP. - OUTSIDE AIR DAMPER OPEN (WHERE APPLICABLE)

AQ. 3) NIGHT SETBACK TEMPERATURE RANGE: 70°F (21°C) - AUTOMATIC FAN OPERATION

AR. - OUTSIDE AIR DAMPER CLOSED (WHERE APPLICABLE)

AS. WATER LEVEL DETECTOR MOUNTED IN PRIMARY DRAIN PAN ABOVE THE PRIMARY DRAIN LINE CONNECTION AND BELOW THE TOP OF THE PRIMARY DRAIN PAN OVERFLOW RIM SHALL DEACTIVATE UNIT AND SOUND LOCAL ALARM UPON DETECTION OF LIQUID.

AT. PROJECT IS REQUIRED TO SUBMIT AT FINAL INSPECTION A WHOLE-BUILDING PIPING TEST SHOWING A PASSING RATING OF ≥ 5 AIR CHANGES PER HOUR AT A PRESSURE OF 50 PASCAL, PER R402.4.1.2. A WRITTEN REPORT OF THE RESULTS OF THE TEST SHALL BE SIGNED BY THE PARTY CONDUCTING THE TEST AND PROVIDED TO THE OFFICIAL. TESTING SHALL BE CONDUCTED IN ACCORDANCE WITH ASTM E 779 OR ASTM E 1827.

AU. DOMESTIC RANGE HOOD SHALL DISCHARGE TO THE OUTDOORS THROUGH SHEET METAL DUCTS CONSTRUCTED OF GALVANIZED STEEL, STAINLESS STEEL, ALUMINUM OR COPPER. SUCH DUCTS SHALL HAVE SMOOTH INNER WALLS, SHALL BE AIR TIGHT, SHALL BE EQUIPPED WITH A BACK DRAFT DAMPER, AND SHALL BE INDEPENDENT OF ALL OTHER EXHAUST SYSTEMS.

AV. INSULATE REFRIGERANT LINES TO A MINIMUM OF R-3. THE LIQUID LINE DOES NOT REQUIRE INSULATION.

AW. PROTECTION OF PIPING INSULATION EXPOSED TO SUNLIGHT, MOISTURE, EQUIPMENT MAINTENANCE, AND WIND, AND SHALL PROVIDE SHIELDING FROM SOLAR RADIATION THAT CAN CAUSE DEGRADATION OF THE MATERIAL. INSULATE ALL REFRIGERANT PIPING WITH 0.75" THICK CLOSED-CELL, ADHESIVE TAPE SHALL NOT BE PERMITTED. WRAP WITH ALUMINUM AND SEAL WITH MASTIC, ALTERNATIVELY USE PLASTIC, AIREX E-FLEX OR PVC SHIELDING.

AX. REFRIGERANT PIPING: RUN FROM CHASE TO ROOF EQUIPMENT SHALL BE NEATLY SUSPENDED AND SUPPORTED ON UNITRUST OR WITH OTHER SUPPORTS TO BUILDING STRUCTURE AND SHALL NOT BE ATTACHED TO ROOF OR SEAL ON ROOF W/D INTERMENT WD OR METAL BLOCKING AND A SECONDARY ROOF MEMBRANE. PROTECTIVE SHEET SUPPLIED BY ROOF MEMBRANE MANUFACTURER.

AY. INSULATE REFRIGERANT LINES TO A MINIMUM OF R-3. THE LIQUID LINE DOES NOT REQUIRE INSULATION.

AZ. PROTECTION OF PIPING INSULATION EXPOSED TO SUNLIGHT, MOISTURE, EQUIPMENT MAINTENANCE, AND WIND, AND SHALL PROVIDE SHIELDING FROM SOLAR RADIATION THAT CAN CAUSE DEGRADATION OF THE MATERIAL. INSULATE ALL REFRIGERANT PIPING WITH 0.75" THICK CLOSED-CELL, ADHESIVE TAPE SHALL NOT BE PERMITTED. WRAP WITH ALUMINUM AND SEAL WITH MASTIC, ALTERNATIVELY USE PLASTIC, AIREX E-FLEX OR PVC SHIELDING.

BA. CUTTING AND PATCHING OF DUCT, OR EXTEGTING BUILDING FINISHES FOR INSULATION OR PIPING INSULATION: ALL DUCTS SHALL BE SEALED WITH SAME INSULATION MATERIAL AND THICKNESS AS EXISTING AND SEALED VAPOR TIGHT.

BB. CUTTING AND PATCHING OF DUCT, OR EXTEGTING BUILDING FINISHES FOR INSULATION OR PIPING INSULATION: ALL DUCTS SHALL BE SEALED WITH SAME INSULATION MATERIAL AND THICKNESS AS EXISTING AND SEALED VAPOR TIGHT.


BC. CUTTING AND PATCHING OF DUCT, OR EXTEGTING BUILDING FINISHES FOR INSULATION OR PIPING INSULATION: ALL DUCTS SHALL BE SEALED WITH SAME INSULATION MATERIAL AND THICKNESS AS EXISTING AND SEALED VAPOR TIGHT.

MECHANICAL KEYED NOTES:

- ① PROVIDE NEW AHU. REFER TO SCHEDULE AND DETAIL FOR MORE INFORMATION. ROUTE 3/4" CONDENSATE DRAIN TO DAYLIGHT. PROVIDE PUMP DRAIN IF NEEDED.
- ② PROVIDE BATHROOM EXHAUST FAN. REFER TO SCHEDULE AND DETAILS. INSTALL AS PER MANUFACTURER'S INSTRUCTIONS.
- ③ PROVIDE NEW CONDENSING UNIT. REFER TO SCHEDULE AND DETAIL FOR MORE INFORMATION. REFRIGERANT CIRCUIT ACCESS PORTS LOCATED OUTDOORS MUST BE FITTED WITH LOCKING-TYPE TAMPER-RESISTANT CAPS.
- ④ ROUTE REFRIGERANT SUCTION AND LIQUID PIPING FROM INDOOR AHU TO OUTDOOR UNIT. SIZING TO BE BASED ON MANUFACTURERS REQUIREMENTS FOR TOTAL DEVELOPED LENGTH.
- ⑤ PROVIDE NEW THERMOSTAT TO CONTROL AHU. COORDINATE EXACT LOCATION WITH OWNER/ARCH.
- ⑥ VENTLESS KITCHEN HOOD. RECYCLING RANGE HOOD. AIRFLOW OF THE EXHAUST HOOD SHALL NOT EXCEED 400 CFM. MINIMUM EFFICIENCY 2.8 (CFM/WATT).
- ⑦ ROUTE 4" EXHAUST DRYER PER MANUFACTURER'S REQUIREMENTS AND VENTED DIRECTLY TO THE OUTSIDE.
- ⑧ PROVIDE AND INSTALL 6" FRESH AIR DUCT. FRESH AIR DUCT TO BE ROUTED TO MECHANICAL ROOM.
- ⑨ PROVIDE CEILING RADIATION DAMPER (CRD) FOR EXHAUST AND FIRE SMOKER DAMPER (FSD) FOR DUCT. REFER TO MECHANICAL SCHEDULES AND DETAILS.
- ⑩ EQUIPMENT/DUCTWORK LOCATED IN DROPPED CEILING/BULKHEAD. COORDINATE WITH STRUCTURAL.
- ⑪ PROVIDE NEW RETURN AIR TRANSFER GRILLE.

GENERAL NOTES:


- COORDINATE ALL WALL CAPS LOCATIONS WITH ARCHITECTURAL AND STRUCTURAL DRAWINGS.
- ALL WALL CAPS AND SOFFIT VENTS SHALL HAVE BACK DRAFT DAMPERS. TOILET AND KITCHEN EXHAUST SHALL INCLUDE INSECT SCREEN.
- THE LAST 10'0" OF DRYER, KITCHEN AND BATH EXHAUST SHALL BE SLOPED AT 1/8" PER FOOT TO EXTERIOR WALL CAP.
- BEDROOM, CLOSET, BATHROOMS, STAND ALONE DOORS SHALL BE UNDERCUT (BY OTHERS) FOR RETURN AIR PATH.
- MAINTAIN A MINIMUM OF 10'0" BETWEEN ALL MECHANICAL AIR INTAKES AND ANY EXHAUST TERMINATIONS, GAS FLUES, OR PLUMBING VENTS.
- RECYCLING KITCHEN RANGE VENT HOOD (BY OTHERS) SHALL BE PROVIDED WITH AN INTEGRAL BACK DRAFT DAMPER.
- GENERAL CONTRACTOR SHALL COORDINATE STRUCTURAL TRUSSES INSTALLED ABOVE VERTICAL AIR HANDLING UNITS TO AVOID HVAC AND STRUCTURAL CONFLICTS. HVAC WILL HAVE A SUPPLY DUCT DISCHARGE PLENUM THAT MUST EXTEND BETWEEN OPEN WEB JOISTS/TRUSSES.
- ALL EXHAUSTS SHALL TERMINATE A MINIMUM OF 10' FROM PROPERTY LINES.

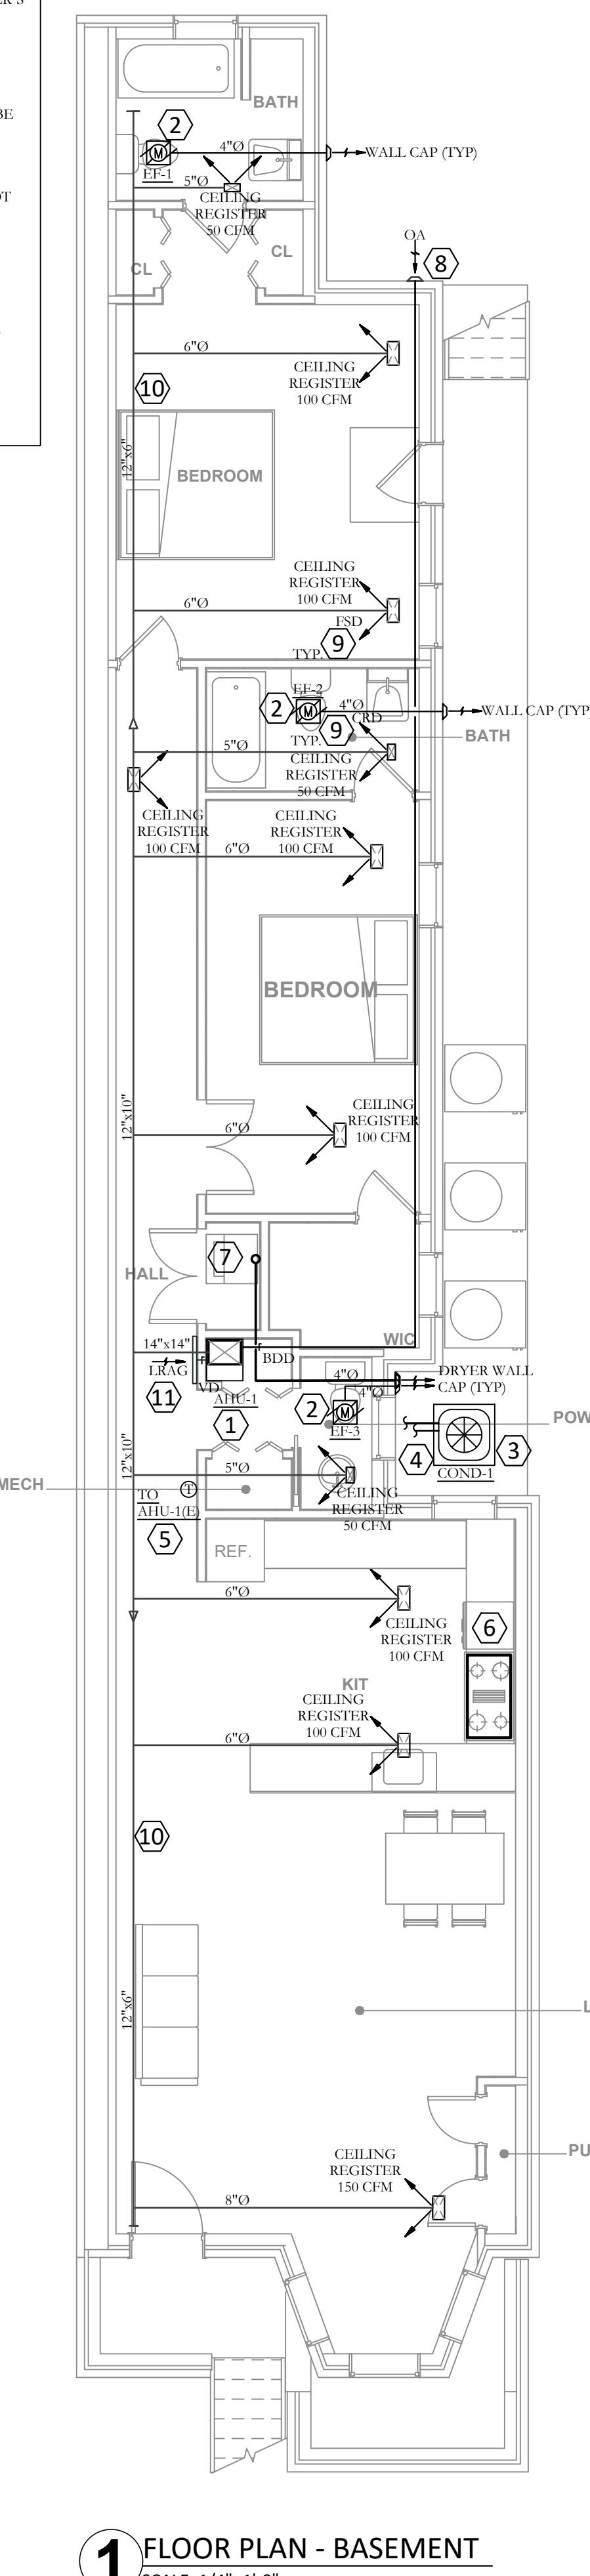


1 FLOOR PLAN - BASEMENT
SCALE: 1/4"=1'-0"

SPLIT SYSTEM HEAT PUMP UNIT SCHEDULE														
SYSTEM	TONNAGE	SUPPLY AIR	OUTSIDE AIR	E.S.P. (H2O)	SENSIBLE COOLING (MBH) @ 95 AMB	EAT (DB/WB)	LAT (DB/WB)	TOTAL COOLING (MBH)	HEATING TYPE	HEATING CAPACITY MBH(OUTPUT)	REFRIGERANT TYPE	SEER	BASIS OF DESIGN INDOOR UNIT	OUTDOOR UNIT
AHU-1 & COND-1	2.5 TON	1000 CFM	60 CFM	0.5	25.5 MBH	80 F/67.0 F	57 F/55 F	30.0 MBH	HEAT PUMP / ELECTRIC HEAT	9.6 KW	R-32	13.0	TRANE 4TGB3/30A1000AA 240V/1PH/60HZ 53 MCA/60 MOCP 119 LBS.	TRANE 4TWB3030A1000BA 240V/1PH/60HZ 15 MCA/25 MOCP 209 LBS.


FAN SCHEDULE													
MARK	LOCATION	CFM	ESP IN WG.	ELECTRICAL DATA				DRIVE	FAN CONTROLLED BY	MANUFACTURER AND MODEL NUMBER	REMARKS		
				VOLTS	PHASE	HERTZ	RPM						
EF-1 THRU 3	SEE PLAN	75	0.25	120	1	60	580	15.89	4.71	DIRECT	WALL SWITCH	GREENHECK SP-B50	SEE NOTES BELOW

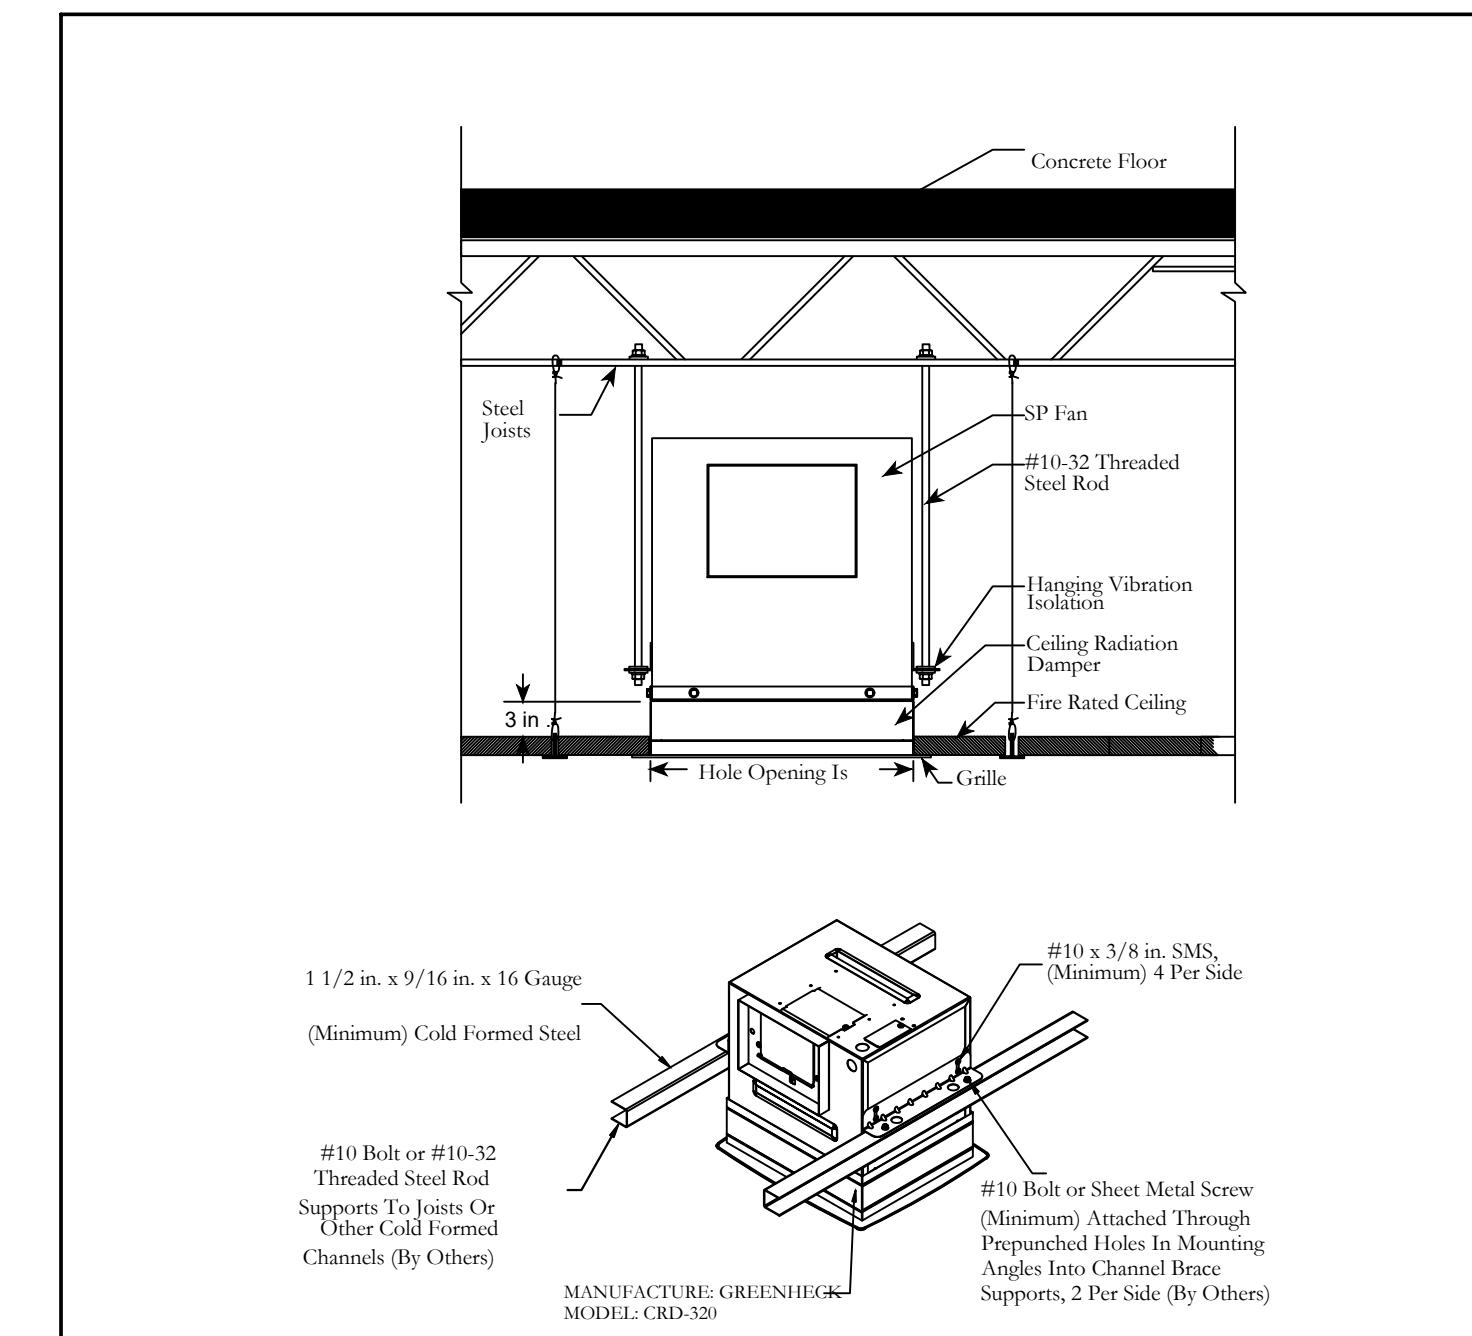

2 EXHAUST/ FIRE DAMPER DETAIL
SCALE: 1/4"=1'-0"

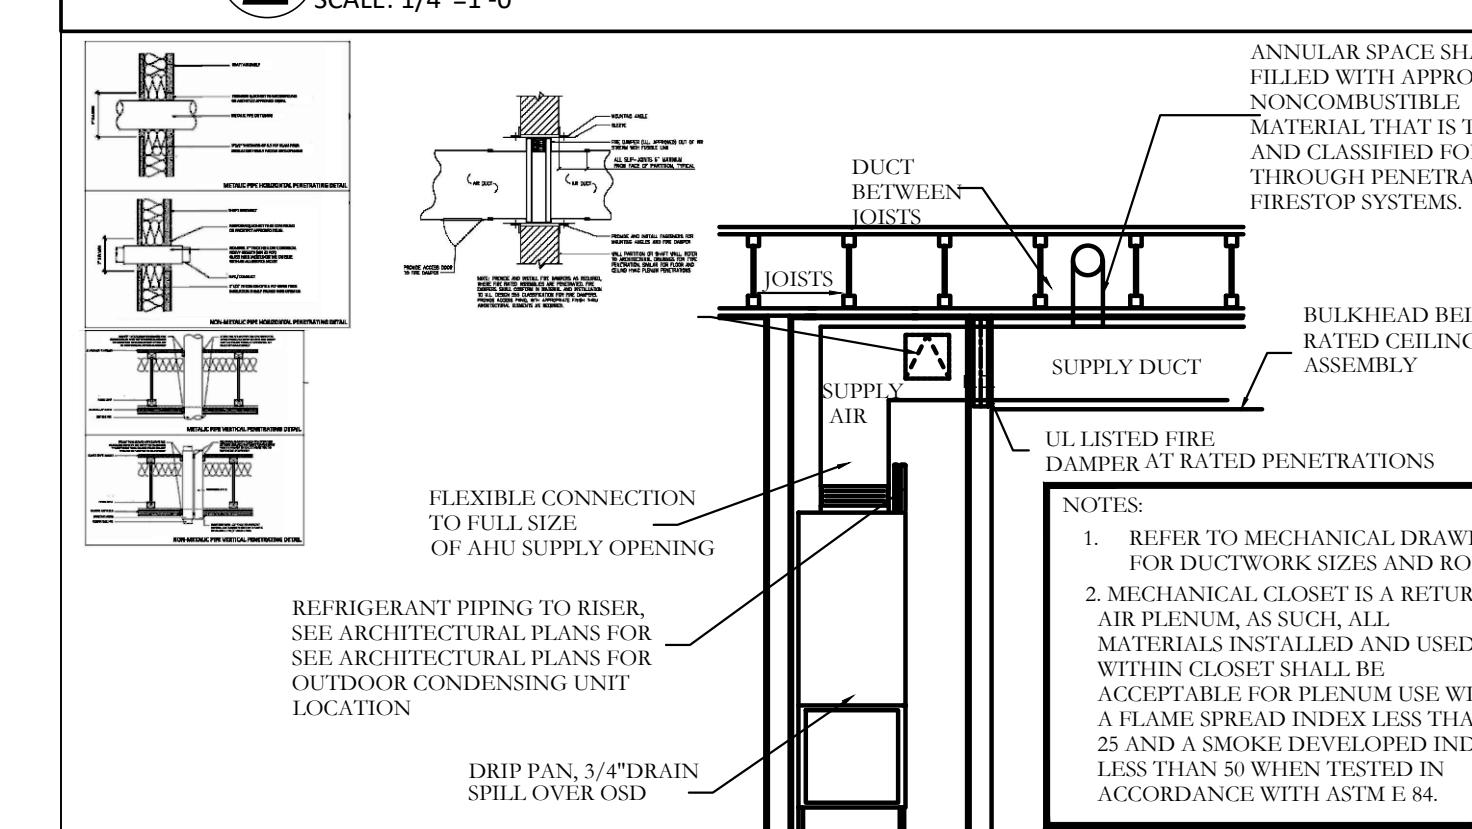

3 FIRE PENETRATION DETAILS
SCALE: 1/4"=1'-0"

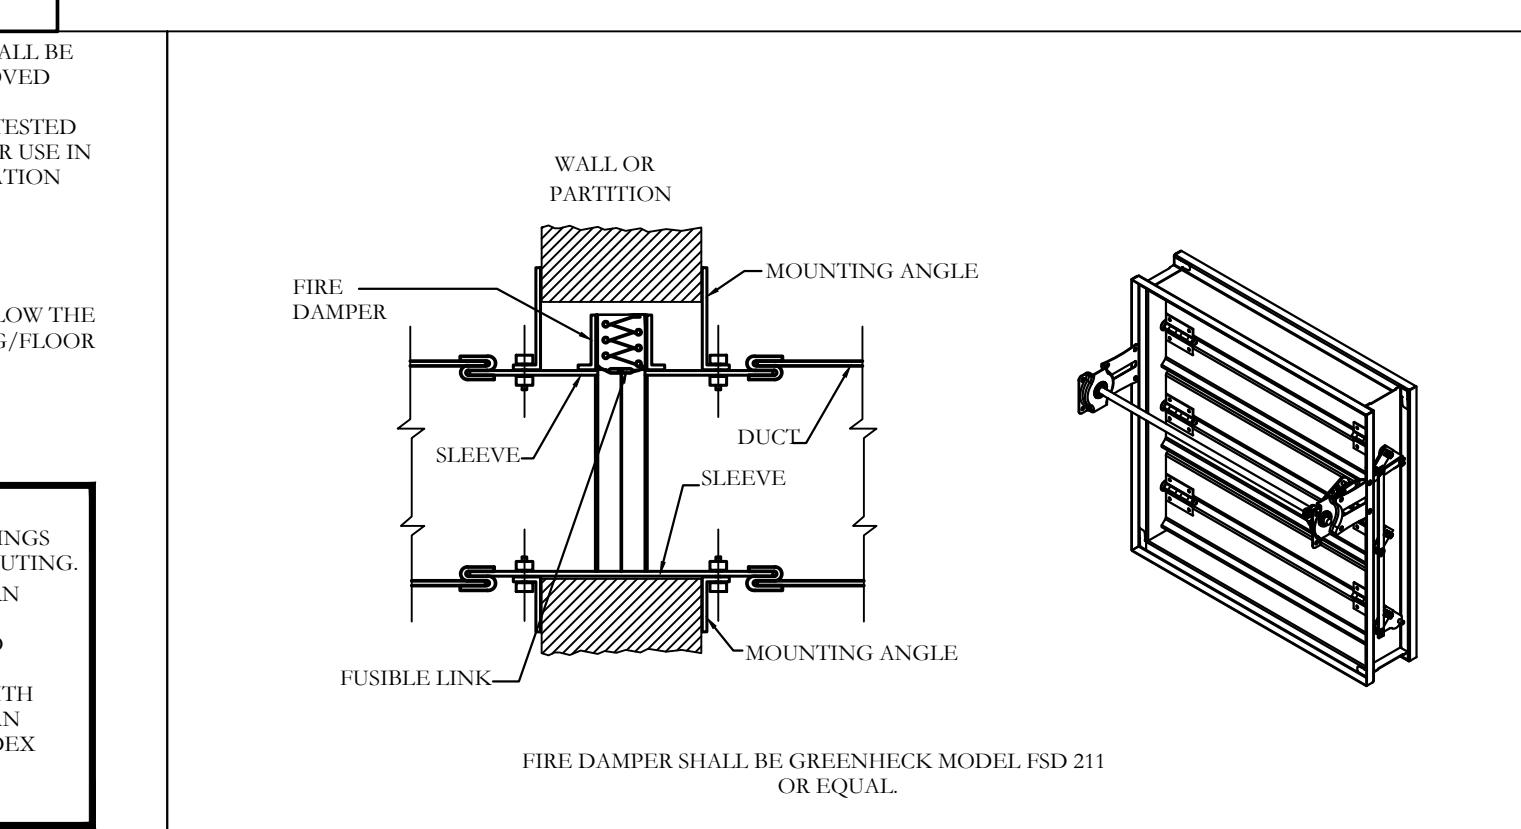

4 DUCT FIRE DAMPER DETAIL
SCALE: 1/4"=1'-0"




Project number	H096
Date	11/26/2024
Drawn by	S
Checked by	K
M200	
Scale	3/16" = 1'-0"

A&I
Design

Architecture & interiors planning
7373 McWhirter PI.
Annandale, VA 22003
WWW.AldesignDC.com
703-507-3146

AS BUILT SET

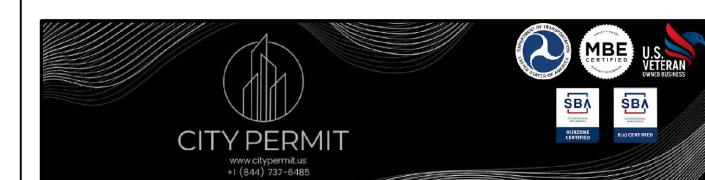

3 Story Town Home
1332 Harvard St NW,
Washington, DC 20009




Design - Consultants - Management - Permits
ADDRESS: 8318 LIBERIA AVE. MANASSAS VA. 20110
E: KHALID@LAMAENGINEERS.COM
LAMAENGINEERS@OUTLOOK.COM
TEL: 571-833-8357

No.	Description	Date
△	Permit set	11/26/2024
△	Permit comment	01/06/2025

**BASEMENT FLOOR
PLAN, SCHEDULES
AND DETAILS**

Project number	H096
Date	11/26/2024
Drawn by	S
Checked by	K
M200	
Scale	3/16" = 1'-0"

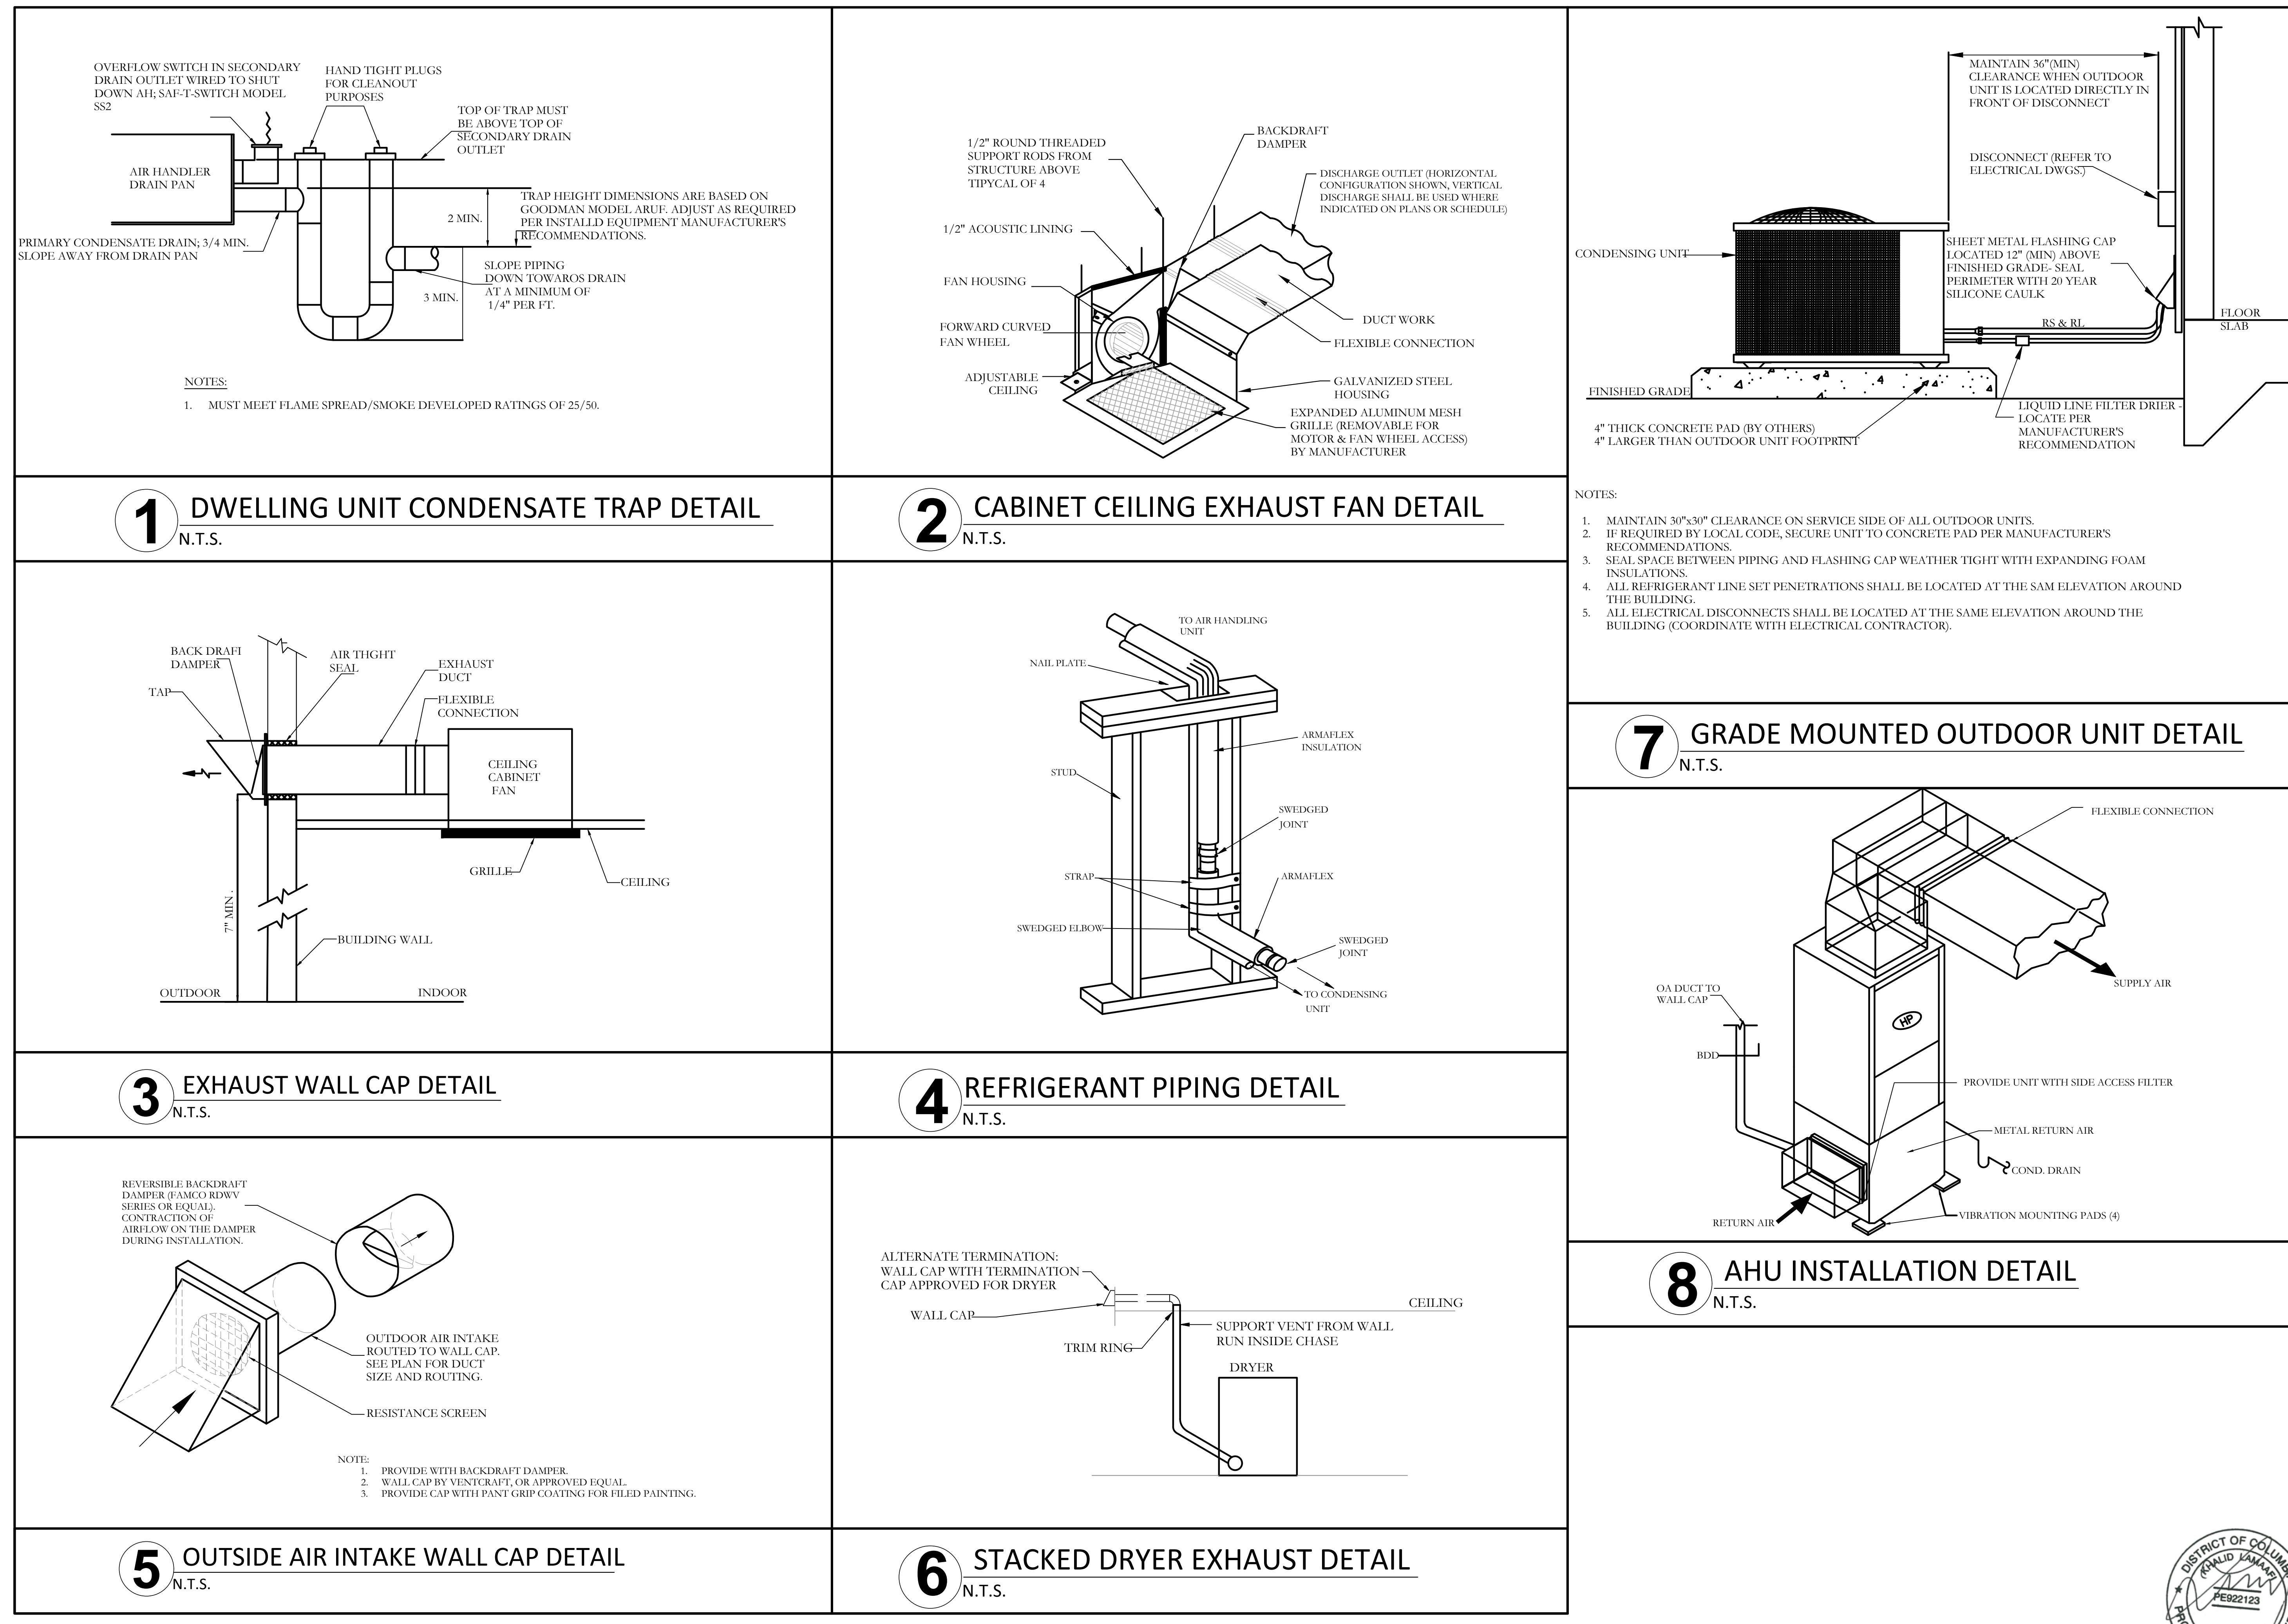

A&I
Design
Architecture & interiors planning
7373 McWhirter Pl.
Annandale, VA 22003
WWW.AldesignDC.com
703-507-3146

AS BUILT SET



3 Story Town Home
1332 Harvard St NW,
Washington, DC 20009



Design - Consultants - Management - Permit

ADDRESS: 8318 LIBERIA AVE. MANASSAS VA. 20110

E: KHALID@LAMAENGINEERS.COM

LAMAENGINEERS@OUTLOOK.COM

TEL: 571-833-8357

No.	Description	Date
1	Permit set	11/26/2024
2	Permit comment	01/06/2025
3		
4		
5		
6		
7		
8		


Project number	H096	
Date	11/26/2024	
Drawn by	S	
Checked by	K	
Scale	3/16" = 1'-0"	

M300

DISTRICT OF COLUMBIA
KHALID KAMARIAH
PE922123
01/06/2025


PLUMBING NUMBERED NOTES:

① CONTRACTOR TO VERIFY EXACT SIZE AND LOCATION OF THE PIPING IN THE FIELD

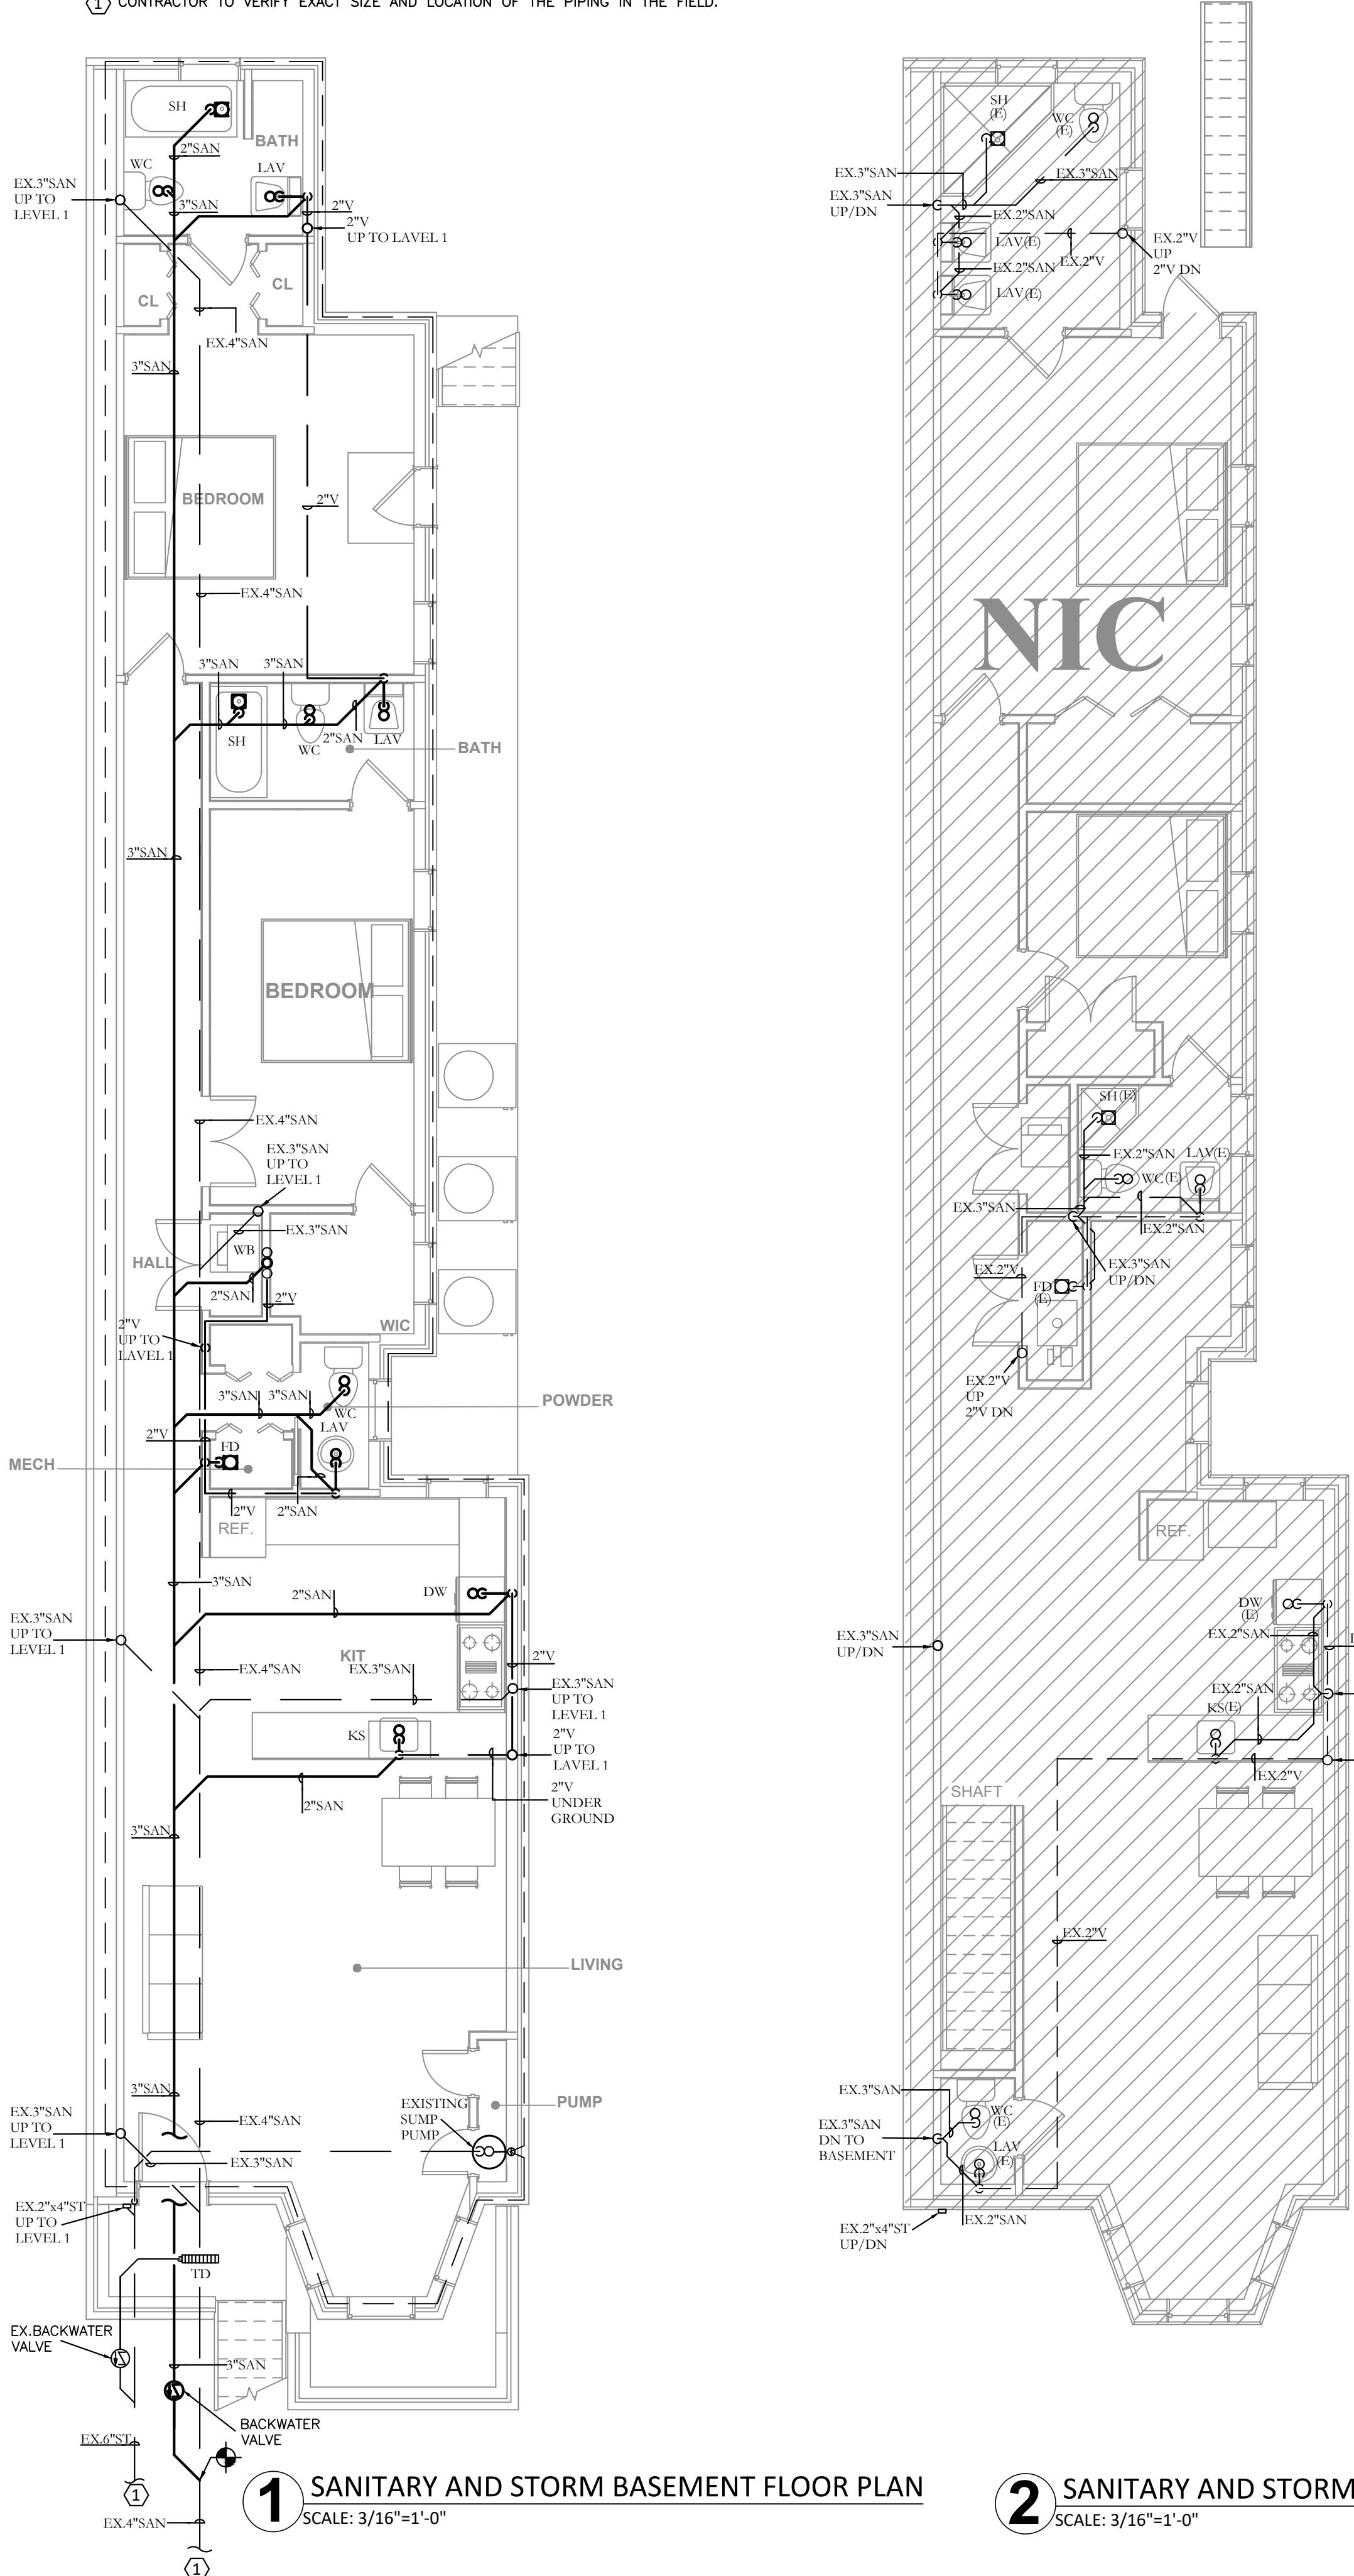


2 SANITARY AND STORM FLOOR PLAN-LEVEL

SCALE: 3/16"=1'-0"

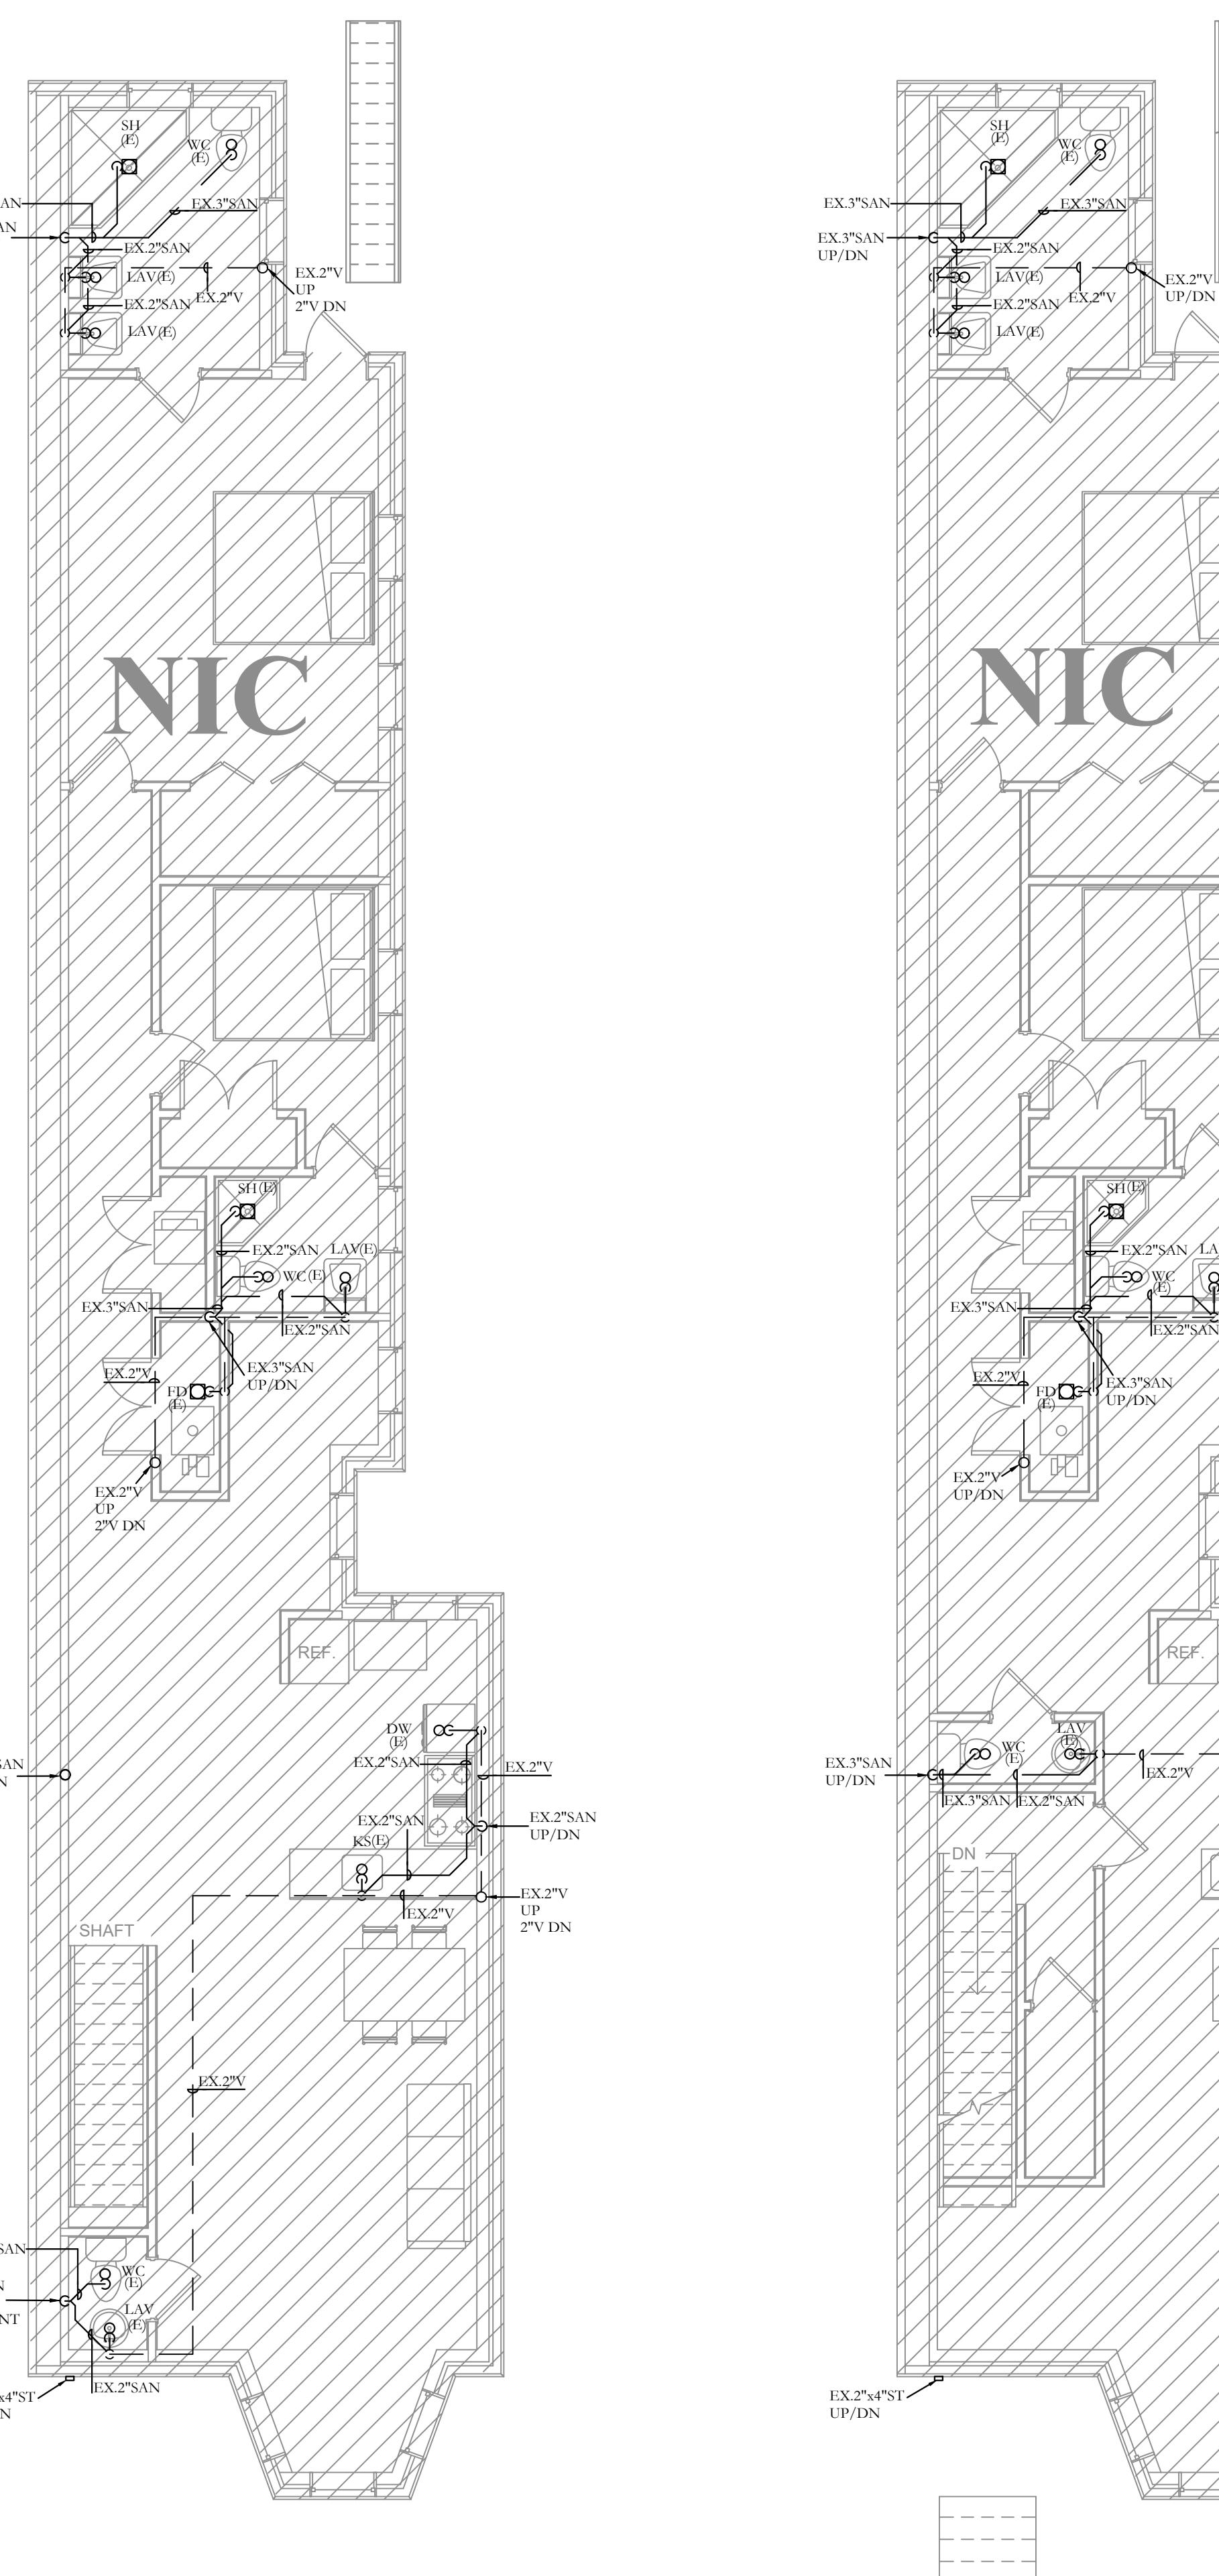


3 SANITARY AND STORM FLOOR PLAN-LEVEL

SCALE: 3/16"=1'-0"

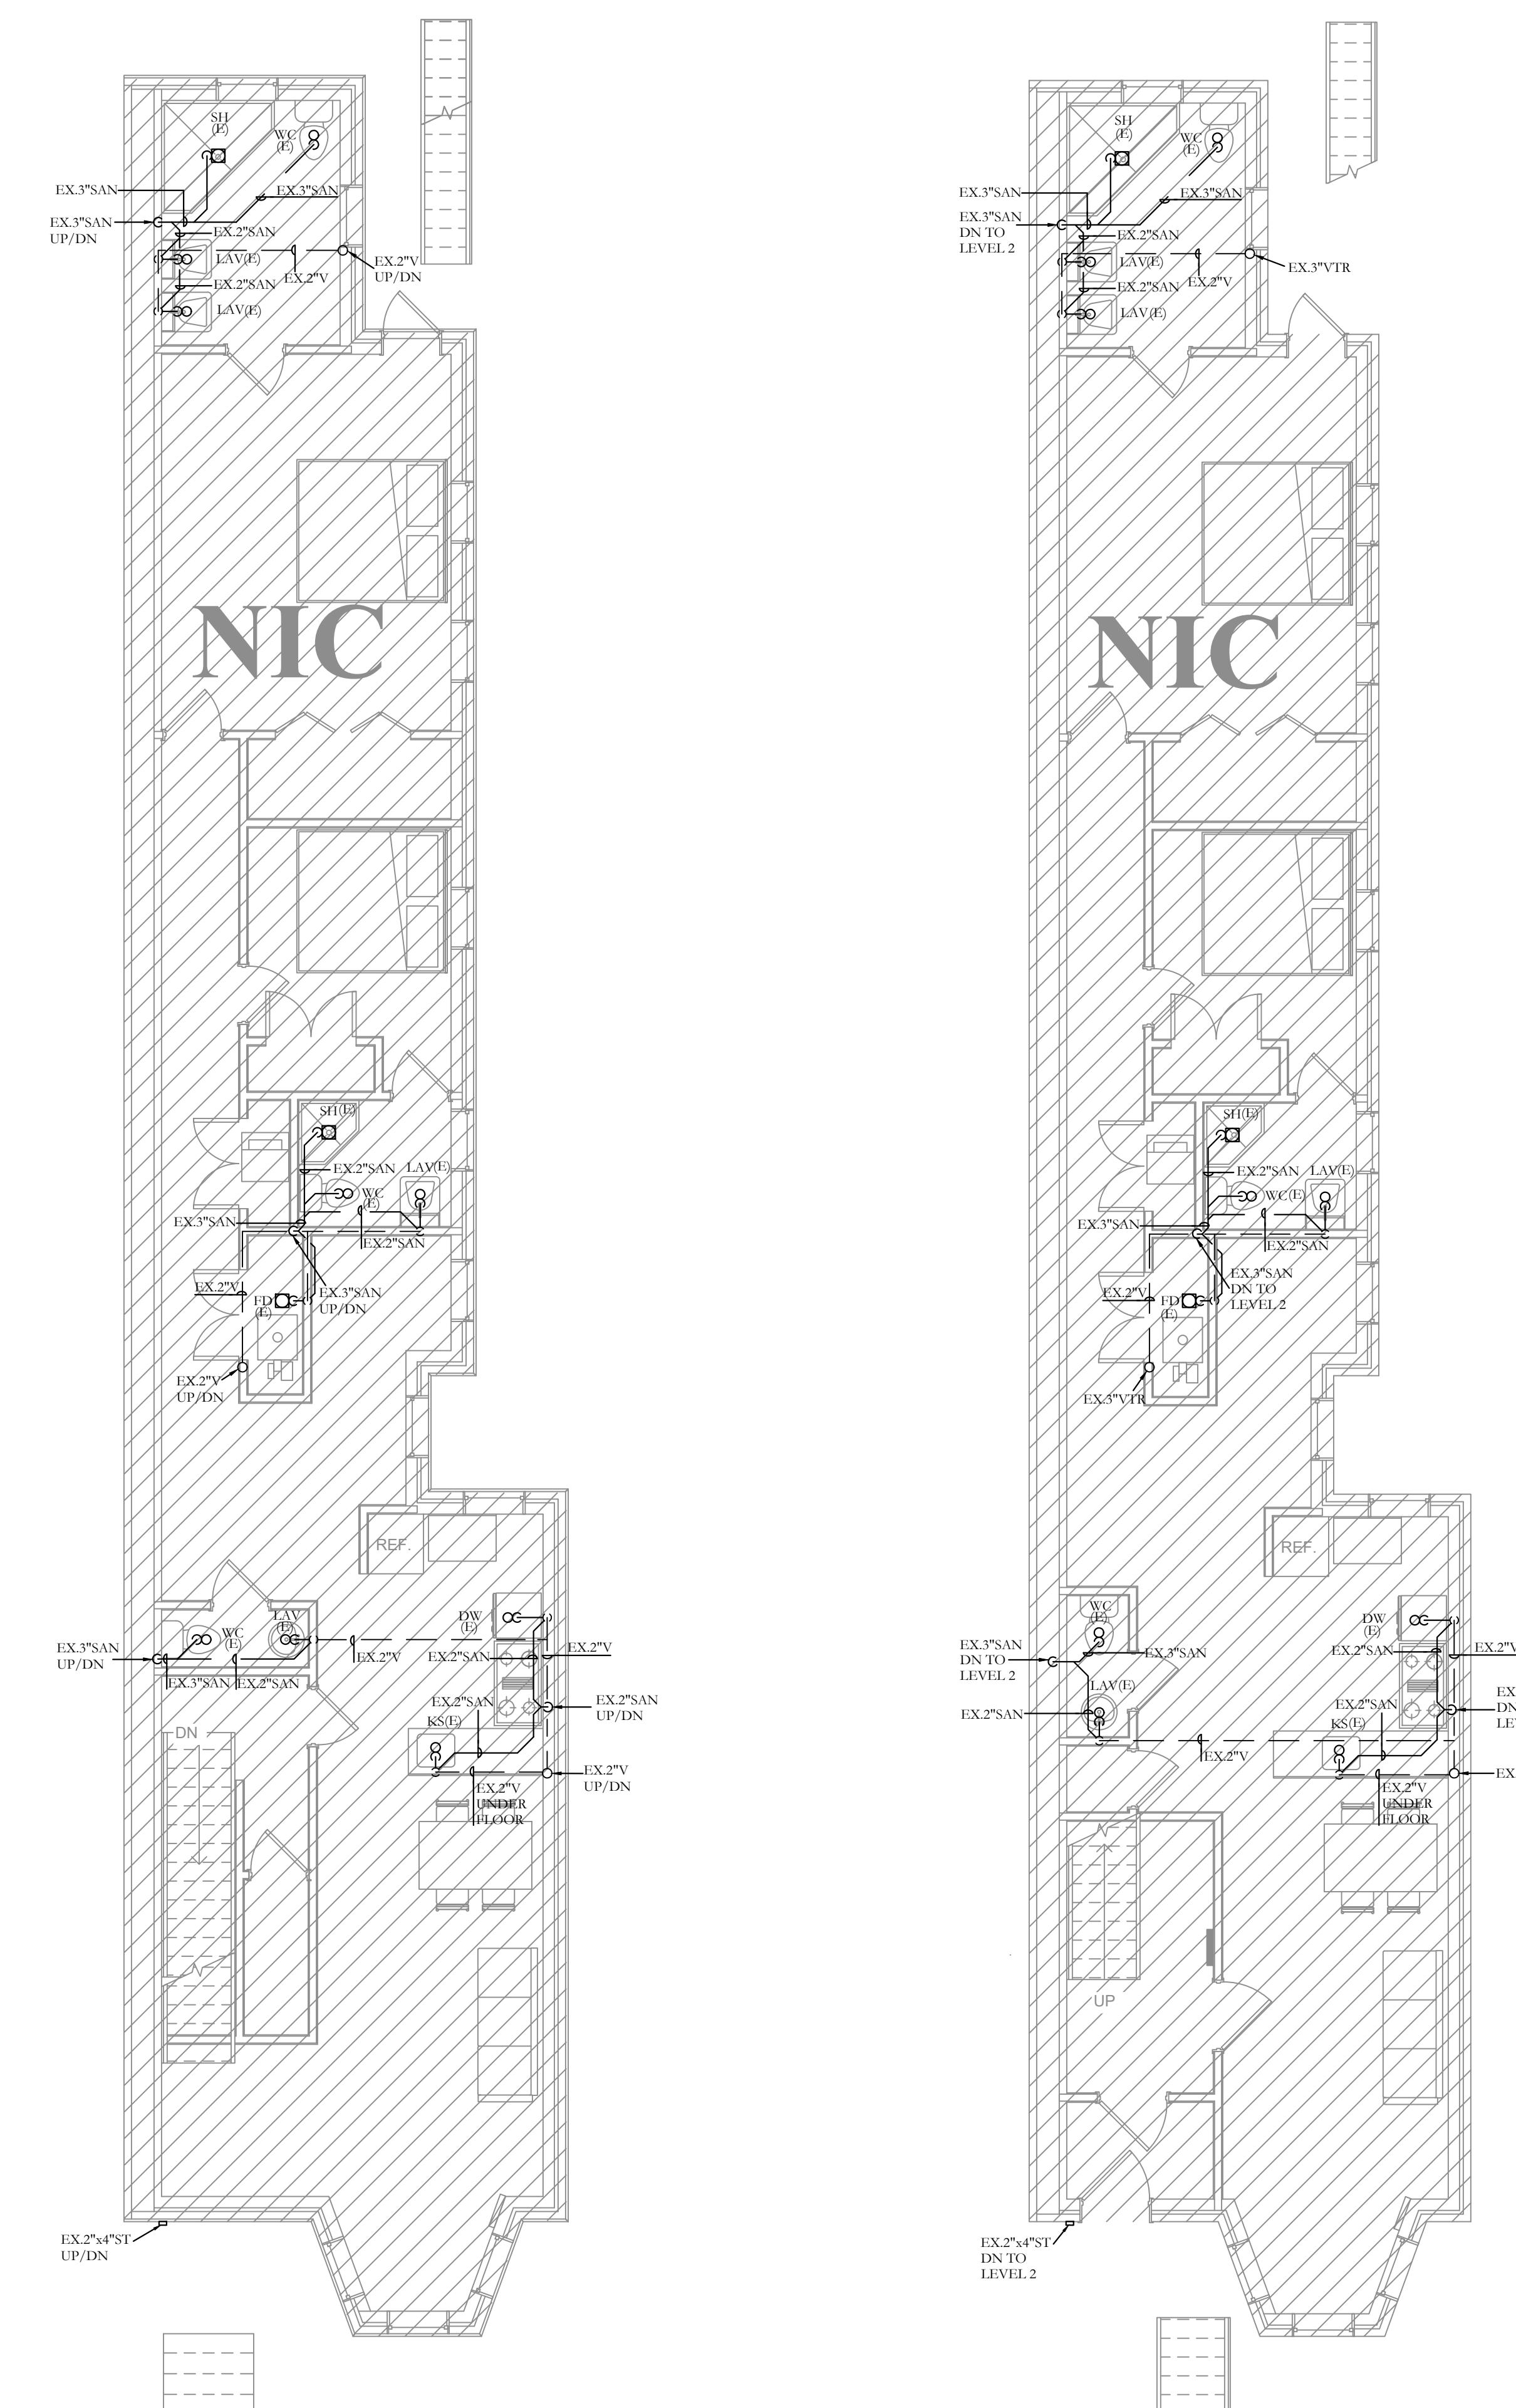

4 SANITARY AND STORM FLOOR PLAN-LEVEL 3

SCALE: 3/16"=1'-0"

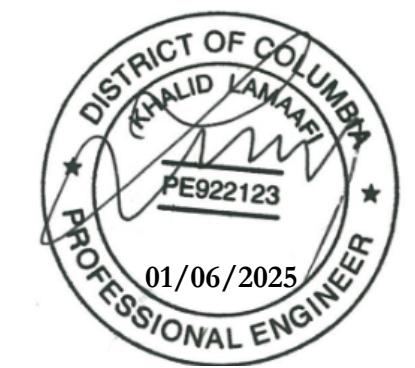

Project number	H096
Date	11/26/2024
Drawn by	S
Checked by	K
P200	
Scale	3/16" = 1'-0"

SANITARY AND STORM FLOOR PLANS

Project number	H096
Date	11/26/2024
Drawn by	S
Checked by	K
P200	
Scale	3/16" = 1'-0"

A&I Design

Architecture & Interiors planning
7373 McWhirter Pl.
Annandale, VA 22003
WWW.AldesignDC.com
703-507-3146

AS BUILT SET




3 Story Town Home


1332 Harvard St NW,
Washington, DC 20009



LAMA
ENGINEERS LLC
ign - Consultants - Management - Permit
SS: 8318 LIBERIA AVE. MANASSAS VA, 20110
: KHALID@LAMAENGINEERS.COM
LAMAENGINEERS@OUTLOOK.COM

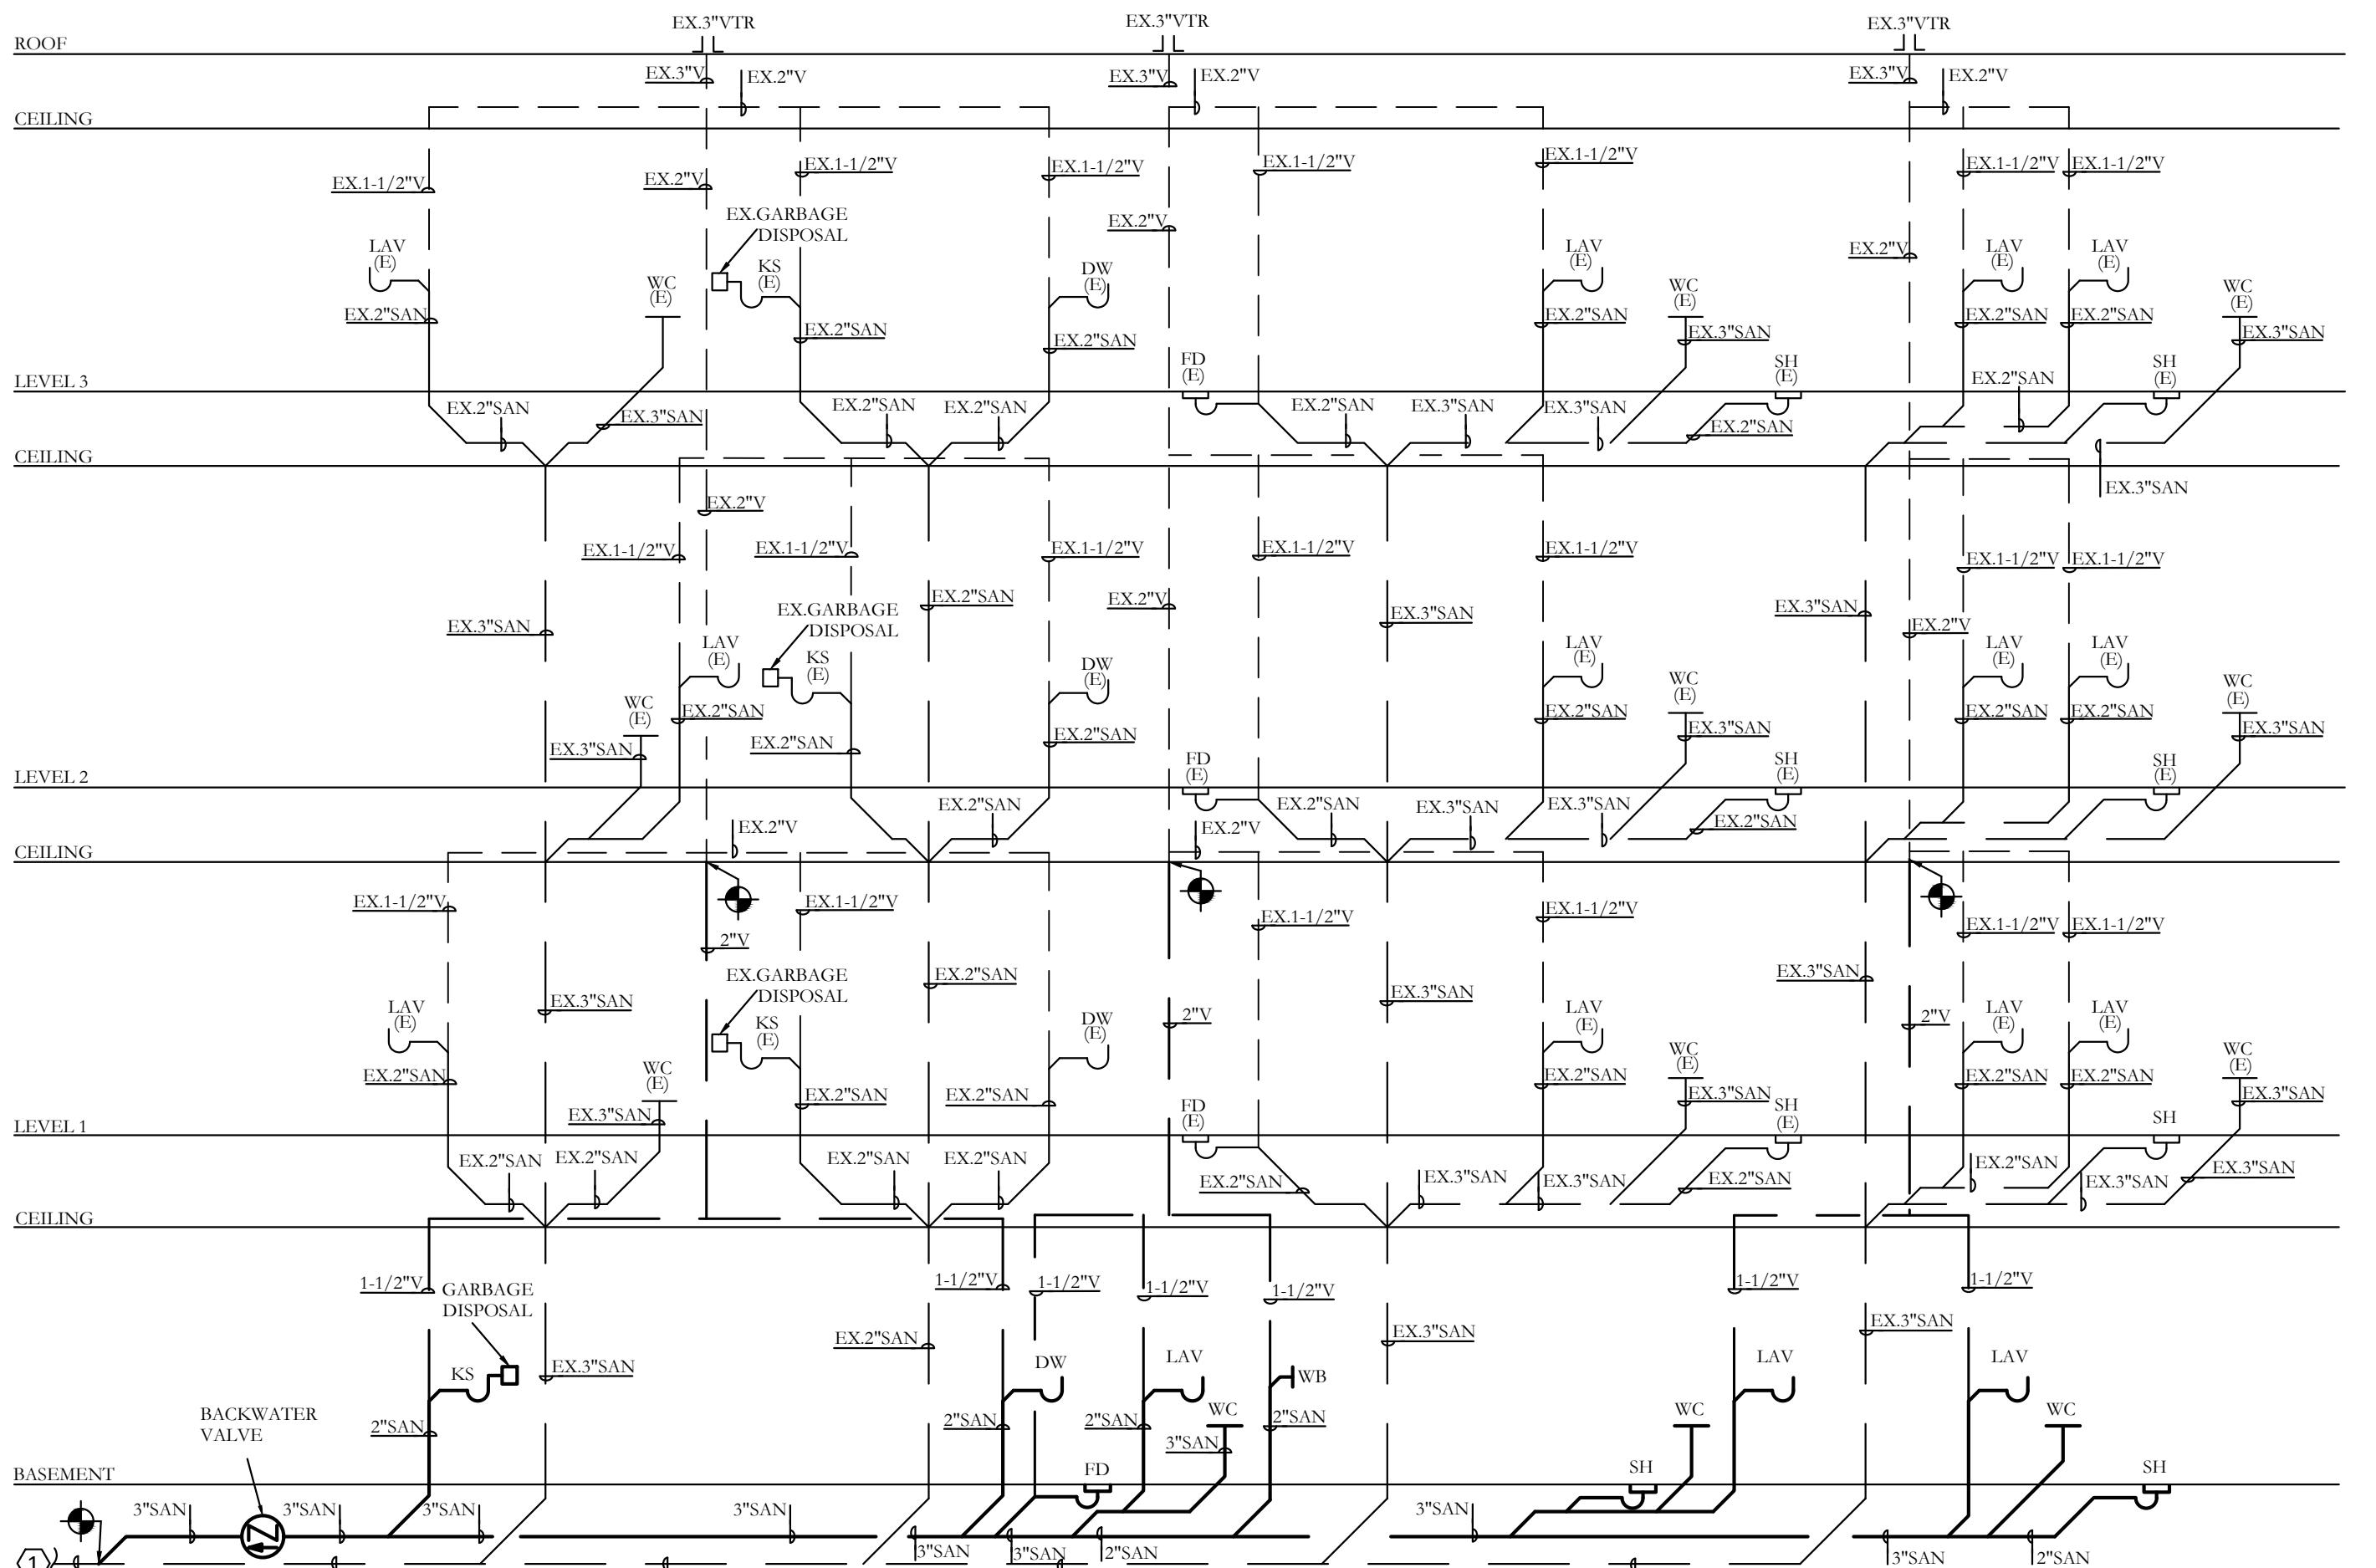


1 SANITARY RISER DIAGRAM

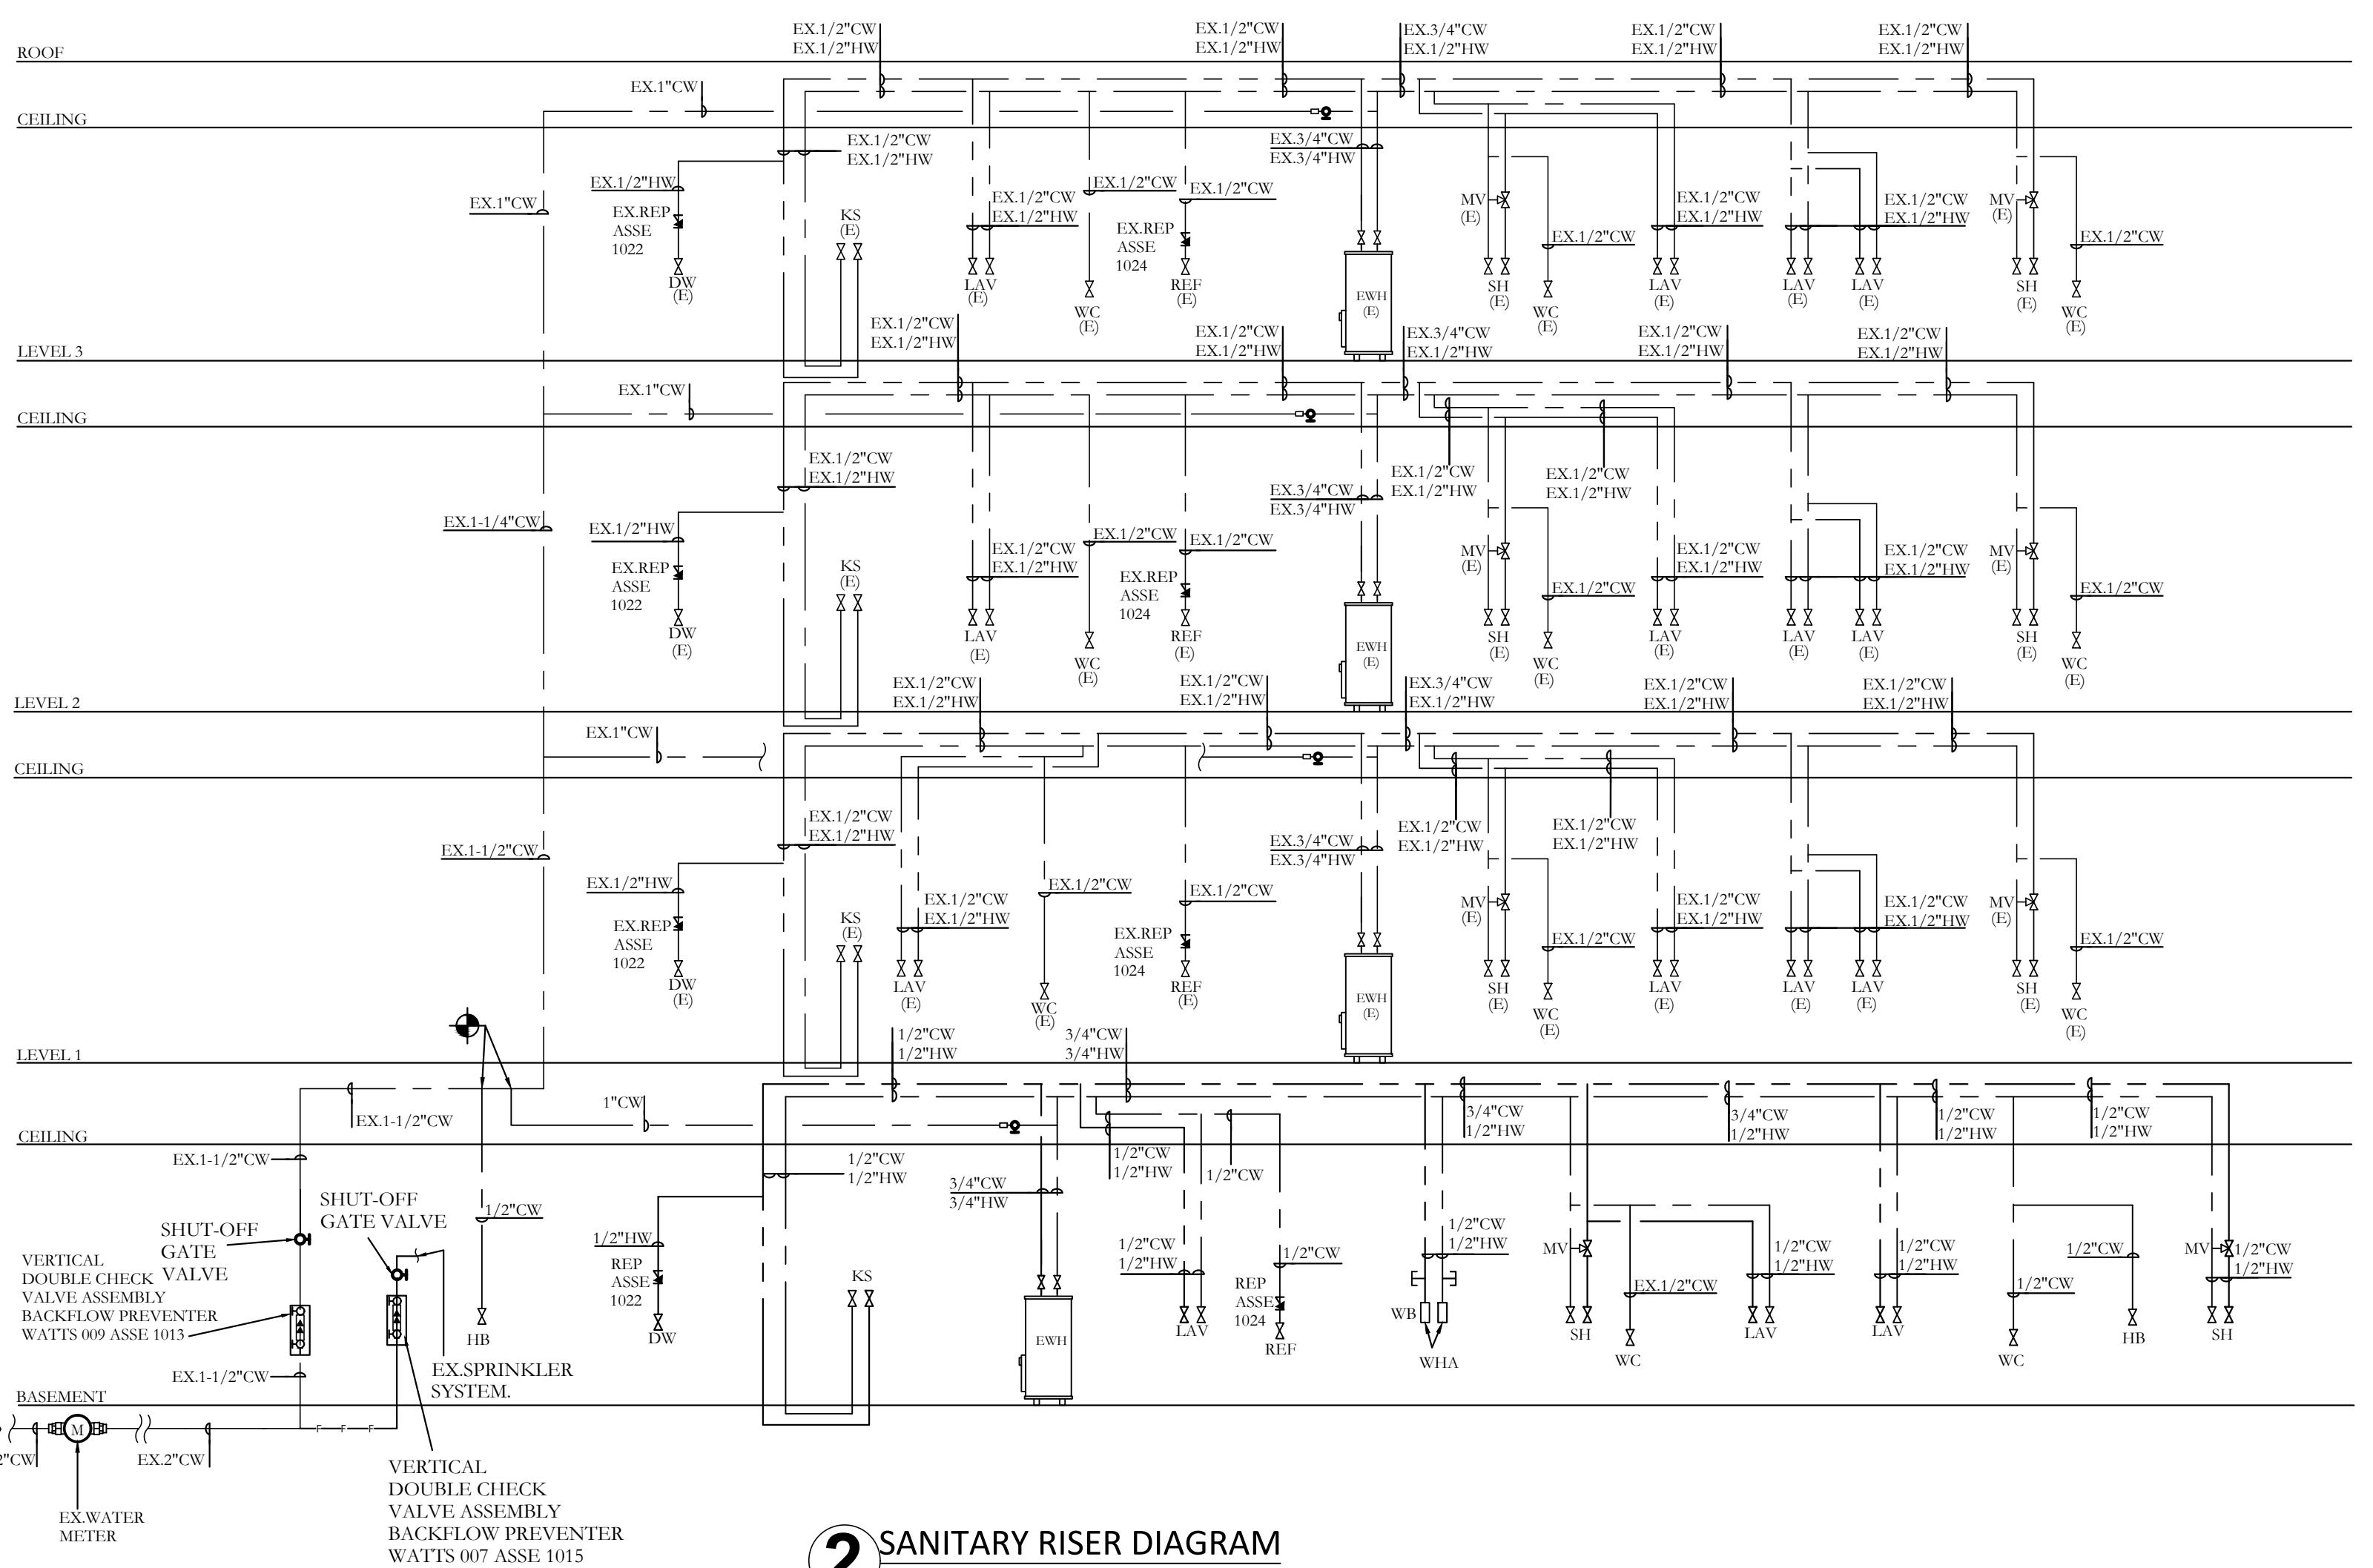


2 SANITARY RISER DIAGRAM N.T.S.

PLUMBING NUMBERED NOTES:

① CONTRACTOR TO VERIFY EXACT SIZE AND LOCATION OF THE PIPING IN THE FIELD.

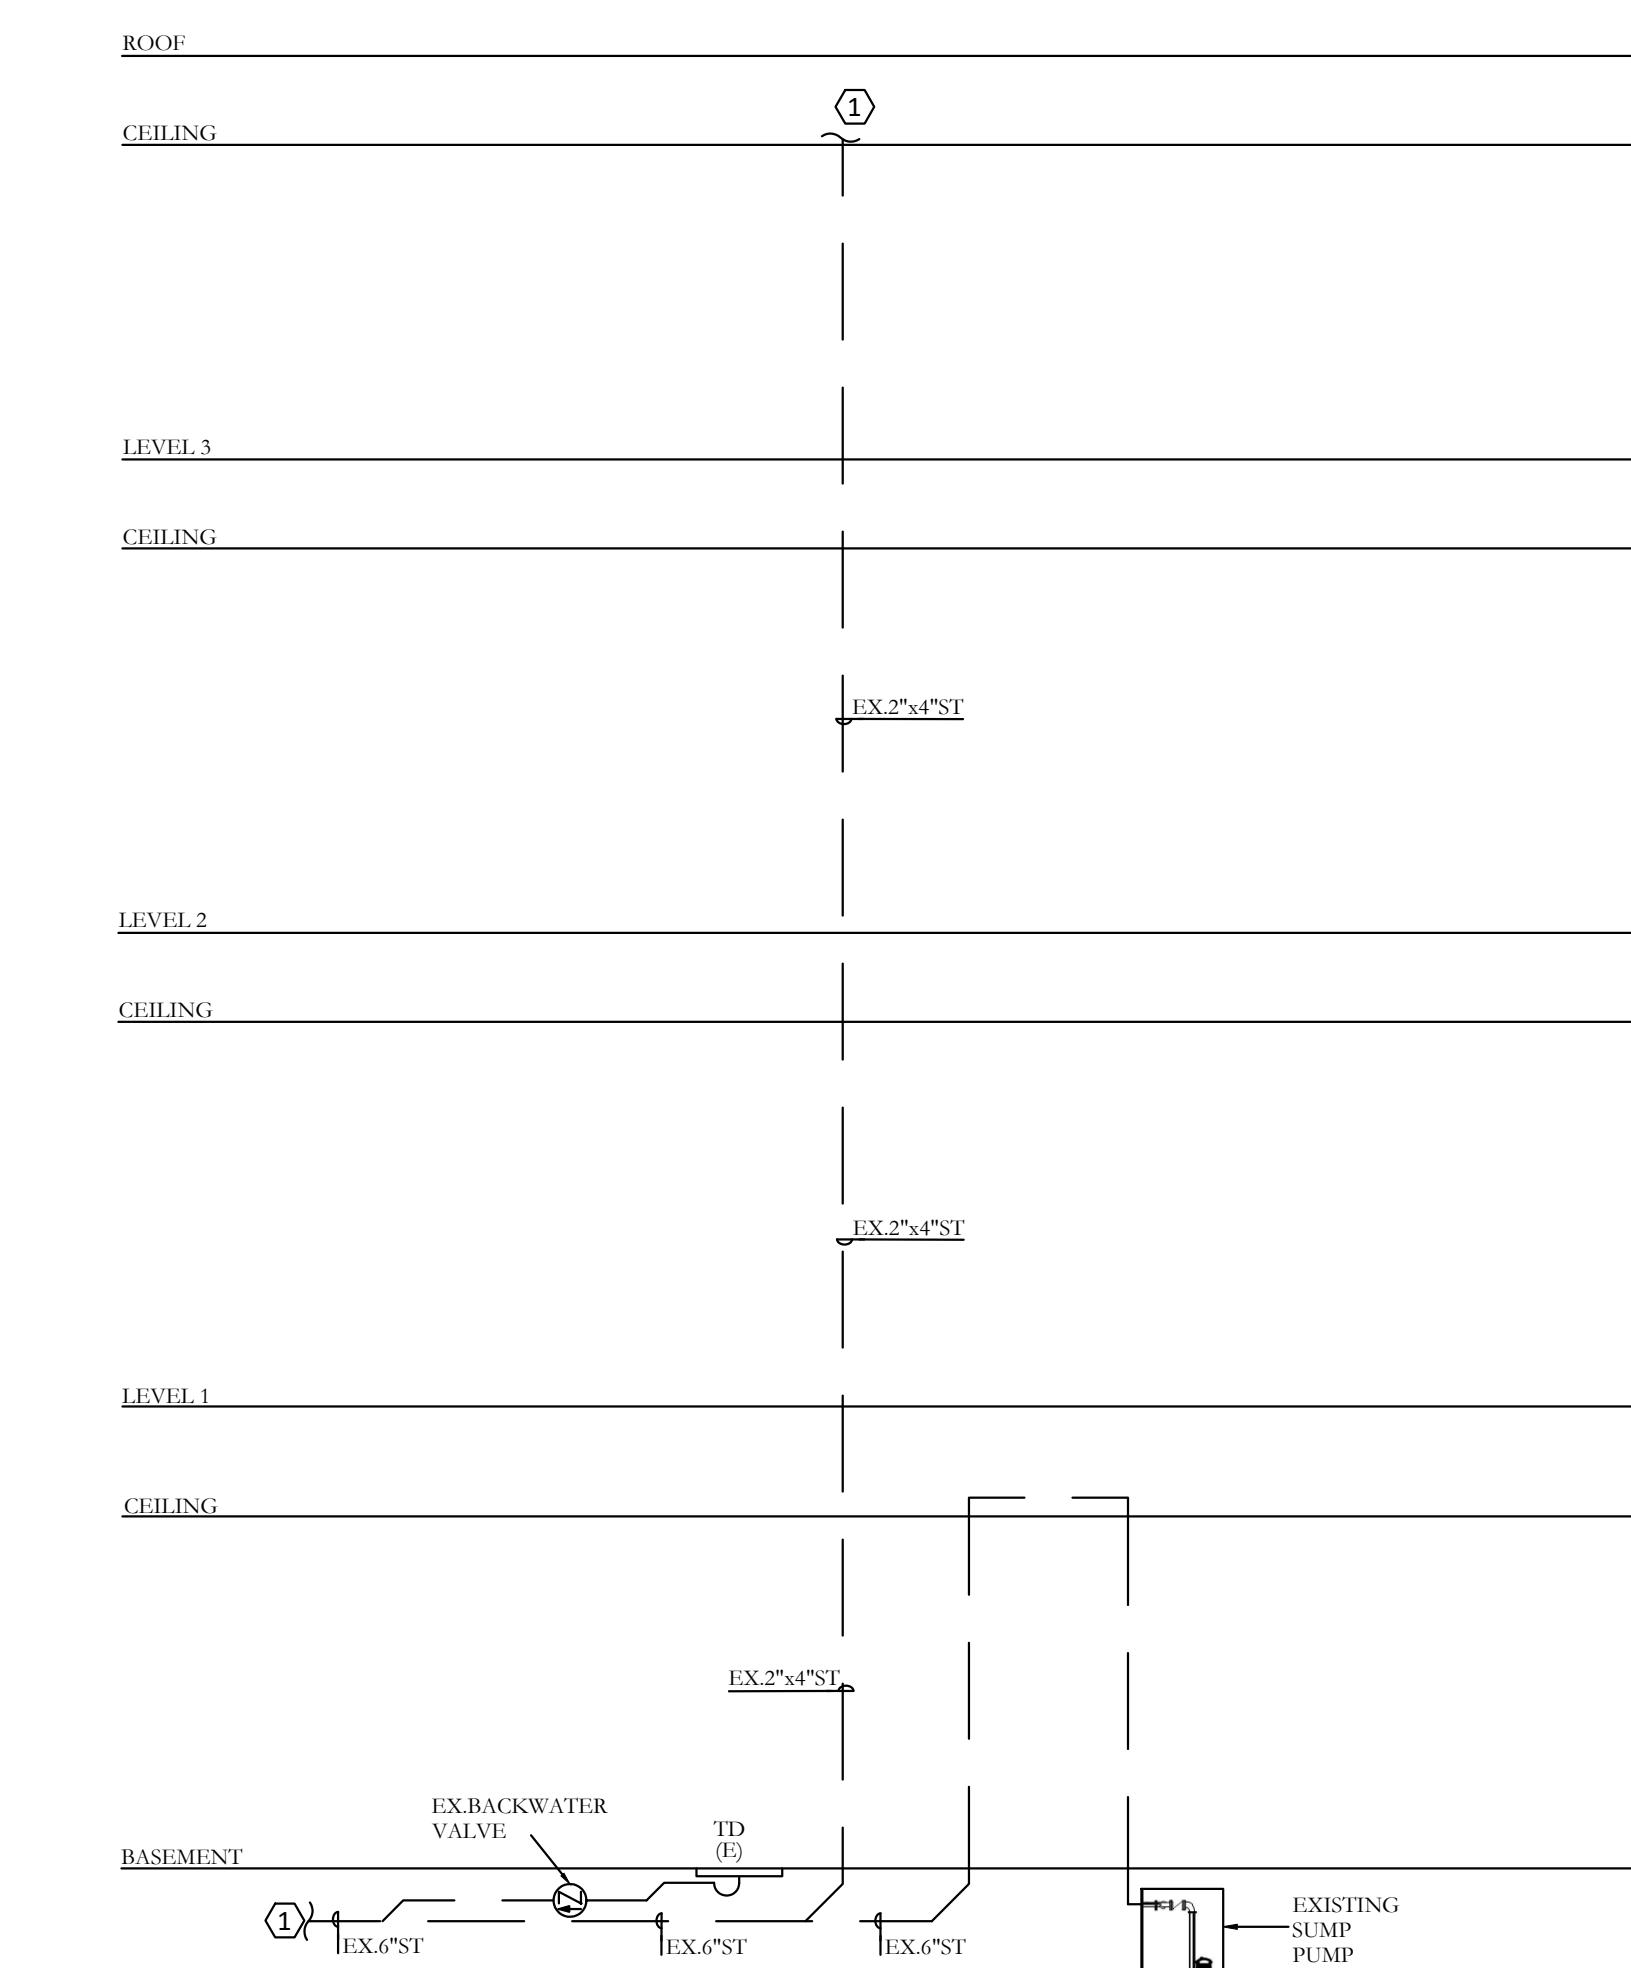

3 STORM RISER DIAGRAM N.T.S.

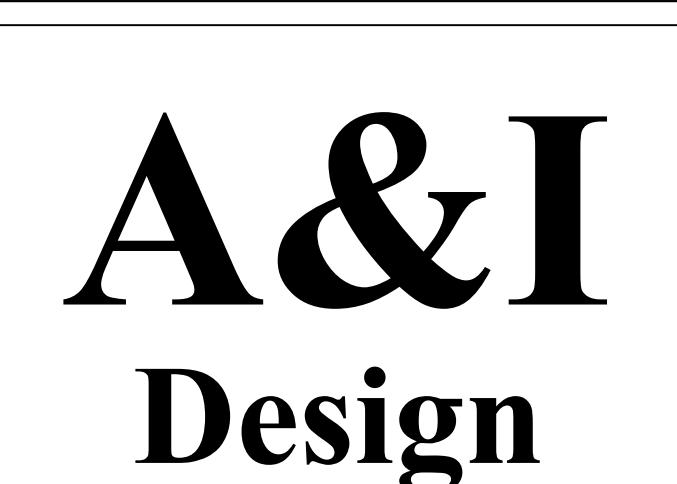

Architecture & Interiors planning
7373 McWhirter Pl.
Annandale, VA 22003
WWW.AldesignDC.com
703-507-3146

AS BUILT SET




3 Story Town Home

1332 Harvard St NW,
Washington, DC 20009



LAMA
ENGINEERS LLC
Design - Consultants - Management - Permit
ADDRESS: 8318 LIBERIA AVE. MANASSAS VA, 20110
E : KHALID@LAMAENGINEERS.COM
LAMAENGINEERS@OUTLOOK.COM
TEL : 571-833-8357

RISER DIAGRAMS

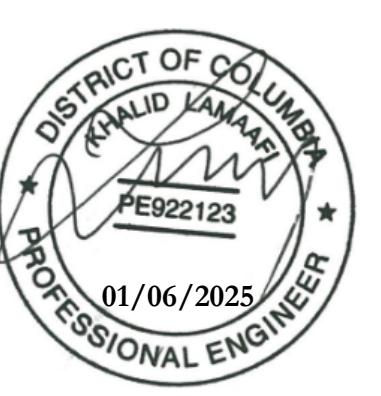

P400

3/1
