



PUD MODIFICATIONS

CASE NOS. 05-36-36 I

Owner / Developer
Toll DC II LP

Land Use Counsel
Holland & Knight

Architect
Davis Carter Scott Ltd

Civil Engineer
Wiles Mensch Corporation

Landscape Architect
Landscape Architecture Bureau

Structural Engineer
SK &A Structural Eng. PLLC


MEP Engineer
Schwartz Suevers Anolia Eng. LLC

OCTOBER 30,2014

DRAWING INDEX (PROPOSED)

G-001	ZONING PLAN AND TABULATION
G-002	AREA MAP
G-003	VICINITY IMAGES
C-101A	EXISTING CONDITIONS
C-101B	EXISTING CONDIONS
C-103A	EROSION AND SEDIMENT CONTROL PLAN - PHASE 2A
C-103B	EROSION AND SEDIMENT CONTROL PLAN - PHASE 2A
C-103C	EROSION AND SEDIMENT COTROL PLAN - PHASE 2B
C-103D	EROSION AND SEDIMENT CONTROL PLAN - PHASE 2B
C-104A	SITE PLAN
C-104B	SITE PLAN
C-105A	UTILITY PLAN
C-105B	UTILITY PLAN
C-106A	GRADING PLAN
C-106B	GRADING PLAN
C-701	STORMWATER MANAGEMENT PLAN
L-1	OVERALL LANDSCAPE PLAN
L-2	LANDSCAPE PLAN
L-3	ILLUSTRATIVE COURTYARD PLAN
L-4	PERSPECTIVE VIEWS - COURTYARD ENTRANCE
L-5	PERSPECTIVE VIEW - COURTYARD
L-6	PERSPECTIVE VIEW - COURTYARD
L-7	PERSPECTIVE VIEW - COURTYARD ENTRANCE
A-201	PARKING LEVEL G2
A-202	PARKING LEVEL G1
A-203	1st FLOOR PLAN
EX-203	1st FLOOR PLAN APPROVED PUD
A-204	2nd FLOOR PLAN
EX-204	2nd FLOOR PLAN APPROVED PUD
A-205	(NOT USED)
A-206	TYPICAL FLOOR PLAN
EX-206	TYPICAL FLOOR PLAN APPROVED PUD
A-207	ROOF PLAN
EX-207	ROOF PLAN APPROVED PUD
A-301	ELEVATION - K STREET (W/ TREES)
A-301a	ELEVATION - K STREET (W/O TREES)
EX-301	ELEVATION - K STREET APPROVED PUD
A-302	ELEVATION - 2nd STREET (W/ TREES)
A-302a	ELEVATION - 2nd STREET (W/O TREES)
EX-302	ELEVATION - 2nd STREET APPROVED PUD
A-303	ELEVATION - L STREET (W/ TREES)
A-303a	ELEVATION - L STREET (W/O TREES)
EX-303	ELEVATION - L STREET APPROVED PUD
A-304	ELEVATION - COURTYARD
EX-304	ELEVATION - COURTYARD APPROVED PUD
A-305	END ELEVATIONS
A-401	SITE SECTION
A-402	SITE SECTION
A-501	ELEVATION - K STREET - ENLARGEMENT
EX-501	ELEVATION - K STREET - ENLARGEMENT APPROVED PUD
A-502	ELEVATION - 2nd STREET - ENLARGEMENT
A-503	ELEVATION - 2nd STREET - ENLARGEMENT
A-504	ELEVATION - 2nd STREET - MATERIALS
EX-504	ELEVATION - 2nd STREET - MATERIALS APPROVED PUD
A-505	PERSPECTIVE - K STREET
A-506	PERSPECTIVES - 2nd STREET
EX-506	PERSPECTIVES - 2nd STREET APPROVED PUD
A-507	PERSPECTIVE - L STREET
A-507a	PERSPECTIVE - L STREET (W/O TREES)
EX-507	PERSPECTIVES - L STREET APPROVED PUD

ZONING COMMISSION
District of Columbia
CASE NO.05-36I
EXHIBIT NO.24A

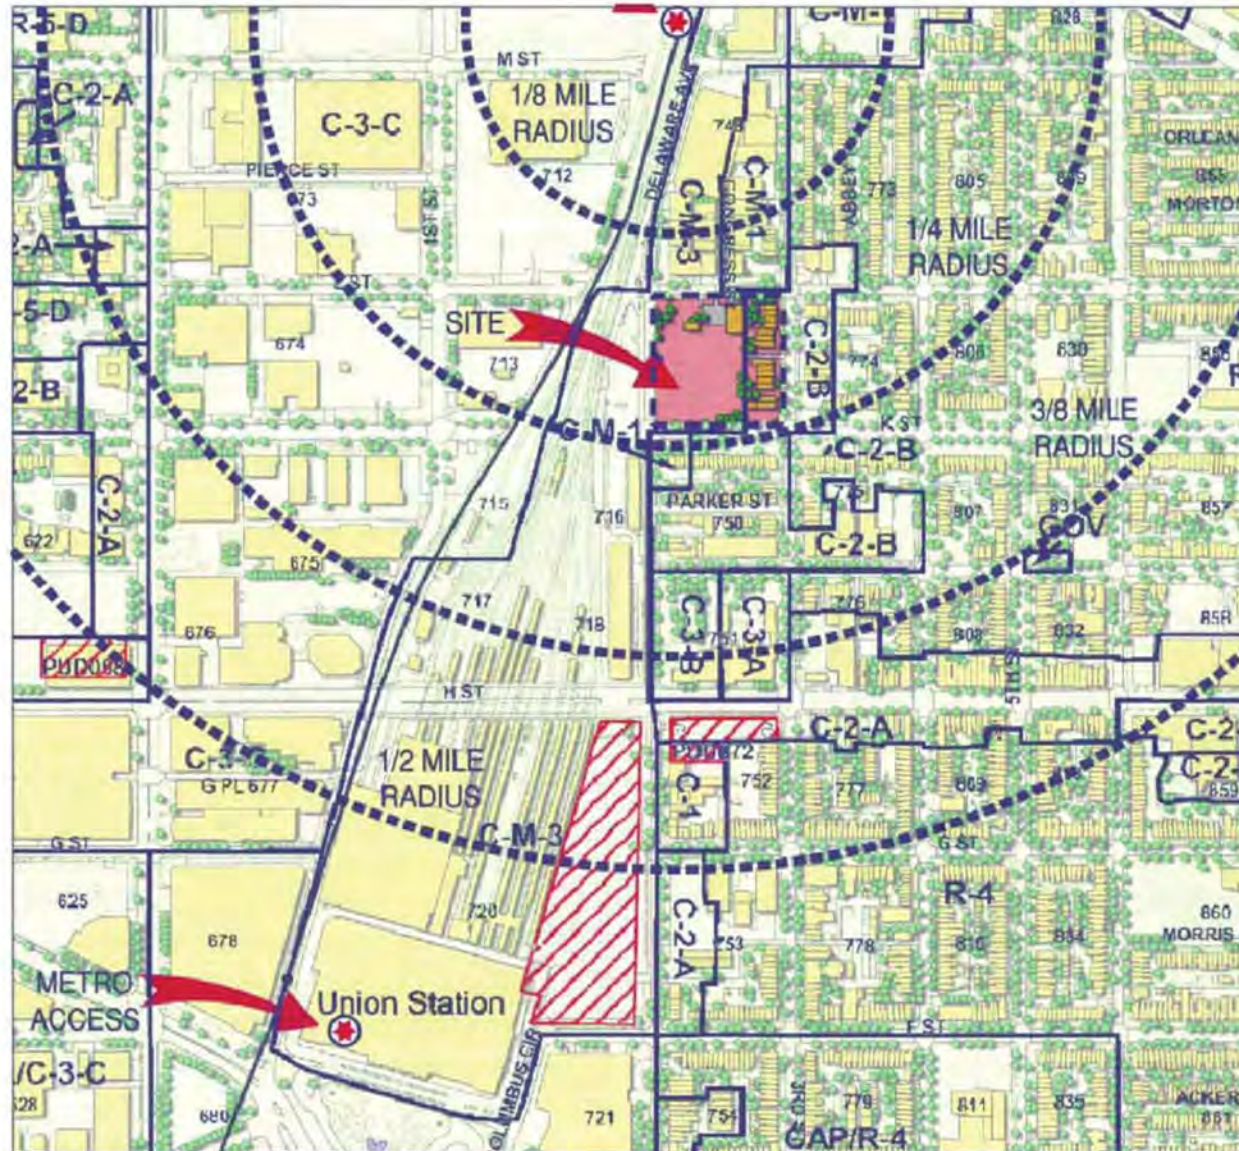

1 ZONING AND VICINITY MAP
SCALE: NTS

ZONING TABULATION

Zone:	C-3-C PUD		
Square:	749		
Lots:	67	828 for Phase-1	
		826, 827 for Phase-2A & 2B	
	31	804, 805, 830 for Phase-3	
Site Area:	Phase - 1	42,839 sf	(as per served by CAS Engineering on 6/27/2008)
	Phase - 2	58,263 sf	(as per served by Wiles Mensch Corp - DC on 11/20/2011)
	Phase - 3	5,295 sf	(as per CAS Engineering Dwg dated 01/14/2013)
		106,397 sf	Total Site Area

Floor Area (FAR) Allowed: 893,735 sf 8.4 FAR as per Approved PUD



Total FAR Proposed by Phases:	Phase - 1	236,905 sf
	Phase - 2A	321,548 sf
	Phase - 2B	238,130 sf
	Phase - 3	34,293 sf
	Total	7.81 FAR 830,876 sf

Number of Dwelling Units	Phase - 1	212
	Phase - 2A	296
	Phase - 2B	229
	Phase - 3	41
	Total	778

	PER APPROVED PUD ORDER No. 05-36A	PROVIDED / PROPOSED
GROSS FLOOR AREA TOTAL *	555,545 sf	559,678 sf
RESIDENTIAL UNITS	415,307 sf	450,742 sf
RETAIL	13,801 sf (incl. daycare 3,446 sf)	16,398 sf (Incl. daycare 6,475 sf)
RESIDENTIAL ANCILLARY USE (Amenity area, fitness center, multi-purpose romms)	13,328 sf	12,719 sf
CORE/SERVICE (Elevators, stairs, corridors, loading areas, trash room utility rooms, storage areas)	113,109 sf	79,769 sf
FAR	Overall Site: 7.84	7.81
	Phase - 1 2.34	2.23
	Phase - 2 5.49	5.26
	Phase - 3 N/A	0.32
LOT OCCUPANCY:	68%	68%
BUILDING HEIGHT:	121'-0" from m.p. and 14 stories from intersection of 2nd & K st	130'-0" from m.p. at L street 14 stories from intersection of 2nd & K St.
PENTHOUSE HEIGHT:	18' - 0"	18' - 6"
PENTHOUSE AREA:	4,490 sf	3,915 sf
PARKING:	545	413 Total spaces 173 spaces in Phase-1 240 spaces in Phase -2A & 2B
LOADING BERTHS:	2 @ 55' DEEP	1 @ 30' DEEP
LOADING PLATFORMS:	2 @ 200 sf	1 @ 200 sf
SERVICE/DELIVERY LOADING:	2 @ 20' deep	1 @ 30' DEEP
TOTAL RESIDENTIAL UNIT AREA (90%)	373,749 sf	405,668 sf
AFFORDABLE RESID UNIT AREA (10%)	41,558 sf	45,074 sf
REAR YARD SETBACK	1/2 width of street (2nd Street) 1/2 (90'-0") = 45'	1/2 width of street (K Street) 1/2 (147'-0") = 73.5'
SIDE YARD	N/A	N/A

* NOTE:

1) FOR PURPOSE OF COUNTING FAR: GROSS FLOOR AREA DOES NOT INCLUDE: 1) BAY PROJECTING OVER
PROPERTY LINE AND 2) PARKING ACCESS RAMPS.

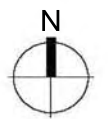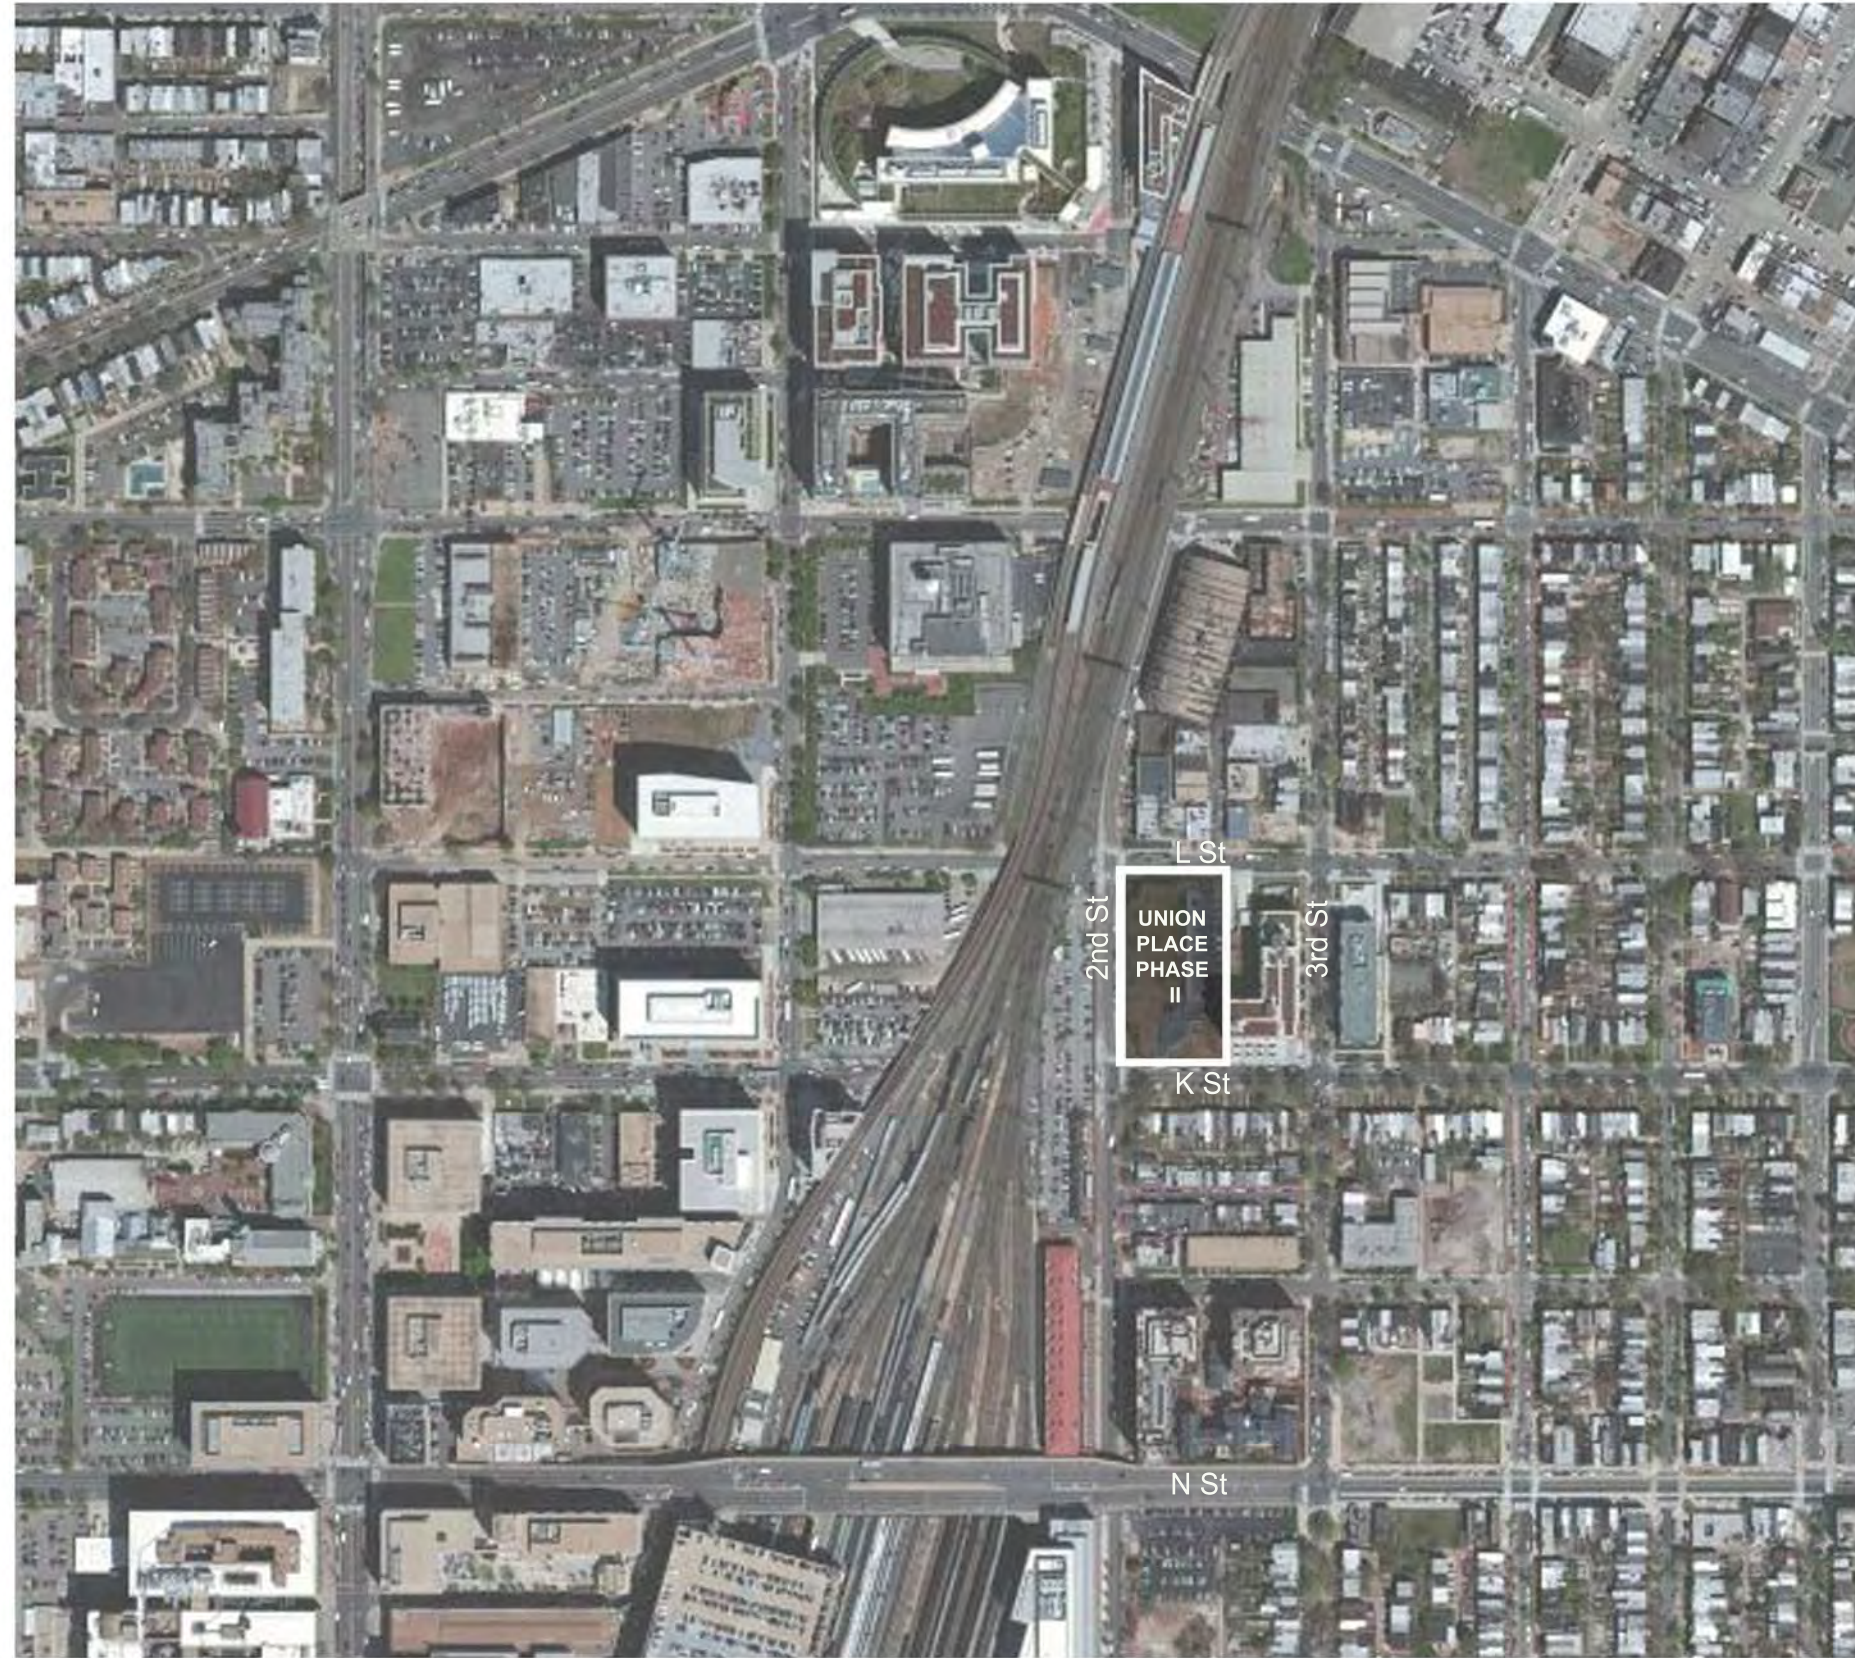



1 INTERSECTION OF 2ND AND L ST - VIEW SOUTH



2 INTERSECTION OF 2ND AND L ST - VIEW NORTH




3 L STREET OVERPASS - VIEW WEST



4 L STREET - VIEW WEST



9 K STREET OVERPASS - VIEW WEST

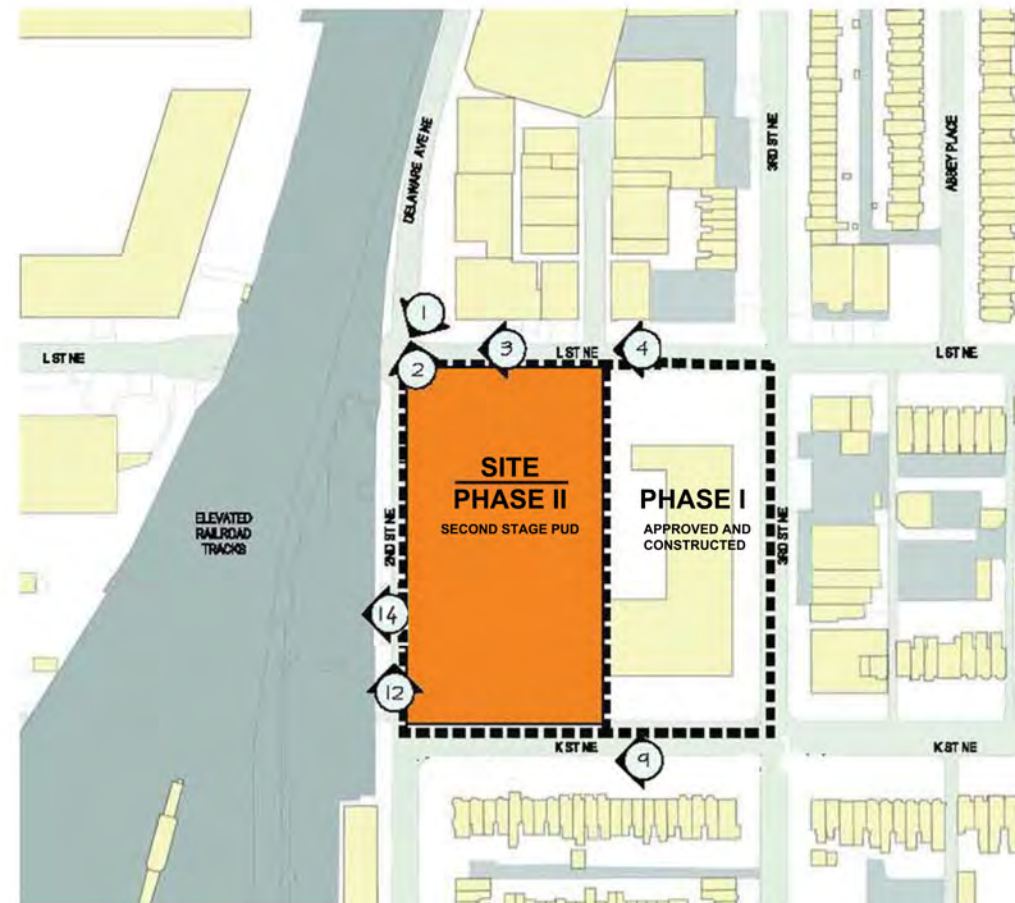

12 2ND STREET - VIEW NORTH




14 2ND STREET- WALL

UNION PLACE – Phase 2A / 2B

07/18/2014

C-101 Existing Conditions.dwg July 15, 2014, 12:18 pm

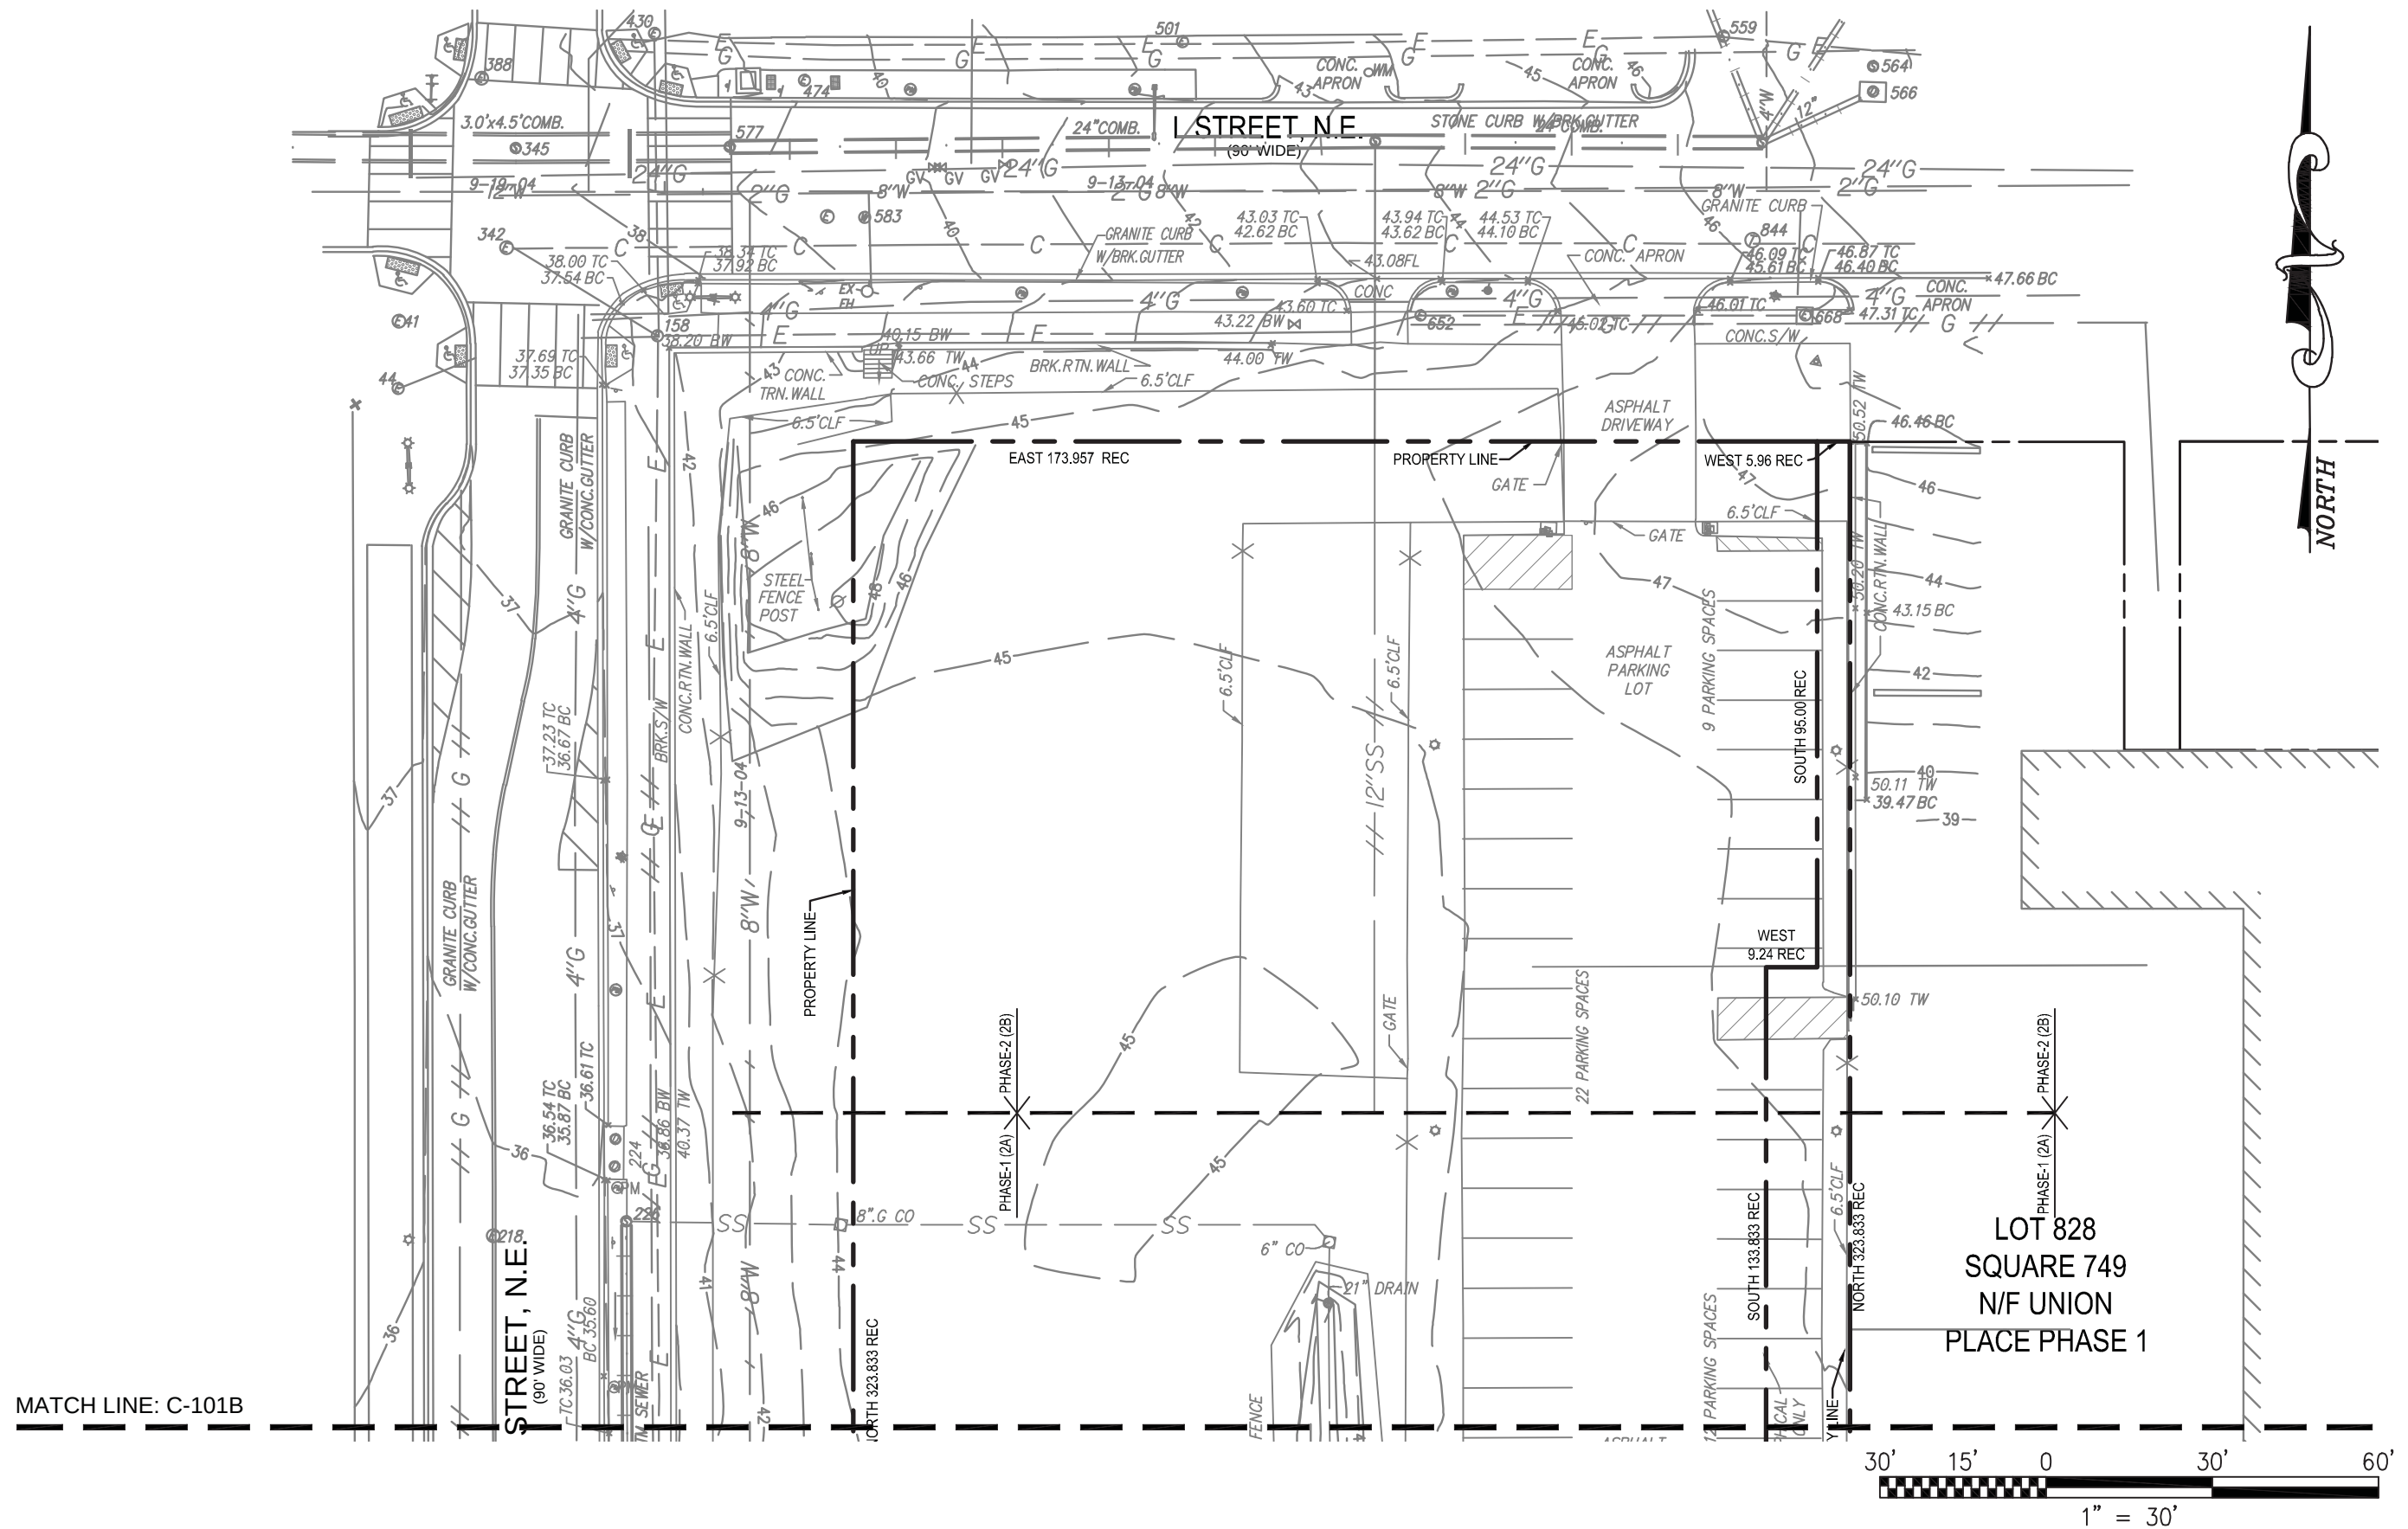

[illegible]

P:\2013\072_UnionPI2\CAD\ENG\PUD_Sheets\C-101 Existing Conditions.dwg
Xrefs: 13-072 BASE; 13-072 PHASE; 13-072 BDR-PUD



UNION PLACE – Phase 2A / 2B

07/18/2014

C-101 Existing Conditions.dwg July 15, 2014, 12:18 pm


- NOTE:**
1. THE CONTRACTOR SHALL BE RESPONSIBLE FOR DESIGN OF SHEETING AND SHORING AND SUPPORT OF EXISTING UTILITIES AND ADJACENT STRUCTURES. SHORING, BRACING, AND UNDERPINNING DESIGNED BY THE CONTRACTOR'S STRUCTURAL ENGINEER LICENSED IN THE DISTRICT OF COLUMBIA SHALL BE PROVIDED AS NECESSARY TO ENSURE THEIR SUPPORT.
 2. PROVIDE SILT FENCE AT PERIMETER OF EXCAVATION AREA TO REMAIN IN PLACE UNTIL BELOW GRADE EXCAVATION HAS BEGUN UNLESS OTHERWISE APPROVED BY THE INSPECTOR.
 3. CONTRACTOR TO PROVIDE ON SITE APPROVED STAMPED AND SIGNED SEDIMENTATION AND EROSION CONTROL DRAWINGS BY DEPARTMENT OF ENVIRONMENT, WATERSHED PROTECTION DIVISION.
 4. PROVIDE CHAIN LINK FENCE AT PERIMETER OF SITE.
 5. APPLICANT SHALL CONTACT THE DEPARTMENT OF THE ENVIRONMENT TO SCHEDULE A PRECONSTRUCTION MEETING BEFORE THE COMMENCEMENT OF A LAND-DISTURBING ACTIVITY.

CONSTRUCTION DATES:

- * THE PROPOSED DEMOLITION WORK DUE TO COMMENCE IN XXXX XXXX AND IS ANTICIPATED TO TAKE APPROXIMATELY 24 MONTHS.
- * EXACT BEGINNING AND END OF CONSTRUCTION IS TO BE ESTABLISHED BY THE OWNER.

TOTAL AREA OF DISTURBANCE:

TOTAL AREA OF DISTURBANCE: 92,450 SQUARE FEET OR 2.12 AC

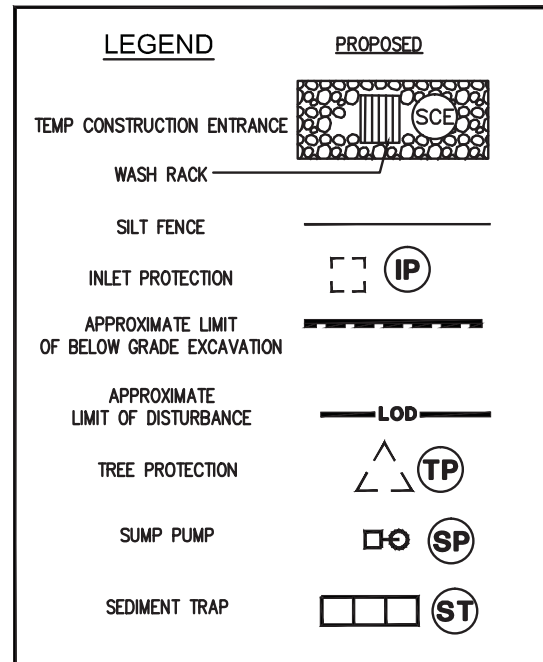

TOTAL VOLUME OF CUT /FILL FOR UTILITIES:

TOTAL AREA OF EXCAVATION: 546 SF

VOLUME OF CUT: $\frac{546 \text{ SQ. FT. (AREA)} \times 7 \text{ FEET (DEPTH)}}{27}$

VOLUME OF CUT AND FILL: 142 cy +/-


TOTAL VOLUME OF CUT OF BELOW GRADE EXCAVATION:

GARAGE PARKING LEVEL G1

TOTAL AREA OF EXCAVATION: 35,957 SF / 0.83 AC

VOLUME OF CUT: $\frac{35,957 \text{ SQ.FT. (AREA)} \times 14 \text{ FEET (DEPTH)}}{27}$

VOLUME OF CUT: 18,644 cy +/-

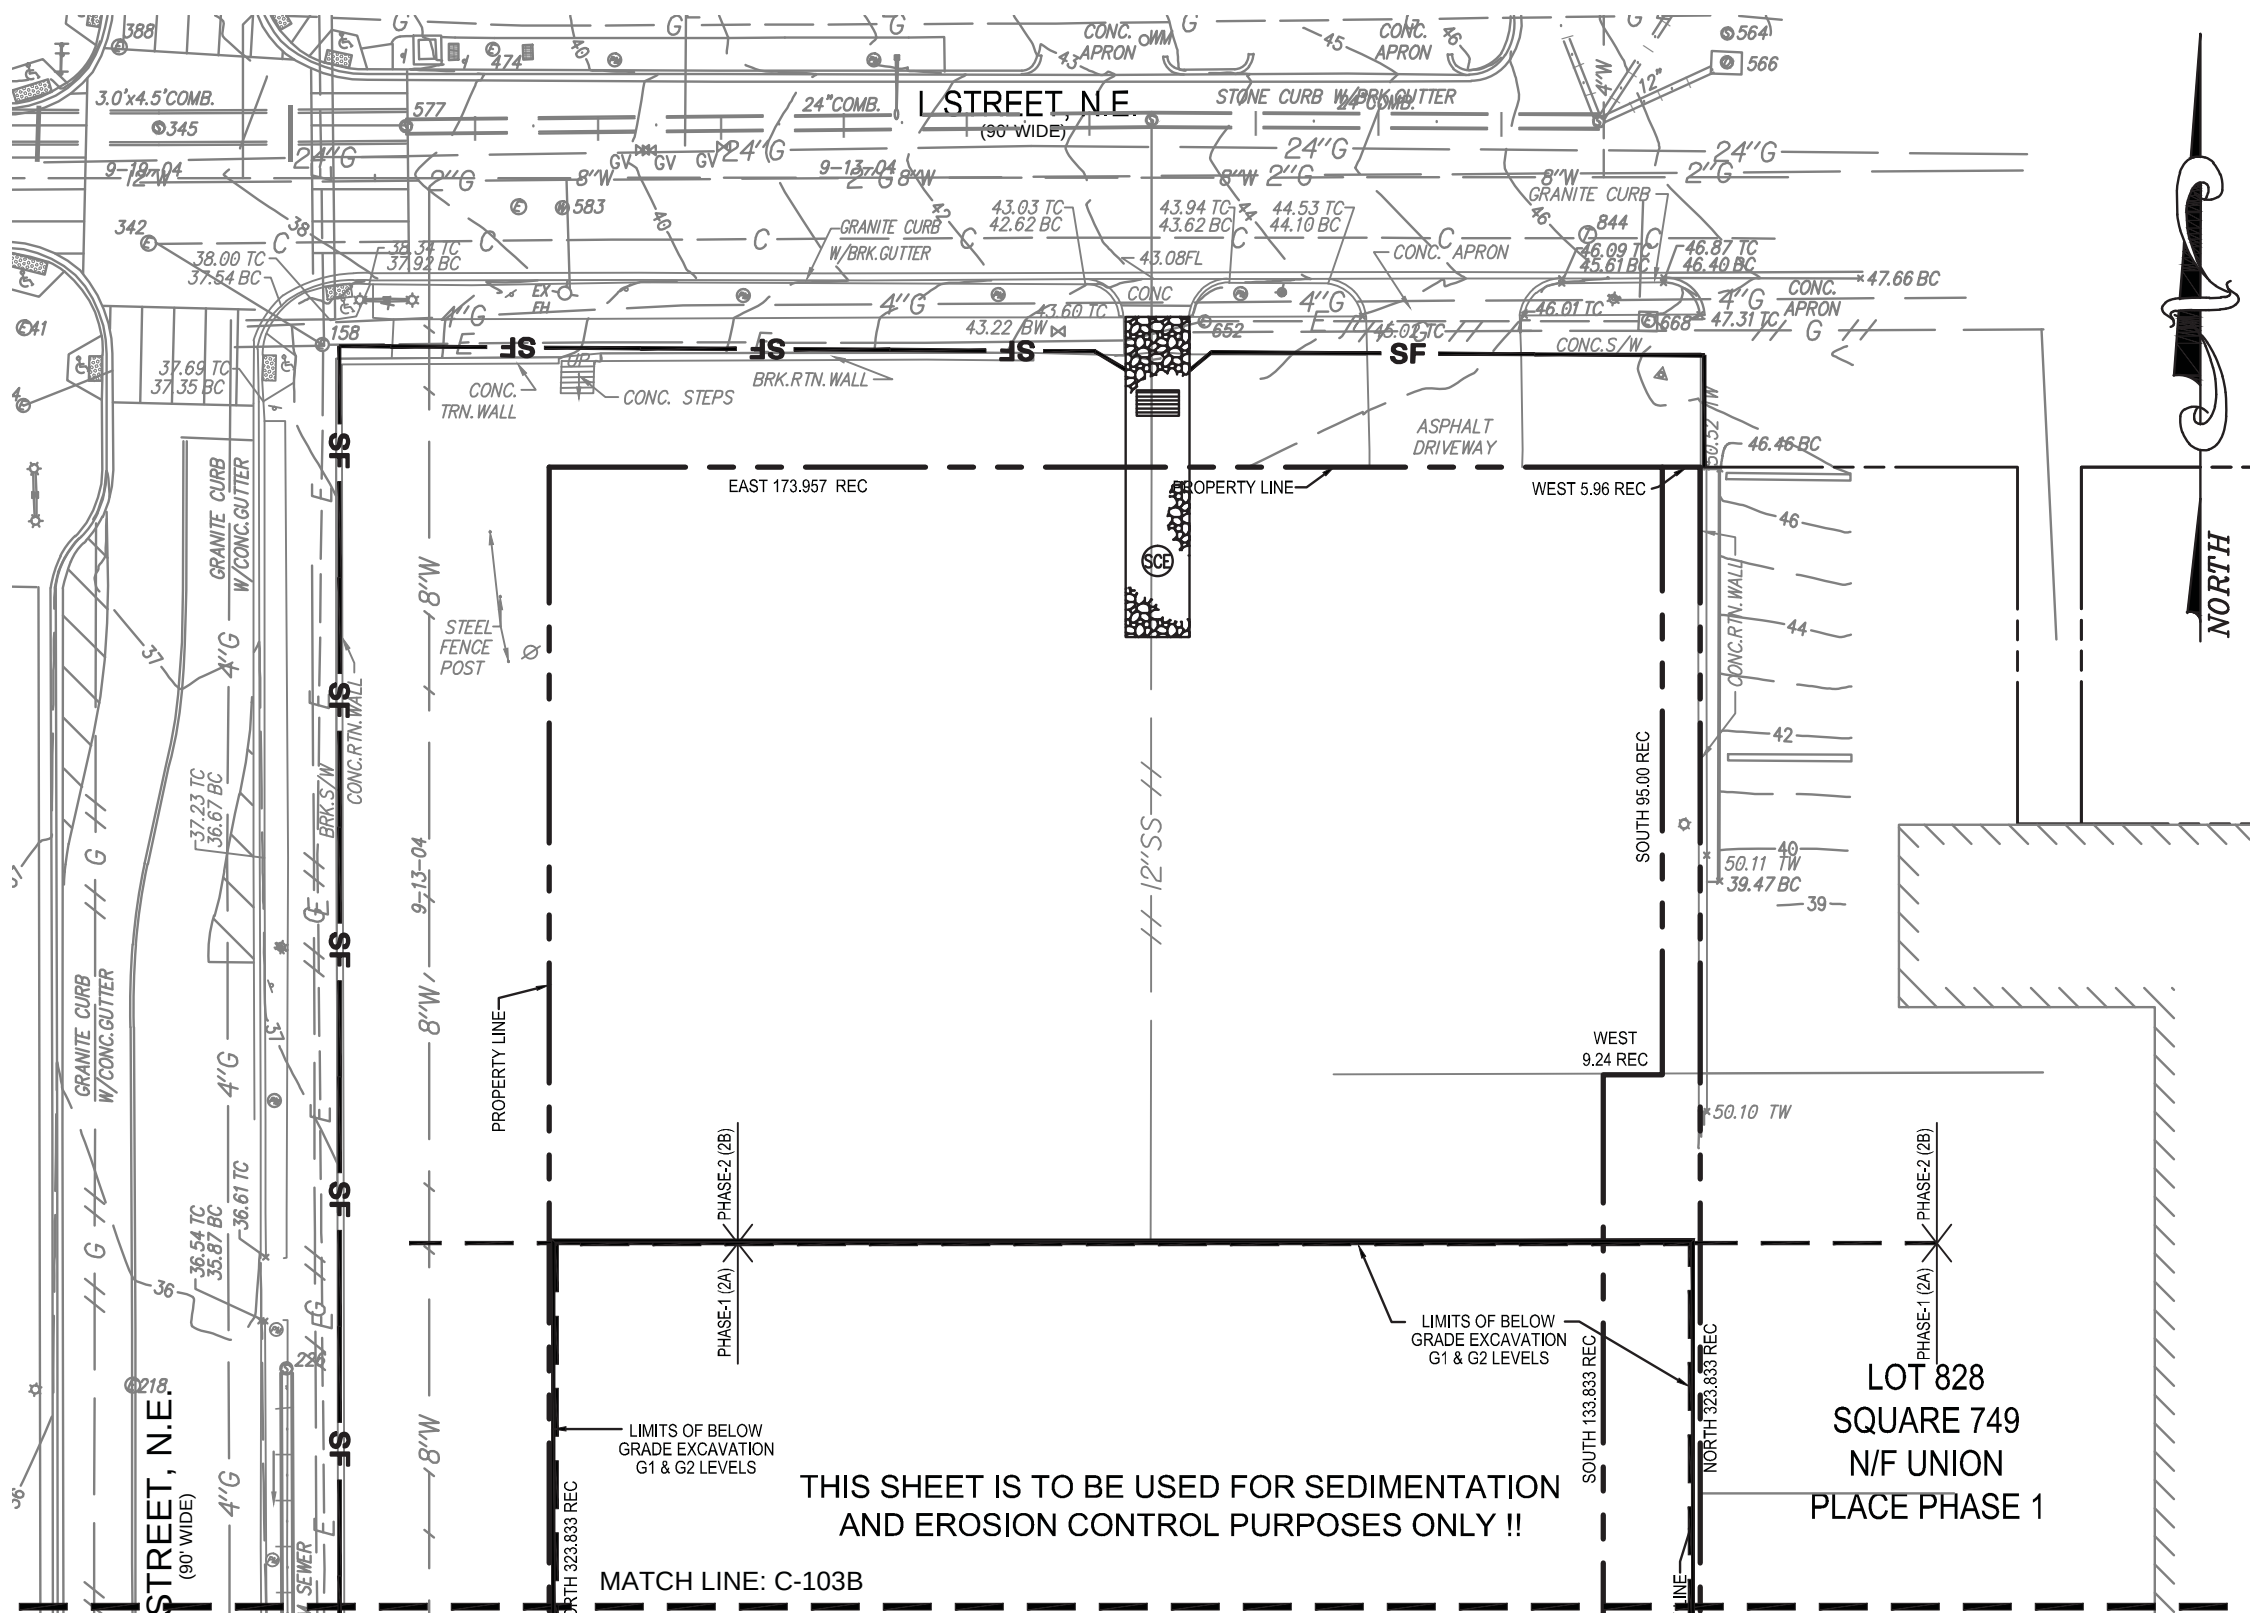

TOTAL VOLUME OF CUT OF BELOW GRADE EXCAVATION:

GARAGE PARKING LEVEL G2

TOTAL AREA OF EXCAVATION: 35,957 SF / 0.83 AC

VOLUME OF CUT: $\frac{35,957 \text{ SQ.FT. (AREA)} \times 9 \text{ FEET (DEPTH)}}{27}$

VOLUME OF CUT: 11,986 cy +/-

DUST CONTROL NOTES:

1. THE CONTRACTOR SHALL CONDUCT OPERATIONS AND MAINTAIN THE PROJECT SITE AS TO MINIMIZE THE CREATION AND DISPERSION OF DUST. DUST CONTROL SHALL BE USED THROUGHOUT THE WORK AT THE SITE.
2. THE CONTRACTOR MUST PROVIDE CLEAN WATER, FREE FROM SALT, OIL AND OTHER DELETERIOUS MATERIAL TO BE USED FOR ON-SITE DUST CONTROL.
3. THE CONTRACTOR SHALL SUPPLY WATER SPRAYING EQUIPMENT CAPABLE OF ACCESSING ALL WORK AREAS.
4. THE CONTRACTOR SHALL IMPLEMENT STRICT DUST CONTROL MEASURES DURING ACTIVE CONSTRUCTION PERIODS ON-SITE. THESE CONTROL MEASURES WILL GENERALLY CONSIST OF WATER APPLICATIONS THAT SHALL BE APPLIED A MINIMUM OF ONCE PER DAY DURING DRY WEATHER OR MORE OFTEN AS REQUIRED TO PREVENT DUST EMISSIONS.
5. FOR WATER APPLICATION TO UNDISTURBED SOIL SURFACES, THE CONTRACTOR SHALL:
 - A. APPLY WATER WITH EQUIPMENT CONSISTING OF TANK, SPRAY BAR, PUMP WITH DISCHARGE PRESSURE GAUGE;
 - B. ARRANGE SPRAY BAR HEIGHT, NOZZLE SPACING AND SPRAY PATTERN TO PROVIDE COMPLETE COVERAGE OF GROUND WITH WATER;
 - C. DISPERSE WATER THROUGH NOZZLES ON SPRAY BAR AT 20 PSI (137.8 K PA) MINIMUM. KEEP AREAS DAMP WITHOUT CREATING NUISANCE CONDITIONS SUCH AS PONDING.
6. FOR WATER APPLICATION TO SOIL SURFACES DURING DEMOLITION AND/OR EXCAVATION, THE CONTRACTOR SHALL:
 - A. APPLY WATER WITH EQUIPMENT CONSISTING OF A TANK, PUMP WITH DISCHARGE GAUGE, HOSES AND MIST NOZZLES;
 - B. LOCATE TANK AND SPRAYING EQUIPMENT SO THAT THE ENTIRE EXCAVATION AREA CAN BE MISTED WITHOUT INTERFERING WITH DEMOLITION AND/OR EXCAVATION EQUIPMENT OR OPERATIONS. KEEP AREAS DAMP WITHOUT CREATING NUISANCE CONDITIONS SUCH AS PONDING.
 - C. APPLY WATER SPRAY IN A MANNER TO PREVENT MOVEMENT OF SPRAY BEYOND SITE BOUNDARIES.

CONSTRUCTION AND STABILIZATION SEQUENCE:

1. INSTALL SEDIMENT AND EROSION CONTROL MEASURES INCLUDING STABILIZED TREE PROTECTION, AND SILT FENCE AS INDICATED ON SHEET C-103. SEE SHEET C-501
2. FOR SEDIMENTATION AND EROSION CONTROL DETAILS.
3. SEDIMENT CONTROL MEASURES SHALL BE INSPECTED AND APPROVED BY THE INSPECTOR PRIOR TO COMMENCING ANY OTHER LAND DISTURBING ACTIVITIES.
4. REMOVE ITEMS AS INDICATED ON DEMOLITION PLAN.
5. INSTALL SITE IMPROVEMENTS AS INDICATED ON CONSTRUCTION DOCUMENTS FOR THE PROPOSED BUILDING.
6. AT THE COMPLETION OF CONSTRUCTION AND AFTER THE INSPECTOR'S APPROVAL, ALL TEMPORARY SEDIMENTATION AND EROSION CONTROL MEASURES SHALL BE REMOVED.

SEDIMENTATION EROSION CONTROL NOTE:


THE APPLICANT MUST NOTIFY THE DEPARTMENT OF HEALTH BY PHONE (202-535-2250) AT LEAST 24 HOURS PRIOR TO THE START OF GRADING ACTIVITY AND WITHIN (2) WEEKS AFTER COMPLETION OF PROJECT TO REQUEST INSPECTION. IF THERE IS NEED TO MAKE CHANGES OR MODIFICATIONS IN THE APPROVED DESIGN, DEPARTMENT OF HEALTH MUST BE NOTIFIED IMMEDIATELY. SCHEDULE AND HOLD PRE-CONSTRUCTION MEETING WITH THE SEDIMENT CONTROL INSPECTOR 48 HOURS PRIOR TO ANY LAND DISTURBING ACTIVITY. CALL 202-535-2977 FOR APPOINTMENT.

THE CONTRACTOR SHALL CALL THE INSPECTION/ENFORCEMENT BRANCH, WATERSHED PROTECTION DIVISION, DISTRICT DEPARTMENT OF THE ENVIRONMENT AT (202) 535-2240 FOR A PRE-CONSTRUCTION MEETING 72 HOURS PRIOR TO THE START OF ANY LAND DISTURBING ACTIVITY.


REMOVAL OF ANY SEDIMENT EROSION CONTROL MEASURES REQUIRES APPROVAL FROM DDOE INSPECTOR.

LAND DISTURBANCE ACTIVITY NOTE:

A PERSON RESPONSIBLE FOR LAND DISTURBANCE IS TO BE PRESENT OR AVAILABLE AT ALL TIMES WHILE SITE IS IN A PHASE INVOLVING LAND DISTURBING ACTIVITY. THE RESPONSIBLE PERSON IS RESPONSIBLE FOR INSPECTION OF THE SITE E&S CONTROL MEASURES BIWEEKLY AND AFTER RAINFALL EVENTS, AVAILABILITY TO RESPOND TO POTENTIAL EROSION PROBLEMS AS THEY OCCUR AND AVAILABILITY TO SPEAK ON SITE WITH DDOE TO REMEDY POTENTIAL PROBLEMS. THE RESPONSIBLE PERSON IS TO HAVE AVAILABLE ON SITE PROOF OF PROFESSIONAL LICENSING OR OF SUCCESSFUL COMPLETION OF A DEPARTMENT APPROVED TRAINING PROGRAM IN COMPLIANCE OF RESPONSIBLE PERSON DESIGNATION.

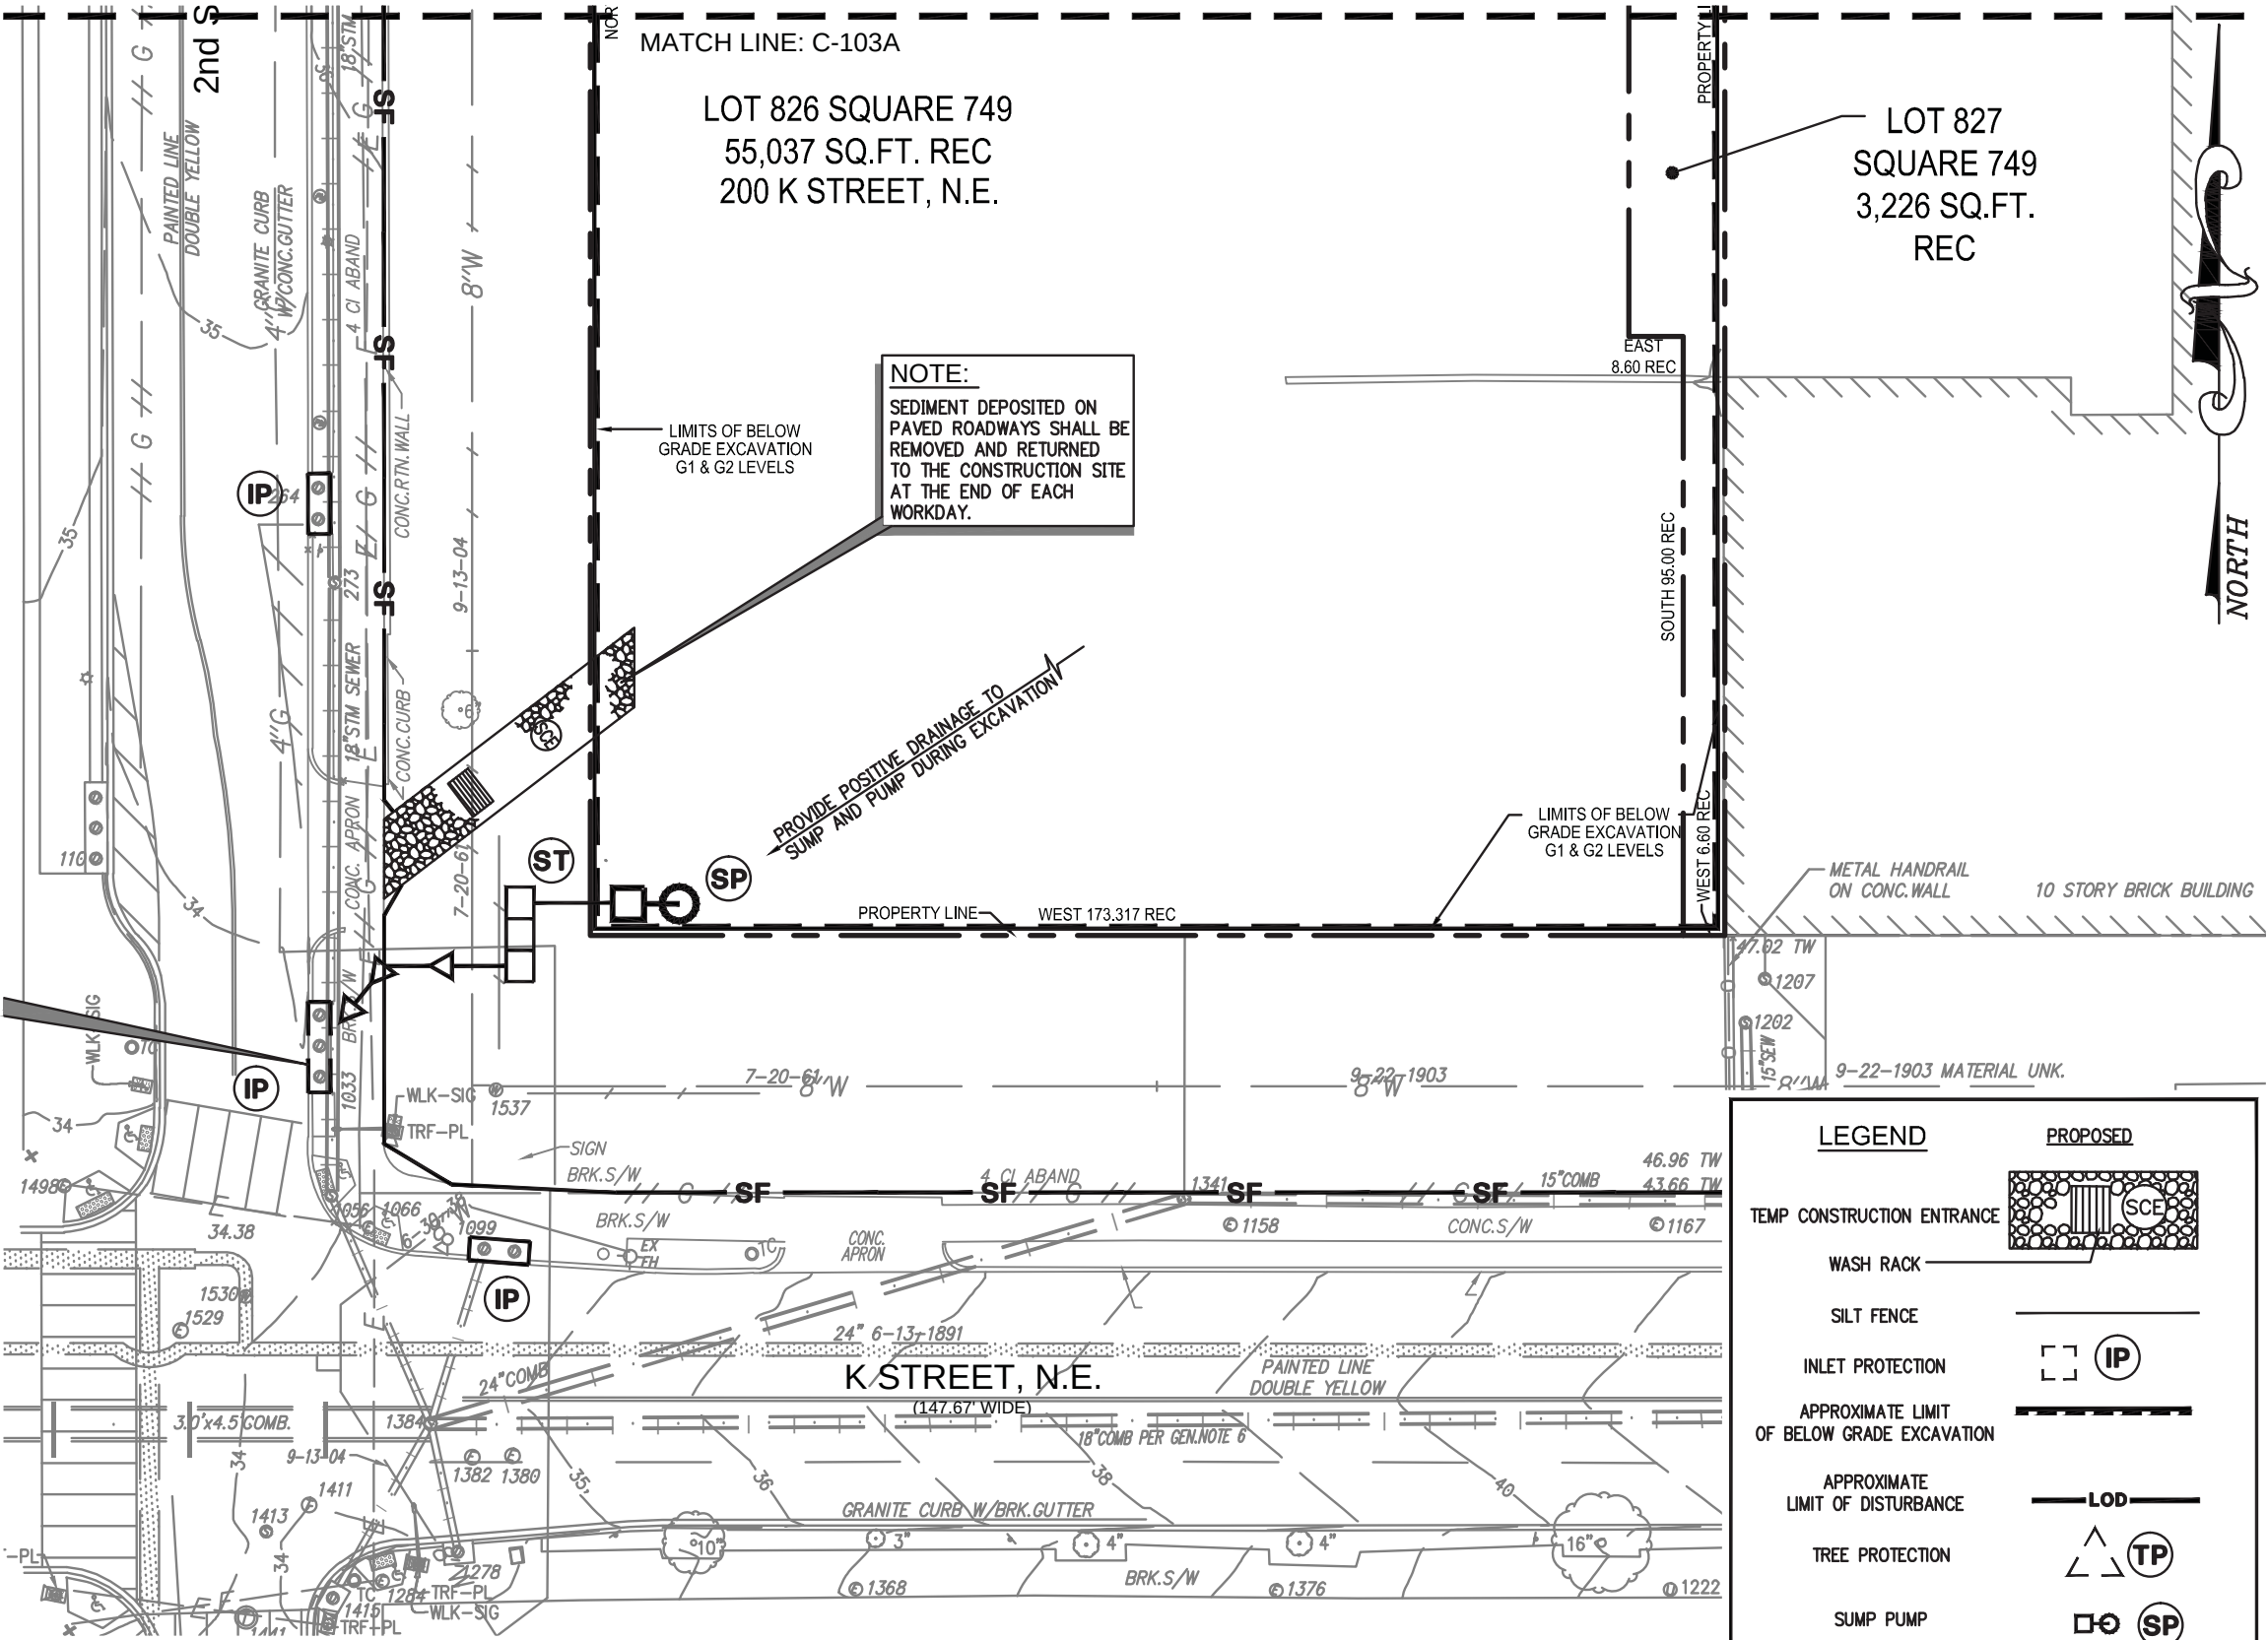

THIS SHEET IS TO BE USED FOR SEDIMENTATION AND EROSION CONTROL PURPOSES ONLY !!

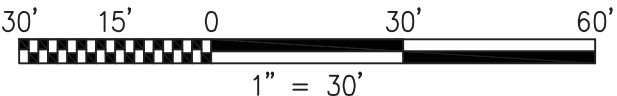


C-103B

07/18/2014

313236.00

P:\2013\072_UnionPI2\CAD\ENG\PUD\Sheets\C-103 Erosion Control Plan-PH2B.dwg
Xrefs: 13-072 BASE; 13-072 PHASE; 13-072 BDR-PUD; 13-072 ESC; 13-072 PH 2B; 13-072 ARCH; 13-072 SITE; 13-072 UTIL; 13-072 LANDSCAPE

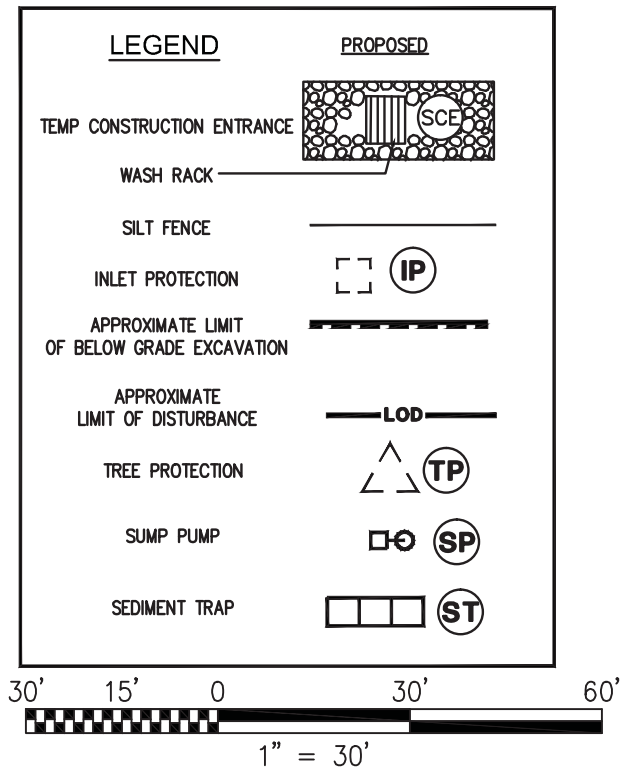

CONTRACTOR TO COORDINATE WITH MS. ELAINE WILSON OF DC/WATER IN REGARDS TO DC/WATER TEMPORARY DISCHARGE PERMIT AT 202-787-4177.

NOTE:


1. THE CONTRACTOR SHALL BE RESPONSIBLE FOR DESIGN OF SHEETING AND SHORING AND SUPPORT OF EXISTING UTILITIES AND ADJACENT STRUCTURES. SHORING, BRACING, AND UNDERPINNING DESIGNED BY THE CONTRACTOR'S STRUCTURAL ENGINEER LICENSED IN THE DISTRICT OF COLUMBIA SHALL BE PROVIDED AS NECESSARY TO ENSURE THEIR SUPPORT.
2. PROVIDE SILT FENCE AT PERIMETER OF EXCAVATION AREA TO REMAIN IN PLACE UNTIL BELOW GRADE EXCAVATION HAS BEGUN UNLESS OTHERWISE APPROVED BY THE INSPECTOR.
3. CONTRACTOR TO PROVIDE ON SITE APPROVED STAMPED AND SIGNED SEDIMENTATION AND EROSION CONTROL DRAWINGS BY DEPARTMENT OF ENVIRONMENT, WATERSHED PROTECTION DIVISION.
4. PROVIDE CHAIN LINK FENCE AT PERIMETER OF SITE.

CONSTRUCTION DATES:

- * THE PROPOSED DEMOLITION WORK DUE TO COMMENCE IN THE SUMMER OF 2014 AND IS ANTICIPATED TO TAKE APPROXIMATELY 24 MONTHS.
- * EXACT BEGINNING AND END OF CONSTRUCTION IS TO BE ESTABLISHED BY THE OWNER.

TOTAL AREA OF DISTURBANCE:

TOTAL AREA OF DISTURBANCE: 19,405 SQUARE FEET OR 0.45 AC

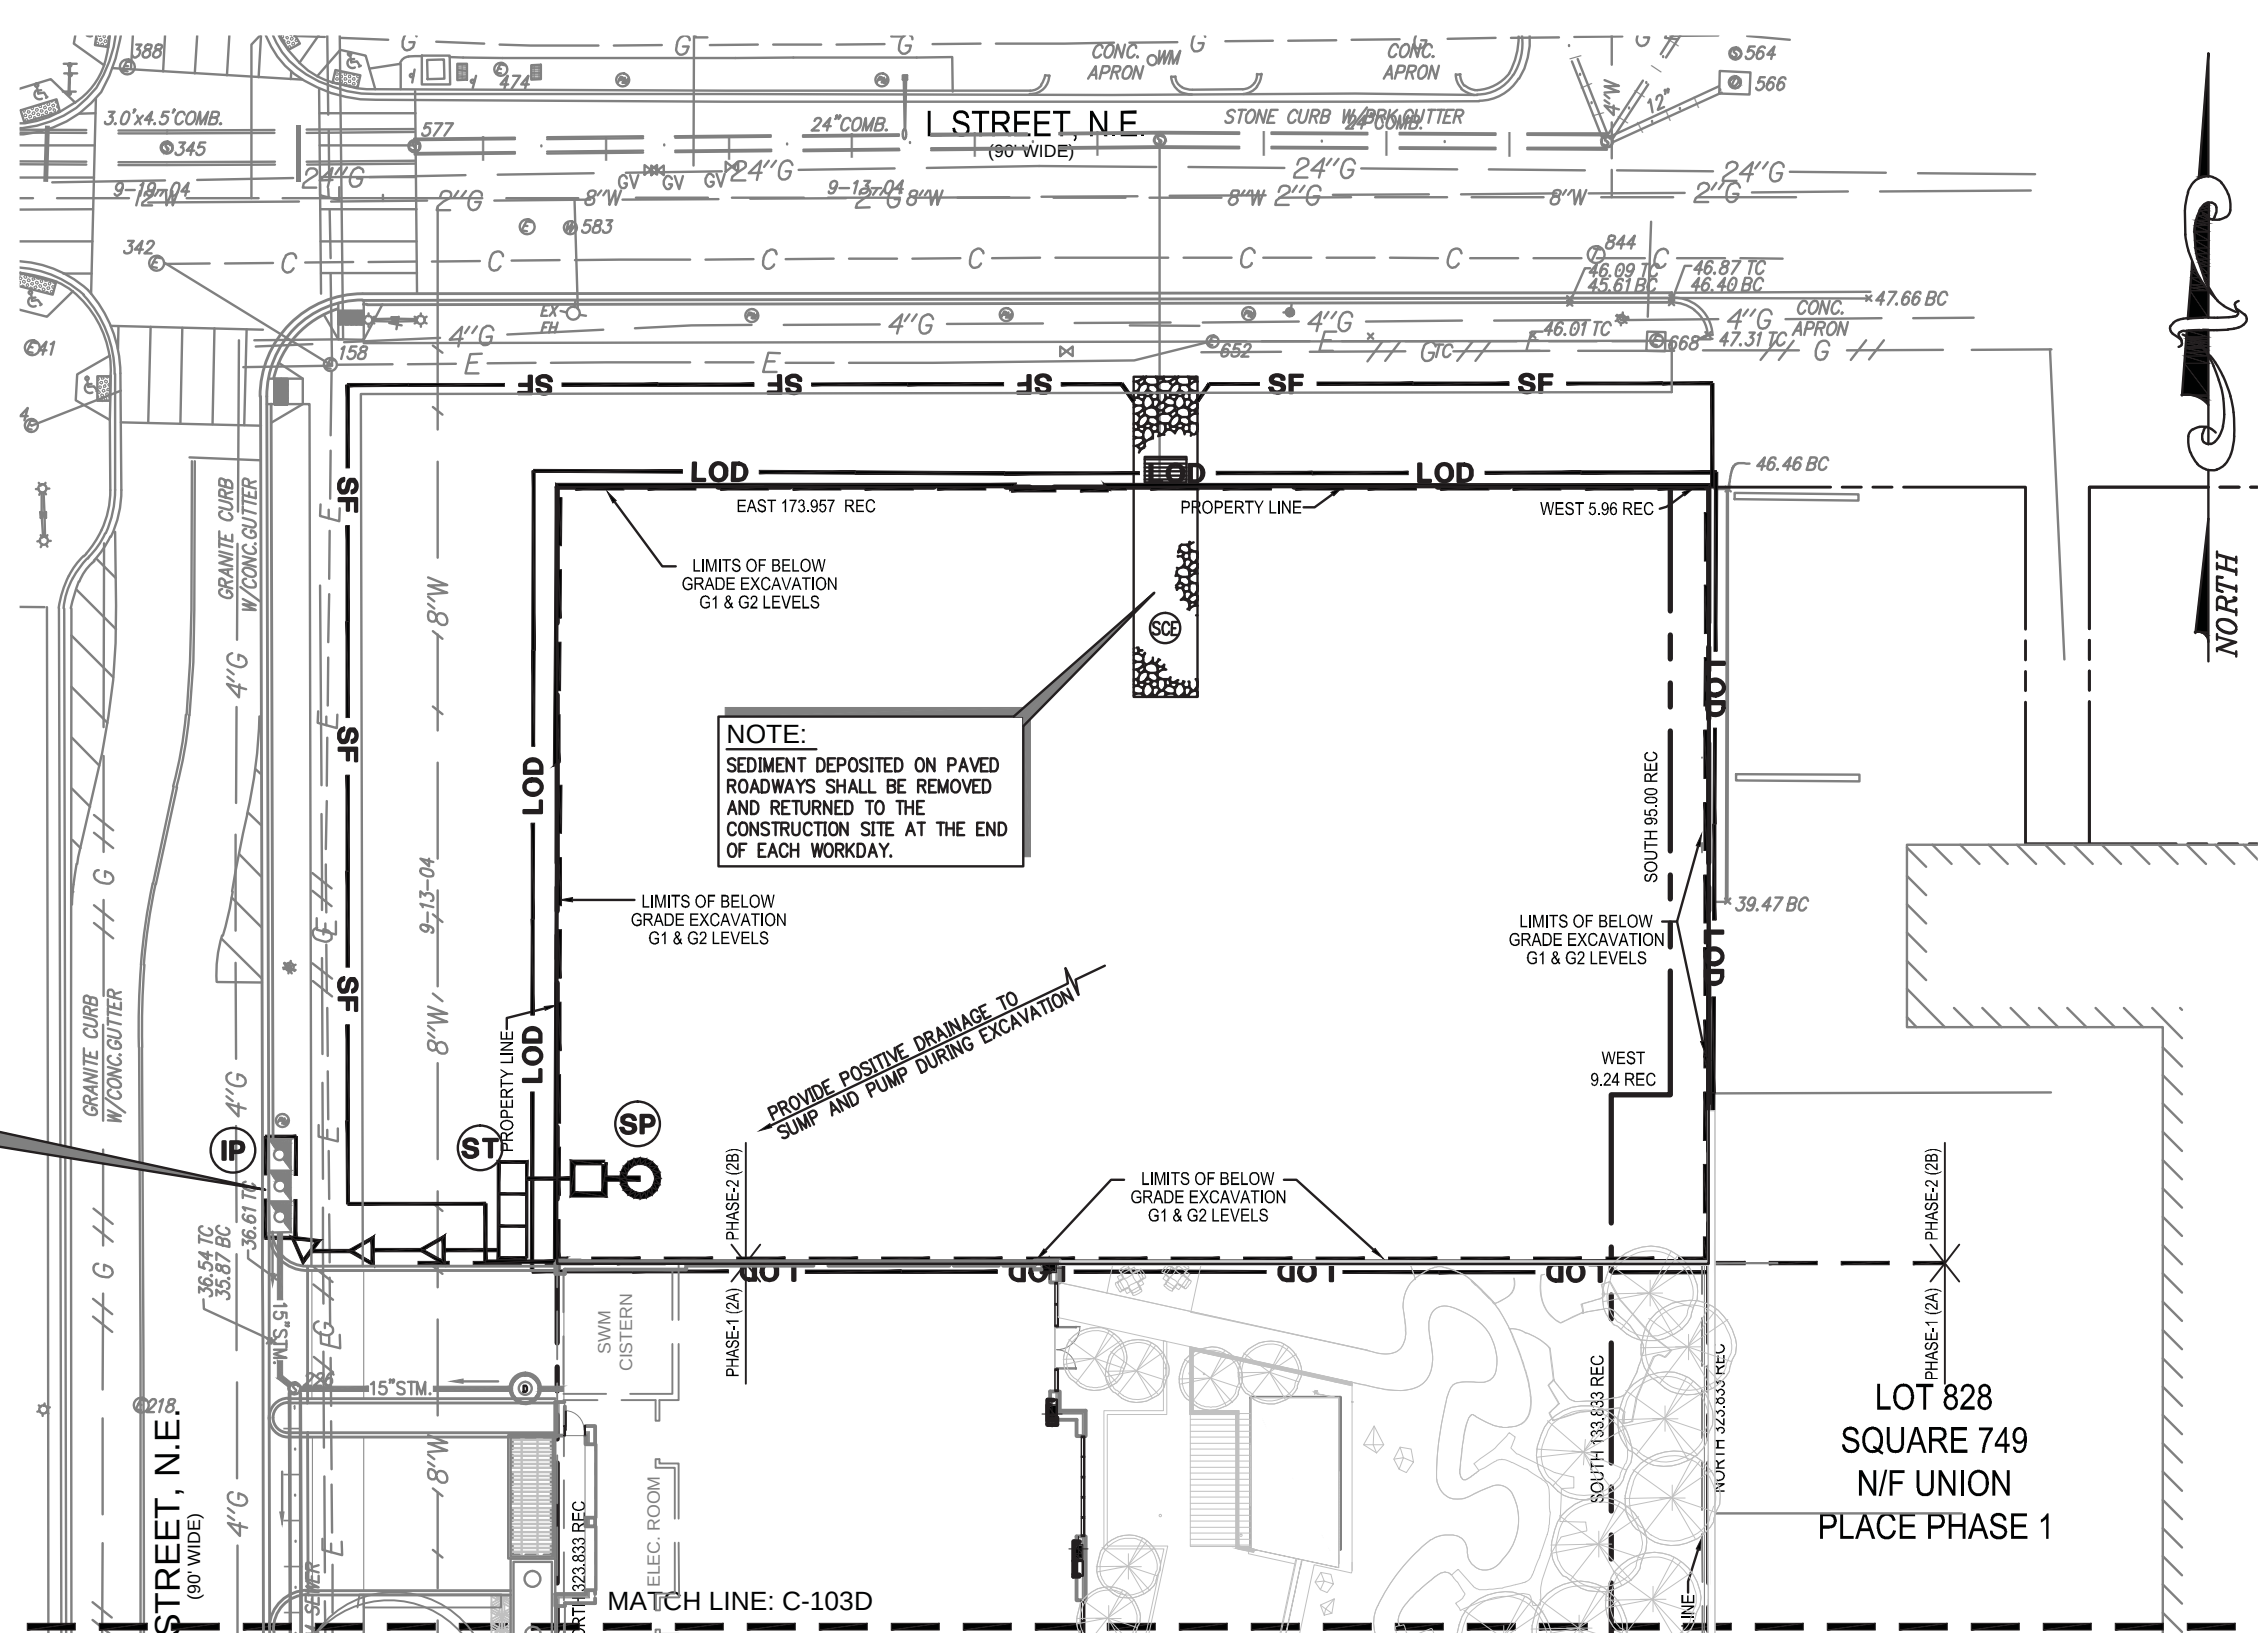

THIS SHEET IS TO BE USED FOR SEDIMENTATION AND EROSION CONTROL PURPOSES ONLY !!

P:\2013\072_UnionPI2\CAD\ENG\PU2_Sheets\C-103 Erosion Control Plan-PH2B.dwg
Xrefs: 13-072 BASE; 13-072 PHASE; 13-072 BDR-PUD; 13-072 ESC PH 2B; 13-072 ARCH; 13-072 SITE; 13-072 UTIL; 13-072 LANDSCAPE

DUST CONTROL NOTES:

1. THE CONTRACTOR SHALL CONDUCT OPERATIONS AND MAINTAIN THE PROJECT SITE AS TO MINIMIZE THE CREATION AND DISPERSION OF DUST. DUST CONTROL SHALL BE USED THROUGHOUT THE WORK AT THE SITE.
2. THE CONTRACTOR MUST PROVIDE CLEAN WATER, FREE FROM SALT, OIL AND OTHER DELETERIOUS MATERIAL TO BE USED FOR ON-SITE DUST CONTROL.
3. THE CONTRACTOR SHALL SUPPLY WATER SPRAYING EQUIPMENT CAPABLE OF ACCESSING ALL WORK AREAS.
4. THE CONTRACTOR SHALL IMPLEMENT STRICT DUST CONTROL MEASURES DURING ACTIVE CONSTRUCTION PERIODS ON-SITE. THESE CONTROL MEASURES WILL GENERALLY CONSIST OF WATER APPLICATIONS THAT SHALL BE APPLIED A MINIMUM OF ONCE PER DAY DURING DRY WEATHER OR MORE OFTEN AS REQUIRED TO PREVENT DUST EMISSIONS.
5. FOR WATER APPLICATION TO UNDISTURBED SOIL SURFACES, THE CONTRACTOR SHALL:
 - A. APPLY WATER WITH EQUIPMENT CONSISTING OF TANK, SPRAY BAR, PUMP WITH DISCHARGE PRESSURE GAUGE;
 - B. ARRANGE SPRAY BAR HEIGHT, NOZZLE SPACING AND SPRAY PATTERN TO PROVIDE COMPLETE COVERAGE OF GROUND WITH WATER;
 - C. DISPERSE WATER THROUGH NOZZLES ON SPRAY BAR AT 20 PSI (137.8 K PA) MINIMUM. KEEP AREAS DAMP WITHOUT CREATING NUISANCE CONDITIONS SUCH AS PONDING.
6. FOR WATER APPLICATION TO SOIL SURFACES DURING DEMOLITION AND/OR EXCAVATION, THE CONTRACTOR SHALL:
 - A. APPLY WATER WITH EQUIPMENT CONSISTING OF A TANK, PUMP WITH DISCHARGE GAUGE, HOSES AND MIST NOZZLES;
 - B. LOCATE TANK AND SPRAYING EQUIPMENT SO THAT THE ENTIRE EXCAVATION AREA CAN BE MISTED WITHOUT INTERFERING WITH DEMOLITION AND/OR EXCAVATION EQUIPMENT OR OPERATIONS. KEEP AREAS DAMP WITHOUT CREATING NUISANCE CONDITIONS SUCH AS PONDING.
 - C. APPLY WATER SPRAY IN A MANNER TO PREVENT MOVEMENT OF SPRAY BEYOND SITE BOUNDARIES.

CONSTRUCTION AND STABILIZATION SEQUENCE:

1. INSTALL SEDIMENT AND EROSION CONTROL MEASURES INCLUDING STABILIZED TREE PROTECTION, AND SILT FENCE AS INDICATED ON SHEET C-103. SEE SHEET C-501
2. FOR SEDIMENTATION AND EROSION CONTROL DETAILS.
3. SEDIMENT CONTROL MEASURES SHALL BE INSPECTED AND APPROVED BY THE INSPECTOR PRIOR TO COMMENCING ANY OTHER LAND DISTURBING ACTIVITIES.
4. REMOVE ITEMS AS INDICATED ON DEMOLITION PLAN.
5. INSTALL SITE IMPROVEMENTS AS INDICATED ON CONSTRUCTION DOCUMENTS FOR THE PROPOSED BUILDING.
6. AT THE COMPLETION OF CONSTRUCTION AND AFTER THE INSPECTOR'S APPROVAL, ALL TEMPORARY SEDIMENTATION AND EROSION CONTROL MEASURES SHALL BE REMOVED.

SEDIMENTATION EROSION CONTROL NOTE:


THE APPLICANT MUST NOTIFY THE DEPARTMENT OF HEALTH BY PHONE (202-535-2250) AT LEAST 24 HOURS PRIOR TO THE START OF GRADING ACTIVITY AND WITHIN (2) WEEKS AFTER COMPLETION OF PROJECT TO REQUEST INSPECTION. IF THERE IS NEED TO MAKE CHANGES OR MODIFICATIONS IN THE APPROVED DESIGN, DEPARTMENT OF HEALTH MUST BE NOTIFIED IMMEDIATELY. SCHEDULE AND HOLD PRE-CONSTRUCTION MEETING WITH THE SEDIMENT CONTROL INSPECTOR 48 HOURS PRIOR TO ANY LAND DISTURBING ACTIVITY. CALL 202-535-2977 FOR APPOINTMENT.

THE CONTRACTOR SHALL CALL THE INSPECTION/ENFORCEMENT BRANCH, WATERSHED PROTECTION DIVISION, DISTRICT DEPARTMENT OF THE ENVIRONMENT AT (202) 535-2240 FOR A PRE-CONSTRUCTION MEETING 72 HOURS PRIOR TO THE START OF ANY LAND DISTURBING ACTIVITY.

REMOVAL OF ANY SEDIMENT EROSION CONTROL MEASURES REQUIRES APPROVAL FROM DDOE INSPECTOR.


LAND DISTURBANCE ACTIVITY NOTE:

A PERSON RESPONSIBLE FOR LAND DISTURBANCE IS TO BE PRESENT OR AVAILABLE AT ALL TIMES WHILE SITE IS IN A PHASE INVOLVING LAND DISTURBING ACTIVITY. THE RESPONSIBLE PERSON IS RESPONSIBLE FOR INSPECTION OF THE SITE E&S CONTROL MEASURES BIWEEKLY AND AFTER RAINFALL EVENTS, AVAILABILITY TO RESPOND TO POTENTIAL EROSION PROBLEMS AS THEY OCCUR AND AVAILABILITY TO SPEAK ON SITE WITH DDOE TO REMEDY POTENTIAL PROBLEMS. THE RESPONSIBLE PERSON IS TO HAVE AVAILABLE ON SITE PROOF OF PROFESSIONAL LICENSING OR OF SUCCESSFUL COMPLETION OF A DEPARTMENT APPROVED TRAINING PROGRAM IN COMPLIANCE OF RESPONSIBLE PERSON DESIGNATION.

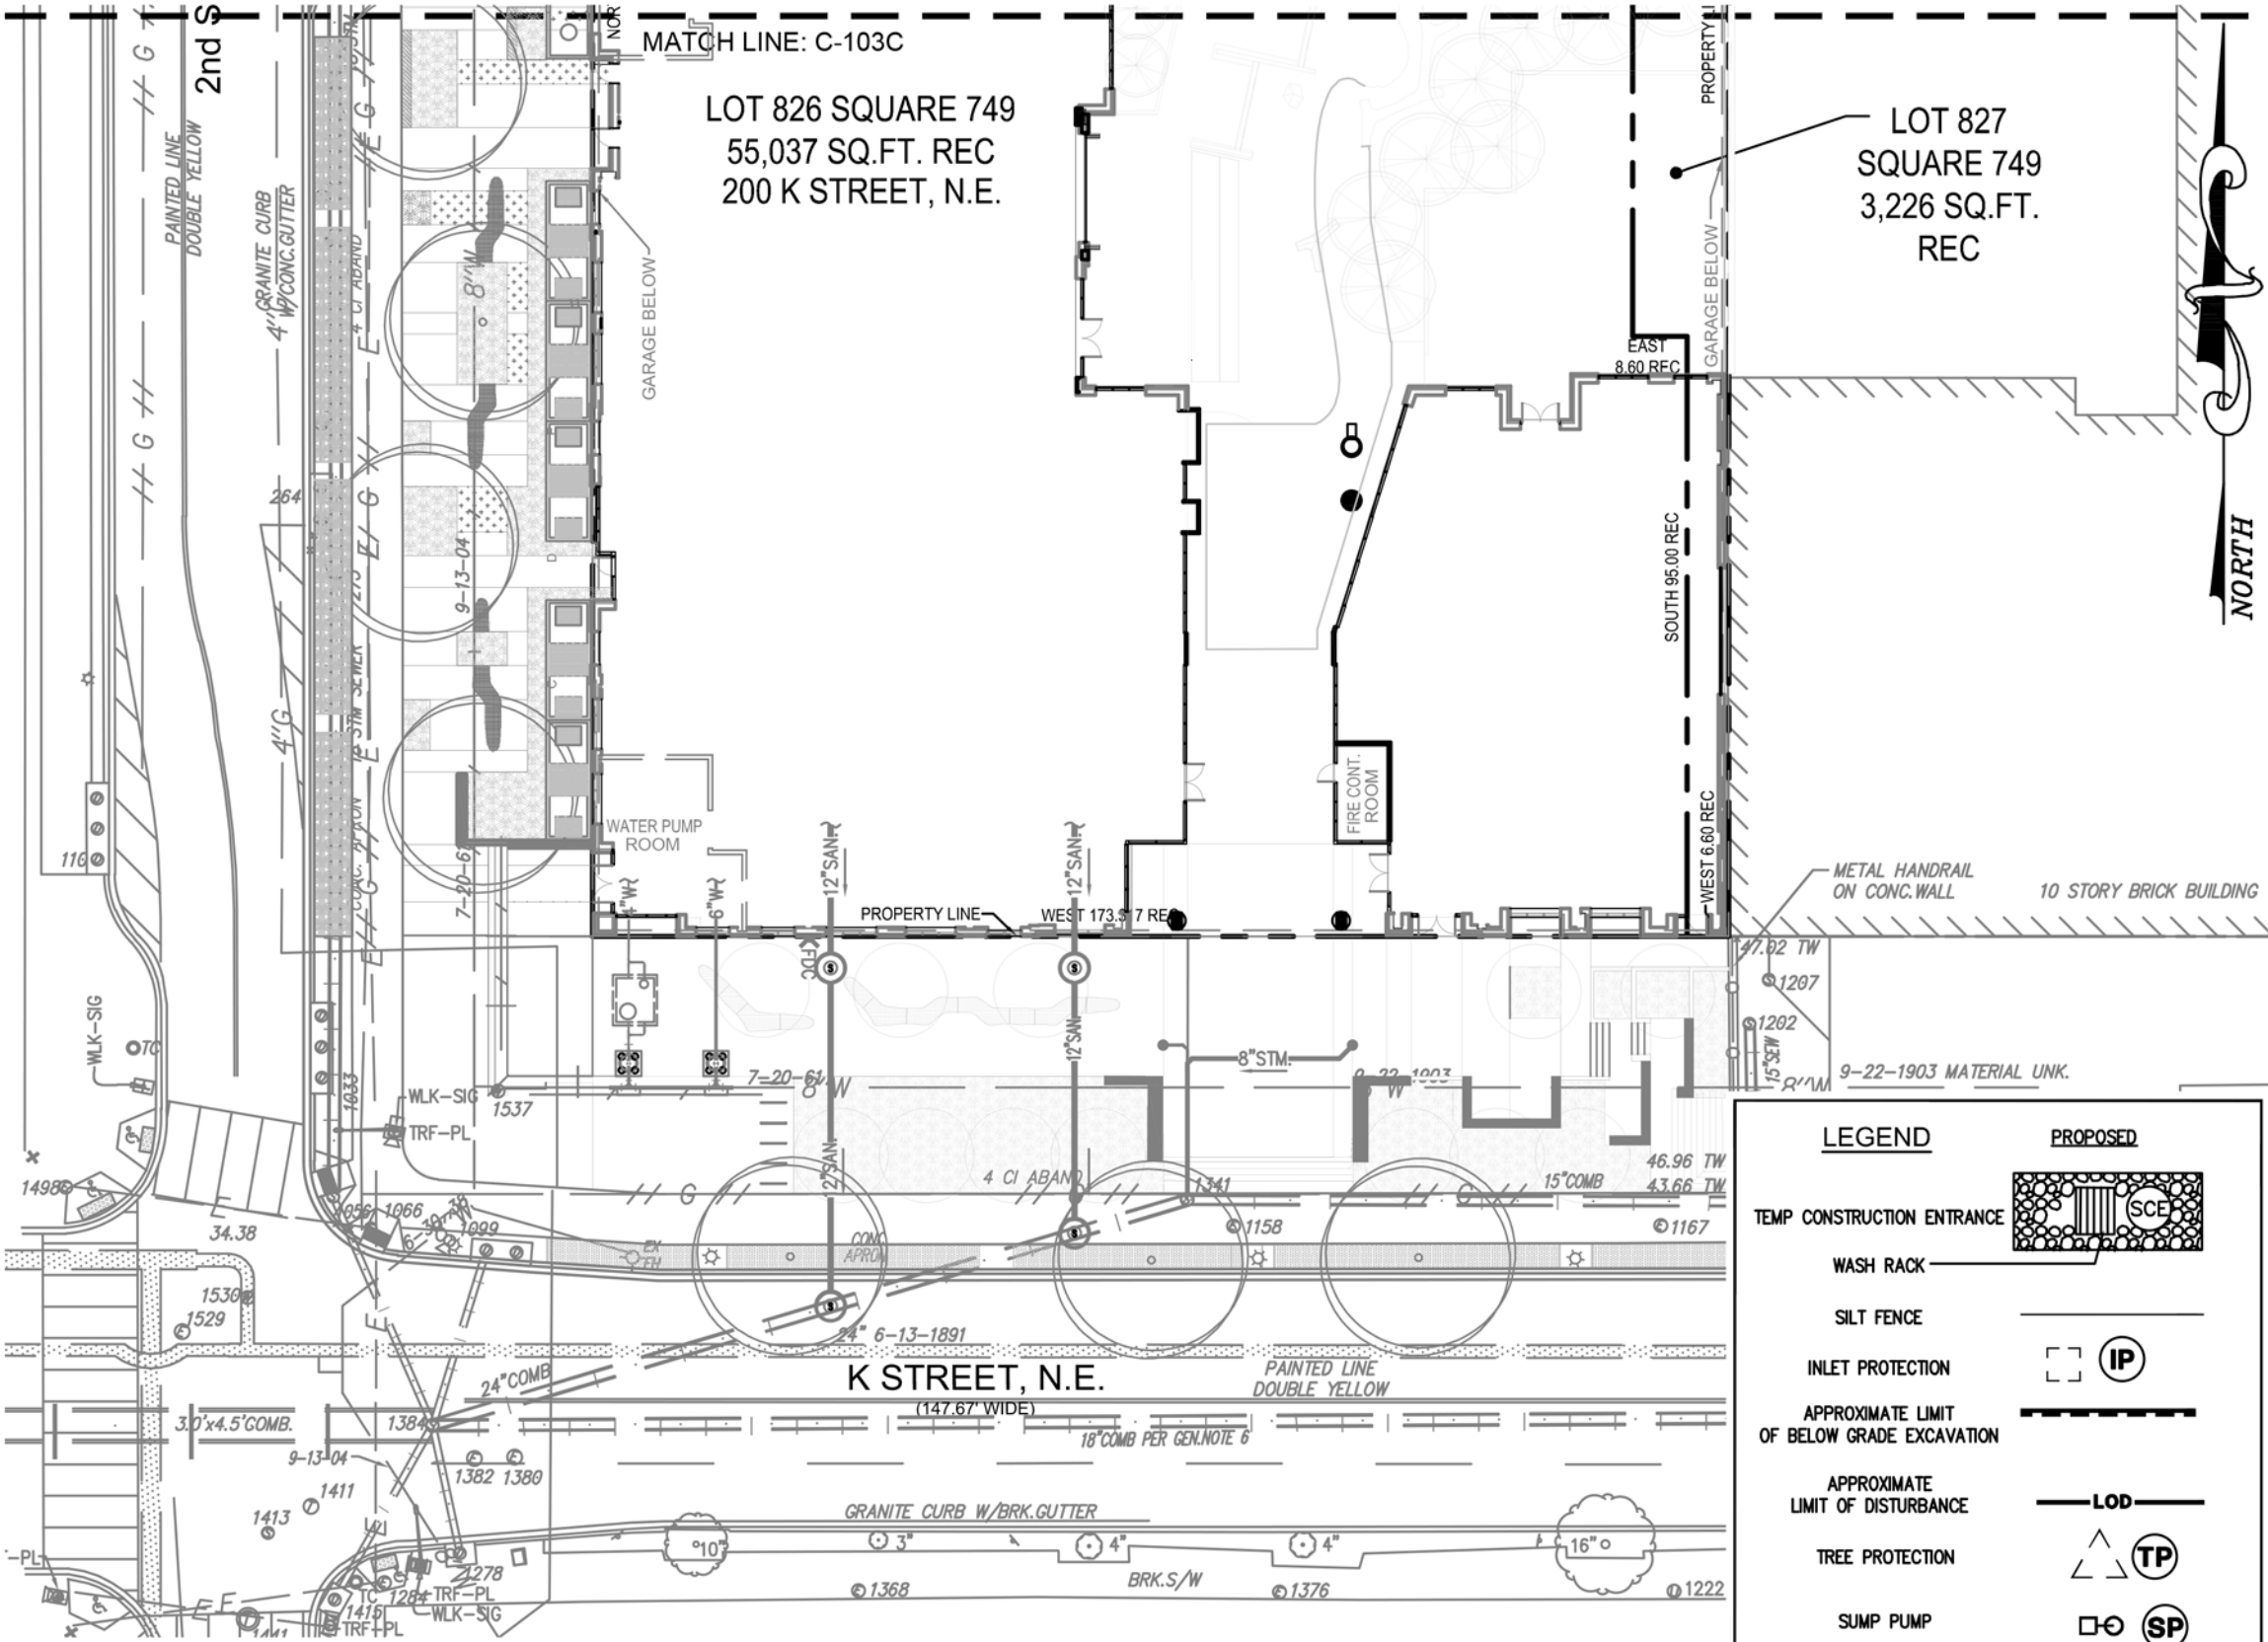

THIS SHEET IS TO BE USED FOR SEDIMENTATION AND EROSION CONTROL PURPOSES ONLY !!

LEGEND	
PROPOSED	
TEMP CONSTRUCTION ENTRANCE	
WASH RACK	
SILT FENCE	
INLET PROTECTION	
APPROXIMATE LIMIT OF BELOW GRADE EXCAVATION	
APPROXIMATE LIMIT OF DISTURBANCE	
TREE PROTECTION	
SUMP PUMP	
SEDIMENT TRAP	

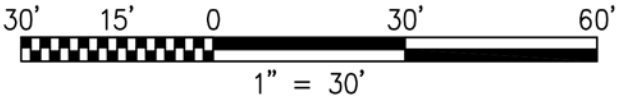

P:\2013\072_UnionPl2\CAD\ENG\PU\Sheets\C-104 Site Plan.dwg
Xrefs: 13-072 BASE; 13-072 PHASE; 13-072 BDR-PUD; 13-072 SITE; 13-072 ARCH; 13-072 LANDSCAPE; 13-072 UTIL

SITE KEYNOTES:

- 1 NEW BUILDING. REFER TO ARCHITECTURAL DRAWING FOR DETAILS.
- 2 NEW ASPHALT SURFACE COURSE FRONTING CONSTRUCTION PER DC/DDOT STANDARDS AND SPECIFICATIONS. SEE SHEET C-582 FOR DETAILS.
- 3 LIMIT OF NEW ASPHALT PAVEMENT.
- 4 NEW GRANITE CURB WITH BRICK GUTTER PER DC/DDOT STANDARDS AND SPECIFICATIONS. SEE SHEET C-582 FOR DETAILS.
- 5 LIMIT OF NEW GRANITE CURB AND BRICK GUTTER TO MATCH IN LINE ON GRADE.
- 6 NEW HANDICAP RAMP PER DC/DDOT STANDARDS AND SPECIFICATIONS. REFER TO SHEET C-583 FOR DETAILS.
- 7 NEW CONCRETE APRON PER DC/DDOT STANDARDS AND SPECIFICATIONS. SEE SHEET C-582 FOR DETAILS.
- 8 NEW STREET TREE. REFER TO LANDSCAPE DRAWINGS FOR DETAILS.
- 9 NEW COURTYARD. REFER TO LANDSCAPE DRAWING FOR DETAILS.
- 10 NEW COURTYARD ENTRYWAY. REFER TO ARCH DRAWINGS FOR DETAILS.
- 11 NEW 6' RADIUS CURB RETURN PER DC DDOT STANDARDS AND SPECIFICATIONS. SEE SHEET C-582 FOR DETAILS.
- 12 NEW 3' RADIUS CURB RETURN PER DC DDOT STANDARDS AND SPECIFICATIONS. SEE SHEET C-582 FOR DETAILS.
- 13 NEW FUTURE BUILDING. TO BE BUILT AND PERMITTED UNDER SEPARATED CONTRACT.
- 14 NEW RETAINING WALL. REFER TO STRUCTURAL AND LANDSCAPE PLANS FOR DETAILS.
- 15 NEW EXPOSED AGGREGATE SIDEWALK PER DC/DDOT NMA STANDARDS AND SPECIFICATIONS. SEE SHEET C-582 FOR DETAILS.
- 16 NEW RAIN GARDEN AREA. SEE SHEET C-703 FOR DETAILS.
- 17 NEW GRASSED AREA.
- 18 REFER TO LANDSCAPE AND STRUCTURAL DRAWINGS FOR TREATMENT OF RETAINING WALL AND EXISTING FENCE.

SITE LEGEND:


- NEW ASPHALT PAVEMENT
(FULL DEPTH)
- NEW ASPHALT PAVEMENT
(SURFACE COURSE)

SITE KEY-NOTE

NOTE:

1. REFER TO LANDSCAPE DRAWING FOR LAYOUT AND SPECIES OF TREES.
2. REFER TO LANDSCAPE DRAWING FOR LAYOUT OF COURTYARD.
3. ALL EXISTING MANHOLE TOP TO BE ADJUSTED TO MATCH PROPOSED GRADES.

MATCH LINE: C-104B

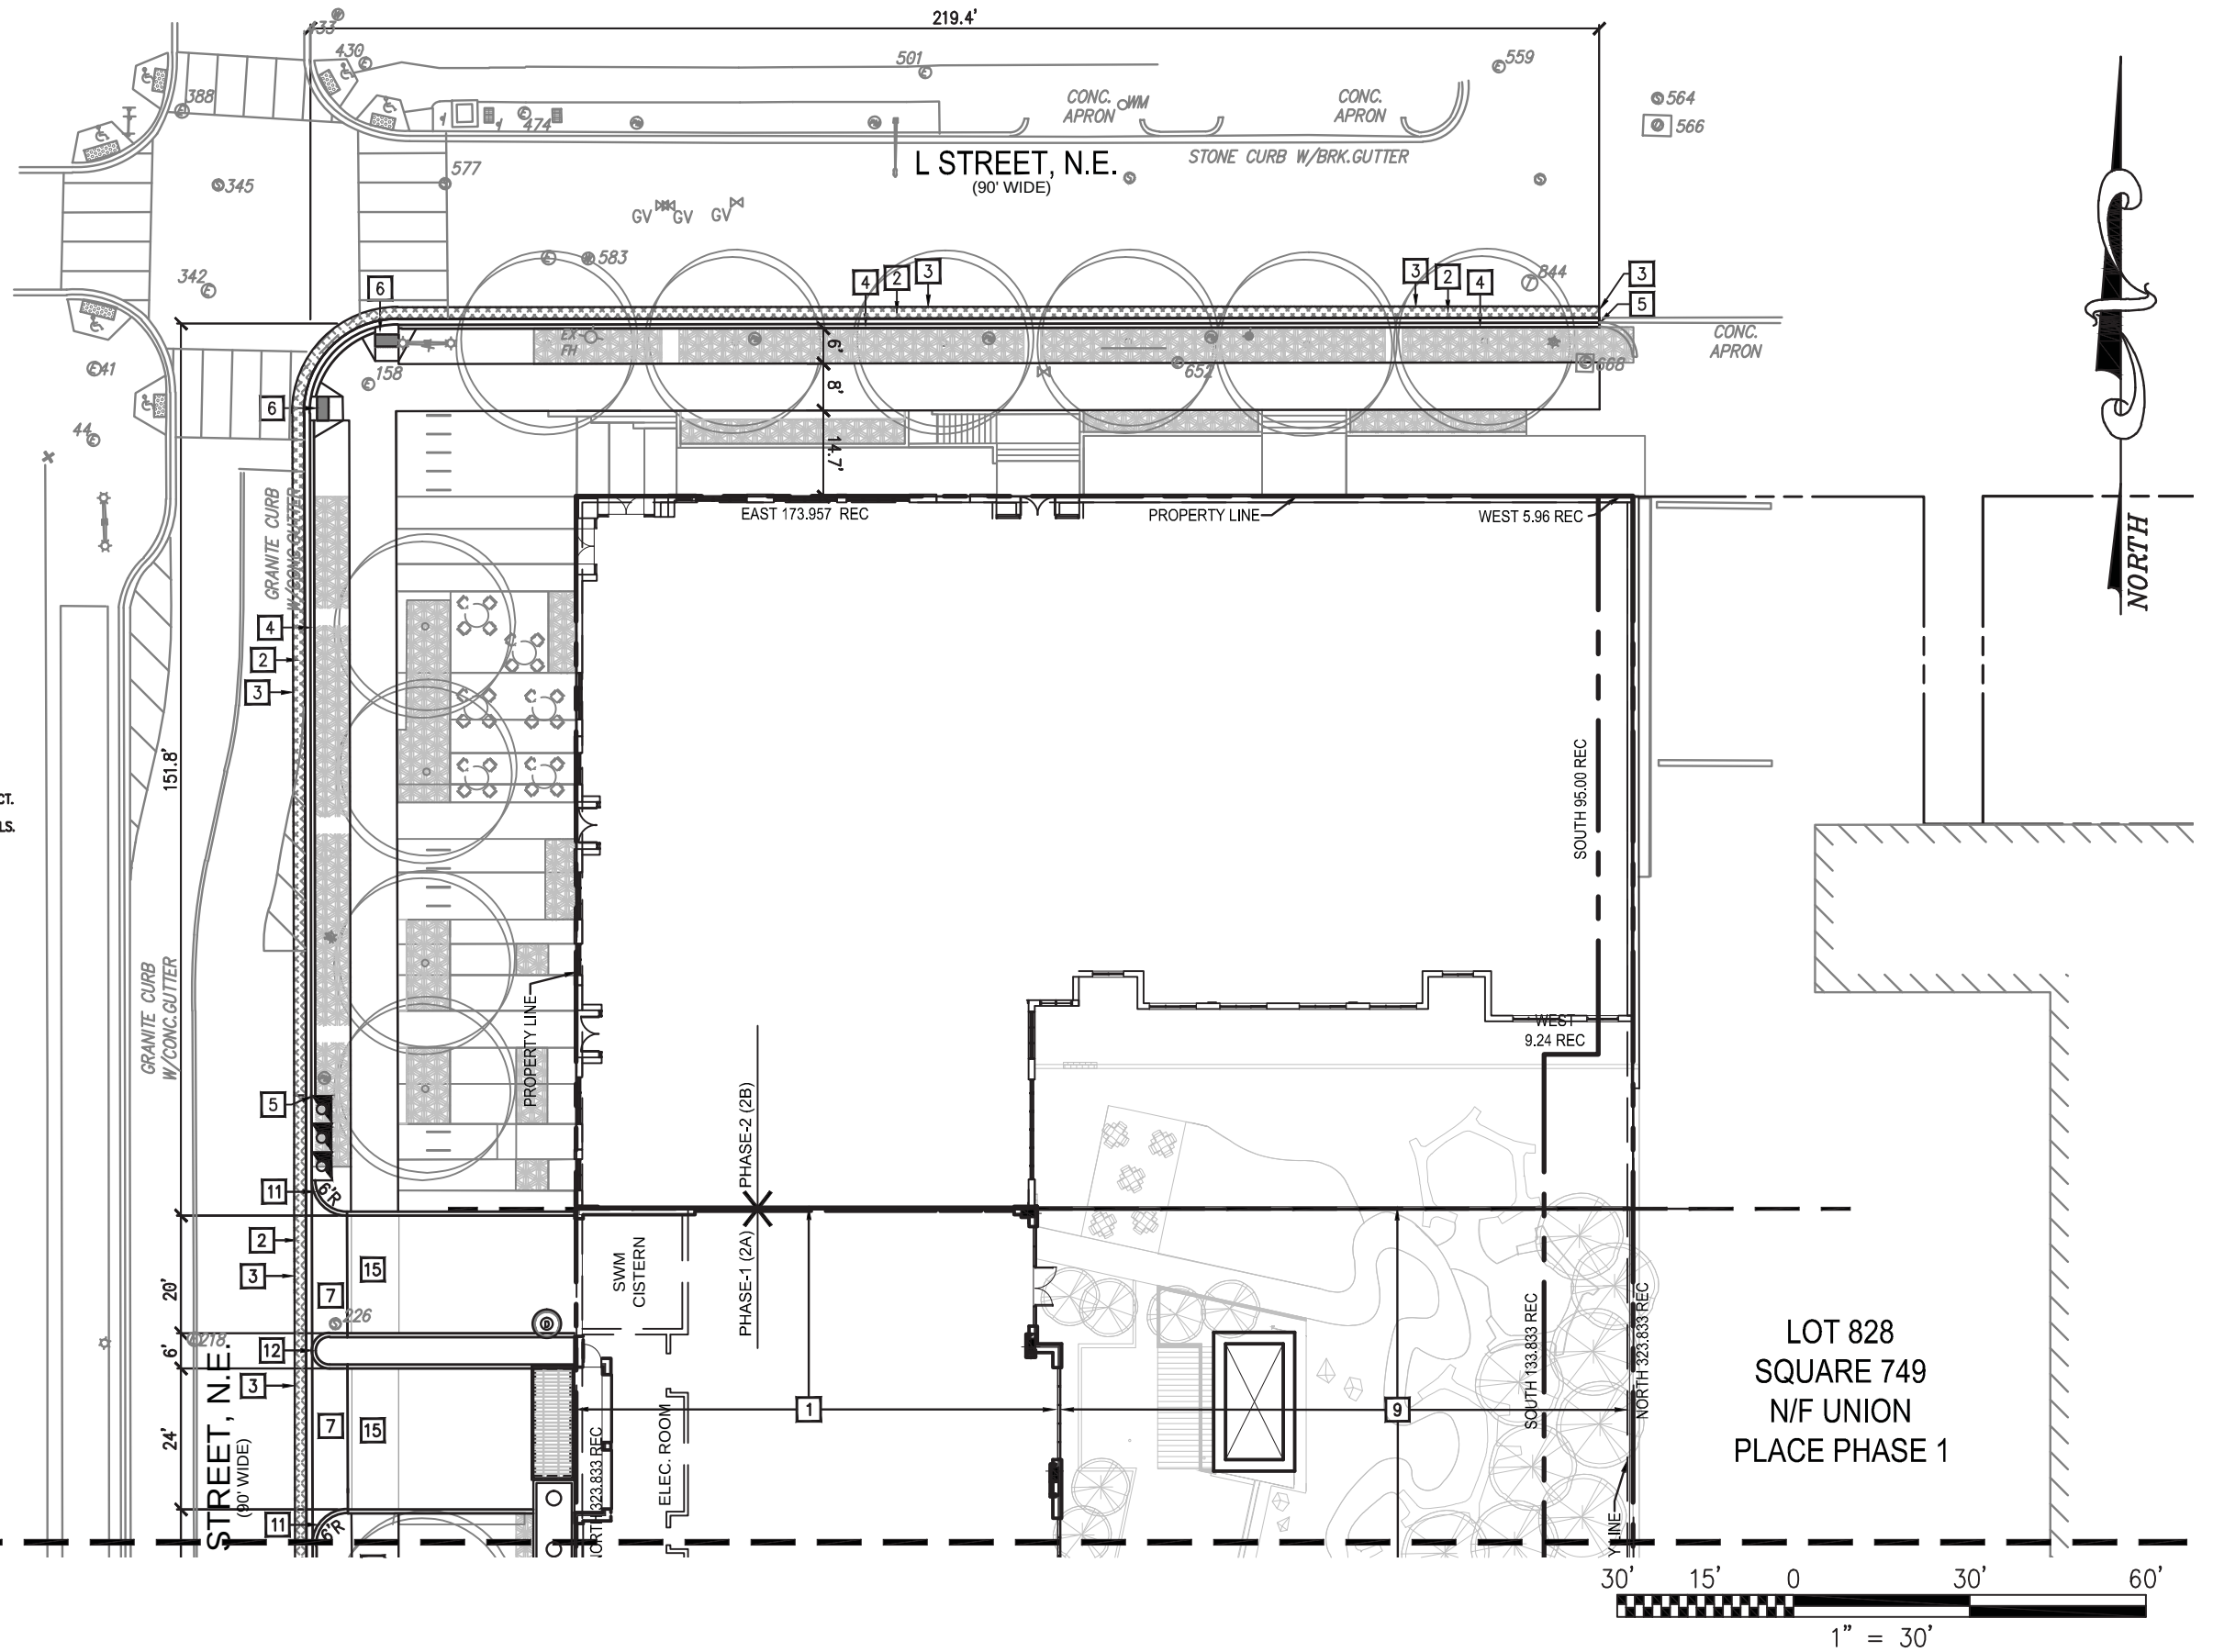

Architectural site plan showing two lots and their surrounding streets.

LOT 826 SQUARE 749
55,037 SQ.FT. REC
200 K STREET, N.E.

LOT 827 SQUARE 749
3,226 SQ.FT. REC

Streets:
2nd S
K STREET, N.E. (147.67' WIDE)

Key Features and Dimensions:
 - **Garage Below:** Located on the north side of Lot 826.
 - **Water Pump Room:** Located on the north side of Lot 826.
 - **Fire Cont. Room:** Located on the east side of Lot 826.
 - **Property Line:** Indicated by a dashed line.
 - **Dimensions:** Various dimensions are shown, including lot width (147.67'), lot area (55,037 SQ.FT. REC and 3,226 SQ.FT. REC), and building dimensions (e.g., 30.1', 44.1', 22.5').
 - **Other Labels:** "GRANITE CURB W/CONC. GUTTER", "PAINTED LINE DOUBLE YELLOW", "METAL HANDRAIL ON CONC. WALL", "10 STORY BRICK BUILDING", "EAST 8.60 REC", "SOUTH 95.00 REC", "WEST 173.17 REC", "WEST 8.60 REC", "CONC. PAVERS", "TRF-PL", "WLK-SIG", "BRK.S/W", "GRANITE CURB W/BRK.GUTTER".

Scale:
1" = 30'

North Arrow: Indicated by a stylized arrow pointing upwards.

SITE KEYNOTES:

- 1** NEW BUILDING. REFER TO ARCHITECTURAL DRAWING FOR DETAILS.
- 2** NEW ASPHALT SURFACE COURSE FRONTING CONSTRUCTION PER DC/DDOT STANDARDS AND SPECIFICATIONS. SEE SHEET C-582 FOR DETAILS.
- 3** LIMIT OF NEW ASPHALT PAVEMENT.
- 4** NEW GRANITE CURB WITH BRICK GUTTER PER DC/DDOT STANDARDS AND SPECIFICATIONS. SEE SHEET C-582 FOR DETAILS.
- 5** LIMIT OF NEW GRANITE CURB AND BRICK GUTTER TO MATCH IN LINE ON GRADE.
- 6** NEW HANDICAP RAMP PER DC/DDOT STANDARDS AND SPECIFICATIONS. REFER TO SHEET C-583 FOR DETAILS.
- 7** NEW CONCRETE APRON PER DC/DDOT STANDARDS AND SPECIFICATIONS. SEE SHEET C-582 FOR DETAILS.
- 8** NEW STREET TREE. REFER TO LANDSCAPE DRAWINGS FOR DETAILS.
- 9** NEW COURTYARD. REFER TO LANDSCAPE DRAWING FOR DETAILS.
- 10** NEW COURTYARD ENTRYWAY. REFER TO ARCH DRAWINGS FOR DETAILS.
- 11** NEW 6' RADIUS CURB RETURN PER DC DDOT STANDARDS AND SPECIFICATIONS. SEE SHEET C-582 FOR DETAILS.
- 12** NEW 3' RADIUS CURB RETURN PER DC DDOT STANDARDS AND SPECIFICATIONS. SEE SHEET C-582 FOR DETAILS.
- 13** NEW FUTURE BUILDING. TO BE BUILT AND PERMITTED UNDER SEPARATED CONTRACT.
- 14** NEW RETAINING WALL. REFER TO STRUCTURAL AND LANDSCAPE PLANS FOR DETAILS.
- 15** NEW EXPOSED AGGREGATE SIDEWALK PER DC/DDOT NOMA STANDARDS AND SPECIFICATIONS. SEE SHEET C-582 FOR DETAILS.
- 16** NEW RAIN GARDEN AREA. SEE SHEET C-793 FOR DETAILS.
- 17** NEW GRASSED AREA.
- 18** REFER TO LANDSCAPE AND STRUCTURAL DRAWINGS FOR TREATMENT OF RETAINING WALL AND EXISTING FENCE.

NEW ASPHALT PAVEMENT
(FULL DEPTH)

NEW ASPHALT PAVEMENT
(SURFACE COURSE)

NOTE:

1. REFER TO LANDSCAPE DRAWING FOR LAYOUT AND SPECIES OF TREES.
2. REFER TO LANDSCAPE DRAWING FOR LAYOUT OF COURTYARD.
3. ALL EXISTING MANHOLE TOP TO BE ADJUSTED TO MATCH PROPOSED GRADES.

313236.00


C-104 Site Plan.dwg October 07, 2014, 8:57 am

P:\2013\072_UnionPl2\CAD\ENG\PU\Sheets\C-105 Utility Plan.dwg
Xrefs: 13-072 BASE; 13-072 PHASE; 13-072 BDR-PUD; 13-072 SITE; 13-072 ARCH; 13-072 UTIL; 13-072 LANDSCAPE

UTILITY KEYNOTES:

- 1 NEW 4.0' DIAMETER CLEANOUT MANHOLE PER DC/WATER STANDARDS AND SPECIFICATIONS. REFER TO DC/WATER STANDARD DRAWING S-20.01 ON SHEET C-503.
- 2 NEW CONNECTION TO EXISTING MANHOLE PER DC/WATER STANDARDS AND SPECIFICATIONS.
- 3 NEW 15" RCP CLASS III STORM SEWER PIPE PER DC/WATER STANDARDS AND SPECIFICATIONS.
- 4 NEW 6" DIP CLASS 52 FIRE SERVICE LATERAL BACKFLOW PREVENTER ASSEMBLY TO MEET ASSE-1048.
- 5 NEW 6" DIP CLASS 52 DOMESTIC WATER SERVICE LATERAL BACKFLOW PREVENTER ASSEMBLY TO MEET ASSE-1015.
- 6 NEW 6" WATER VALVE WITH 4.0' CASING PER DC/WATER STANDARDS AND SPECIFICATIONS. REFER TO DC/WATER STANDARD DRAWING W-20.01 ON SHEET C-503.
- 7 NEW 8" WATER VALVE WITH 4.0' CASING PER DC/WATER STANDARDS AND SPECIFICATIONS. REFER TO DC/WATER STANDARD DRAWING W-20.01 ON SHEET C-503.
- 8 NEW 84"x72"x72" I.D. METER VAULT PER DC/WATER STANDARDS AND SPECIFICATIONS. REFER TO DC/WATER STANDARD DRAWING DG-23.01 ON SHEET C-503.
- 9 NEW CONCRETE THRUST BLOCK PER DC/WATER STANDARDS AND SPECIFICATIONS. REFER TO DC/WATER STANDARD DRAWING W-40.01 ON SHEET C-503.
- 10 NEW 6'x18" PEPCO PARTIALLY GRATED TRANSFORMER VAULT. REFER TO DRY UTILITY DRAWINGS FOR DETAILS.
- 11 NEW PEPCO BUS VAULT. REFER TO DRY UTILITY DRAWINGS FOR DETAILS.
- 12 NEW 8" DIP CLASS 52 WATER LINE AND SLEEVE CONNECTIONS.
- 13 NEW WATER QUALITY CURB INLET CATCH BASIN PER DC/WATER STANDARDS AND SPECIFICATIONS. REFER TO DC/WATER STANDARD DRAWING S-31.01.
- 14 NEW 12" PVC SCH 40 SANITARY SEWER.
- 15 NEW 4.0' DIAMETER MANHOLE WITH DOGHOUSE BASE PER DC WATER STANDARDS AND SPECIFICATIONS. REFER TO DC WATER STANDARD DRAWING S-20.11 ON SHEET C-503.
- 16 NEW 6'x18" PEPCO FULLY GRATED TRANSFORMER VAULT. REFER TO DRY UTILITY DRAWINGS FOR DETAILS.
- 17 NEW SIAMESE FDC CONNECTION. REFER TO PLUMBING DRAWINGS FOR DETAILS.
- 18 LIMITS OF EXISTING ABANDONED 8" WATER MAIN.
- 19 ~~NEW 6" PVC SCH 40 PIPE.~~
- 20 ~~NEW 6" PERFORATED PVC SCH 40 UNDERDRAIN PIPE.~~
- 21 ~~NEW OVERFLOW GRATE INLET.~~
- 22 ~~NEW CLEANOUT. REFER TO DC/WATER STANDARD DRAWING S-80.02 ON SHEET C-503.~~
- 23 NEW 2" GAS LATERAL, SHOWN FOR COORDINATION PURPOSED ONLY. COORDINATE REQUIREMENTS WITH WASHINGTON GAS. REFER TO MECHANICAL/ELECTRICAL/PLUMBING DRAWINGS FOR DETAILS.
- 24 NEW WASHINGTON GLOBE #16 PER DC/DDOT STANDARDS AND SPECIFICATIONS. REFER TO SITE ELECTRICAL DRAWINGS FOR DETAILS AND CONDUIT ROUTING.

MATCH LINE: C-105B

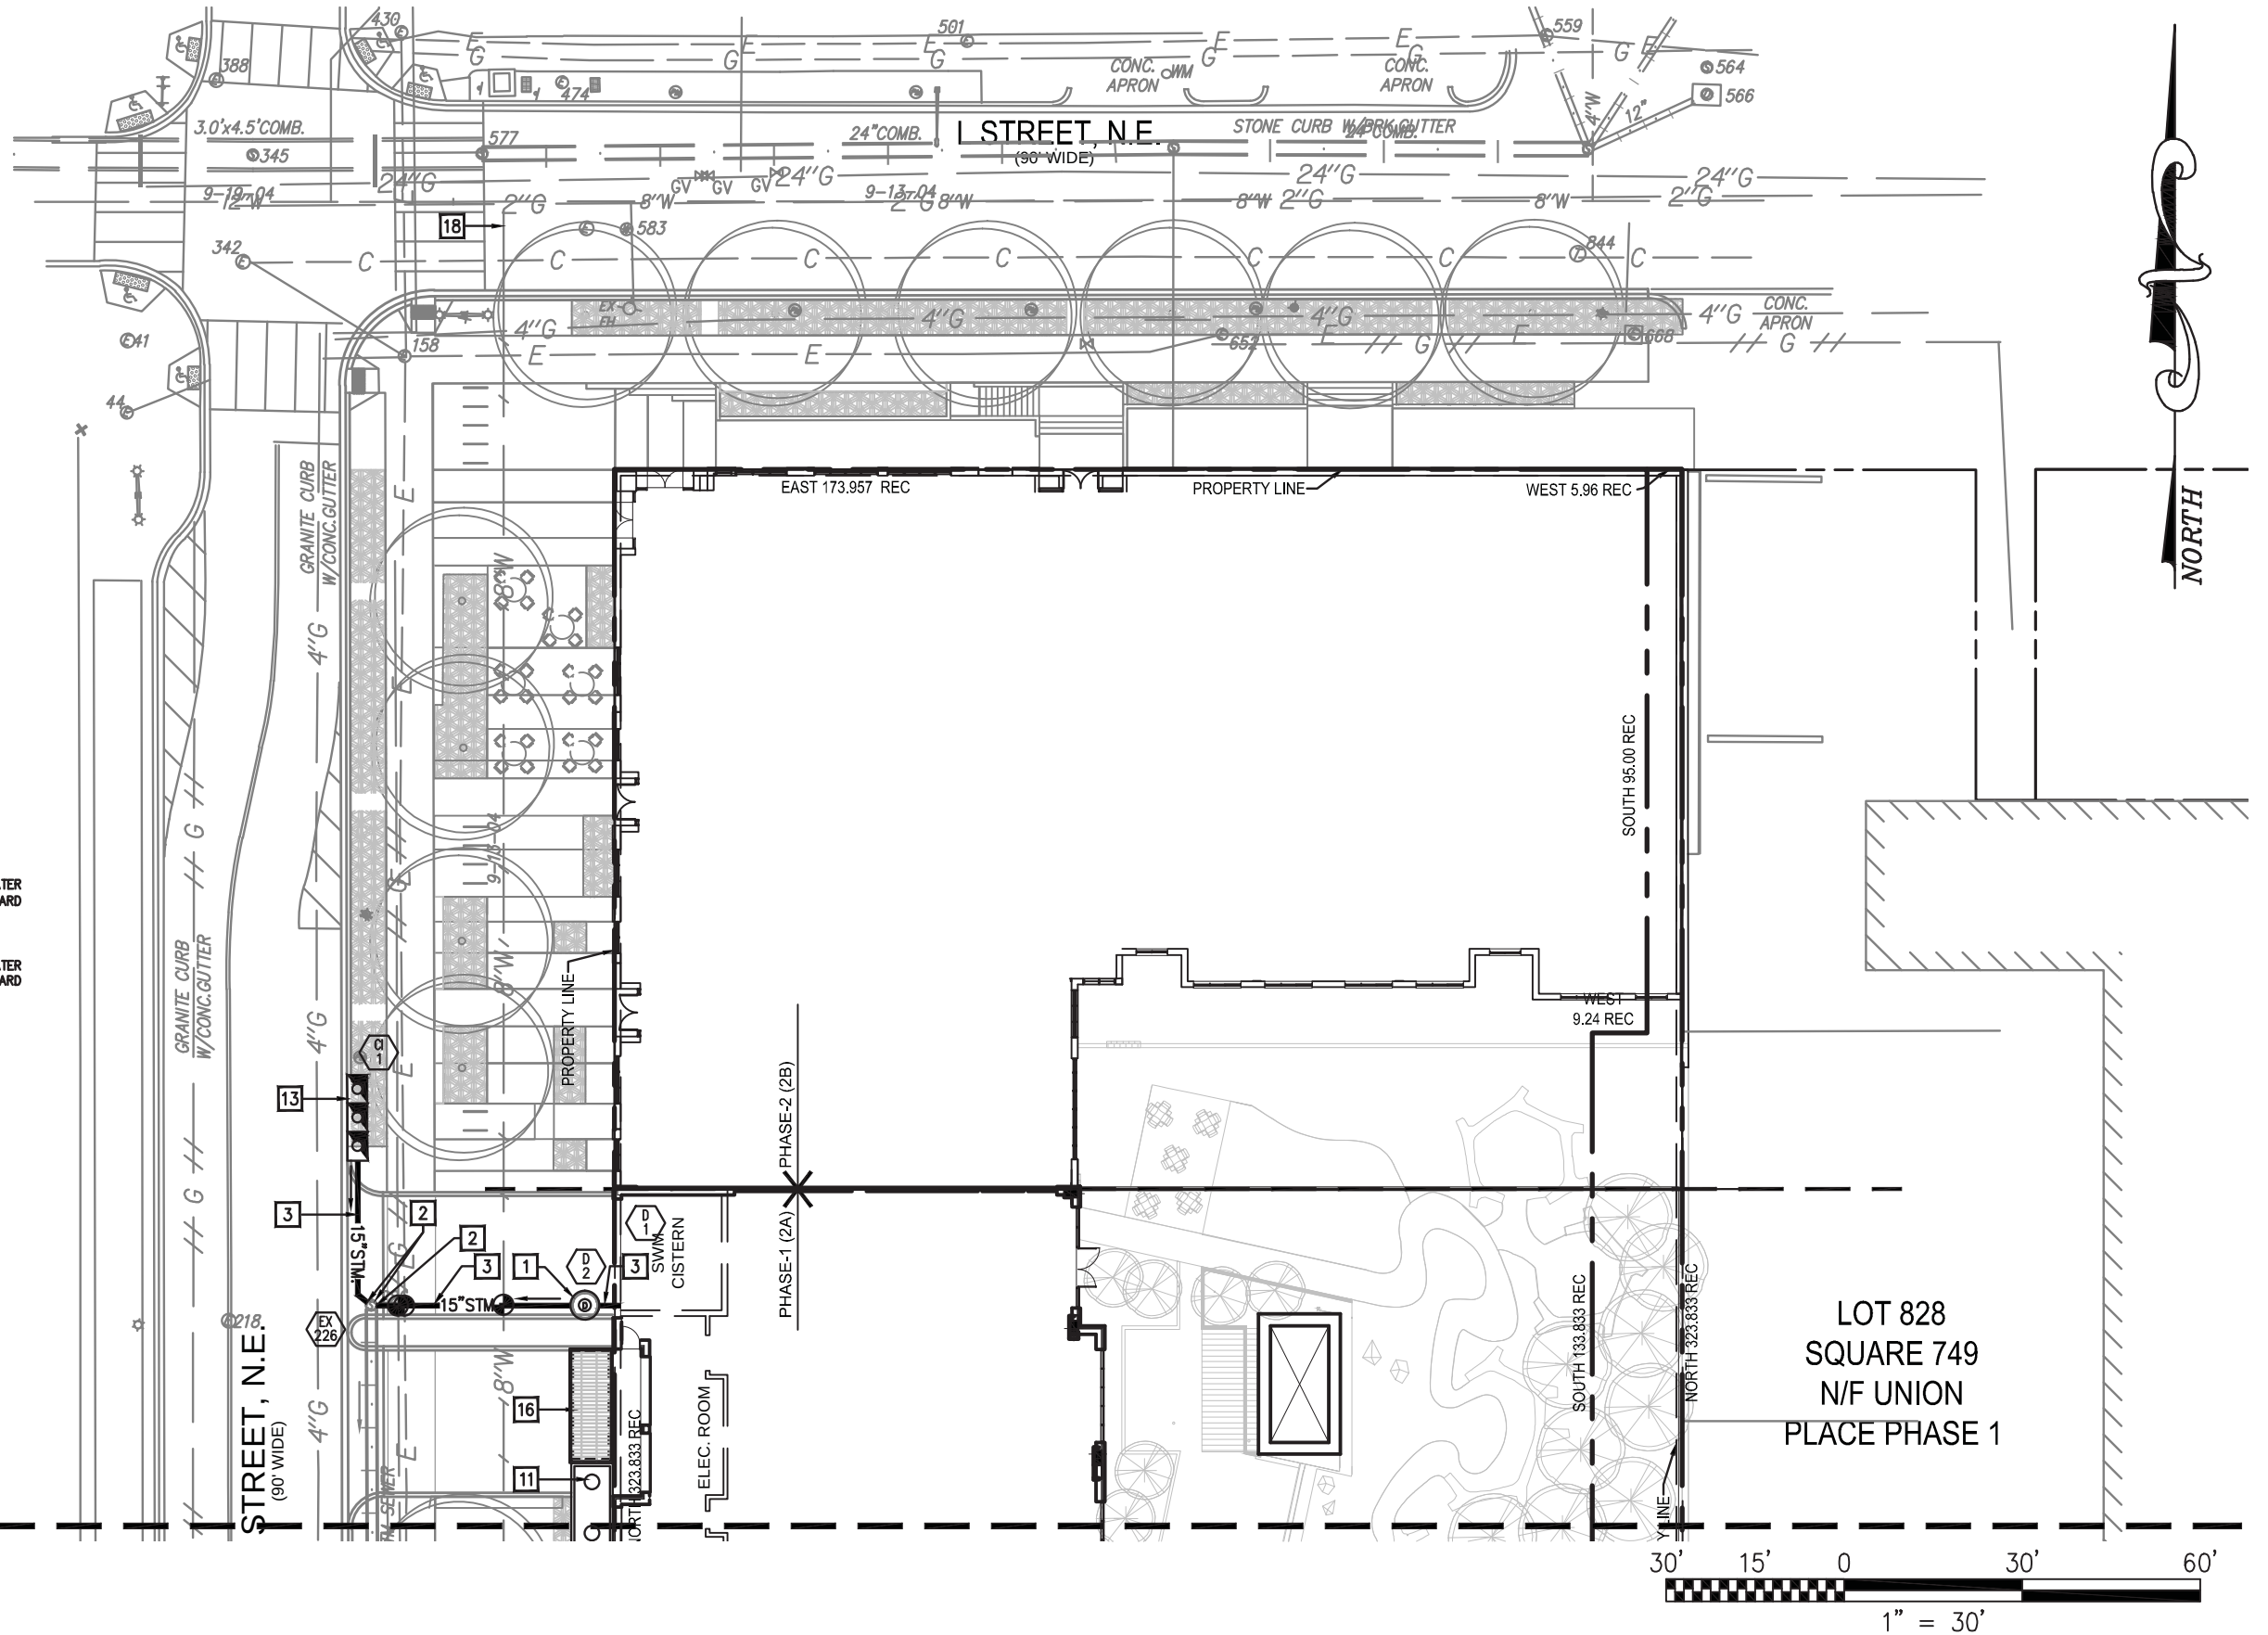

P:\2013\072_UnionPl2\CAD\ENG\PU2\Sheets\C-105 Utility Plan.dwg
Xrefs: 13-072 BASE; 13-072 PHASE; 13-072 BDR-PUD; 13-072 SITE; 13-072 ARCH; 13-072 UTIL; 13-072 LANDSCAPE

MATCH LINE: C-105A

UTILITY KEYNOTES:

- 1 NEW 4.0" DIAMETER CLEANOUT MANHOLE PER DC/WATER STANDARDS AND SPECIFICATIONS. REFER TO DC/WATER STANDARD DRAWING S-20.01 ON SHEET C-503.
- 2 NEW CONNECTION TO EXISTING MANHOLE PER DC/WATER STANDARDS AND SPECIFICATIONS.
- 3 NEW 15" RCPR CLASS III STORM SEWER PIPE PER DC/WATER STANDARDS AND SPECIFICATIONS.
- 4 NEW 6" DIP CLASS 52 FIRE SERVICE LATERAL BACKFLOW PREVENTER ASSEMBLY TO MEET ASSE-1048.
- 5 NEW 4" DIP CLASS 52 DOMESTIC WATER SERVICE LATERAL BACKFLOW PREVENTER ASSEMBLY TO MEET ASSE-1015.
- 6 NEW 6" WATER VALVE WITH 4.0" CASING PER DC/WATER STANDARDS AND SPECIFICATIONS. REFER TO DC/WATER STANDARD DRAWING W-20.01 ON SHEET C-503.
- 7 NEW 8" WATER VALVE WITH 4.0" CASING PER DC/WATER STANDARDS AND SPECIFICATIONS. REFER TO DC/WATER STANDARD DRAWING W-20.01 ON SHEET C-503.
- 8 NEW 72"x72"x72" I.D. METER VAULT PER DC/WATER STANDARDS AND SPECIFICATIONS. REFER TO DC/WATER STANDARD DRAWING DG-23.01 ON SHEET C-503.
- 9 NEW CONCRETE THRUST BLOCK PER DC/WATER STANDARDS AND SPECIFICATIONS. REFER TO DC/WATER STANDARD DRAWING W-40.01 ON SHEET C-503.
- 10 NEW 6"x18" PEPCO PARTIALLY GRATED TRANSFORMER VAULT. REFER TO DRY UTILITY DRAWINGS FOR DETAILS.
- 11 NEW PEPCO BUS VAULT. REFER TO DRY UTILITY DRAWINGS FOR DETAILS.
- 12 NEW 8" DIP CLASS 52 WATER LINE AND SLEEVE CONNECTIONS.
- 13 NEW WATER QUALITY CURB INLET CATCH BASIN PER DC/WATER STANDARDS AND SPECIFICATIONS. REFER TO DC/WATER STANDARD DRAWING S-31.01.
- 14 NEW 12" PVC SCH 40 SANITARY SEWER.
- 15 NEW 4.8" DIAMETER MANHOLE WITH DOGHOUSE BASE PER DC WATER STANDARDS AND SPECIFICATIONS. REFER TO DC WATER STANDARD DRAWING S-20.11 ON SHEET C-503.
- 16 NEW 6"x18" PEPCO FULLY GRATED TRANSFORMER VAULT. REFER TO DRY UTILITY DRAWINGS FOR DETAILS.
- 17 NEW SIAMSE FDC CONNECTION. REFER TO PLUMBING DRAWINGS FOR DETAILS.
- 18 LIMITS OF EXISTING ABANDONED 8" WATER MAIN.
- 19 NEW 6" PVC SCH 40 PIPE.
- 20 NEW 6" PERFORATED PVC SCH 40 UNDERDRAIN PIPE.
- 21 NEW OVERFLOW GRATE INLET.
- 22 NEW CLEANOUT. REFER TO DC/WATER STANDARD DRAWING S-06.02 ON SHEET C-503.
- 23 NEW 2" GAS LATERAL SHOWN FOR COORDINATION PURPOSED ONLY. COORDINATE REQUIREMENTS WITH WASHINGTON GAS. REFER TO MECHANICAL/ELECTRICAL/PLUMBING DRAWINGS FOR DETAILS.
- 24 NEW WASHINGTON GLOBE #16 PER DC/DOOT STANDARDS AND SPECIFICATIONS. REFER TO SITE ELECTRICAL DRAWINGS FOR DETAILS AND CONDUIT ROUTING.
- 25 NEW 6"x4" REDUCER.

