

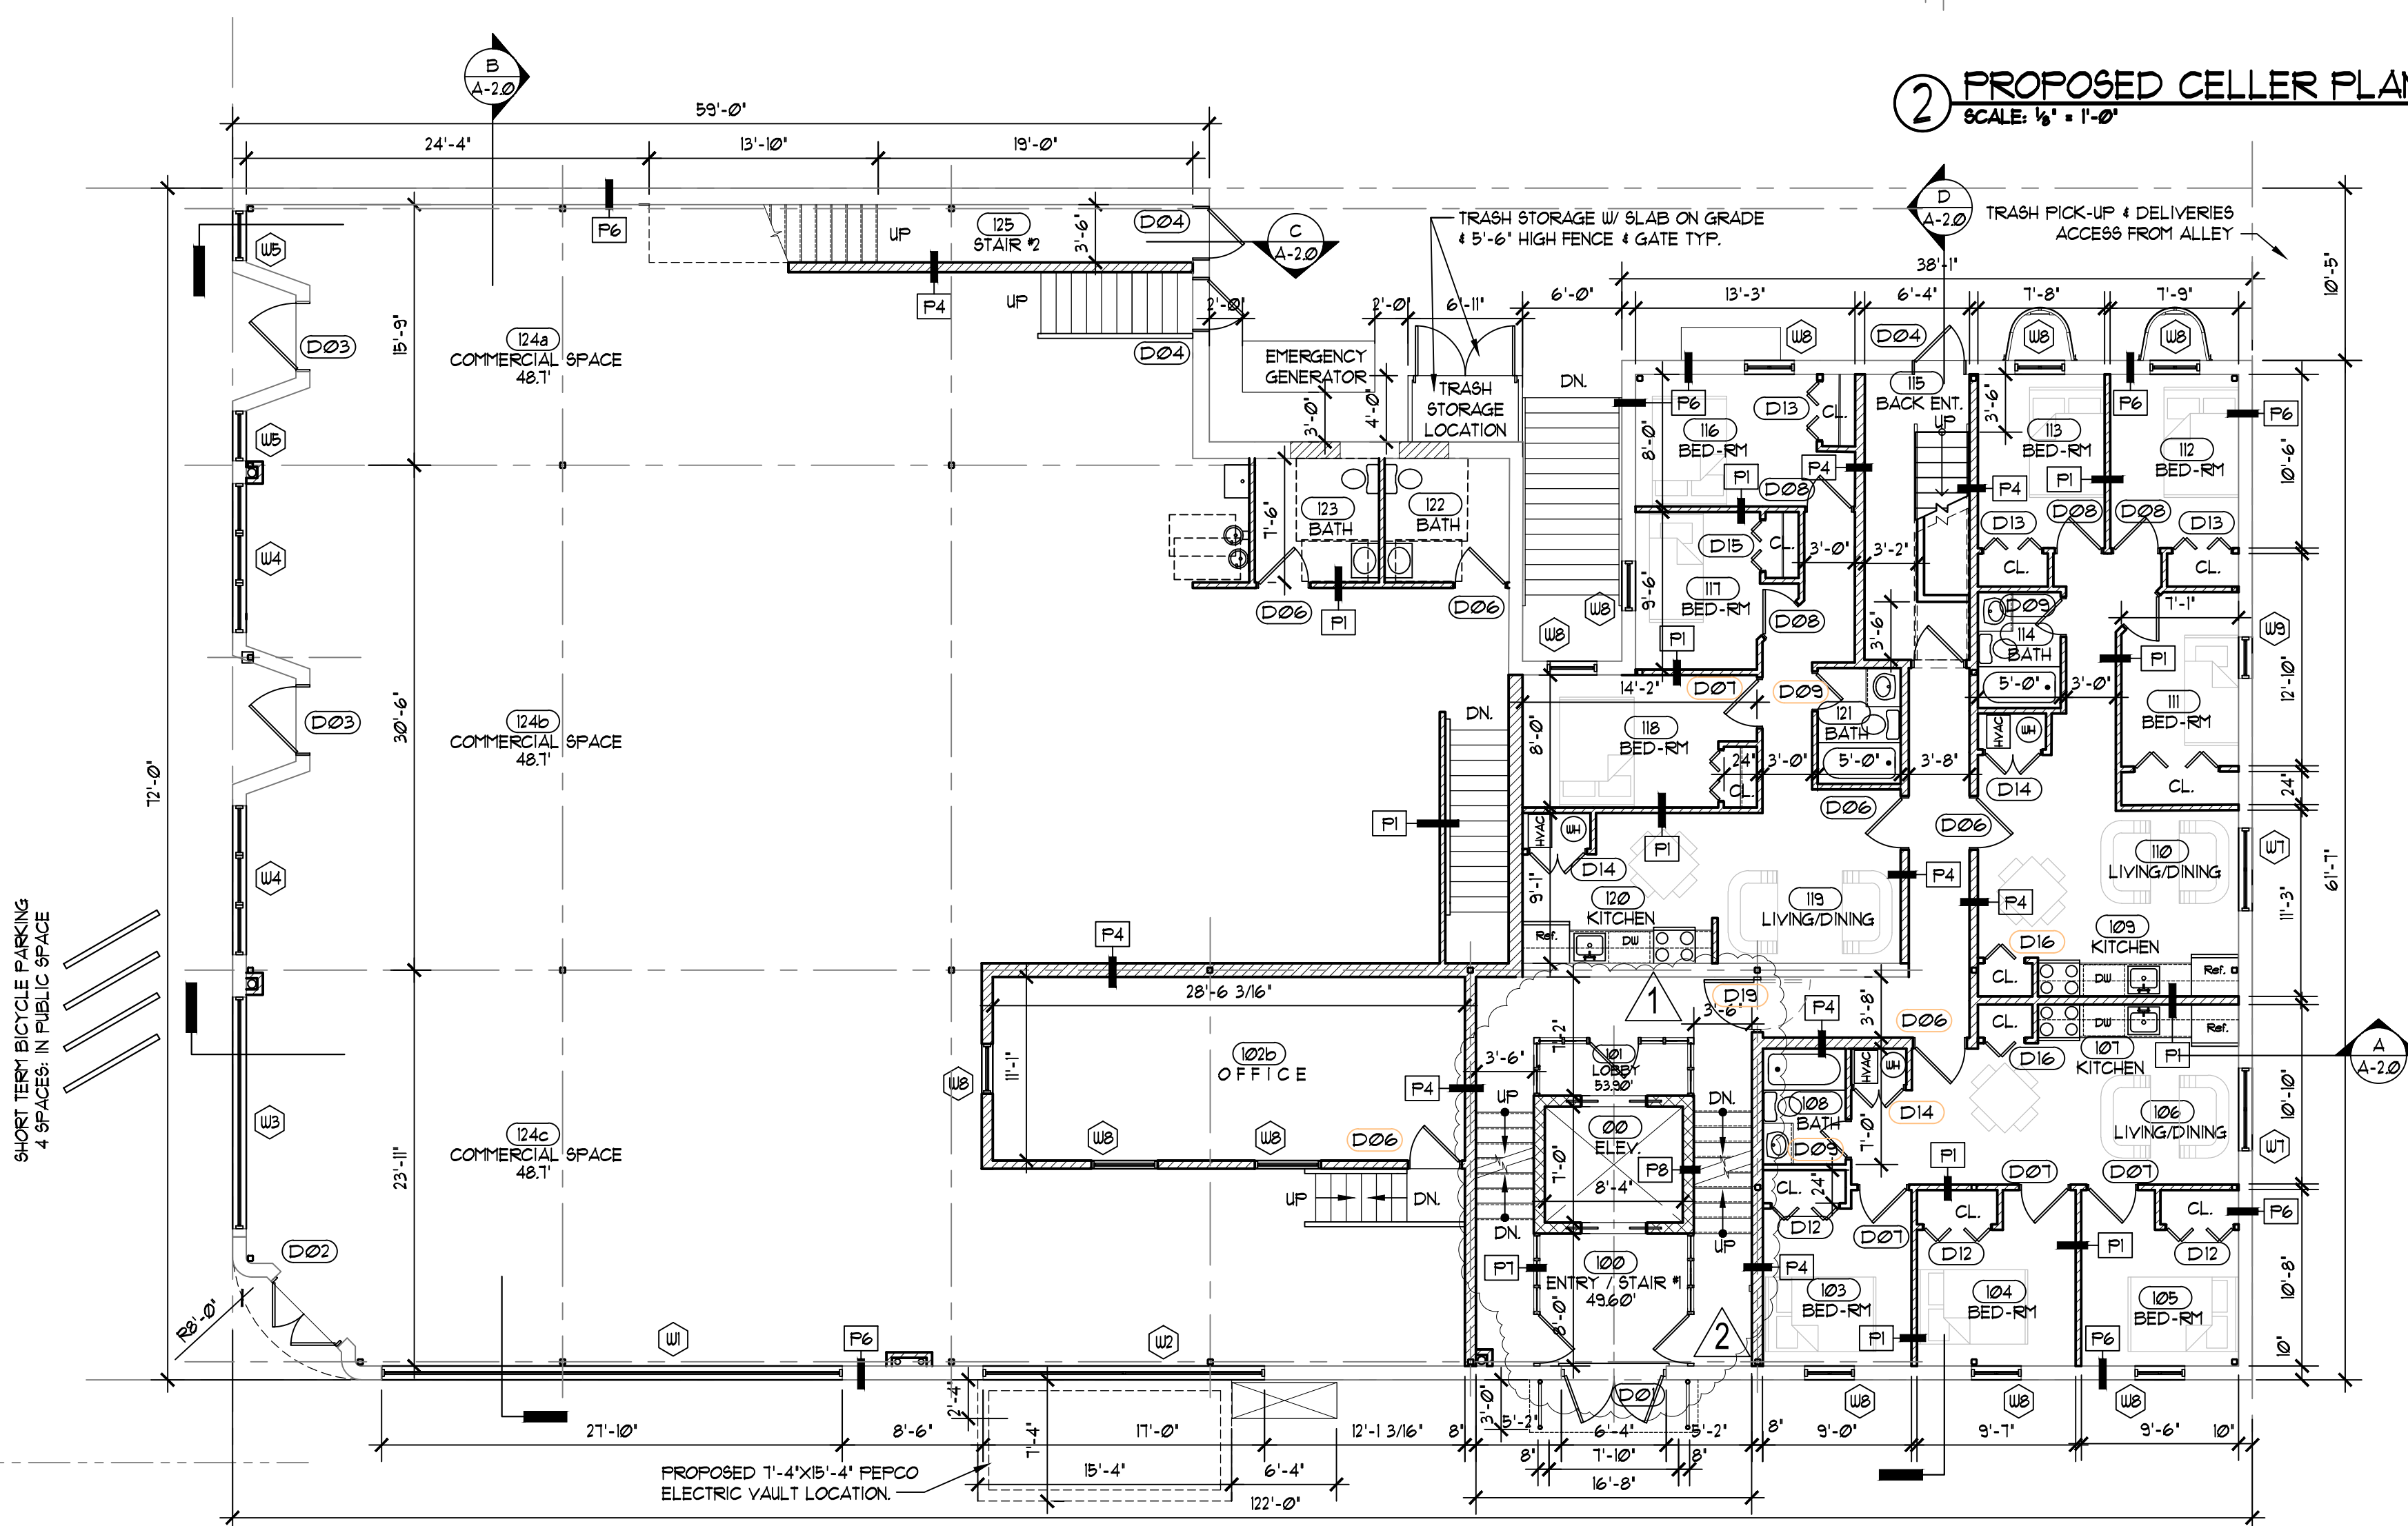
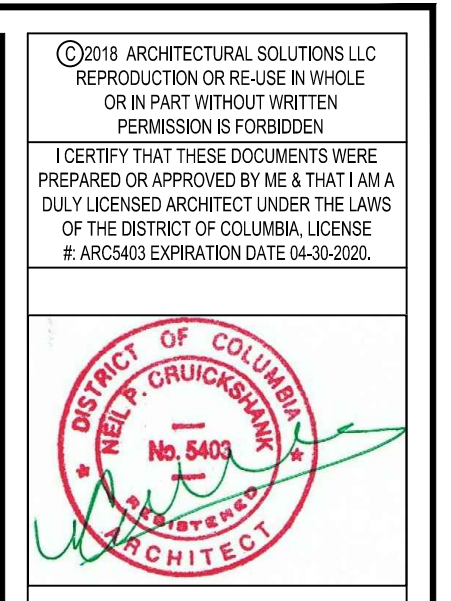


1 PROPOSED SITE PLAN
SCALE: 1/8" = 1'-0"

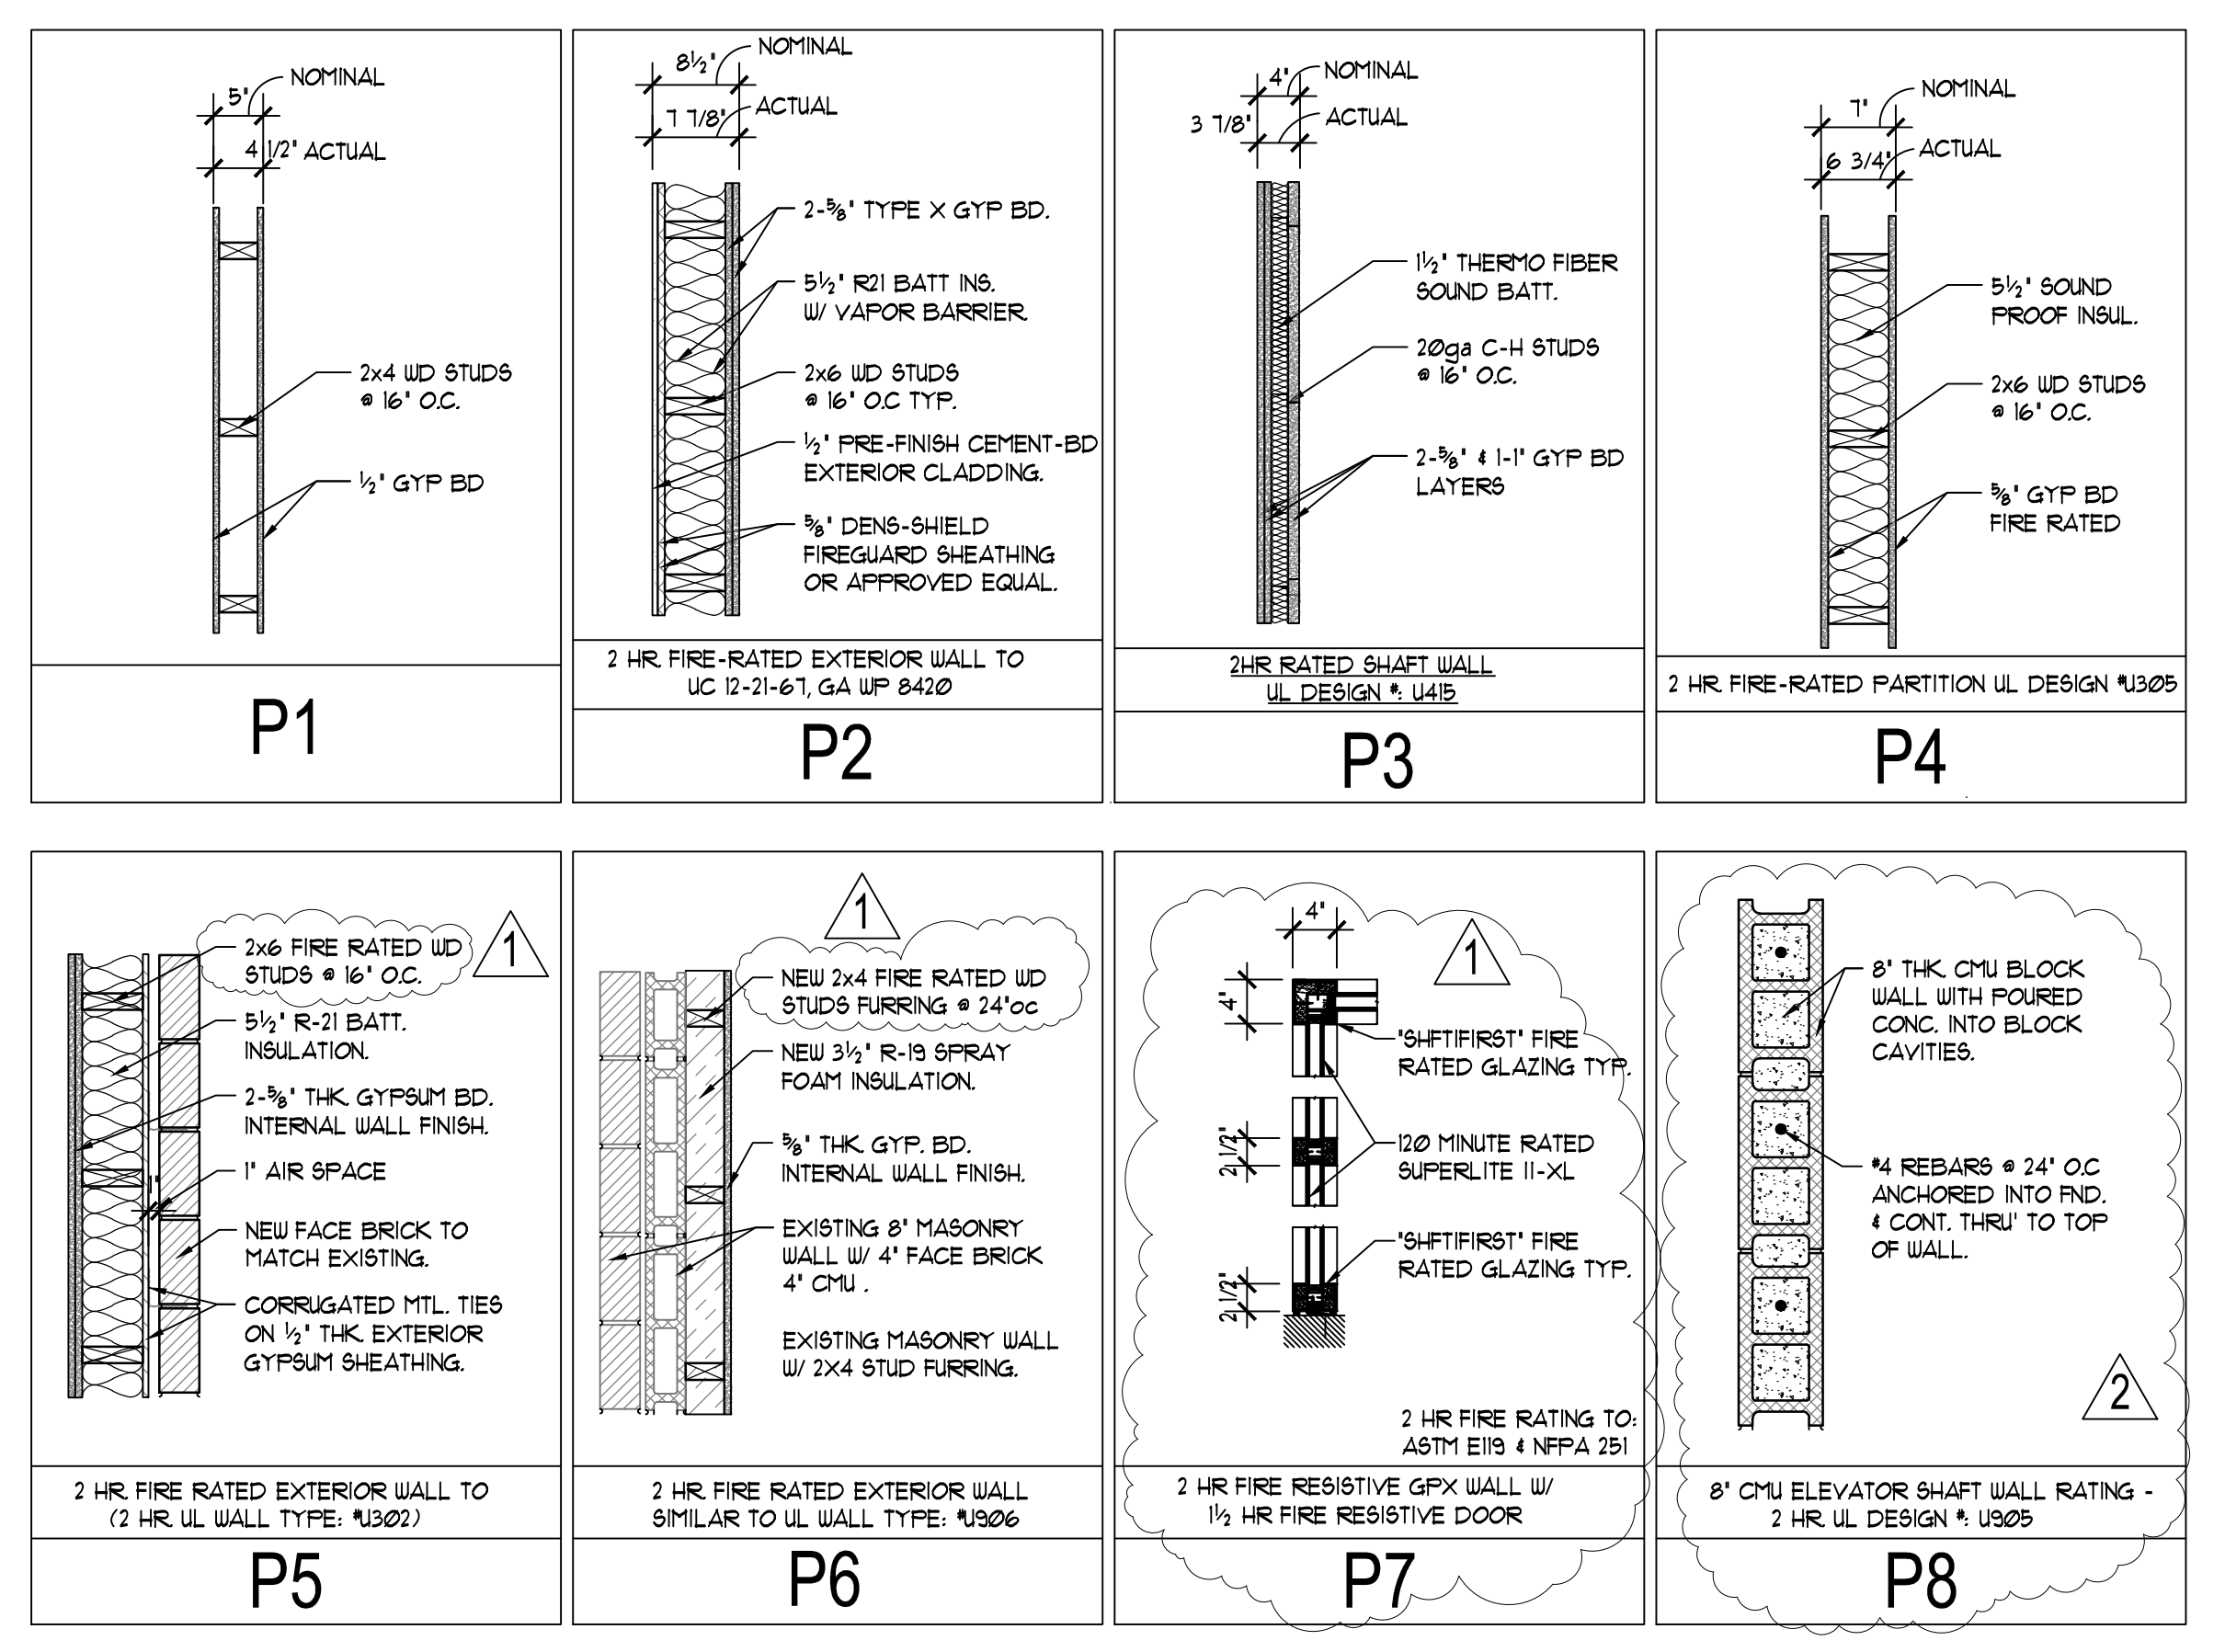

2 PROPOSED CELLAR PLAN
SCALE: 1/8" = 1'-0"

3 FIRST FLOOR PLAN
SCALE: 1/8" = 1'-0"

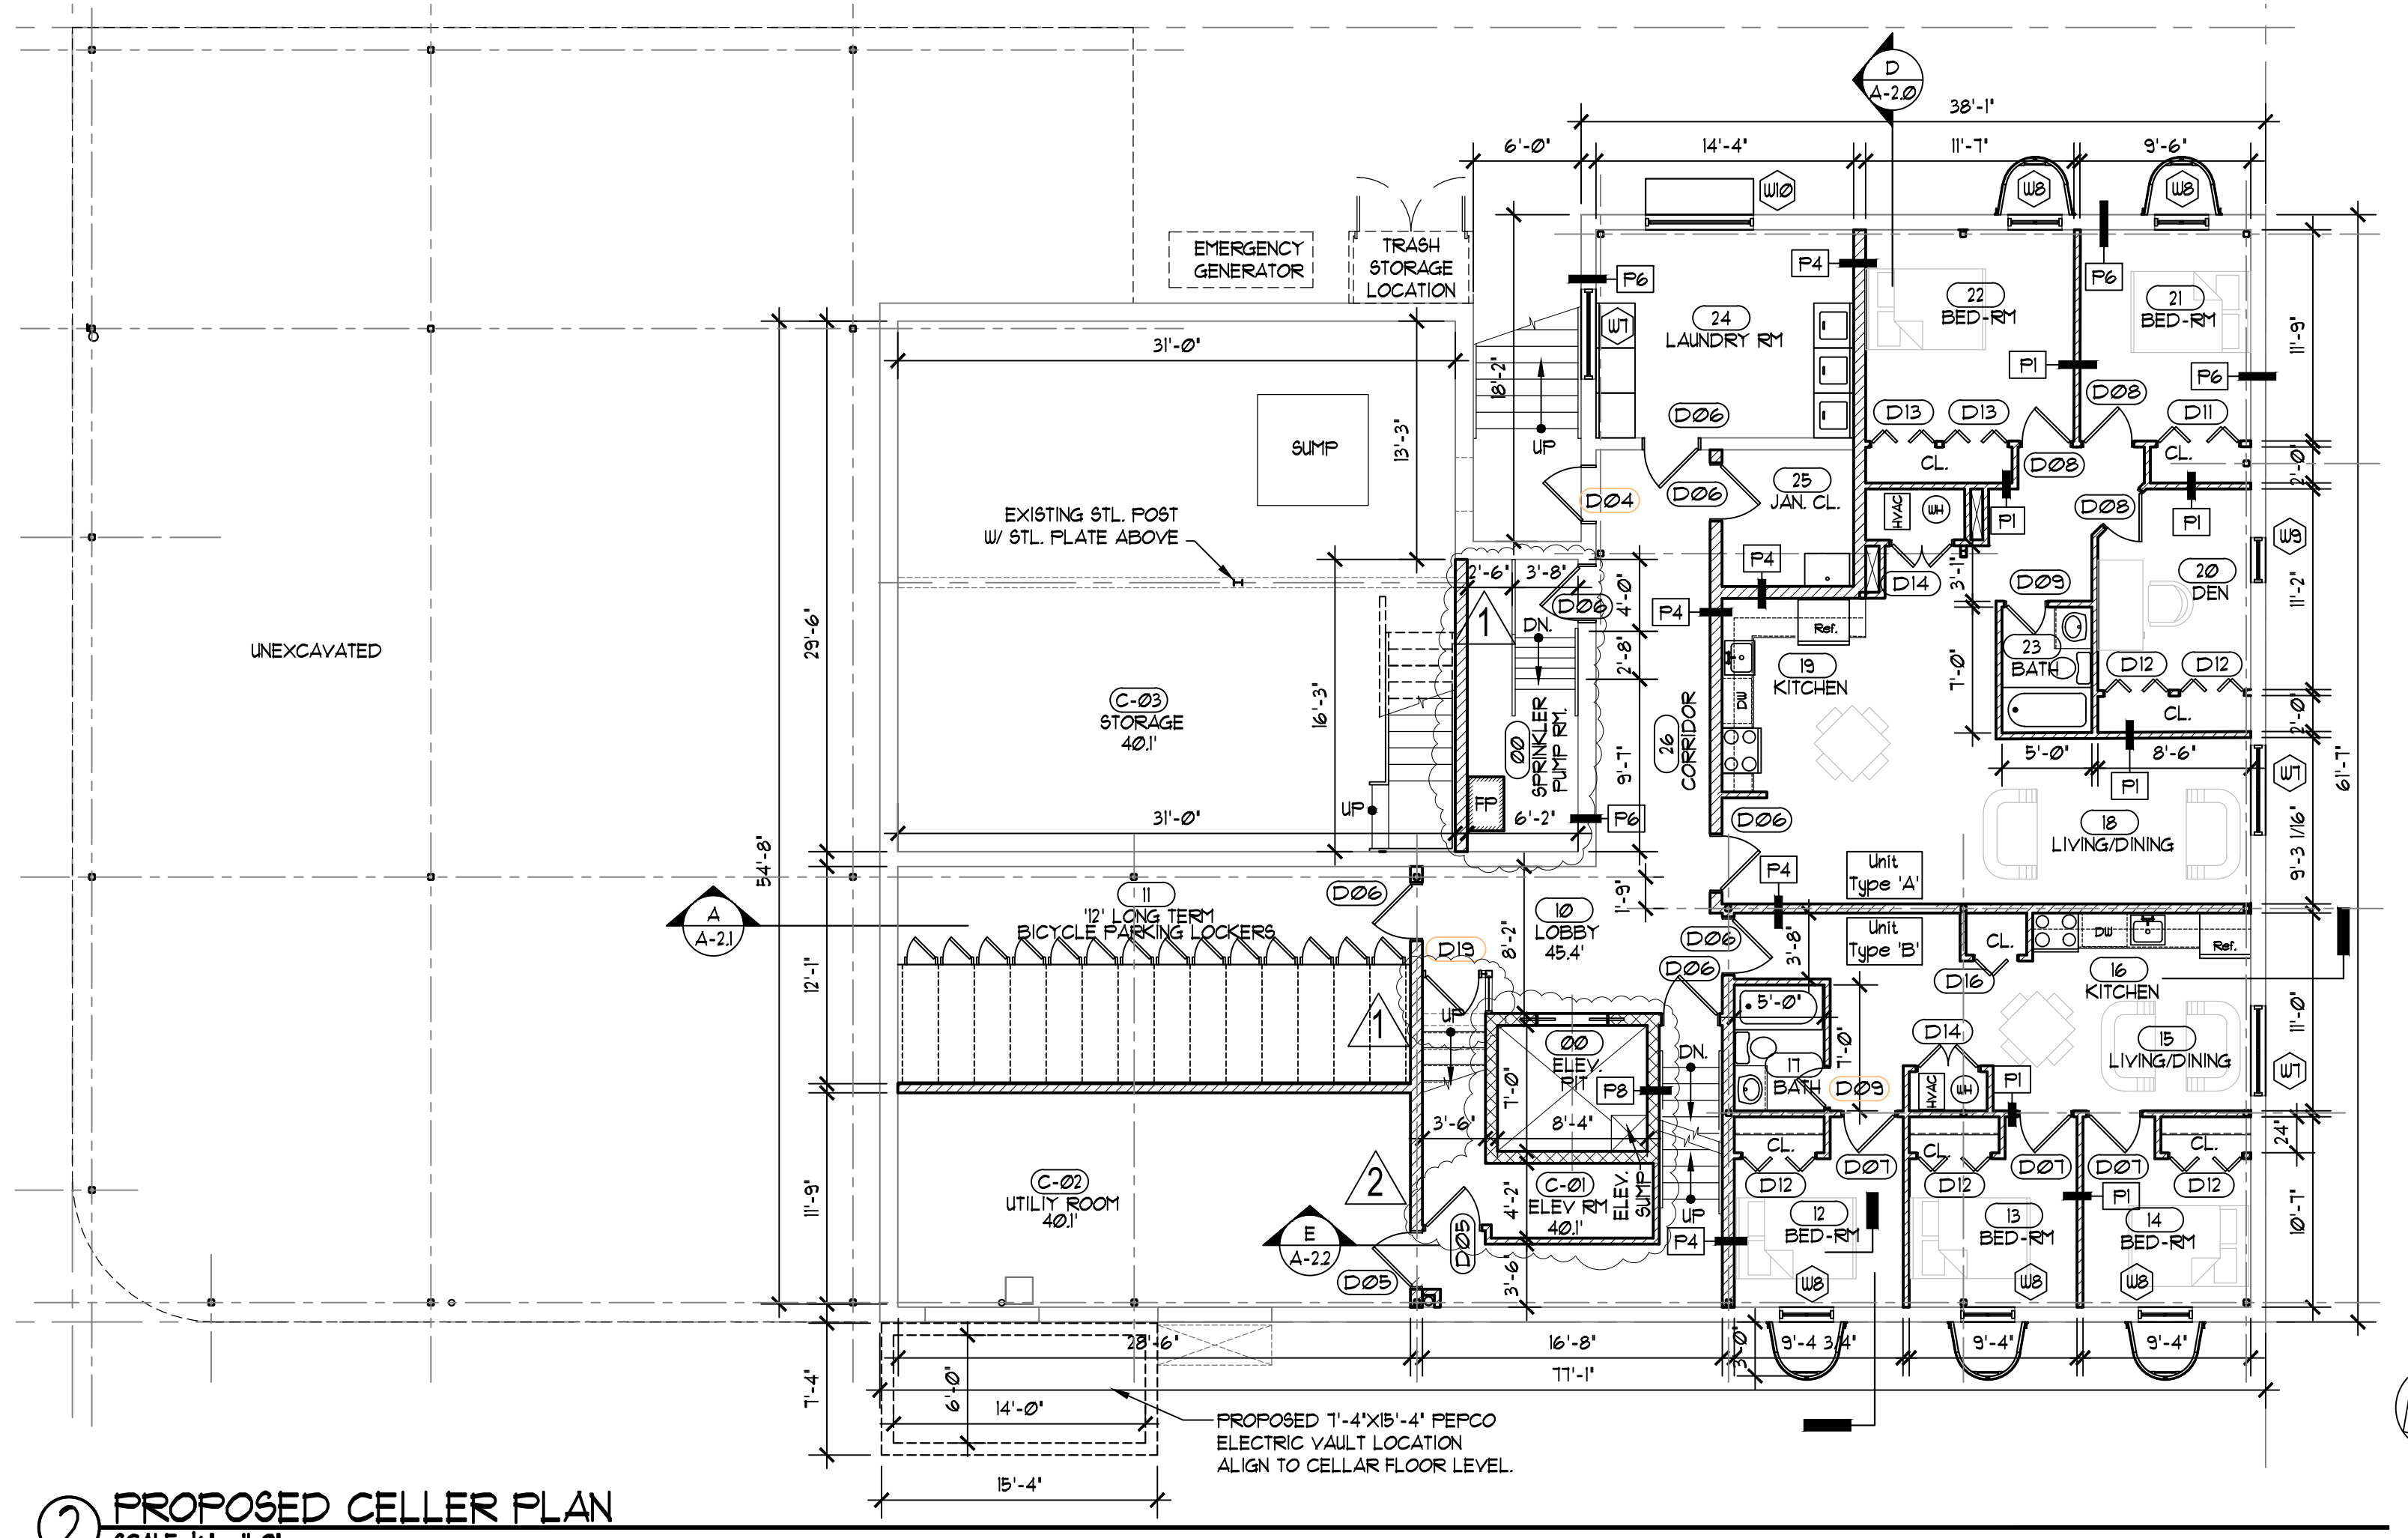

NO.	REVISIONS DESCRIPTION	DATE
1	Revisions to Comply With Plan Reviewer's Comments.	01-21-2019
2	Revisions to Comply With Plan Reviewer's Comments.	08-14-2019


Architectural Solutions LLC
1321 Fenwick Lane,
Silver Spring, MD 20910
E-Mail: info@Arch-Sol.biz
Tel: 301 562 8877
Fax: 301 562 8937
Web: www.Arch-Sol.biz

PROJECT TITLE: SIM Development LLC Existing Building Renovation & Addition @ 1916 15th Street SE, Washington DC 20020
PROJECT #:
CONSTRUCTION ISSUE: 03-02-2018
SHEET #:

A-1.2
Board of Zoning Adjustment
District of Columbia
CASE NO. 19572
EXHIBIT NO. 105



① GOOD HOPE ROAD SE PROPOSED ELEVATION
SCALE: 1/4" = 1'-0"

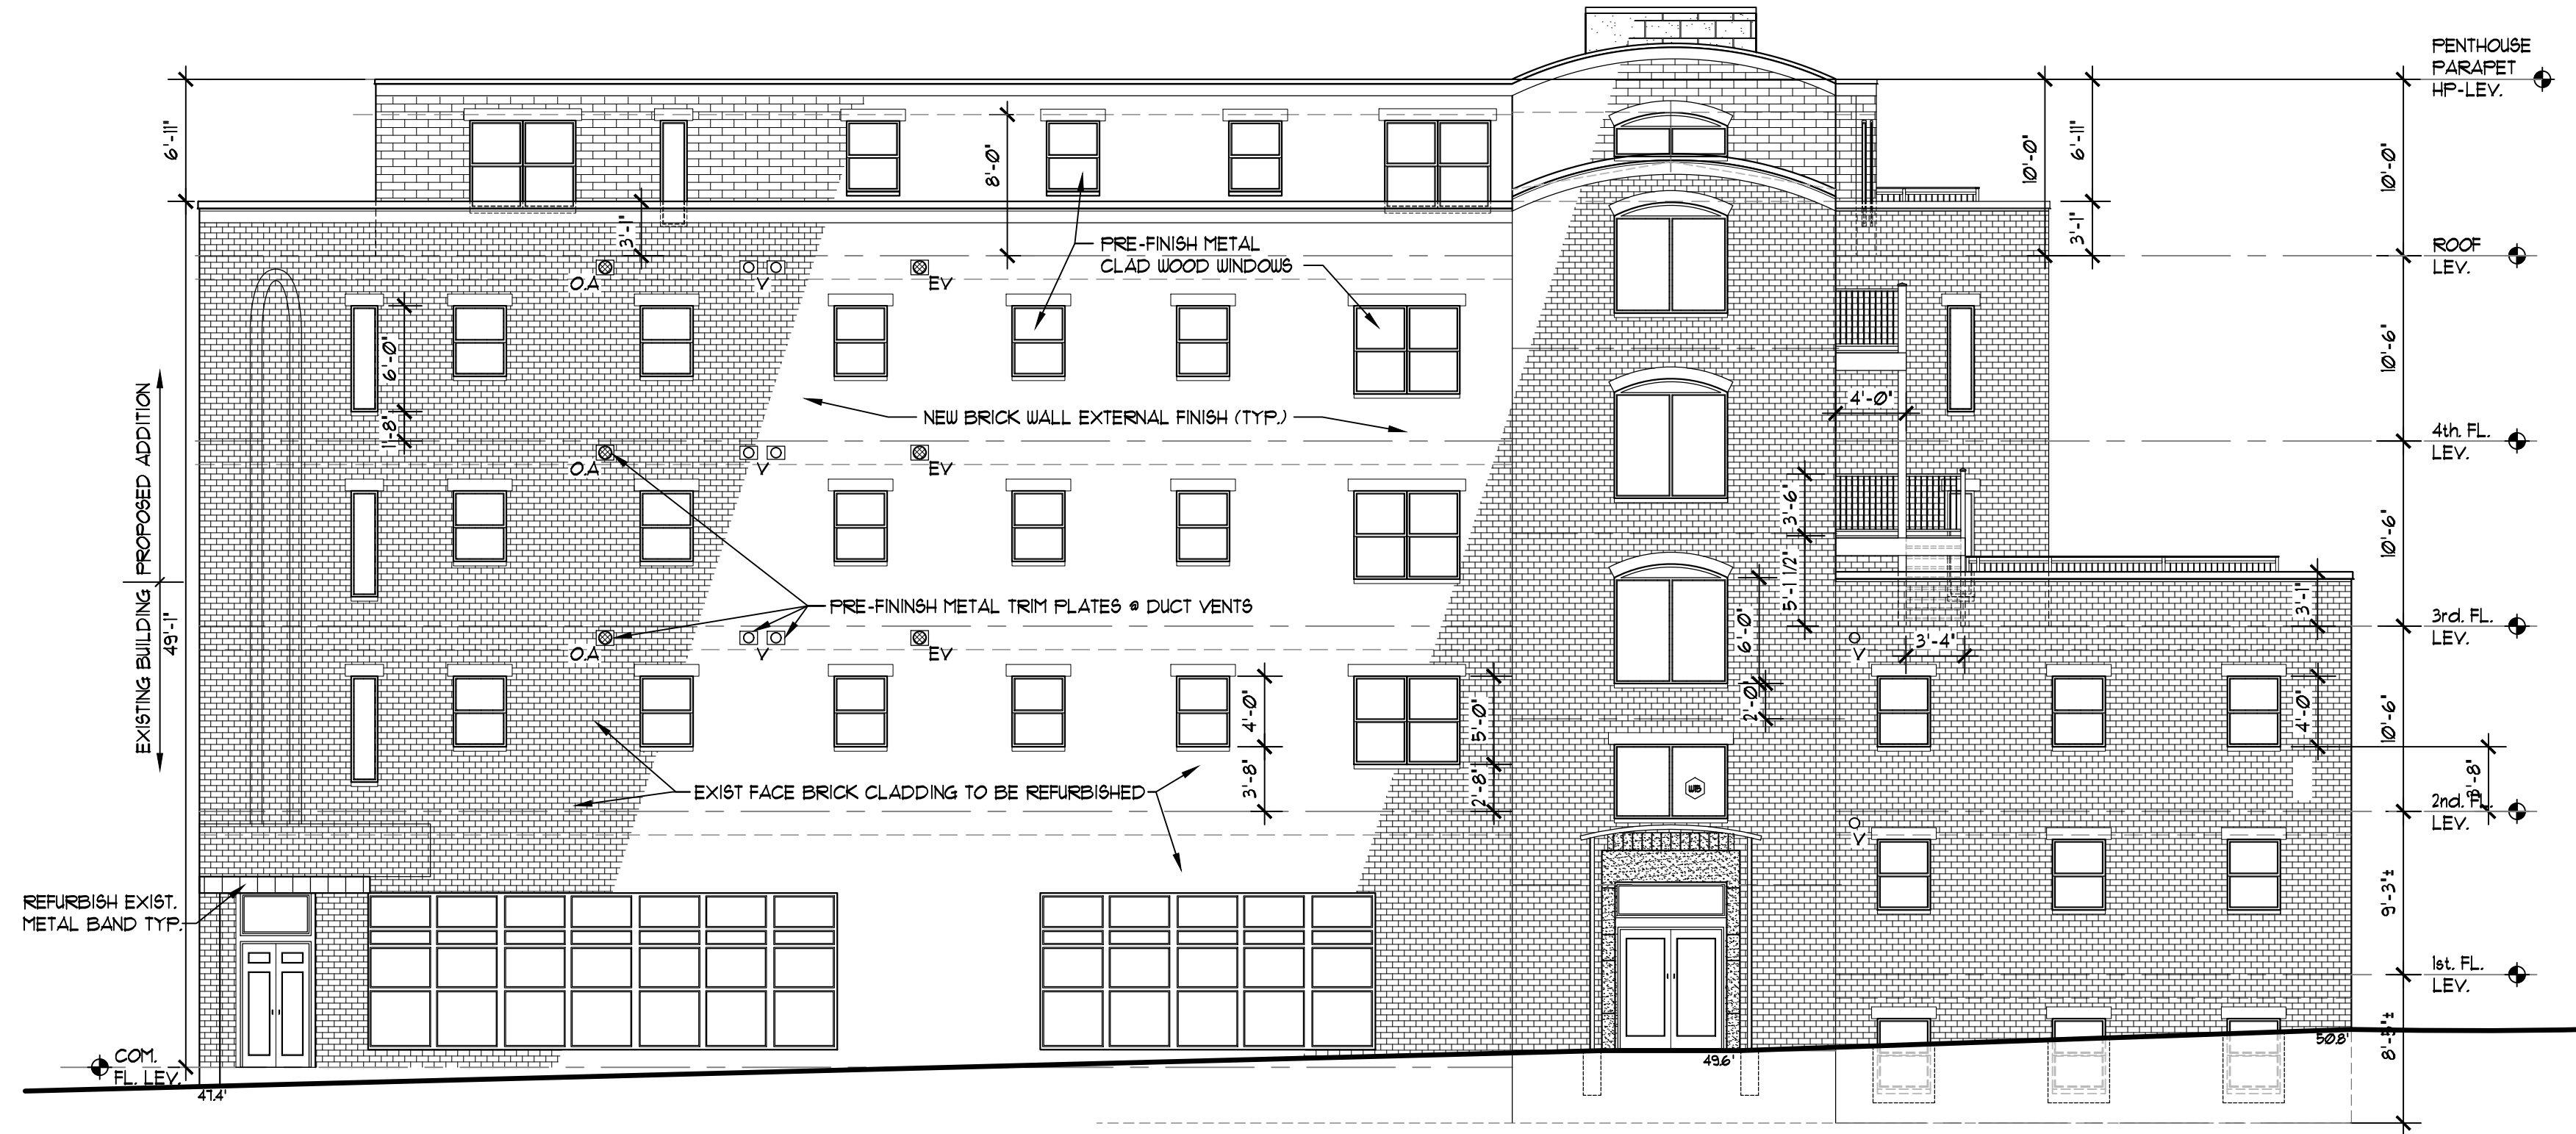

② FIFTEEN STREET SE PROPOSED ELEVATION
SCALE: 1/4" = 1'-0"



③ ALLEY PROPOSED ELEVATION
SCALE: 1/4" = 1'-0"



④ SIDE YARD PROPOSED ELEVATION
SCALE: 1/4" = 1'-0"

©2018 ARCHITECTURAL SOLUTIONS LLC
REPRODUCTION OR RE-USE IN WHOLE
OR IN PART WITHOUT WRITTEN
PERMISSION IS FORBIDDEN.
I CERTIFY THAT THESE DOCUMENTS WERE
PREPARED OR APPROVED BY ME & THAT I AM A
DULY LICENSED ARCHITECT UNDER THE LAWS
OF THE DISTRICT OF COLUMBIA LICENSE
ARCHS 03-02-2018



DATE

01-12-2019

REVISIONS DESCRIPTION
Revisions to Comply With Plan Reviewer's Comments.

NO.

1

2

3

265