




CLIENT:

CoreSite
12100 Sunrise Valley Drive
Reston, VA 20191
T 571.512.7136

PROJECT TEAM:

NORR
1617 John F. Kennedy Blvd., Ste 1600
Philadelphia, PA 19103
215.525.4549
www.NORR.com

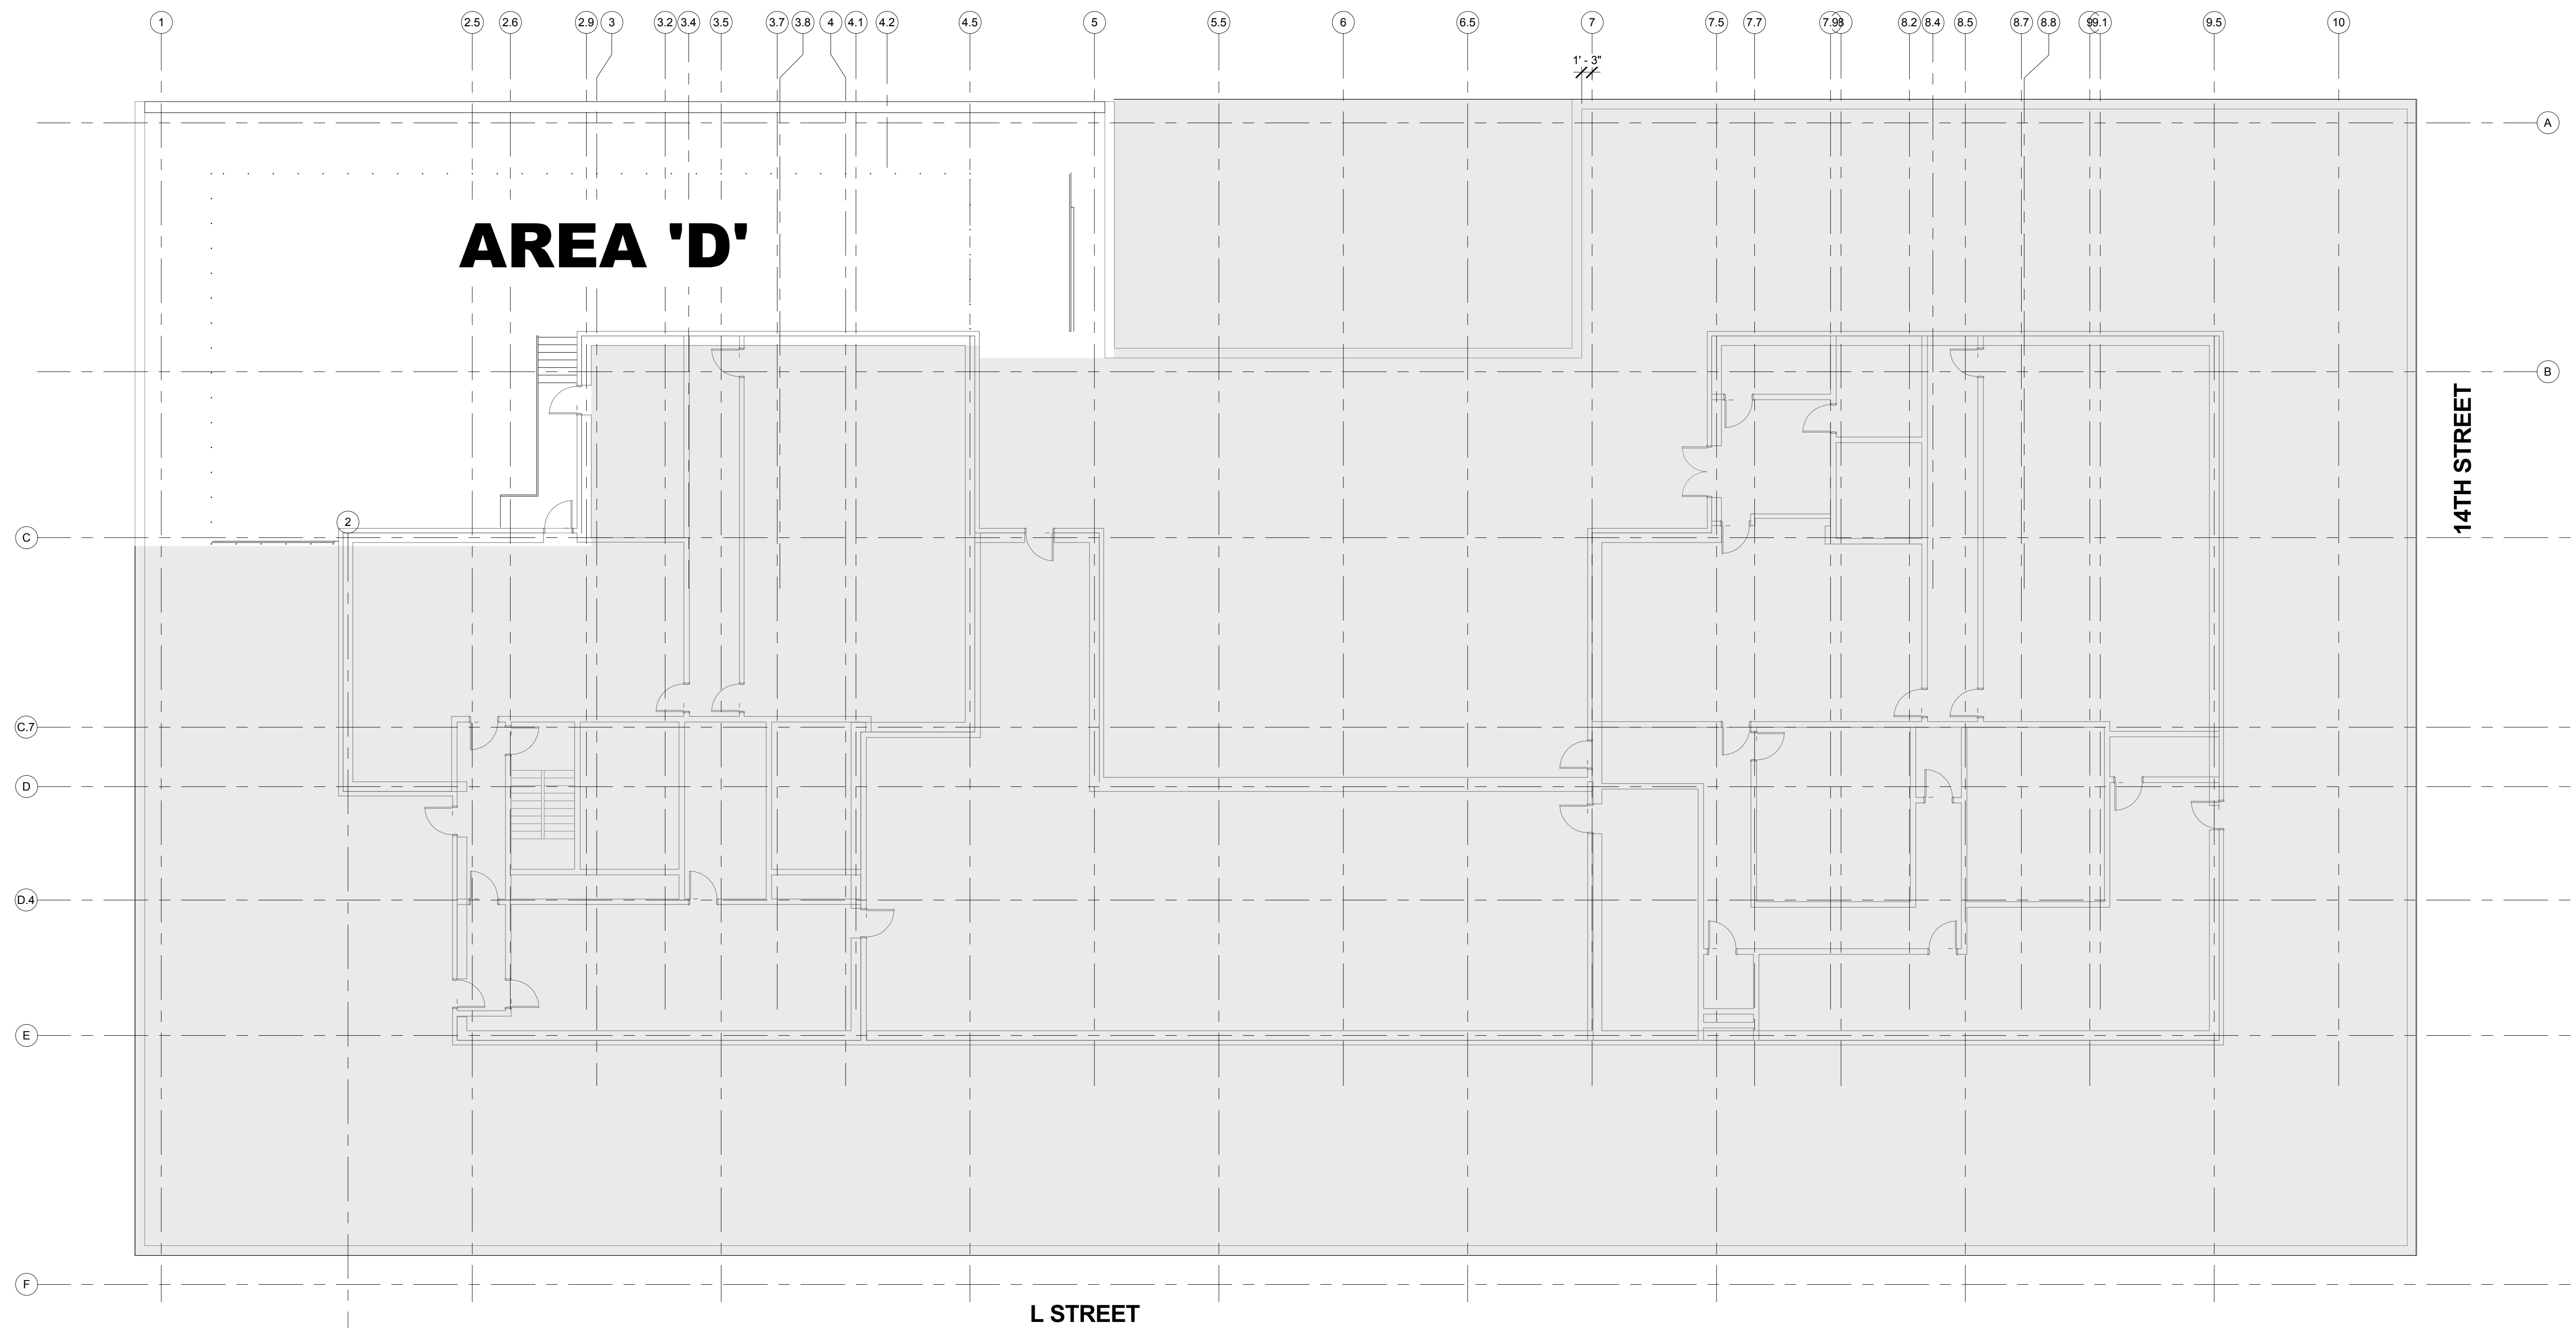

CORESITE - DC2

FRANKLIN COURT BUILDING
1098 14TH STREET NW
WASHINGTON DC 20005
CoreSite



NO.	DATE	DESCRIPTION
1	2017-04-17	ISSUE FOR CLIENT REVIEW (C/F) (W)
2	2017-05-05	ISSUE FOR OWNER AND LANDLORD REVIEW (C/F) (W)
3	2017-05-05	PEER REVIEW (C/F) (W)
4	2017-05-20	REVISED FOR PERMIT (C/F) (W)
5	2017-06-11	ISSUED FOR PERMIT (C/F) (W)

PROJECT NUMBER: 16033900
Copyright © by NORR Design LLC. All Rights Reserved.

SHEET TITLE: ROOF KEY PLAN

SHEET NUMBER: A006

A1 ROOF/MECH LEVEL KEY PLAN
3/32" = 1'-0"




CLIENT:
CoreSite
12100 Sunrise Valley Drive
Reston, VA 20191
T 571.612.7136

PROJECT TEAM
NORR
1617 John F. Kennedy Blvd., Ste 1600
Philadelphia, PA 19103
T 215.525.4849
www.NORR.com

CORESITE - DC2

FRANKLIN COURT BUILDING
1088 14TH STREET NW
WASHINGTON DC 20005
CoreSite




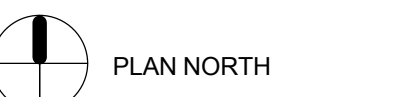


NO.	DATE	DESCRIPTION	PREPARED BY	CHECKED BY	REVISED FOR PERMIT	ISSUED FOR PERMIT	PERMIT REVISIONS
1	2017-04-17	ISSUE FOR CLIENT REVIEW	CMF	NW			
2	2017-06-08	FEEDBACK REVIEW	CMF	NW			
3	2017-07-20	REVISED FOR PERMIT	CMF	NW			
4	2017-08-11	ISSUED FOR PERMIT	CMF	NW			
5	2017-09-27	PERMIT REVISIONS	CMF	NW			

PROJECT NUMBER: 16033900
Copyright © by NORR Design LLC. All Rights Reserved.

SHEET TITLE
ROOF PLAN

SHEET NUMBER
A120

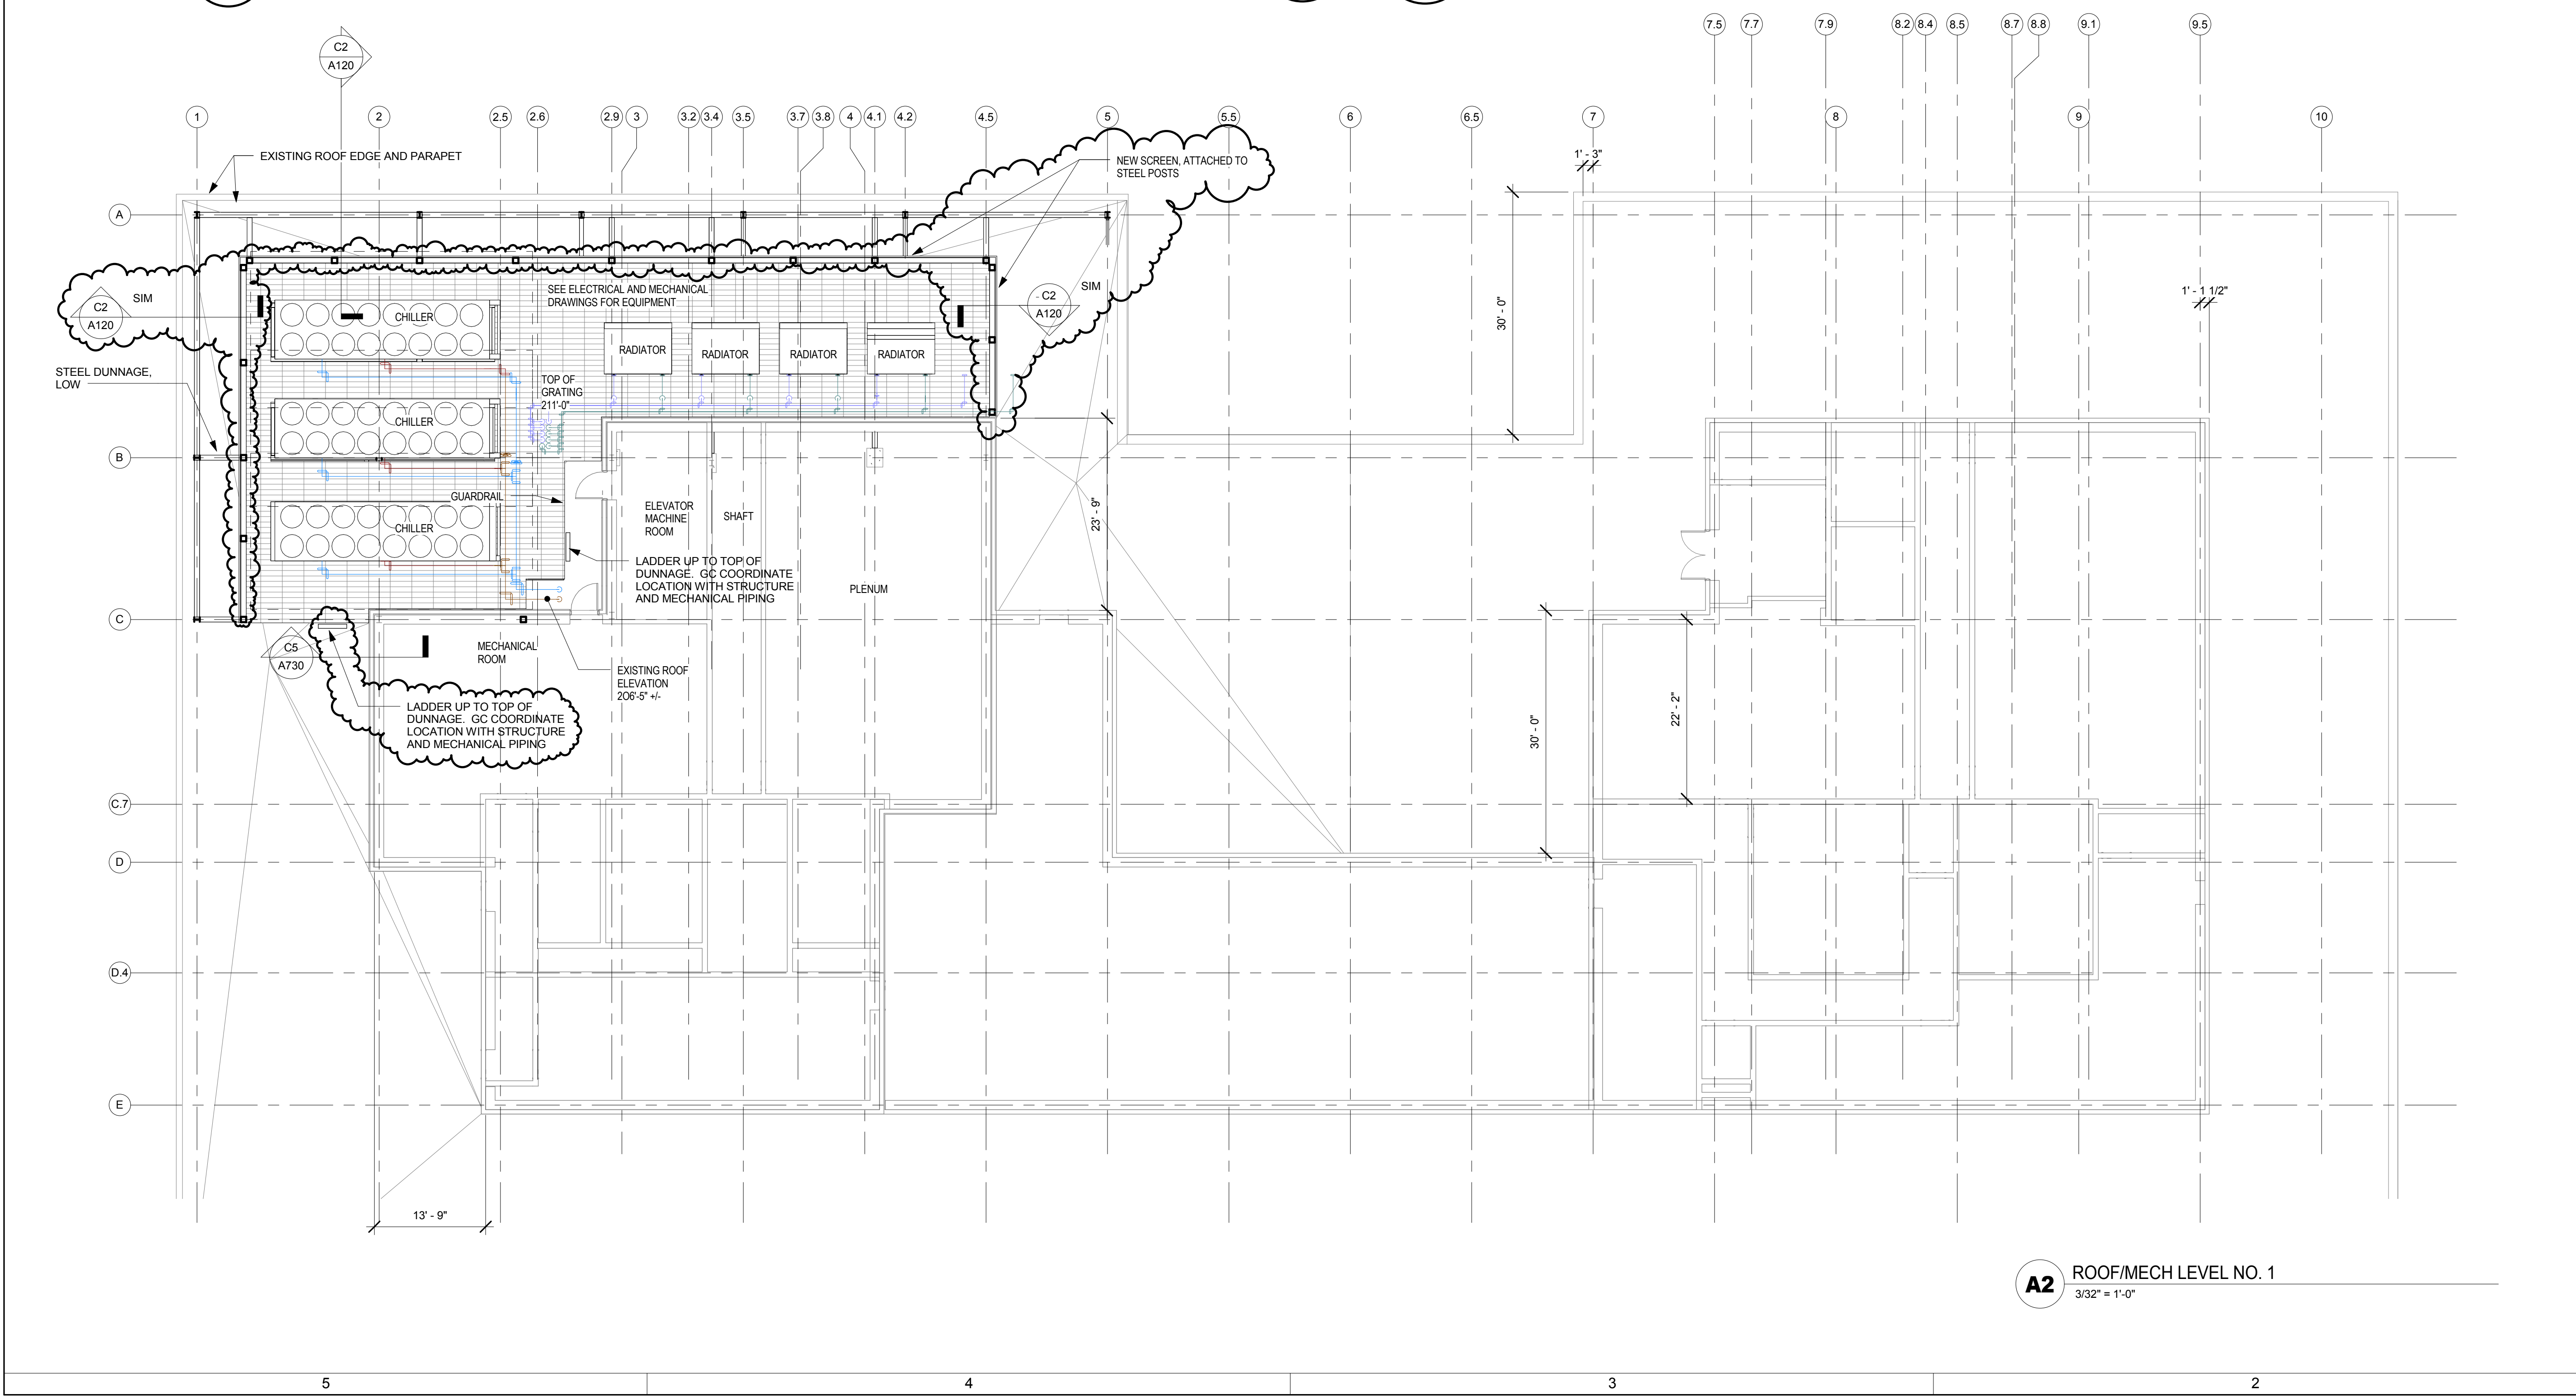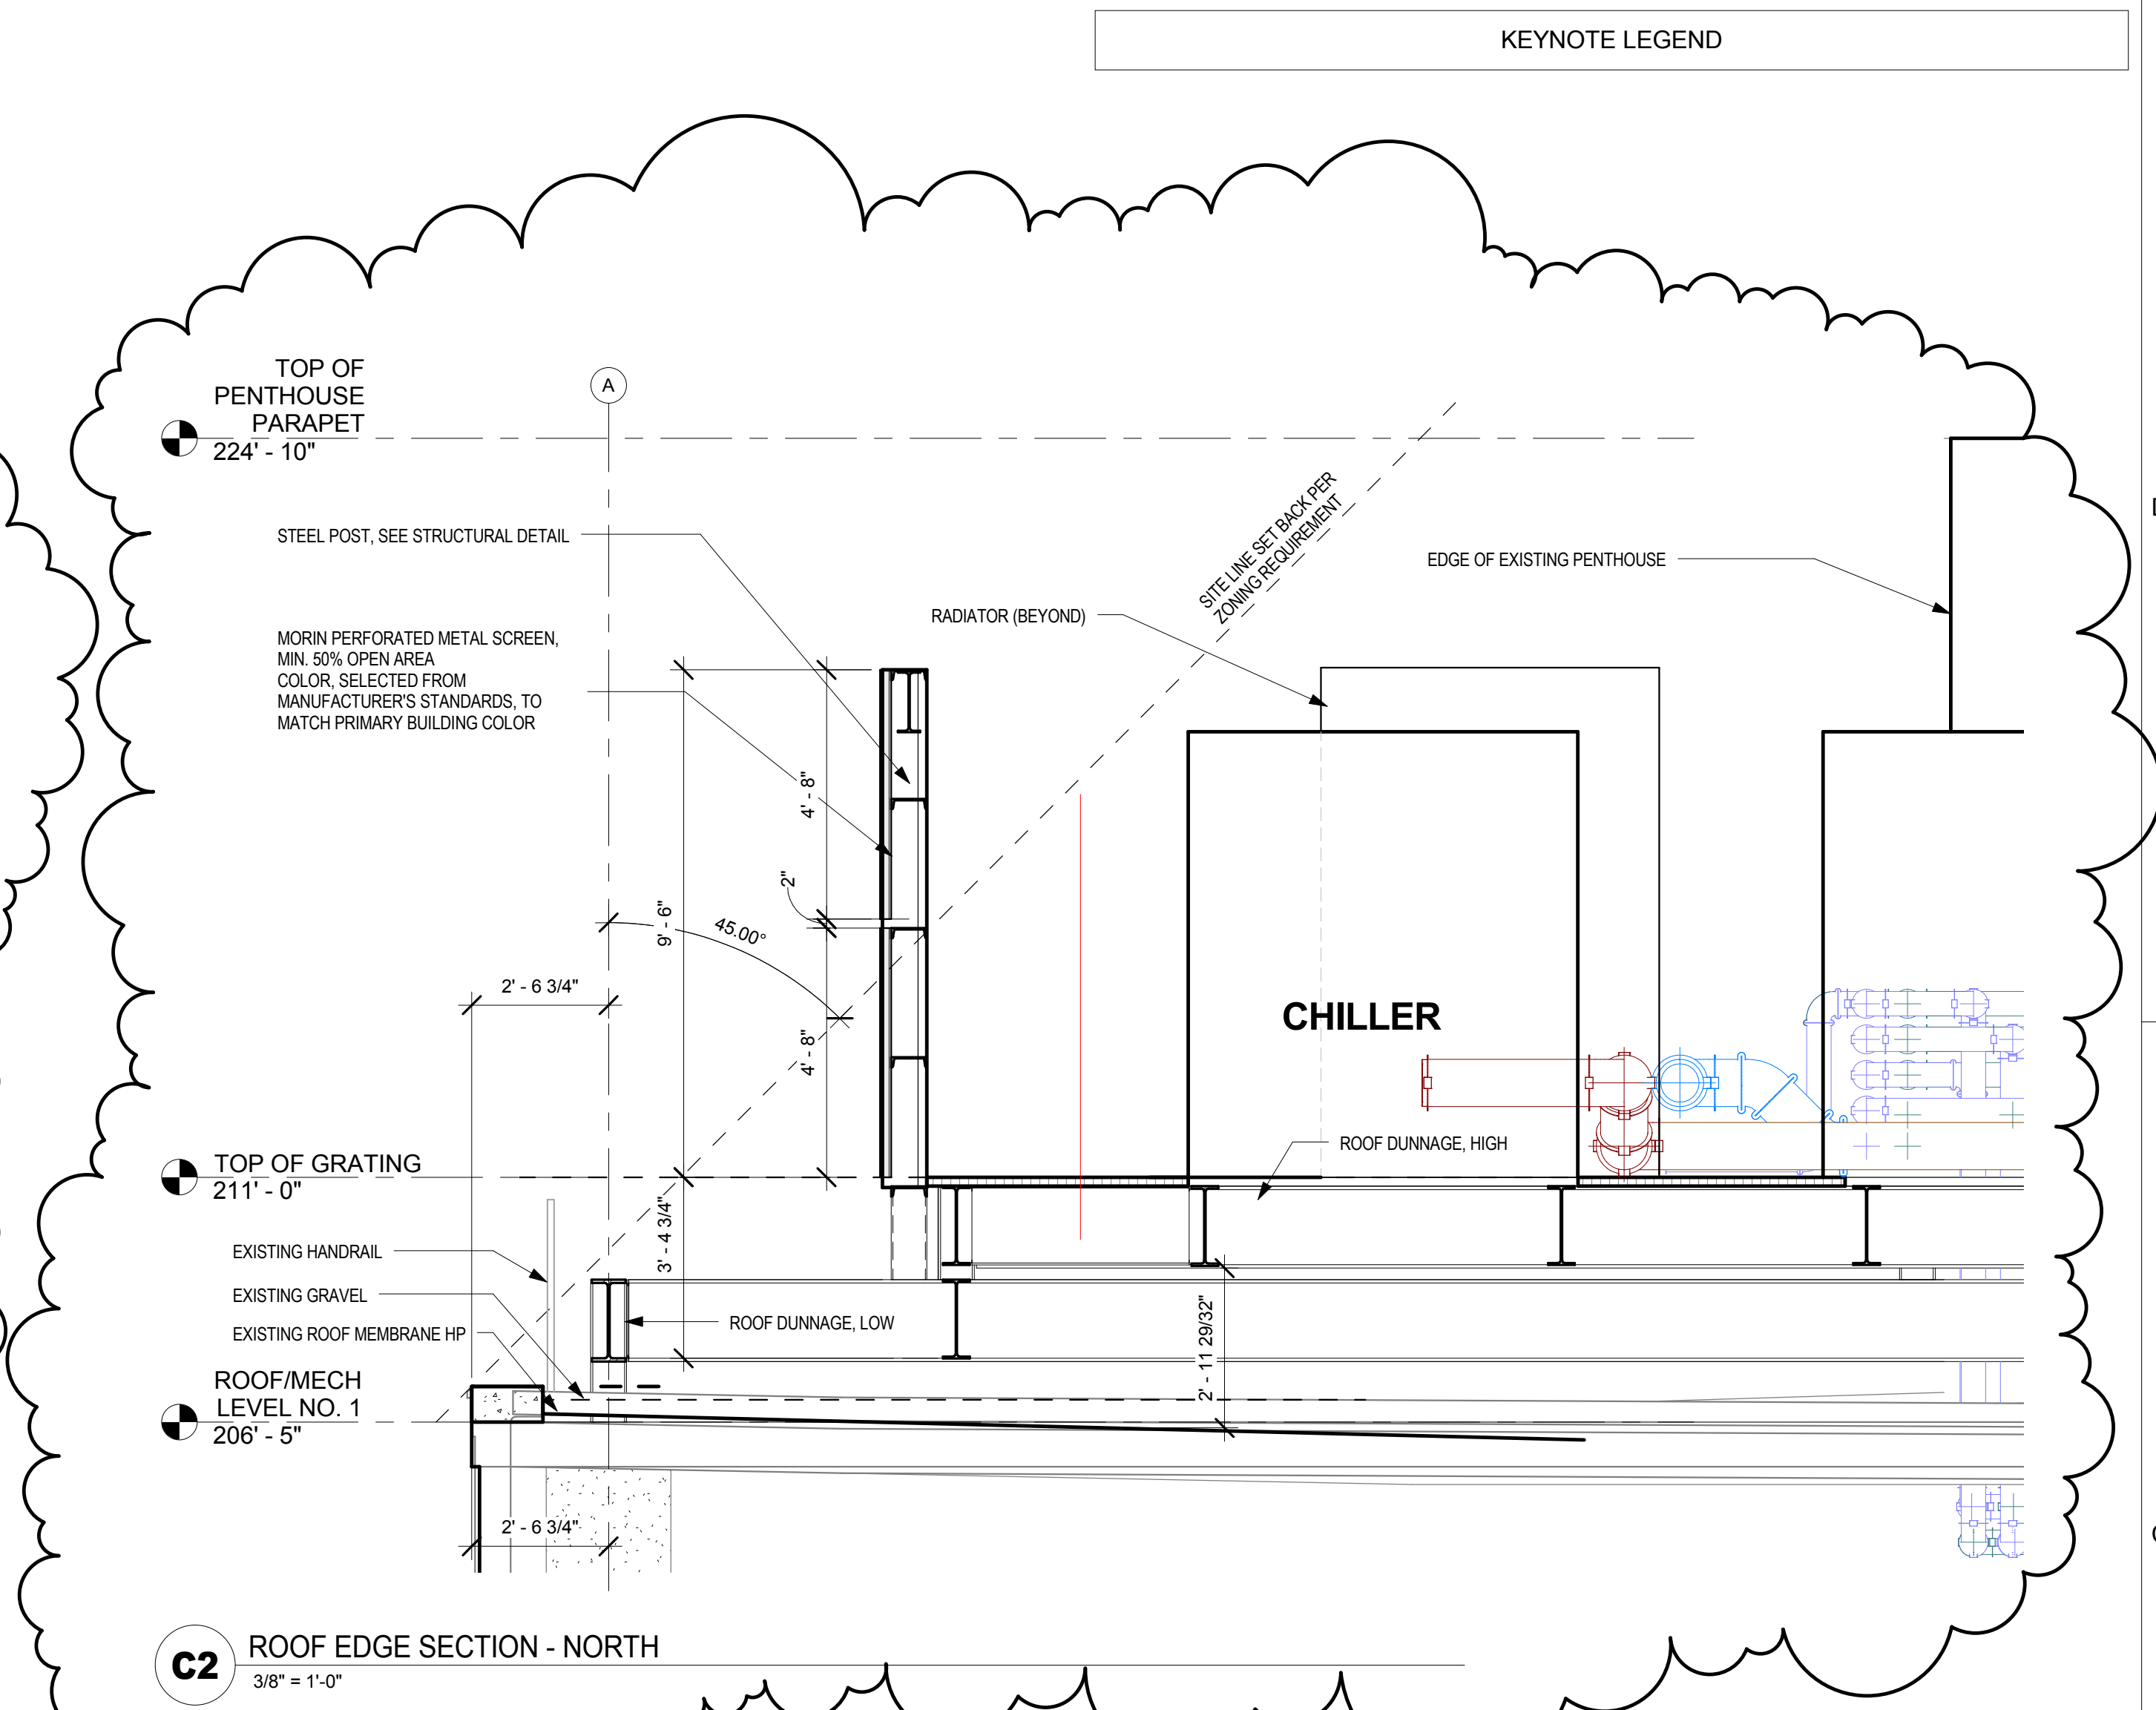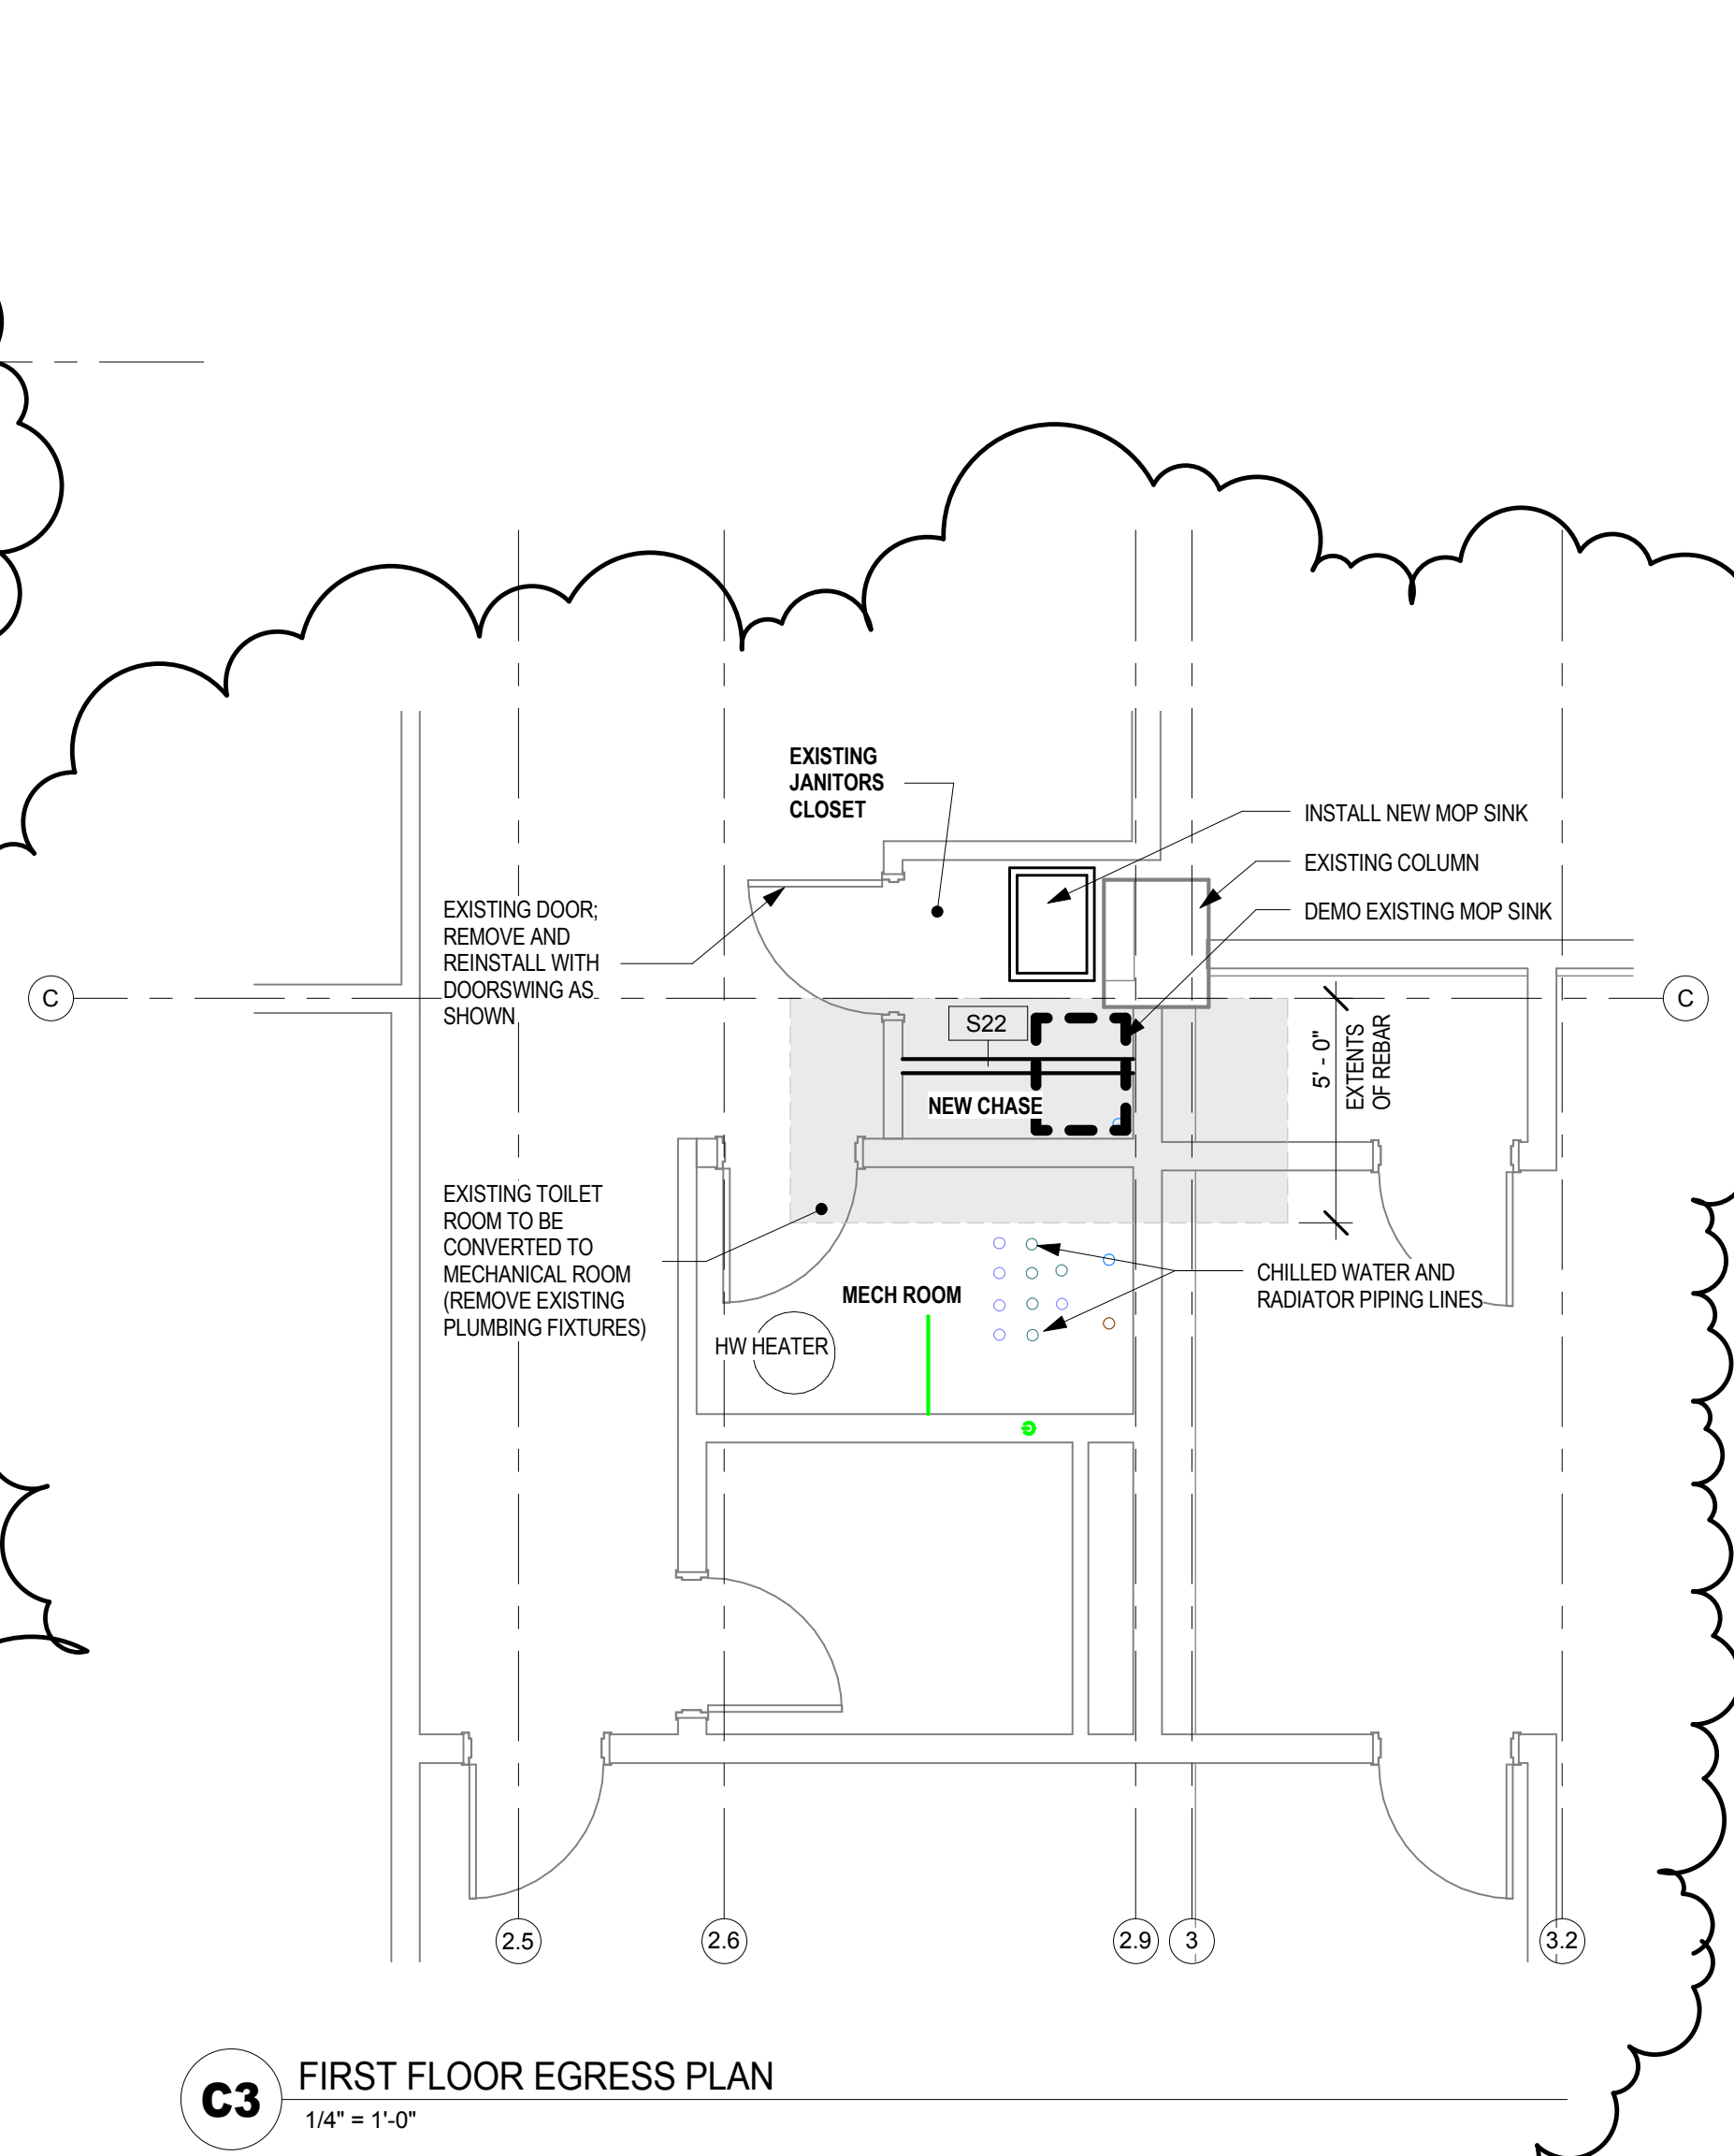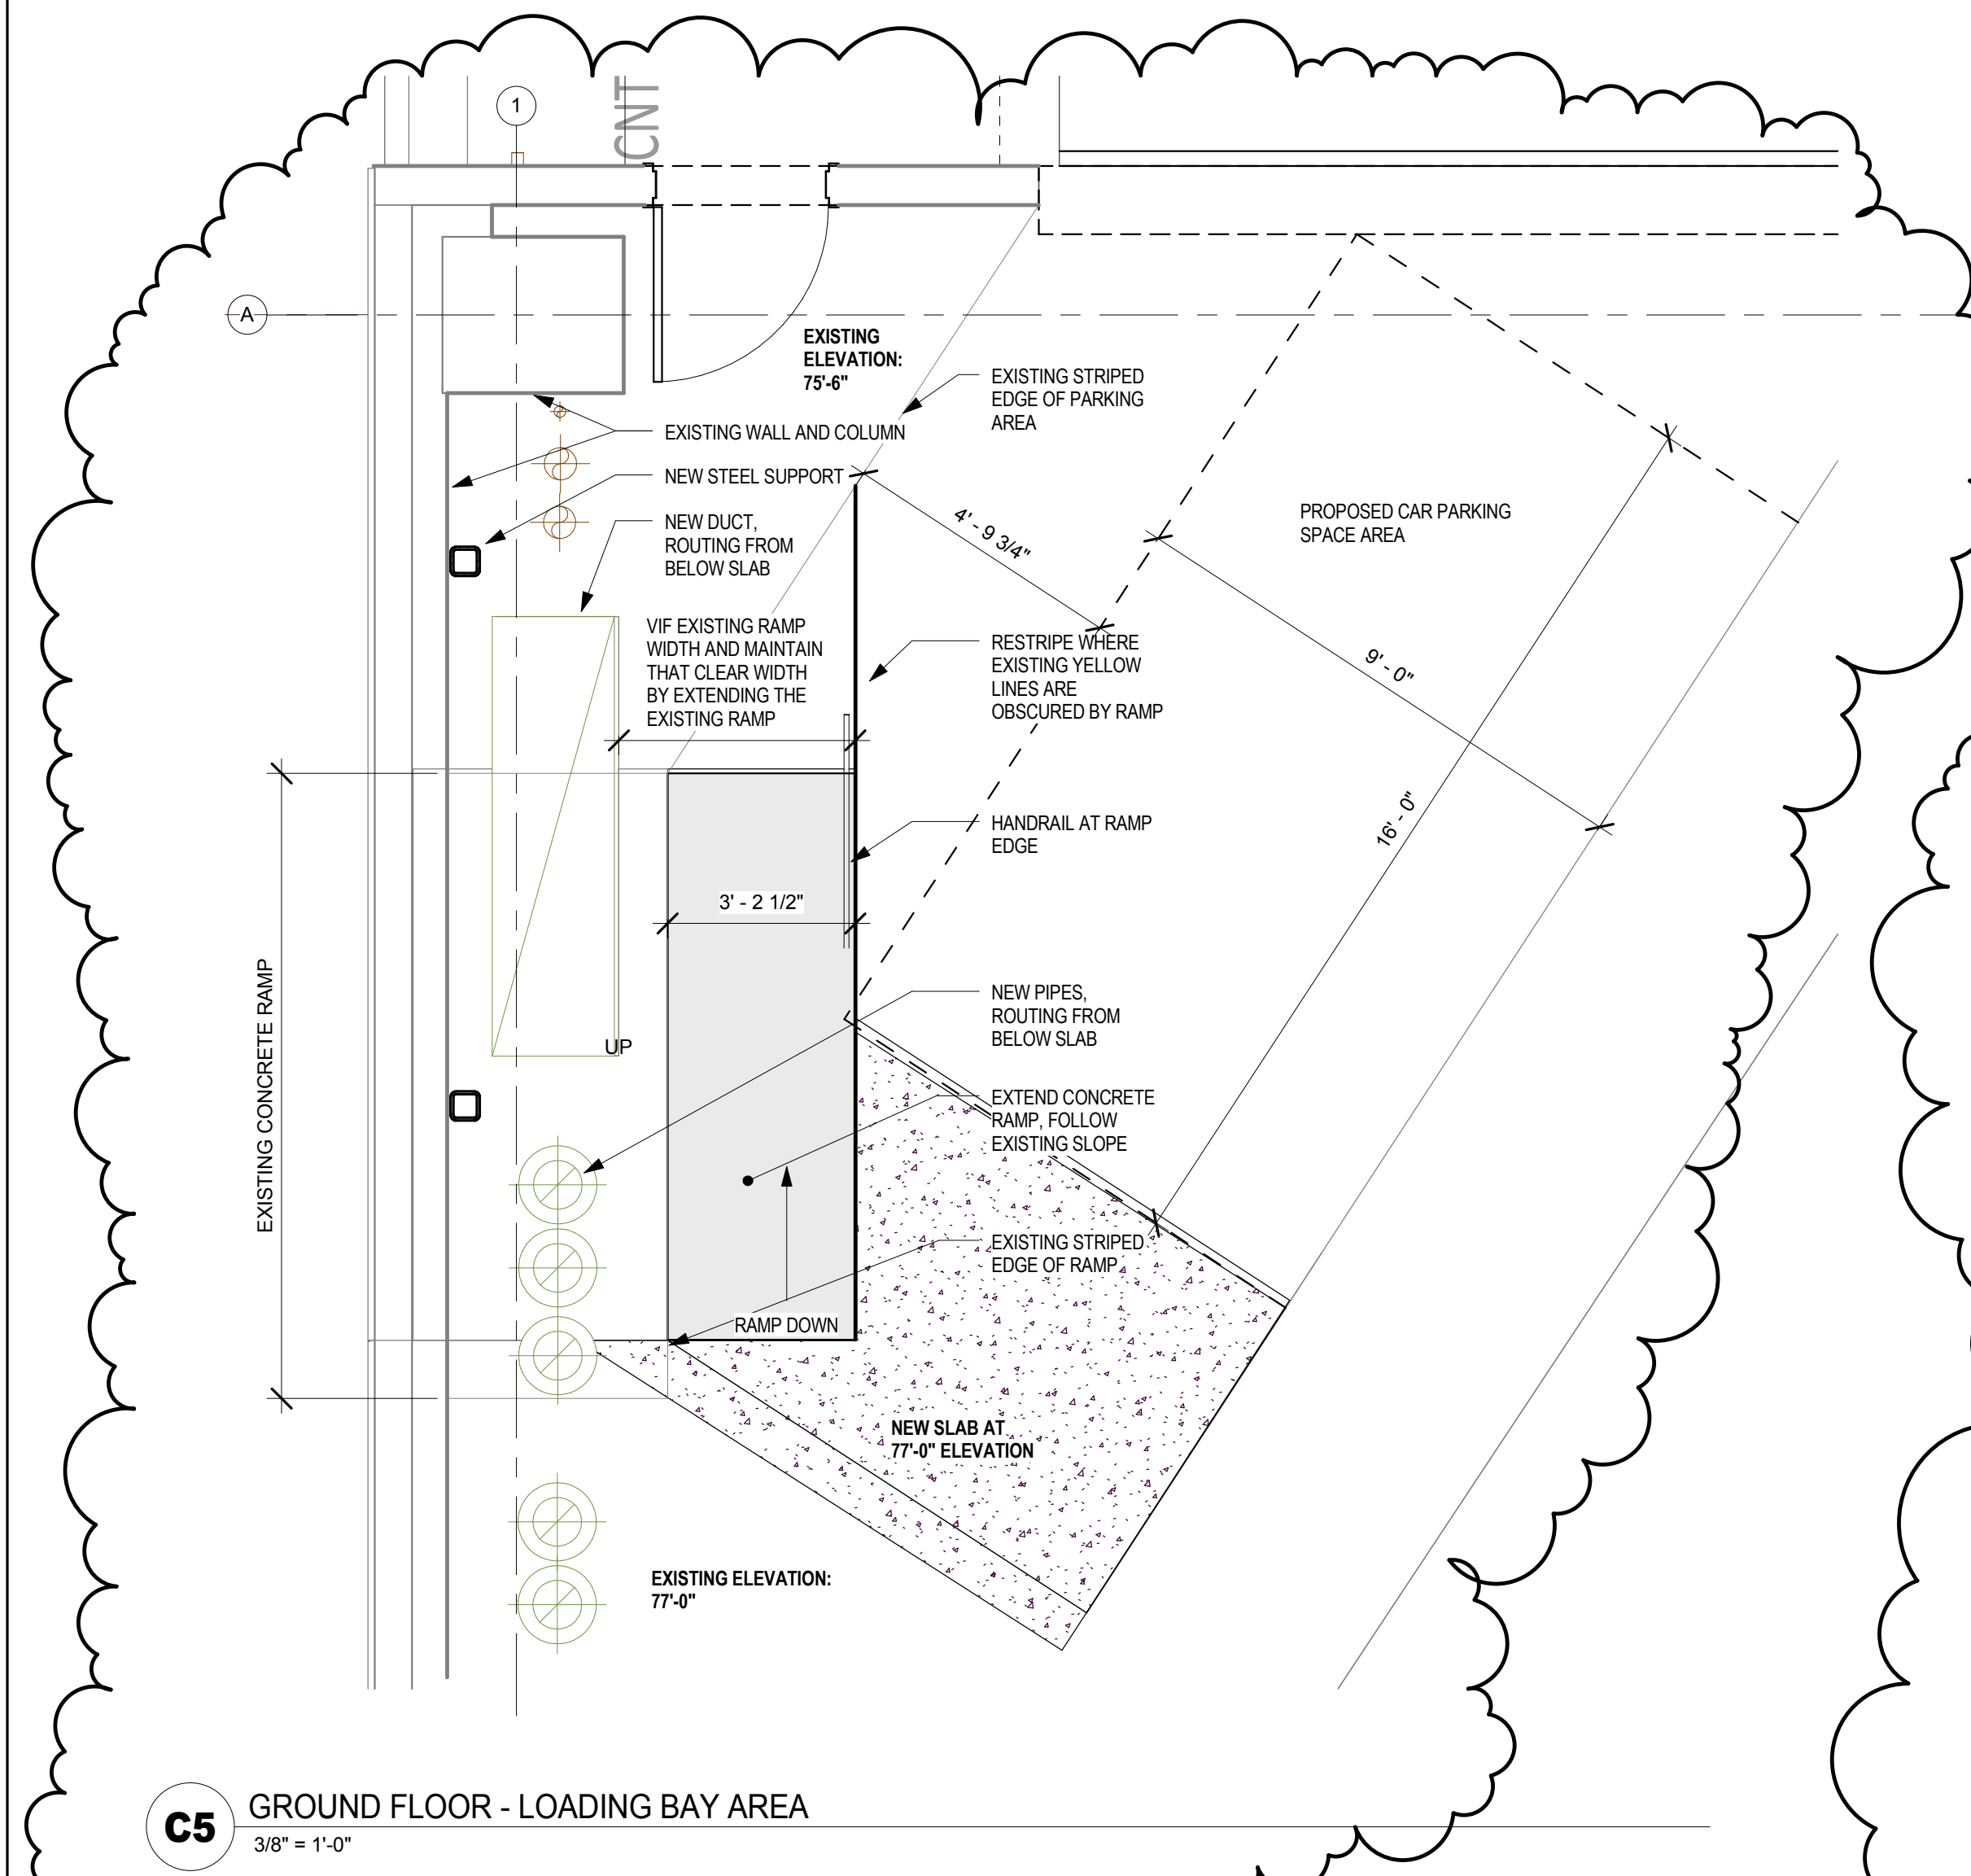


FLOOR PLAN LEGEND

- EXISTING DOOR TO BE REMOVED OR RELOCATED
- EXISTING PARTITION TO BE DEMOLISHED
- EXISTING PARTITION TO REMAIN
- EXISTING DOOR TO REMAIN
- NEW PARTITION. SEE PARTITION TAGS AND TYPES
- NEW 1-HOUR FIRE-RESISTANCE RATED PARTITION. SEE PARTITION TAGS & TYPES
- NEW MULTI-HOUR FIRE-RESISTANCE RATED PARTITION. SEE PARTITION TAGS & TYPES
- NEW SMOKE BARRIER PARTITION. SEE PARTITION TAGS & TYPES
- NEW PARTITION TAG. SEE PARTITION TYPES
- NEW DOOR & DOOR TAG WITH DOOR NUMBER
- NEW GLAZING & GLAZING TAG

ROOM AREA

- ROOM TAG
- NEW FIRE EXTINGUISHER CABINET - SEMI-RECESSED
- NEW MILLWORK
- SHEET NOTE

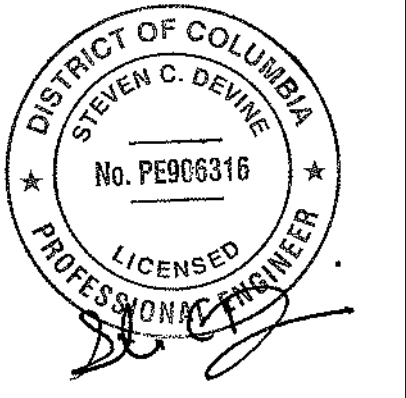

CLIENT:
CORESITE
 12100 Sunrise Valley Drive
 Reston, VA 20191
 T 571.612.7136

PROJECT TEAM
NORR
 1617 John F. Kennedy Blvd., Ste 1600
 Philadelphia, PA 19103
 215.525.4849
 www.enrionetcs.com

CORESITE - DC2


FRANKLIN COURT
 1008 14TH STREET
 WASHINGTON DC 20005
CORESITE

NO.	DATE	DESCRIPTION	PREP'D BY	CHK'D BY
1	2017-05-05	ISSUE FOR CONSTRUCTION AND ORDER REVIEW	KS	EVG
2	2017-06-08	PEER REVIEW	KS	EVG
3	2017-07-13	PEER REVIEW	KS	EVG
4	2017-08-11	ISSUED FOR PERMIT	KS	EVG
5	2017-11-03	AS-BUILT	KS	EVG


PROJECT NUMBER: **16833900**
 Copyright © by NORR Design, Inc. All Rights Reserved.

SHEET TITLE
STRUCTURAL FRAMING DETAILS


SHEET NUMBER
S400

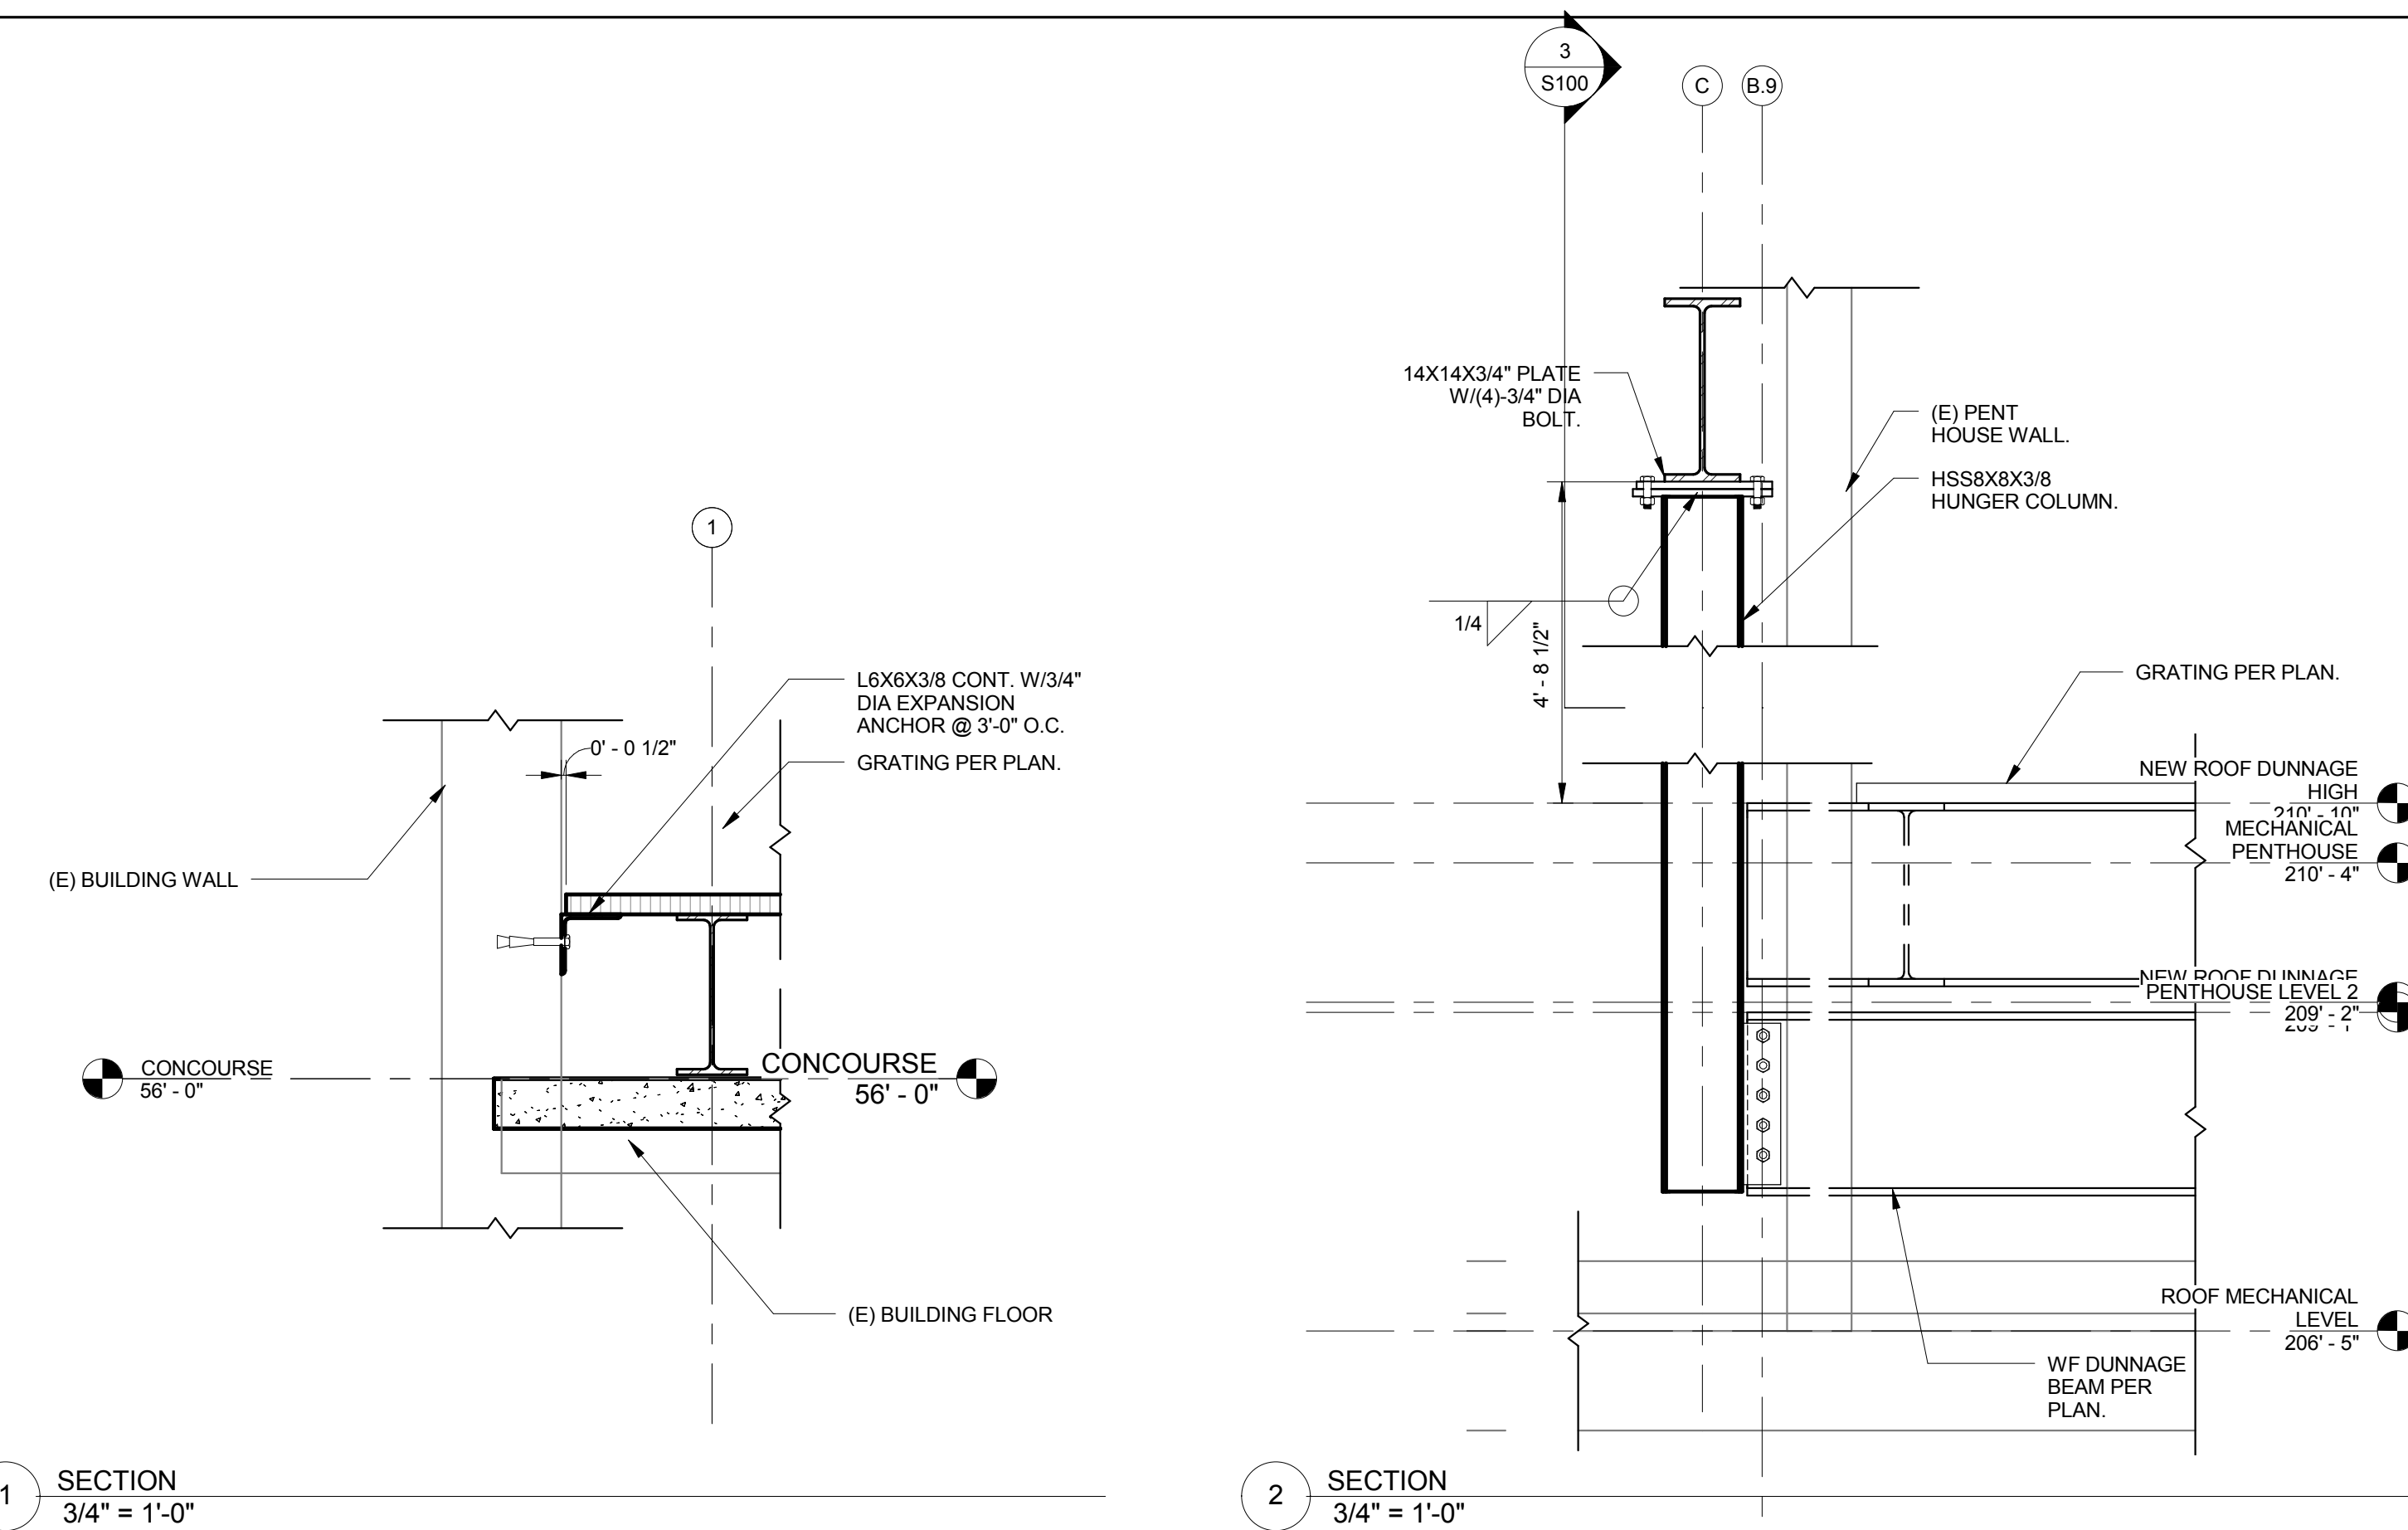

NOTE:
 COLUMN NEEDS SCANNING AT BEAM CONNECTION LOCATION TO AVOID AND COORDINATE LOCATION OF DRILLING FOR BOLT INSTALLATION.

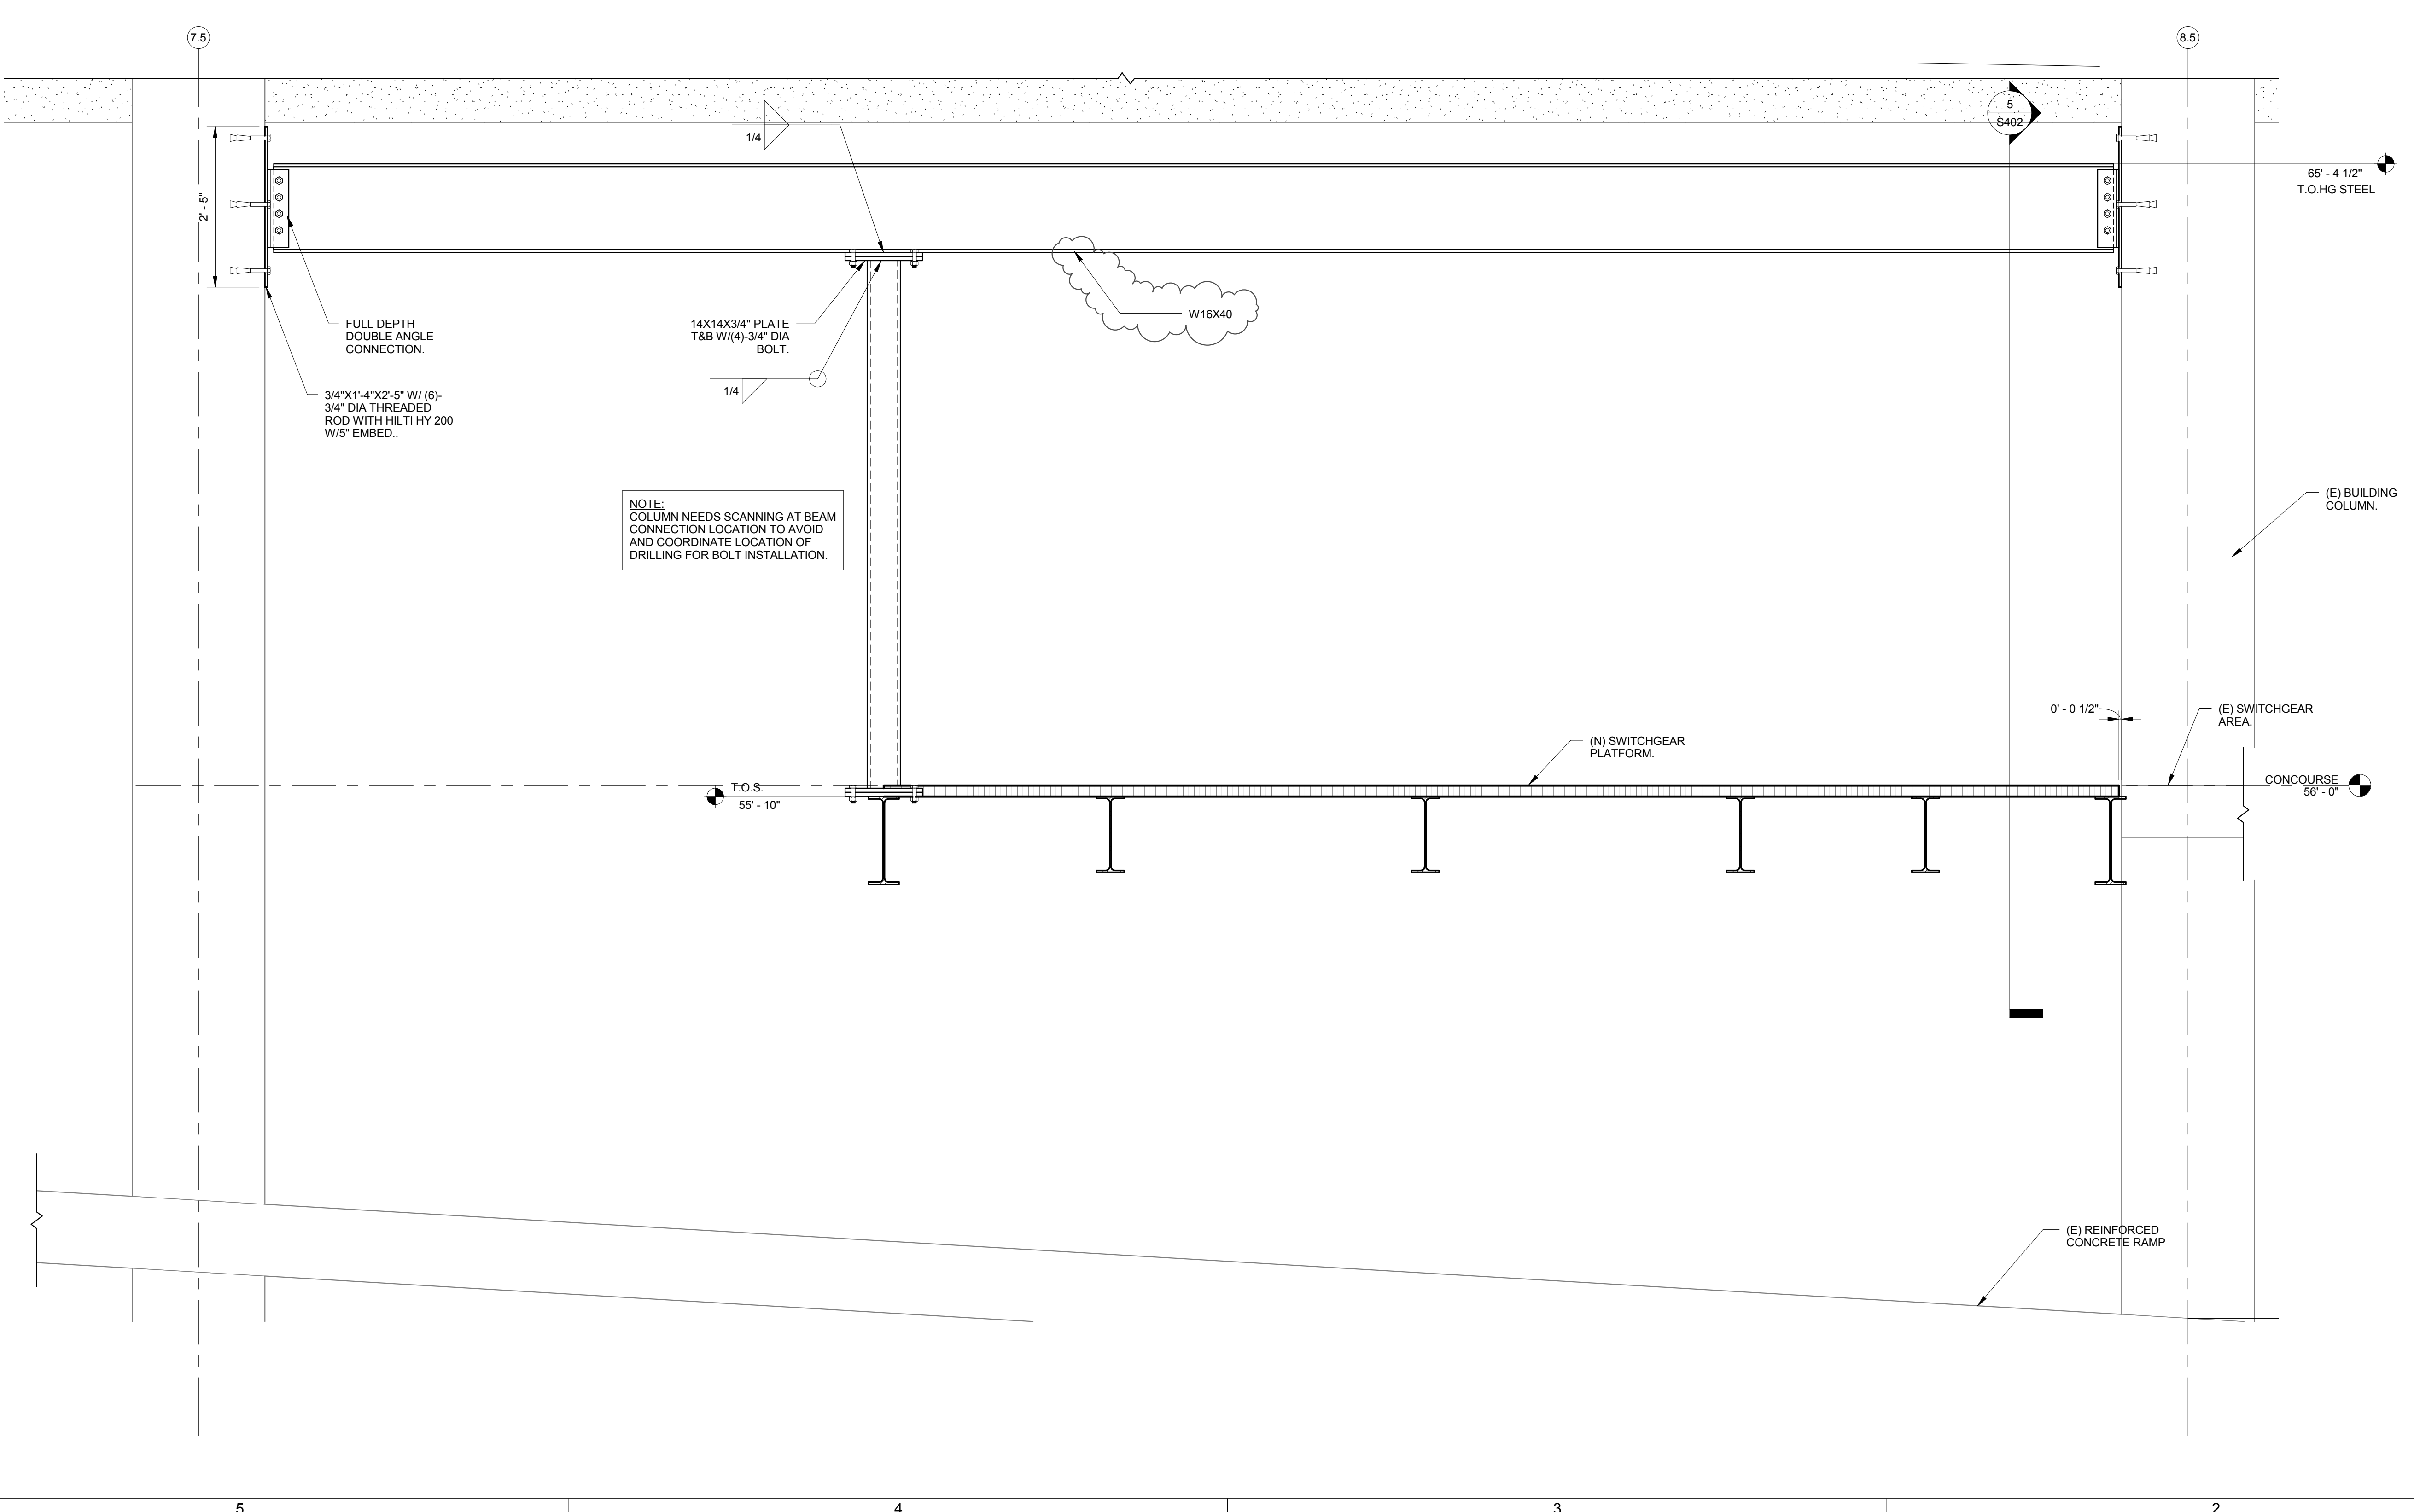

11/3/2017 9:22:49 AM

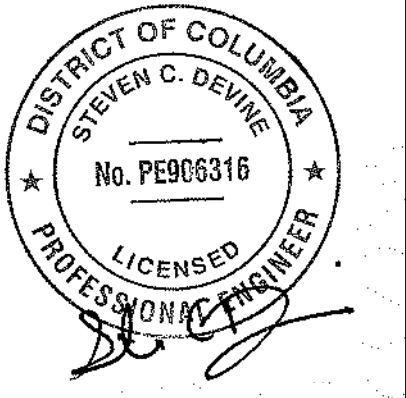

CLIENT:
CORESITE
 12100 Sunrise Valley Drive
 Reston, VA 20191
 T 571.612.7136

PROJECT TEAM
NORR
 1617 John F. Kennedy Blvd., Ste 1600
 Philadelphia, PA 19103
 215.525.4849
 www.enrnetics.com

CORESITE - DC2


FRANKLIN COURT
 1008 14TH STREET
 WASHINGTON DC 20005
CORESITE

NO.	DATE	DESCRIPTION	BY	CHK
1	2017-05-05	ISSUE FOR CONSTRUCTION	KS	EVG
2	2017-06-08	PER REVIEW	KS	EVG
3	2017-07-13	PER REVIEW	KS	EVG
4	2017-08-11	ISSUED FOR PERMIT	KS	EVG
5	2017-05-07	PERMIT REVISION	KS	EVG


PROJECT NUMBER: **1683390**
 Copyright © by NORR Design, Inc. All Rights Reserved.

SHEET TITLE
**STRUCTURAL
 FRAMING CONT.**


SHEET NUMBER
S401

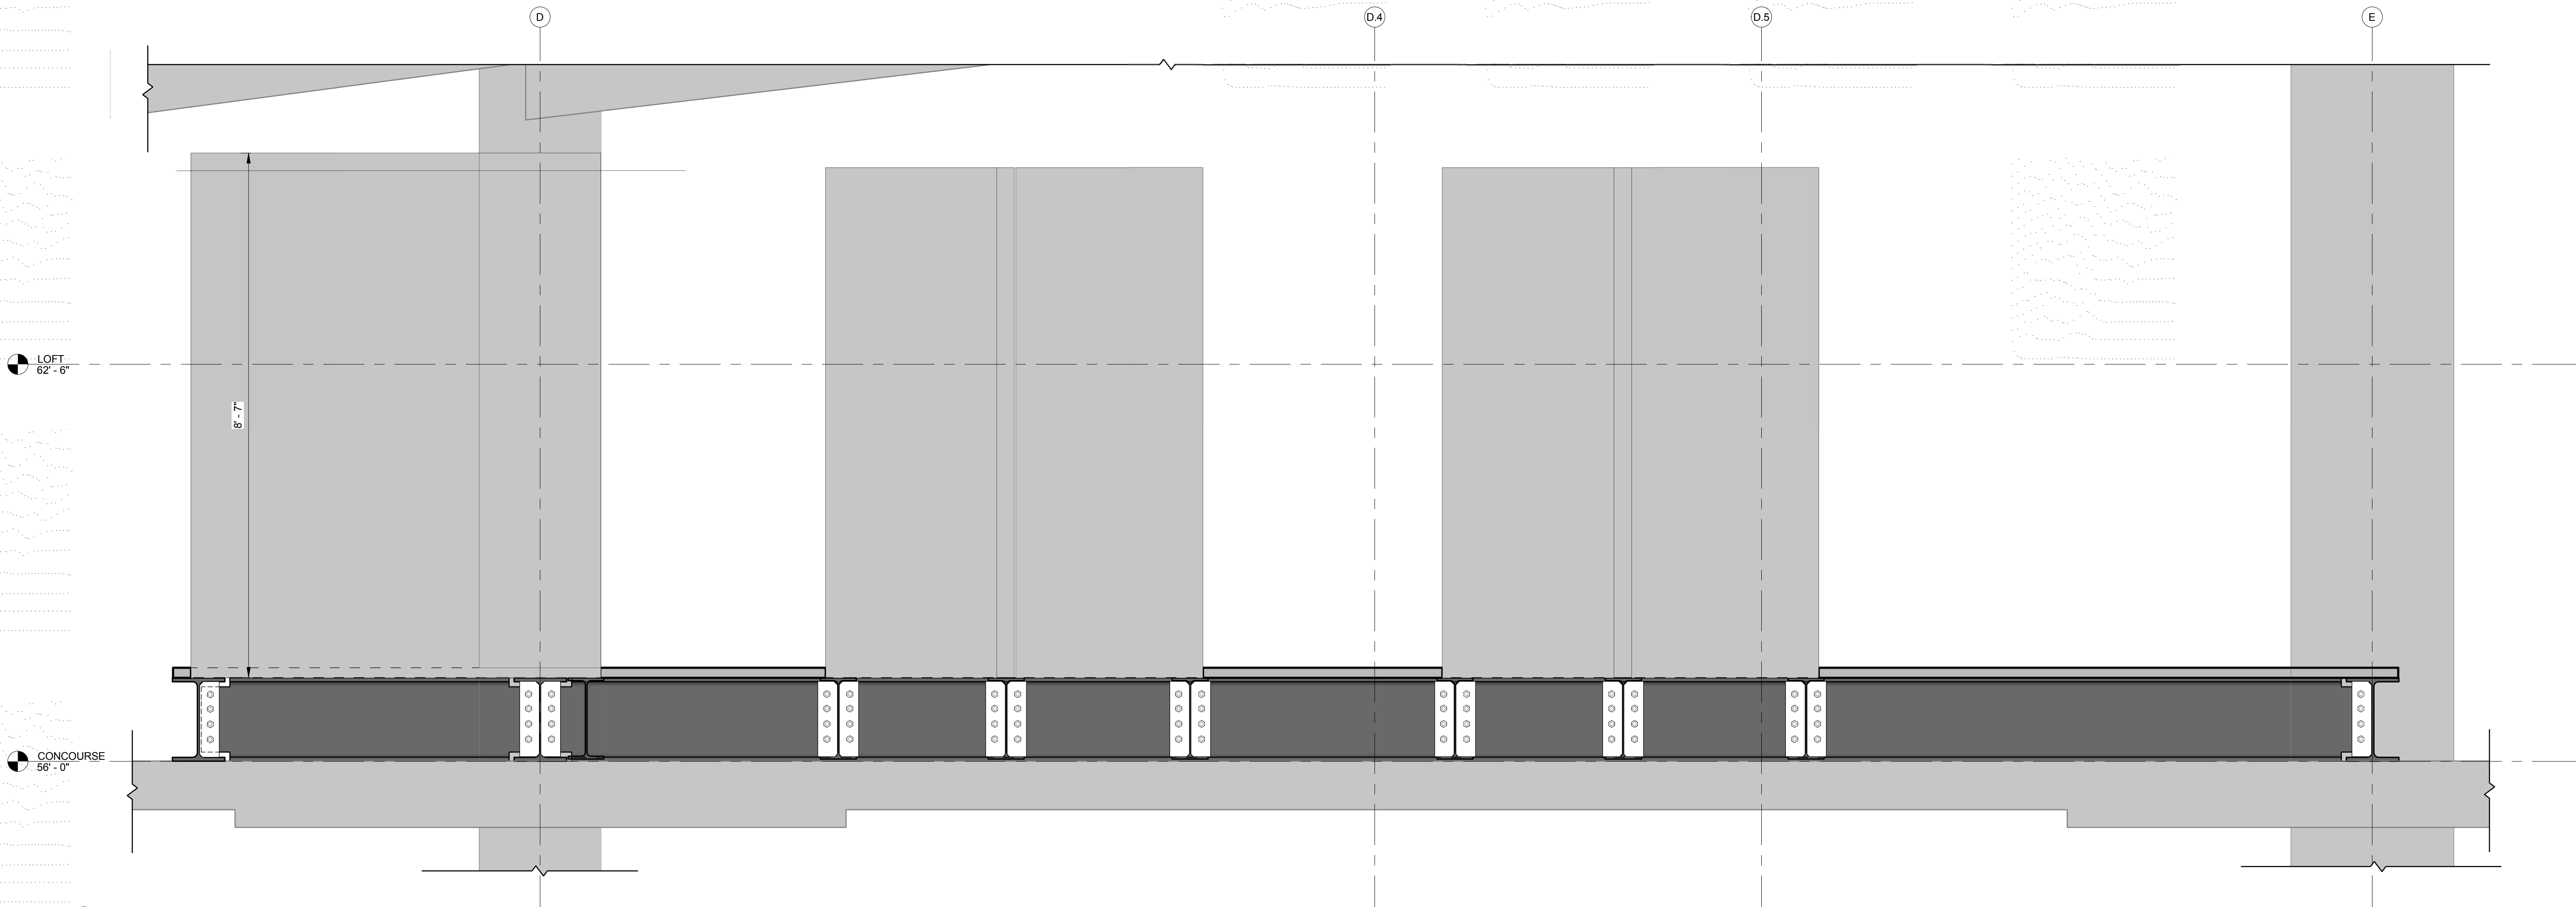


1 SECTION
 3/4" = 1'-0"

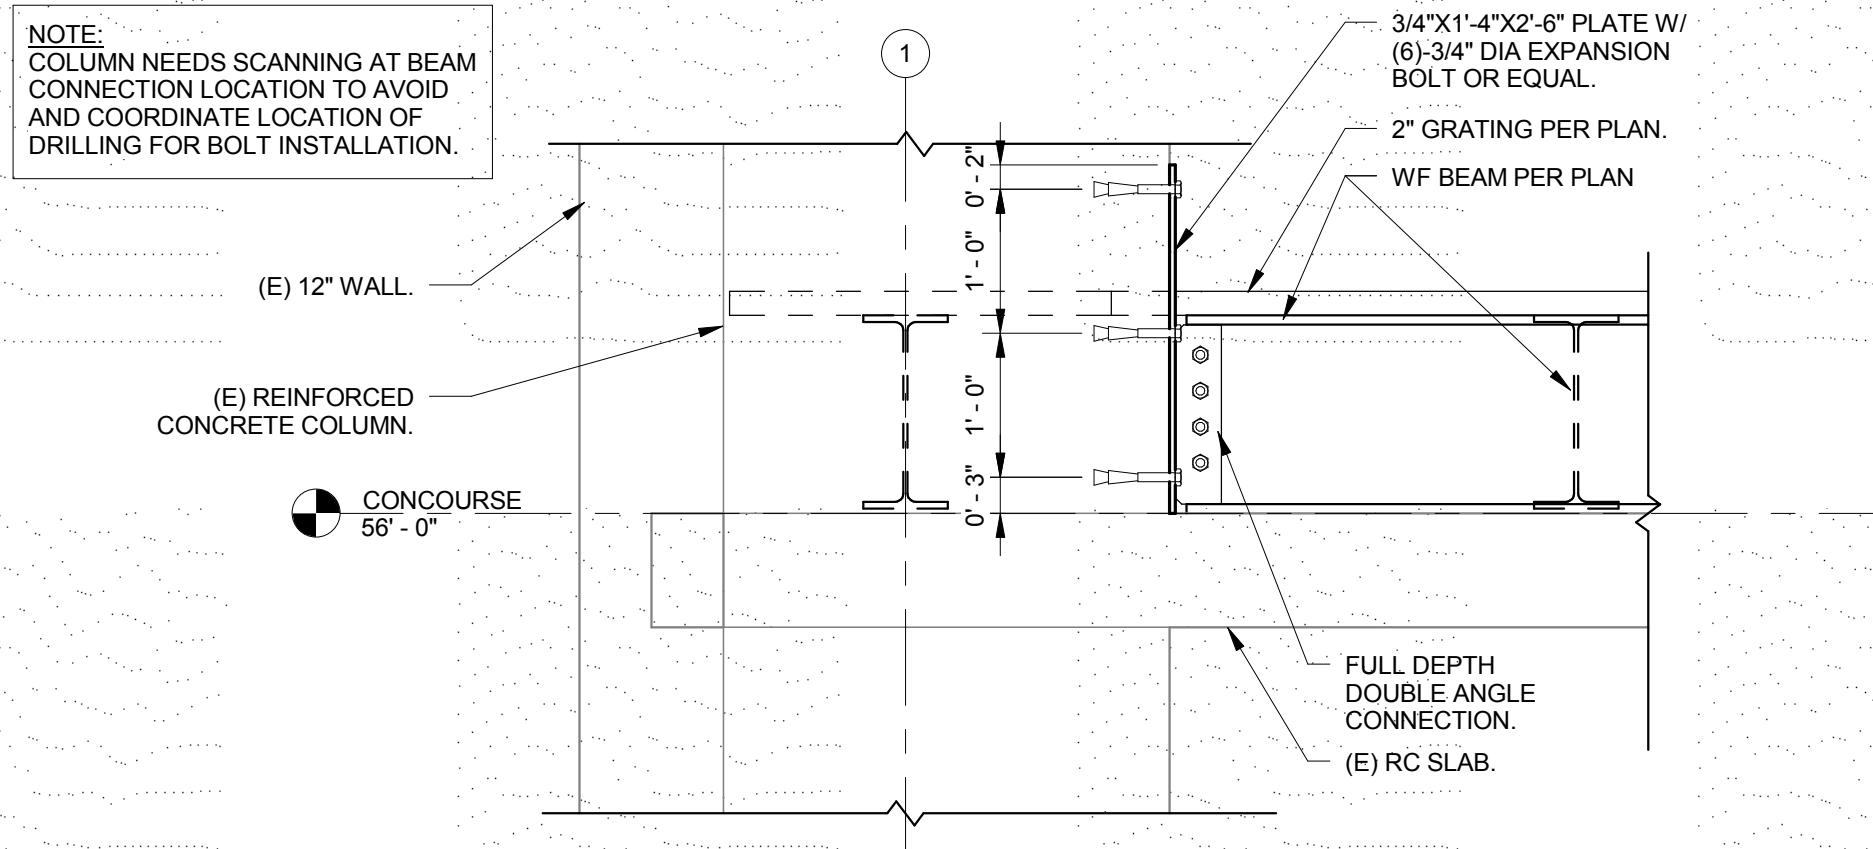


2 SECTION
 3/4" = 1'-0"

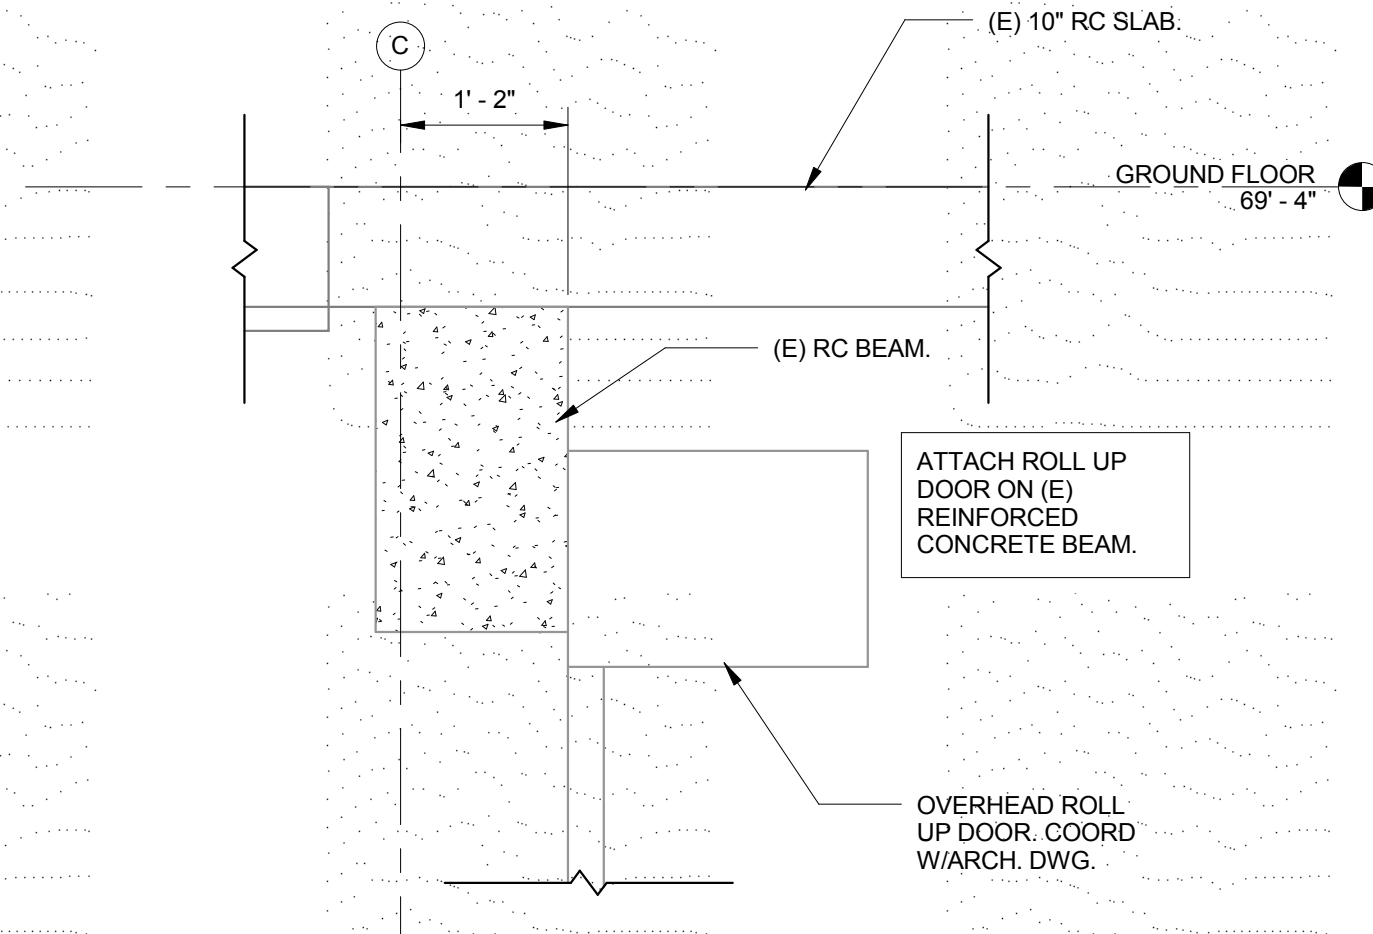


3 SECTION
 3/4" = 1'-0"

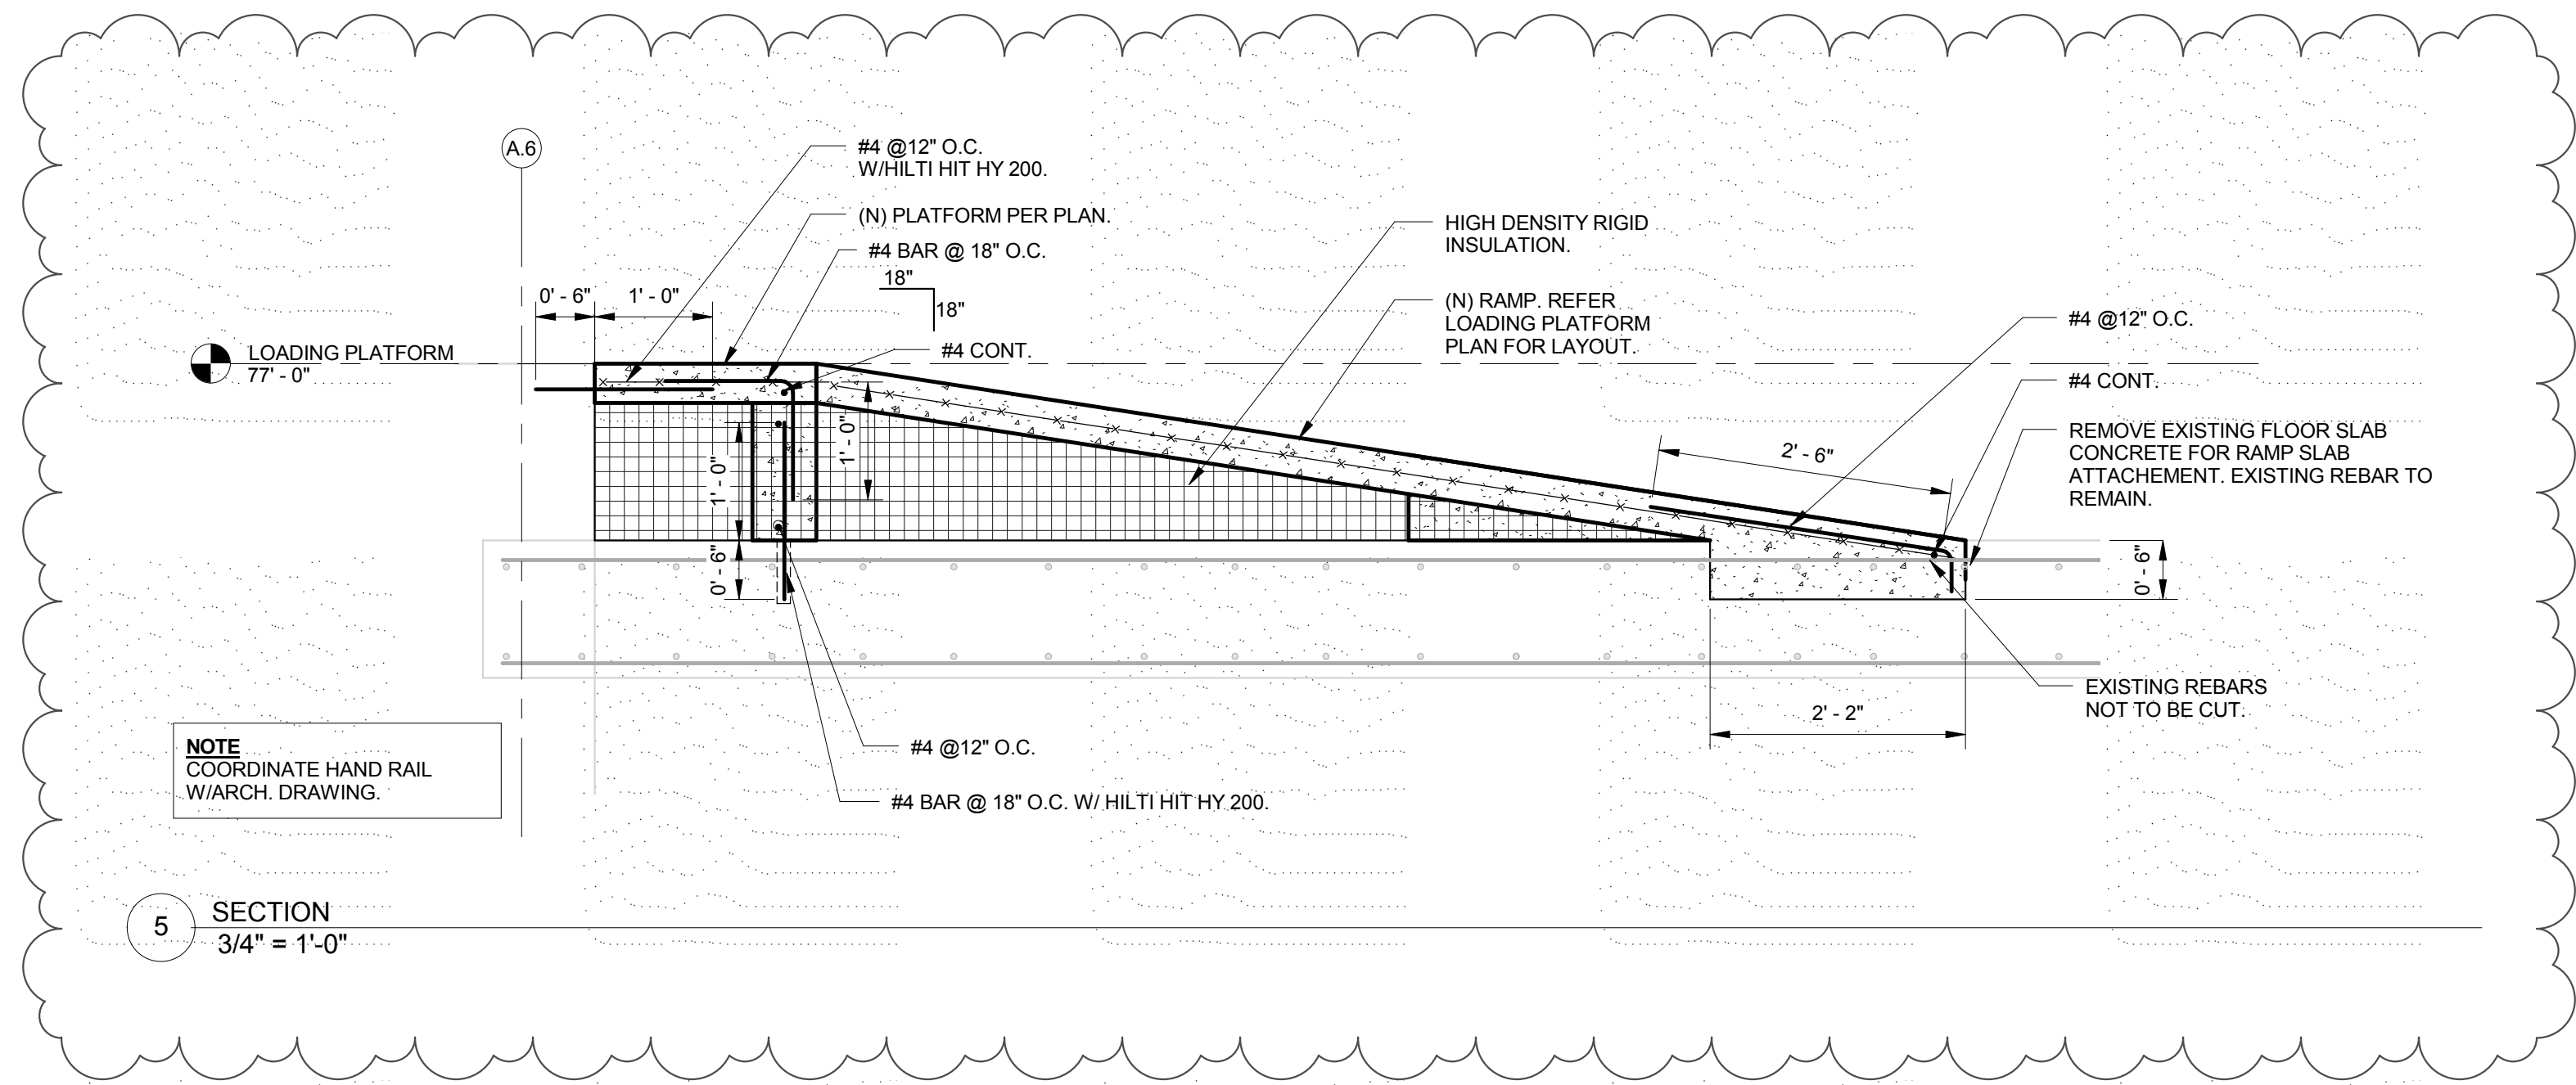

5 SECTION
 3/4" = 1'-0"

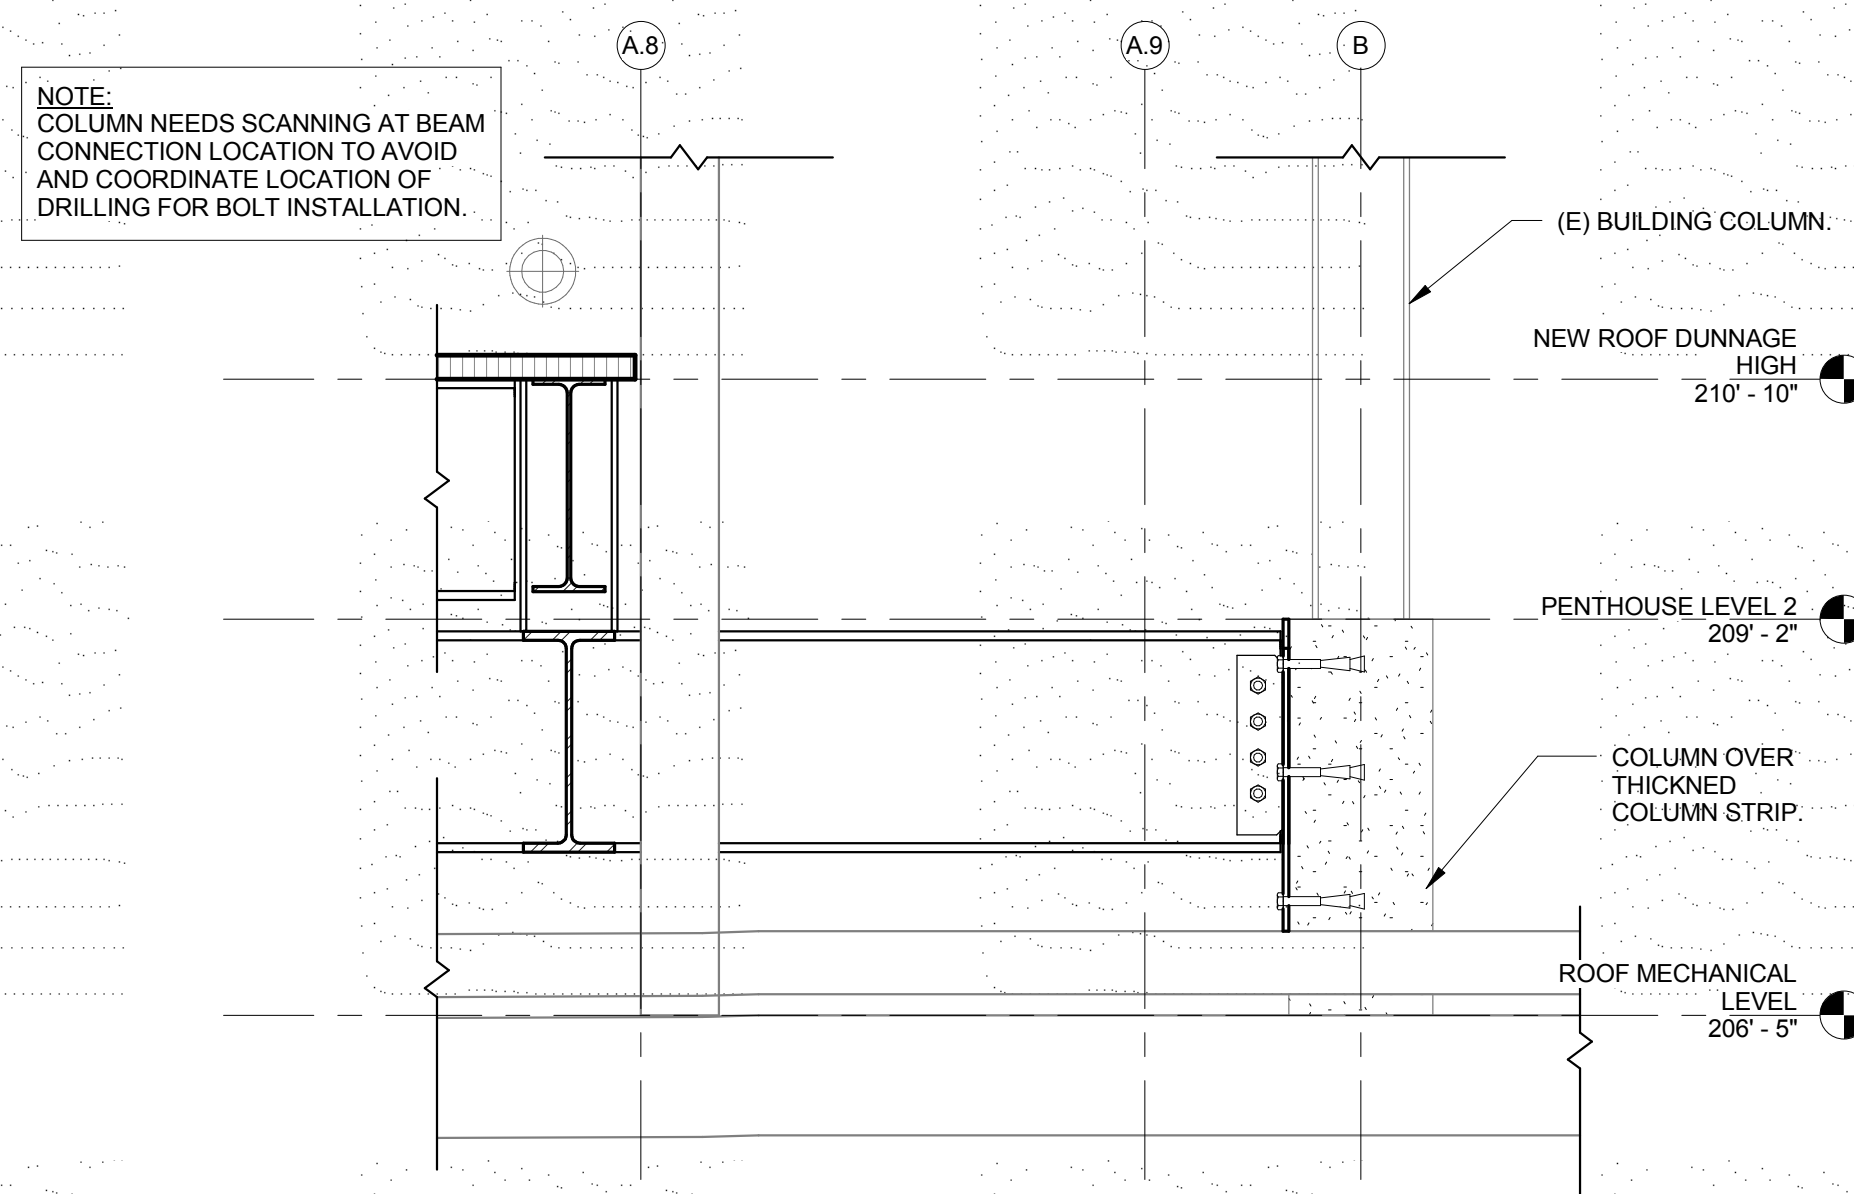

4 SECTION
 3/4" = 1'-0"

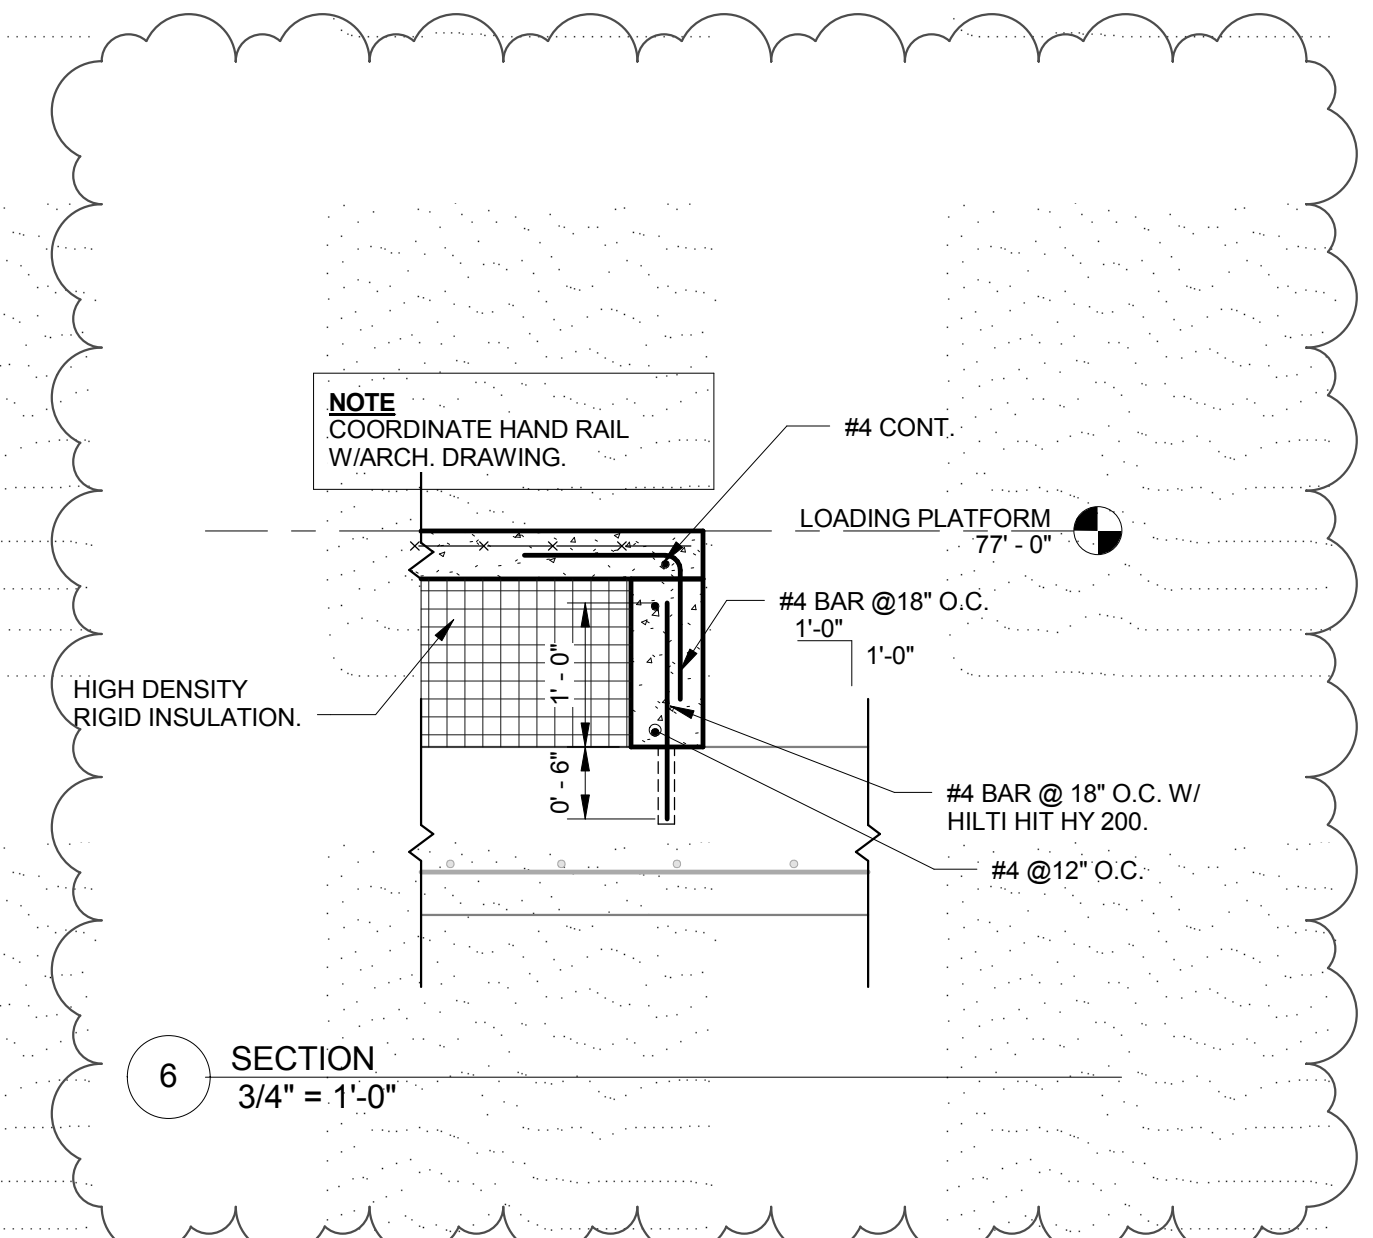

6 SECTION
 3/4" = 1'-0"



CLIENT:

CORESITE
12100 Sunrise Valley Drive
Reston, VA 20191
T 571.612.7136

PROJECT TEAM:

NORR Design Inc.
1617 John F. Kennedy Blvd., Ste 1600
Philadelphia PA, 19103
215.525.4849
www.environmentalcs.com

C

B

CORESITE - DC2

FRANKLIN COURT BUILDING
1099 14TH STREET
WASHINGTON DC 20005

CORESITE

NO.	DATE	DESCRIPTION	DRW/COR
1	2017-04-17	ISSUE FOR CLIENT REVIEW	
2	2017-05-05	ISSUE FOR OWNER AND LANDLORD REVIEW	
3	2017-05-05	PEER REVIEW	
4	2017-07-13	PEER REVIEW REVISION	
5	2017-08-17	ISSUE FOR PERMIT	
6	2017-10-27	PERMIT REVISIONS	

PROJECT NUMBER: M12-080

SHEET TITLE
**ENLARGED
ROOF/MECH
LEVEL HVAC
(EAST)**

SHEET NUMBER
M0403

