


# Tab B



ATELIER MJK  
1875 CONNECTICUT AVENUE  
10TH FLOOR  
WASHINGTON, D.C., 20009  
(202)-643-3995

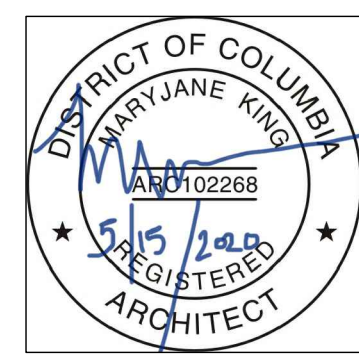

NORTH CAPITOL  
1626-1644 N CAPITOL ST NW  
WASHINGTON, D.C., 20002

REVISIONS:  
1 08/07/2020

- NOTES:
- ALL FURNITURE ARE FOR APPROX. LOCATION AND SCALE ONLY.
  - FINISH FLOORS TO ALL BE LEVEL WITH TRANSITIONS NOT EXCEED 1/4". ALL FLOORING AND TRANSITIONS TO MEET ADA REQUIREMENT. ALL FLOORING TO BE SLIP RESISTANCE AND MEET APPLICABLE FLAME SPREAD RESISTANCE RATINGS.
  - CEILING AND WALL FINISHES TO BE FLAME SPREAD FOR A-2 OCCUPANCIES:
    - CLASS B: IN CORRIDORS AND ENCLOSURE FOR EXIT ACCESS STAIRWAYS AND RAMPS,
    - CLASS C: INTERIOR EXIT STAIRWAYS, INTERIOR EXIT RAMPS AND EXIT PASSAGEWAYS; ROOMS AND CLOSED SPACES
  - CEILING AND WALL FINISHES TO BE FLAME SPREAD FOR R-1 OCCUPANCIES:
    - CLASS C: INTERIOR EXIT STAIRWAYS, INTERIOR EXIT RAMPS AND EXIT PASSAGEWAYS; CORRIDORS AND ENCLOSURE FOR EXIT ACCESS STAIRWAYS AND EXIT ACCESS RAMPS; ROOMS AND CLOSED SPACES
  - FLOOR FINISHES CRITICAL RADIANT FLUX TO BE NO LESS THAN CLASS II.

PROGRESS PRINTS  
NOT FOR  
CONSTRUCTION

- KEY:
- EXISTING WALLS
  - NEW CONSTRUCTION
  - DOOR TAGS
  - WINDOW TAGS
  - WALL TAGS

0' 2' 4' 6'




These plans are conditionally approved as submitted or noted during plan review and are subject to field inspection. Approved plans must be kept on site and are needed for all inspections. No changes or modifications to these plans. Changes require a revision permit with the revised plans. Trade Permits are required for trade work. E. of Electrical or Plumbing

Electrical Review: Alex Malmgren - 06-02-2021  
DC Water Review: David Blum - 06-02-2021  
Structural Review: Andrew Miller - 06-02-2021  
Fire Review: Luchi Lu - 06-02-2021  
Mechanical Review: Alex Pottel-Groh - 06-02-2021  
Plumbing Review: Alex Pottel-Groh - 06-02-2021  
HPB Review: Brandon Meyer - 06-02-2021  
Energy Review: Rafael Palomero-Camero - 06-02-2021  
DDO Review: Tiffany Tenbrook - 06-02-2021  
Green Review: Rafael Palomero-Camero - 06-02-2021

ATELIER Mjk

1875 CONNECTICUT AVENUE  
10TH FLOOR  
WASHINGTON, D.C., 20009

(202)-643-3995

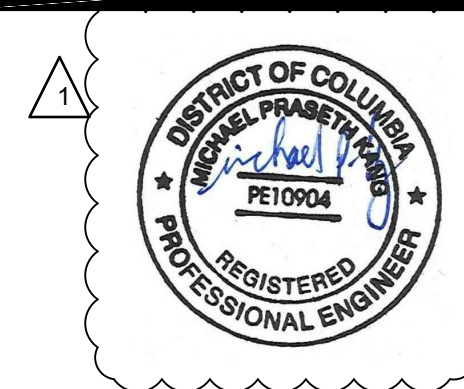

NORTH CAPITOL

1626-1644 N CAPITOL ST NW  
WASHINGTON, D.C., 20002

REVISIONS:

PERMIT REVISIONS 08-14-20


DATE: 04/23/2020

SHEET NAME:


PENTHOUSE FLOOR PLAN  
LIGHTING NEW WORK

SHEET #:

E0105

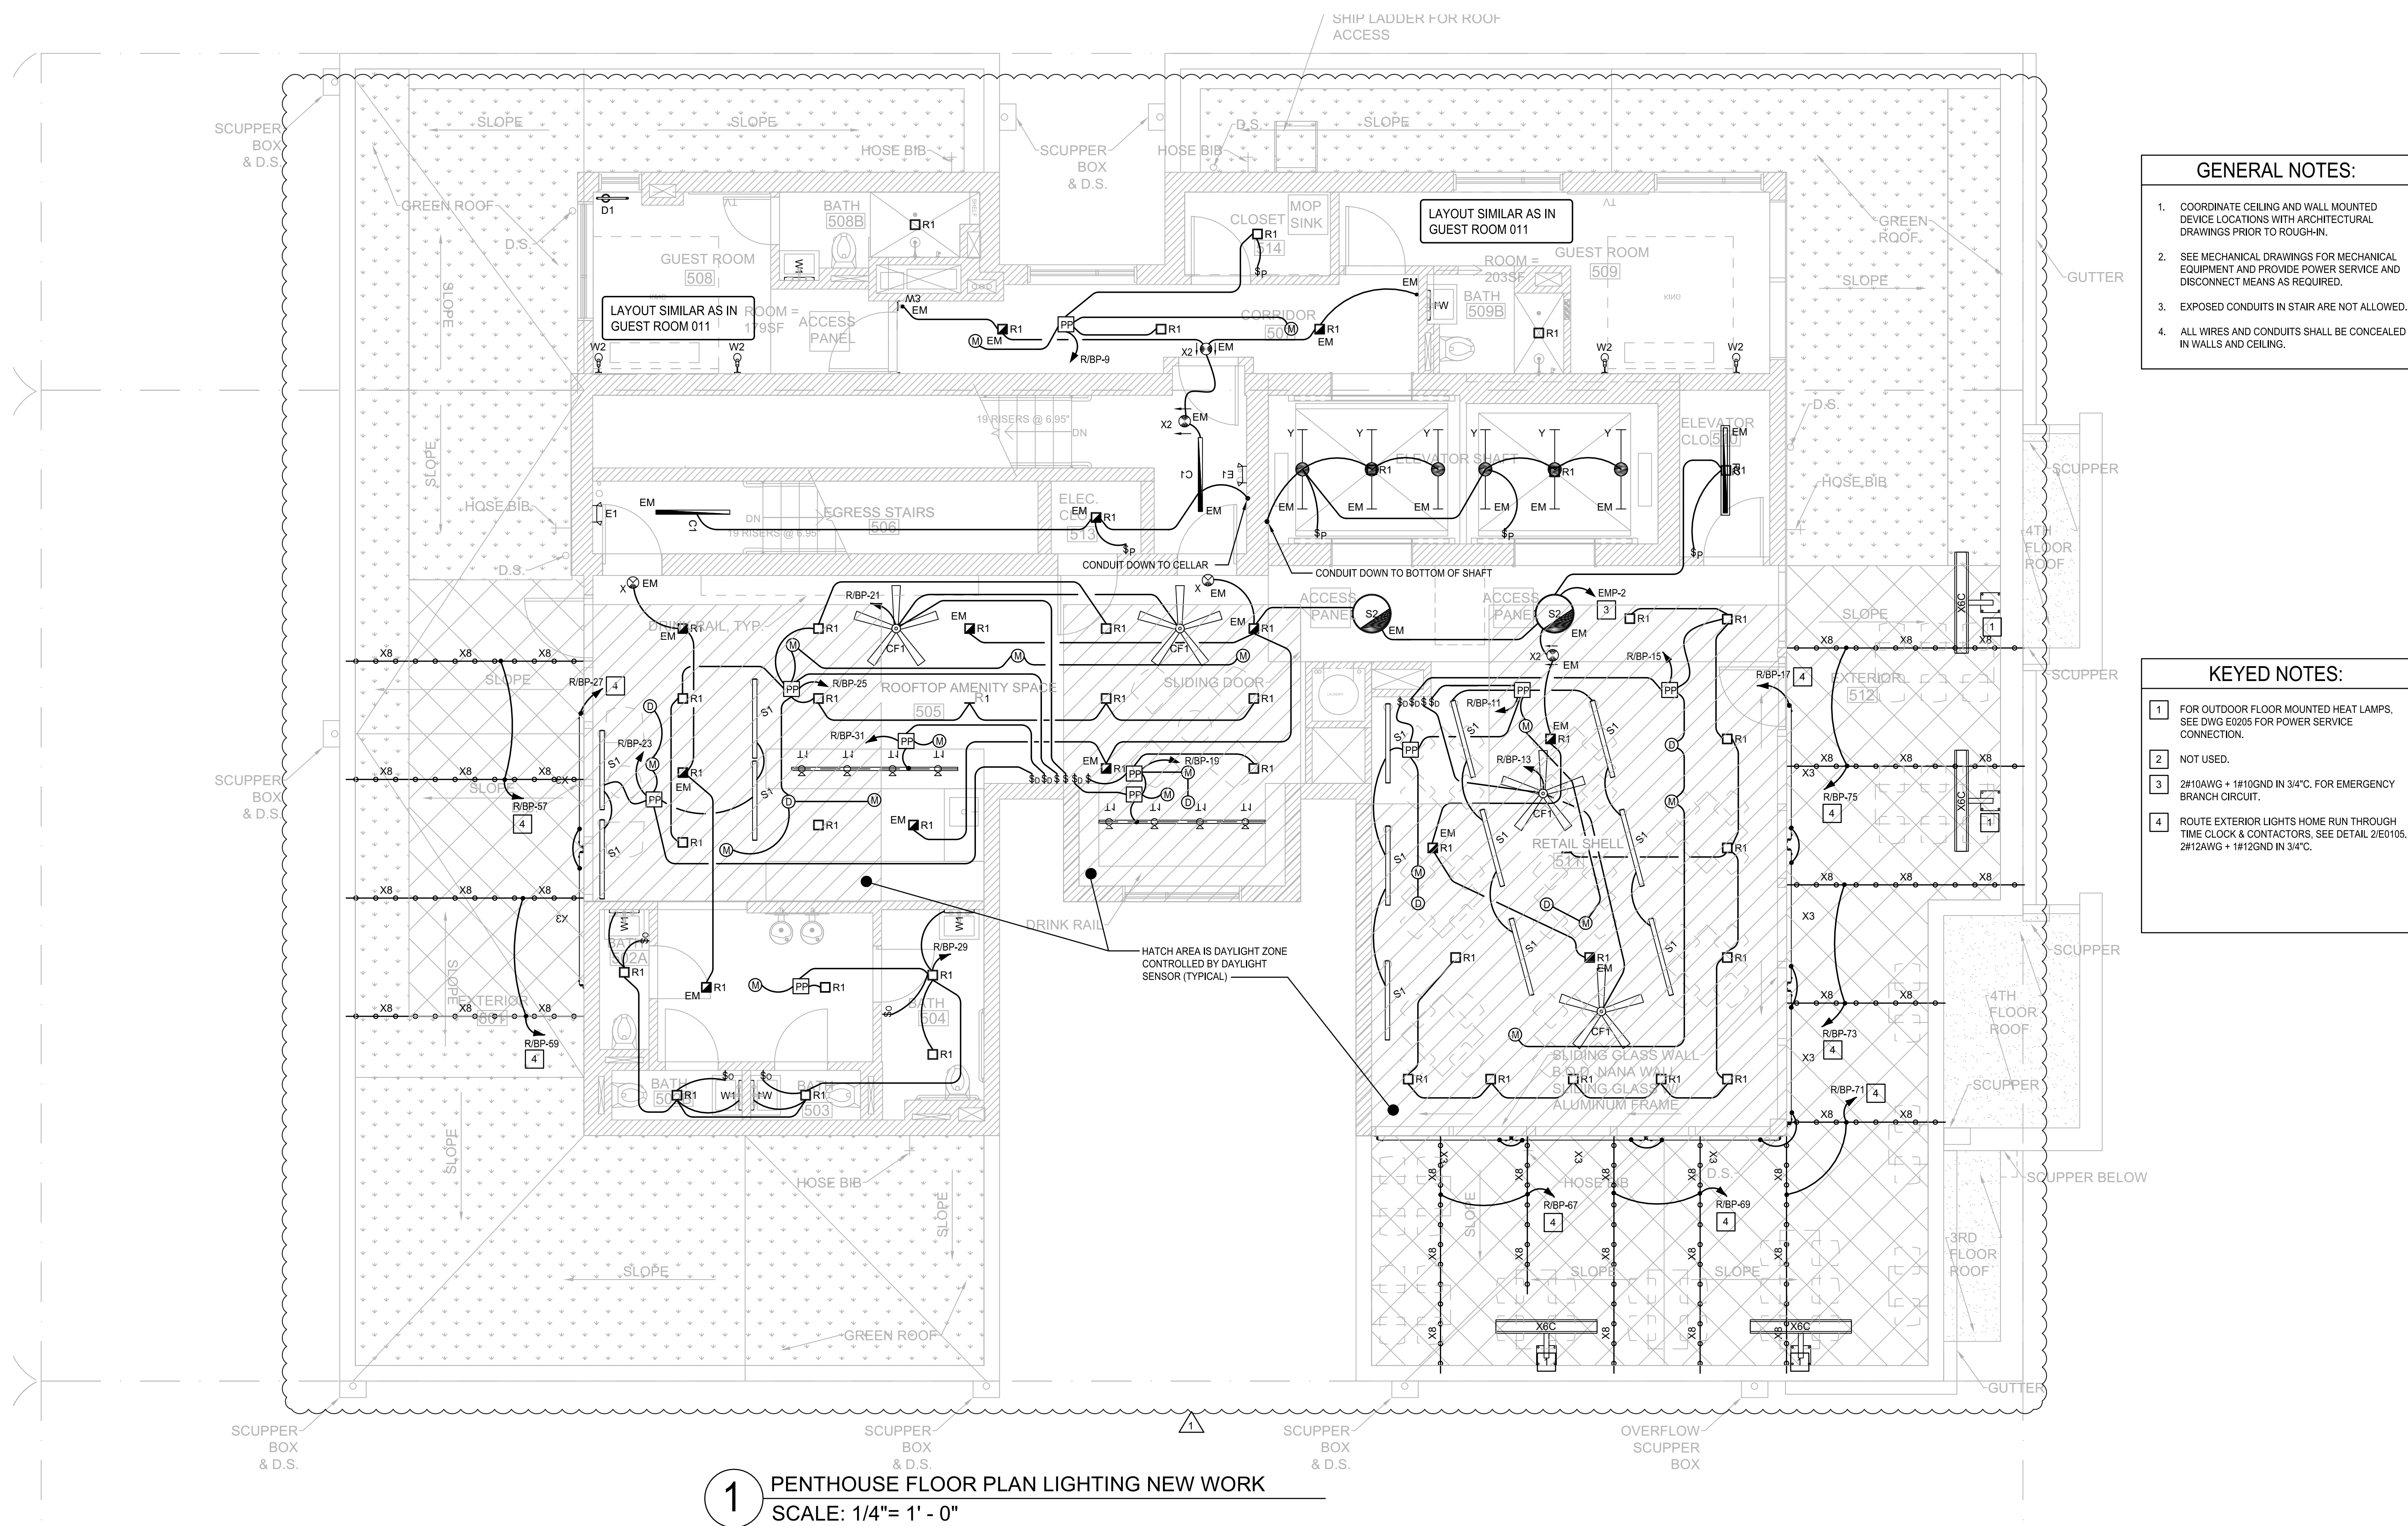

1 PENTHOUSE FLOOR PLAN LIGHTING NEW WORK  
SCALE: 1/4" = 1' - 0"

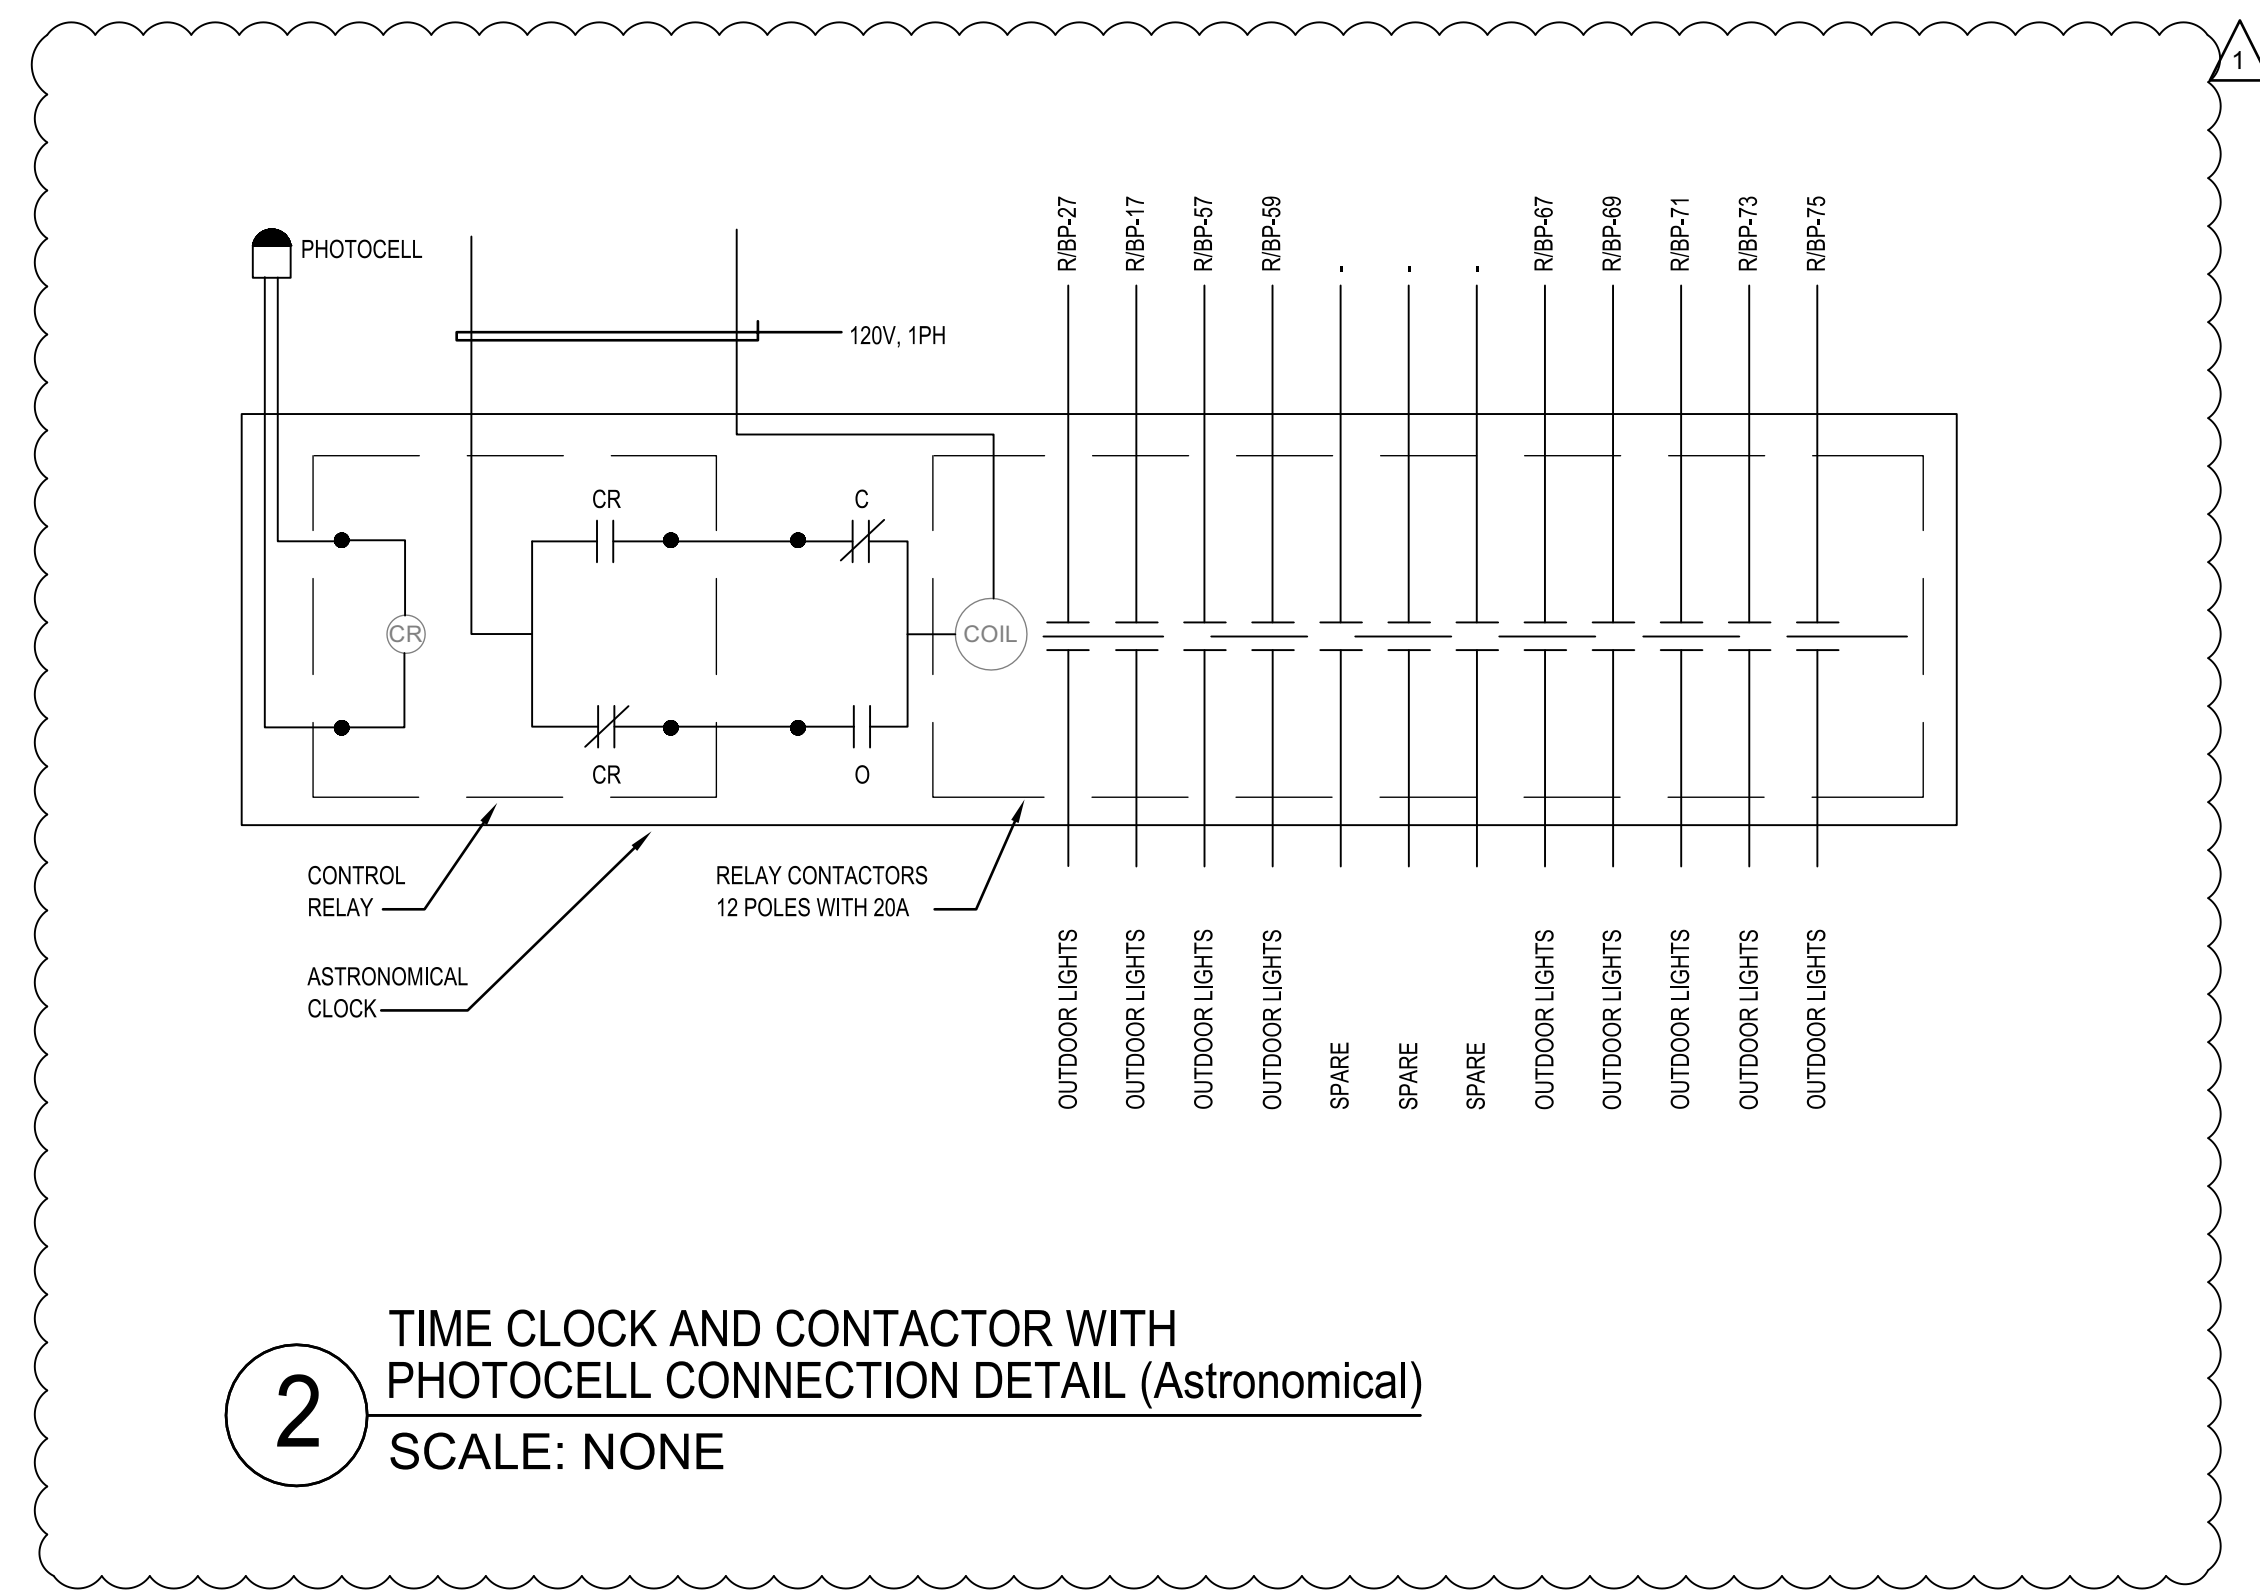

2 TIME CLOCK AND CONTACTOR WITH  
PHOTOCELL CONNECTION DETAIL (Astronomical)  
SCALE: NONE