



2 1ST FLOOR
1/4" = 1'-0"



1 CELLAR PLAN
1/4" = 1'-0"



2-FAMILY ROWHOUSE
RENOVATION / ADDITION

ADDRESS N.W. WASHINGTON D.C., 20000

2P-A-XXX

No.	Description	Date



2020-XX-XX
AS-BUILT DWGS

D002

EXISTING
PLANS



6/3/2021 10:31:08 PM

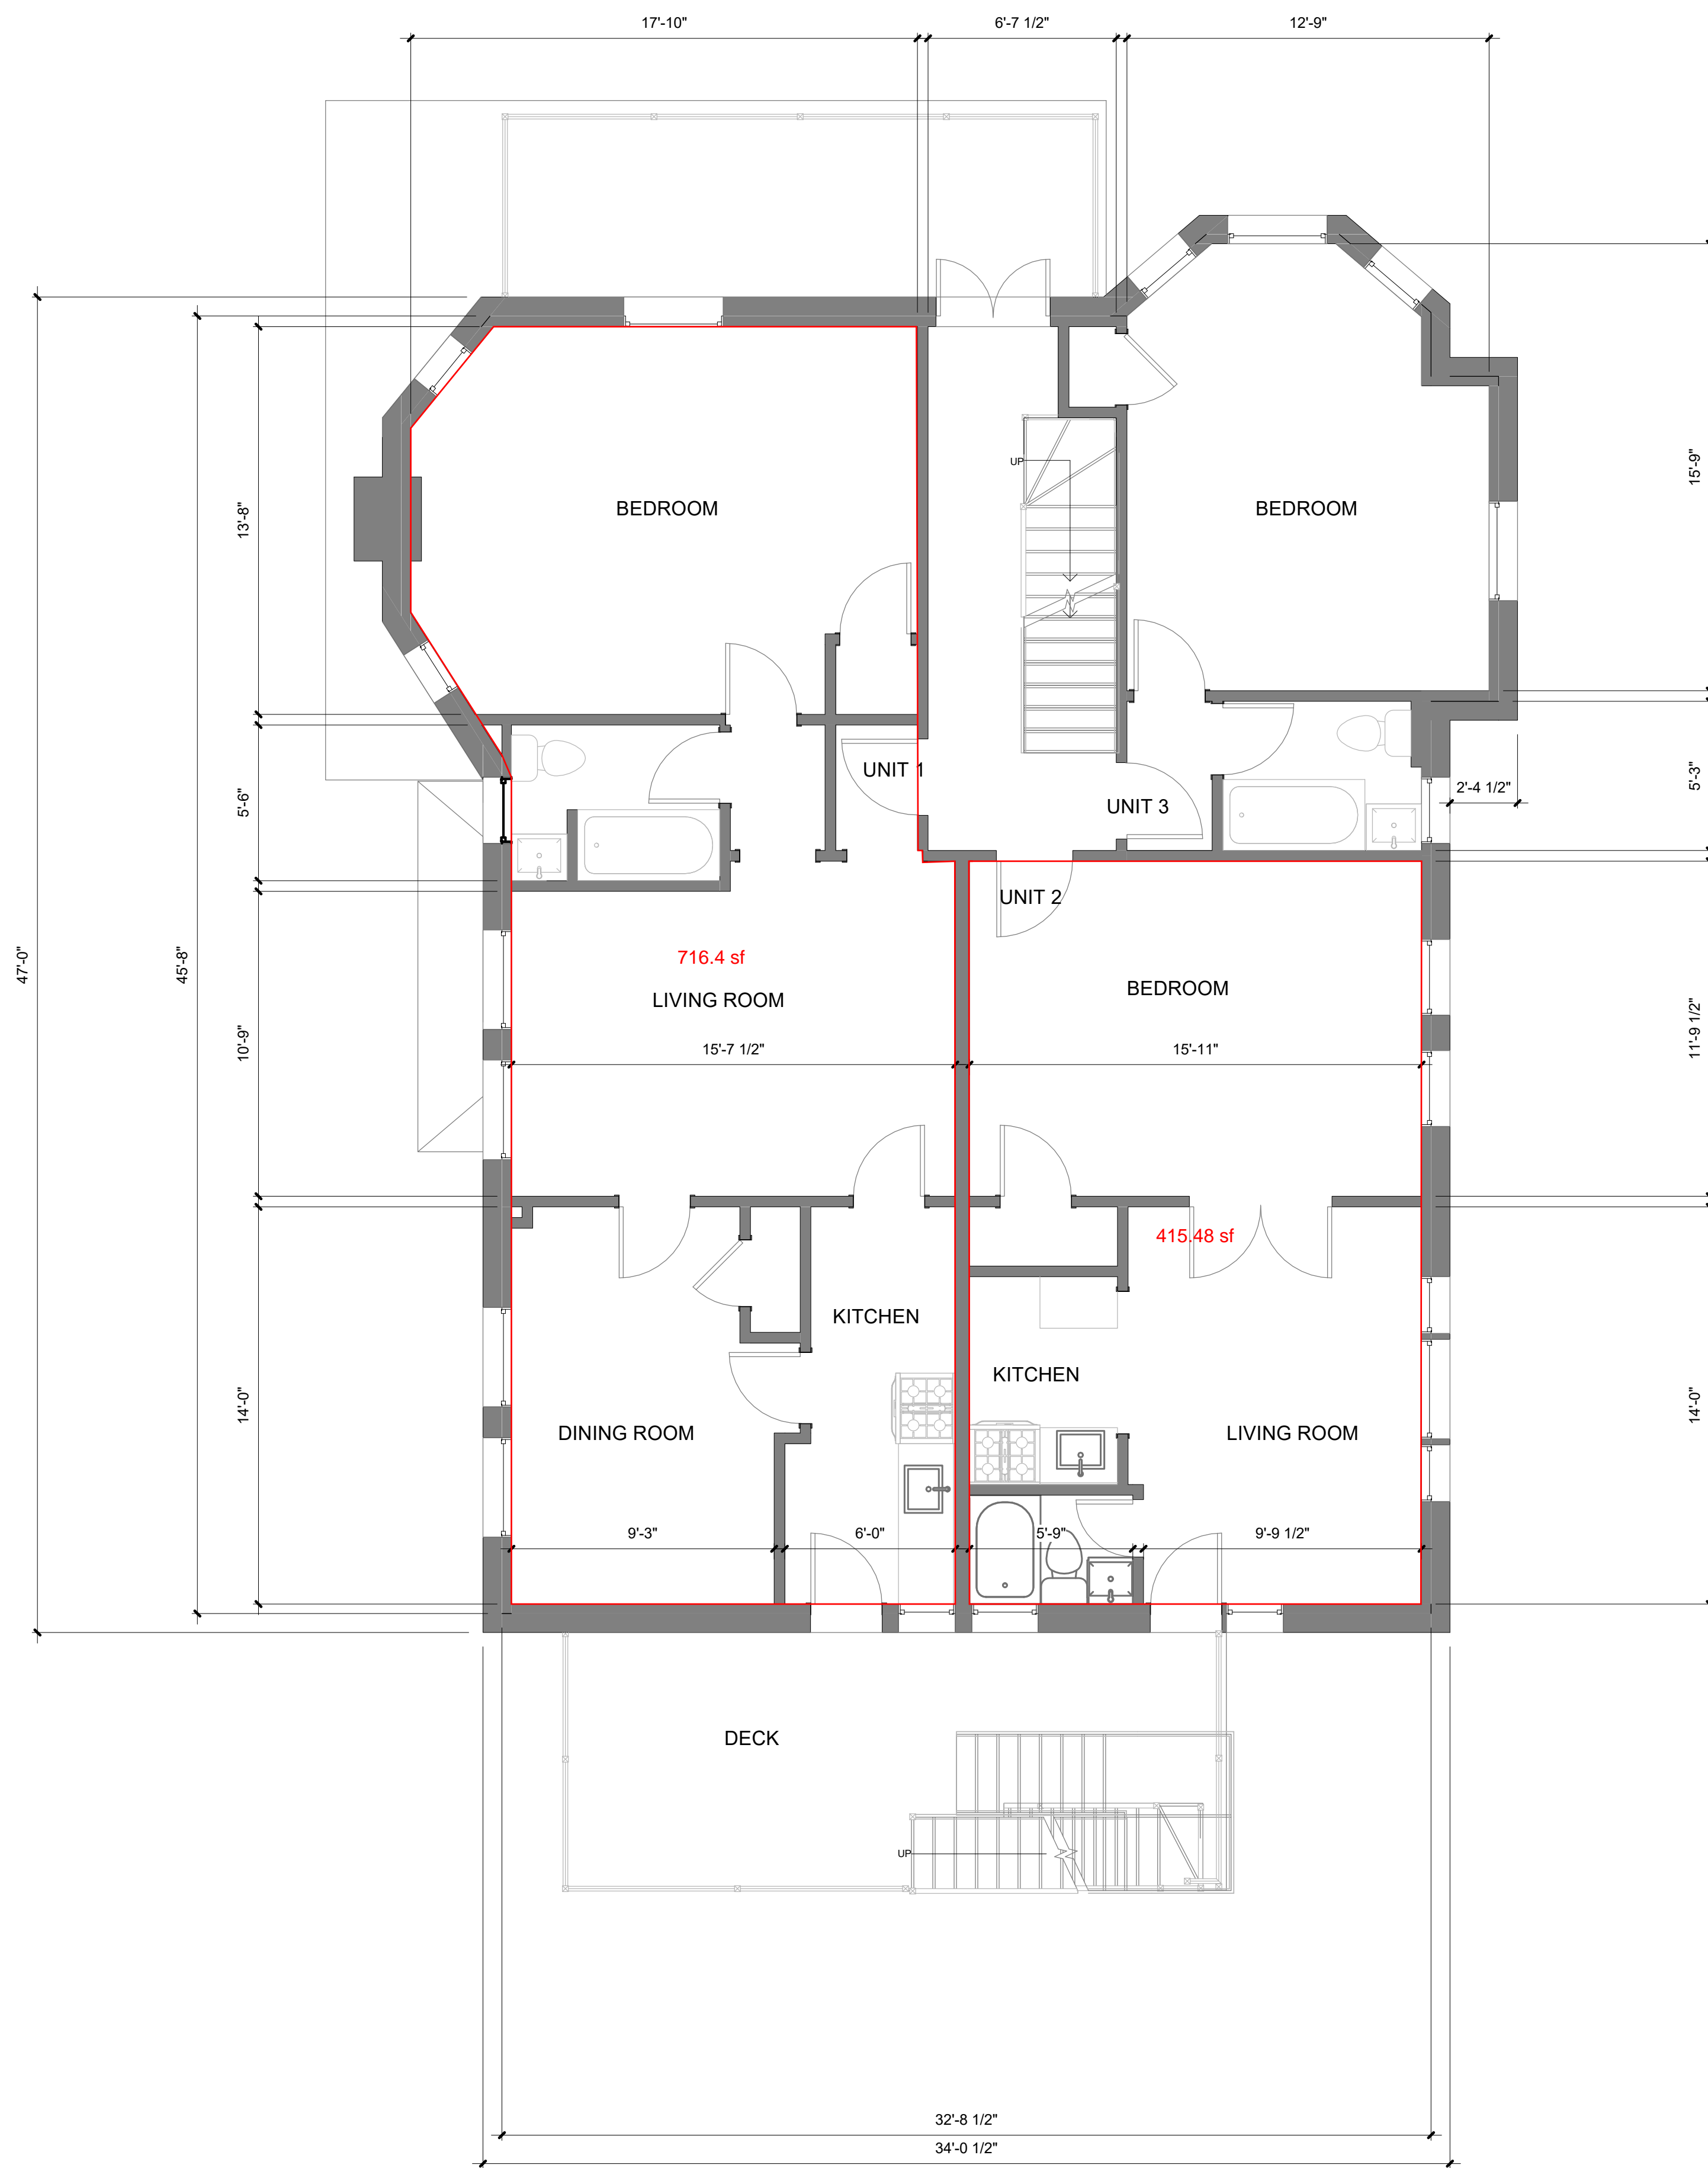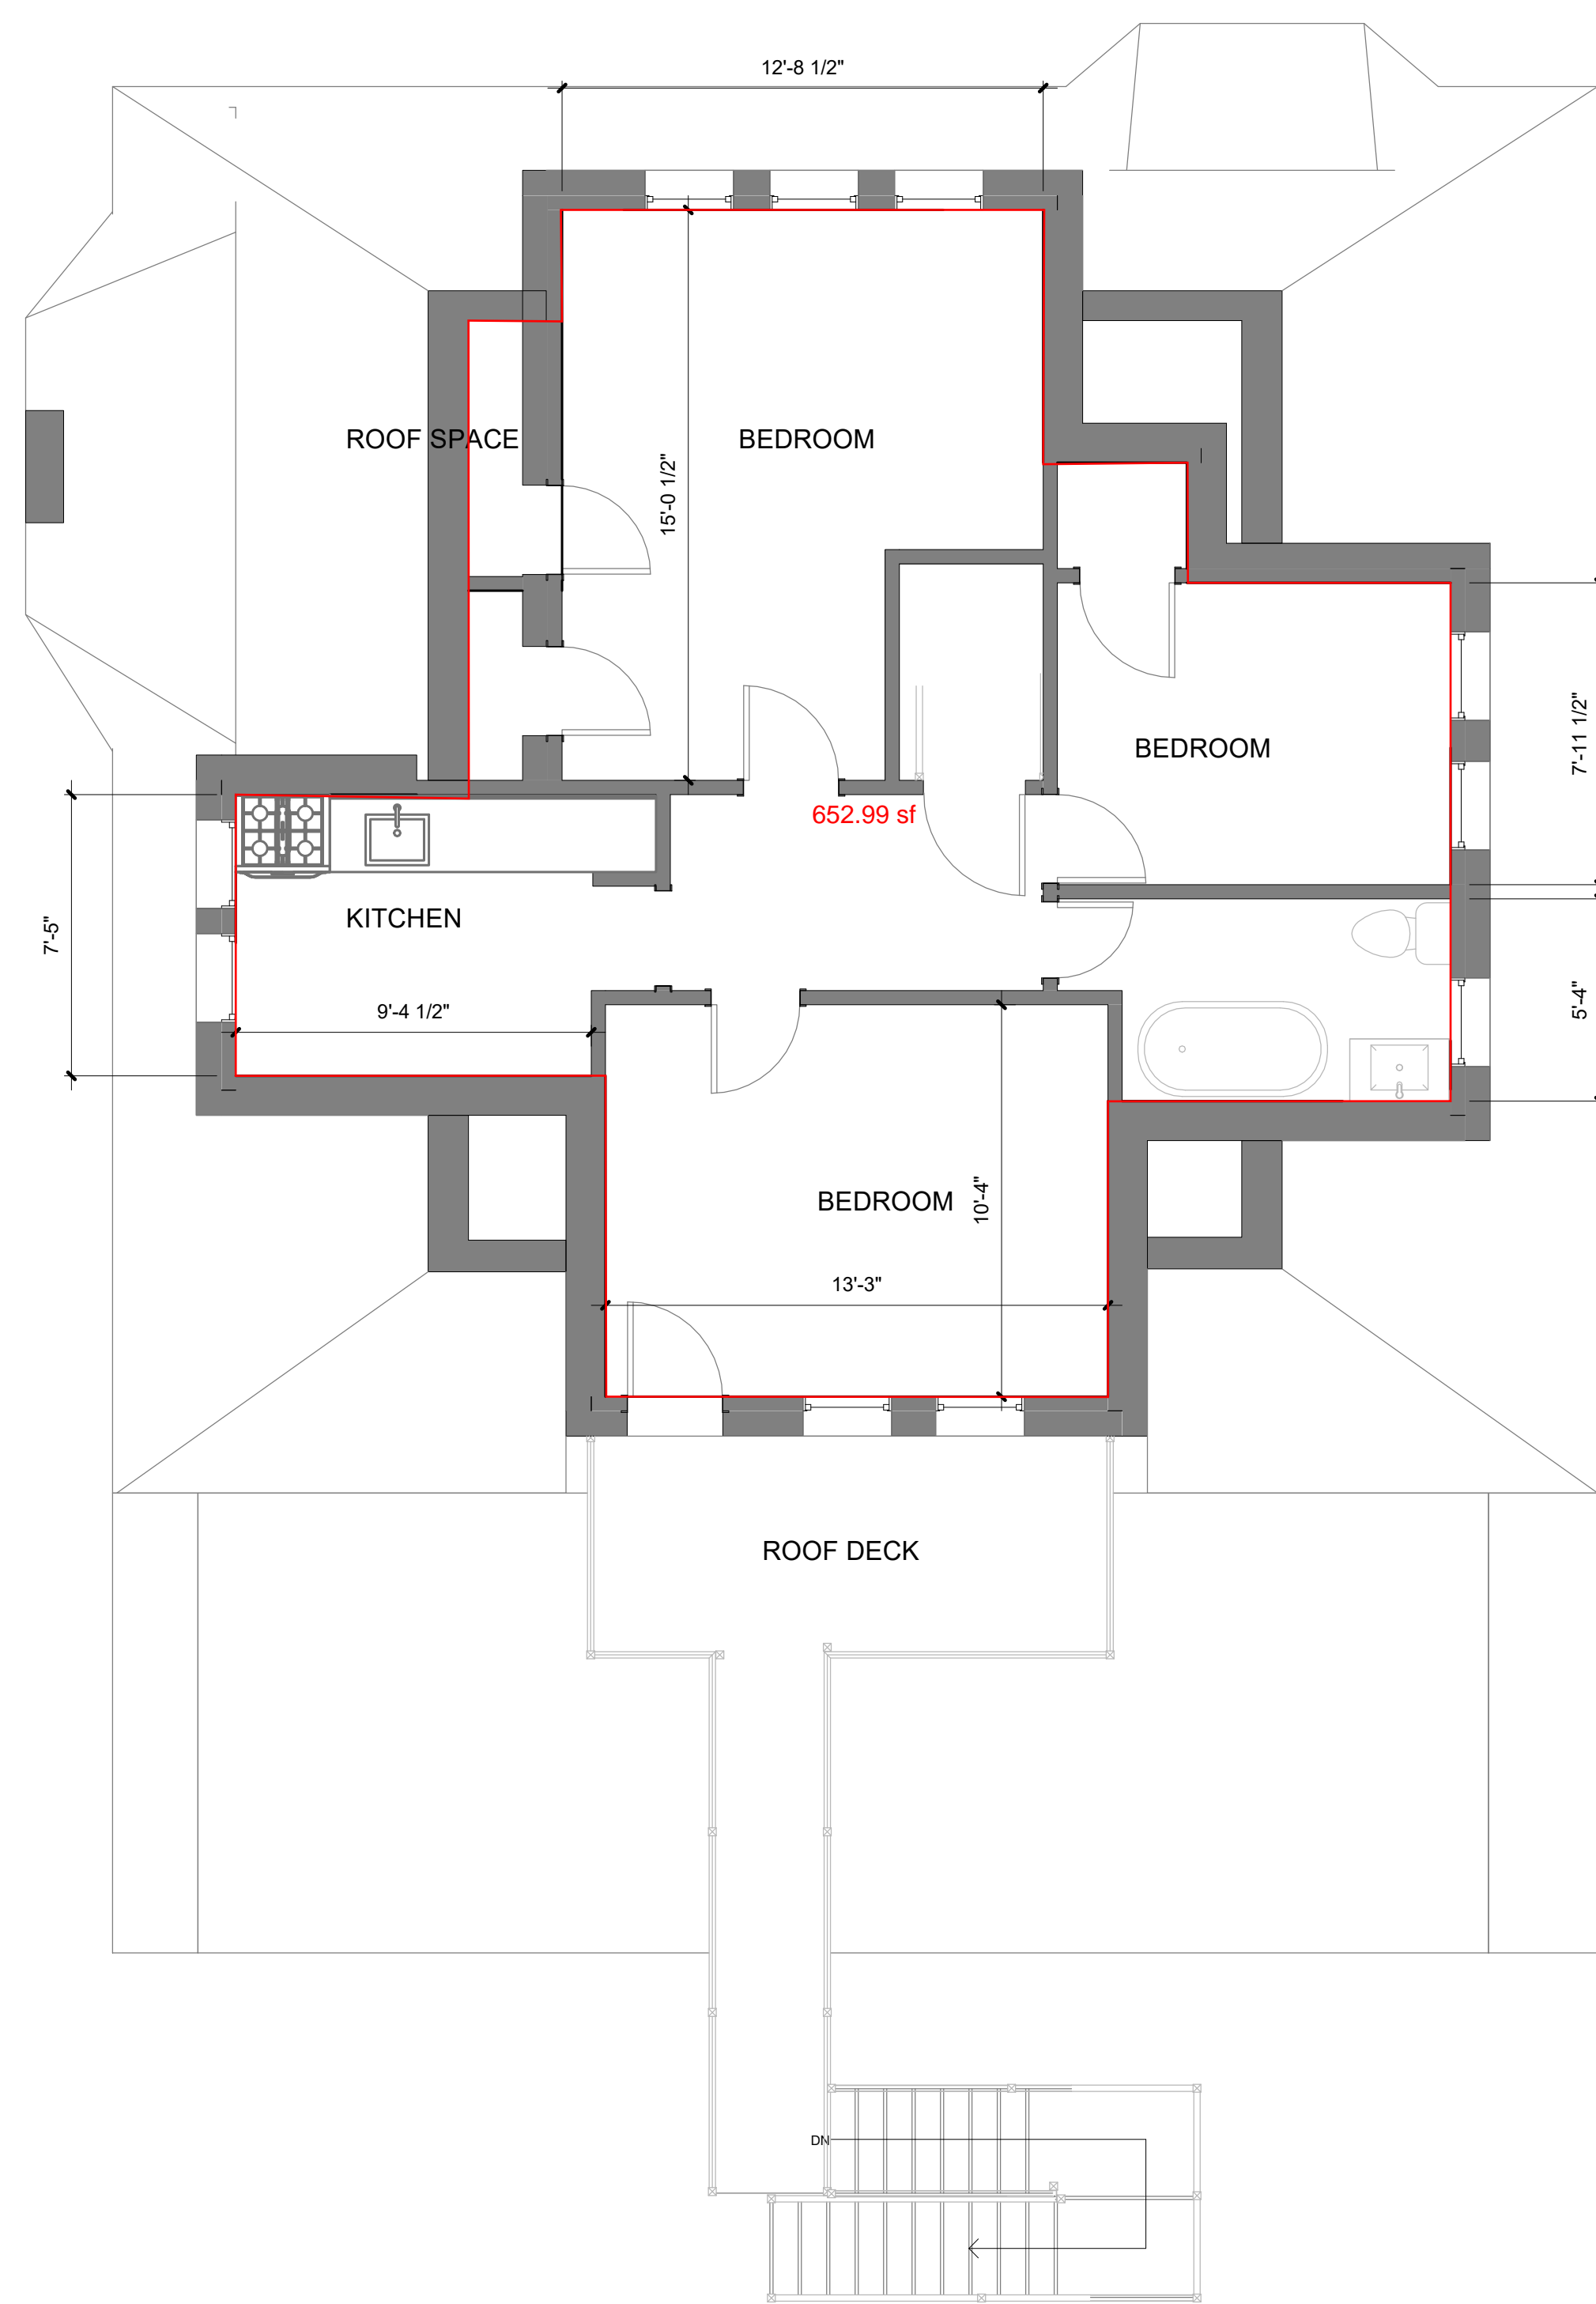

**2-FAMILY ROWHOUSE
RENOVATION / ADDITION**

ADDRESS N.W. WASHINGTON D.C., 20000

2P-A-XXX

2020-XX-XX
AS-BUILT DWGS

No.	Description	Date

D003

EXISTING
PLANS



6/3/2021 10:31:08 PM