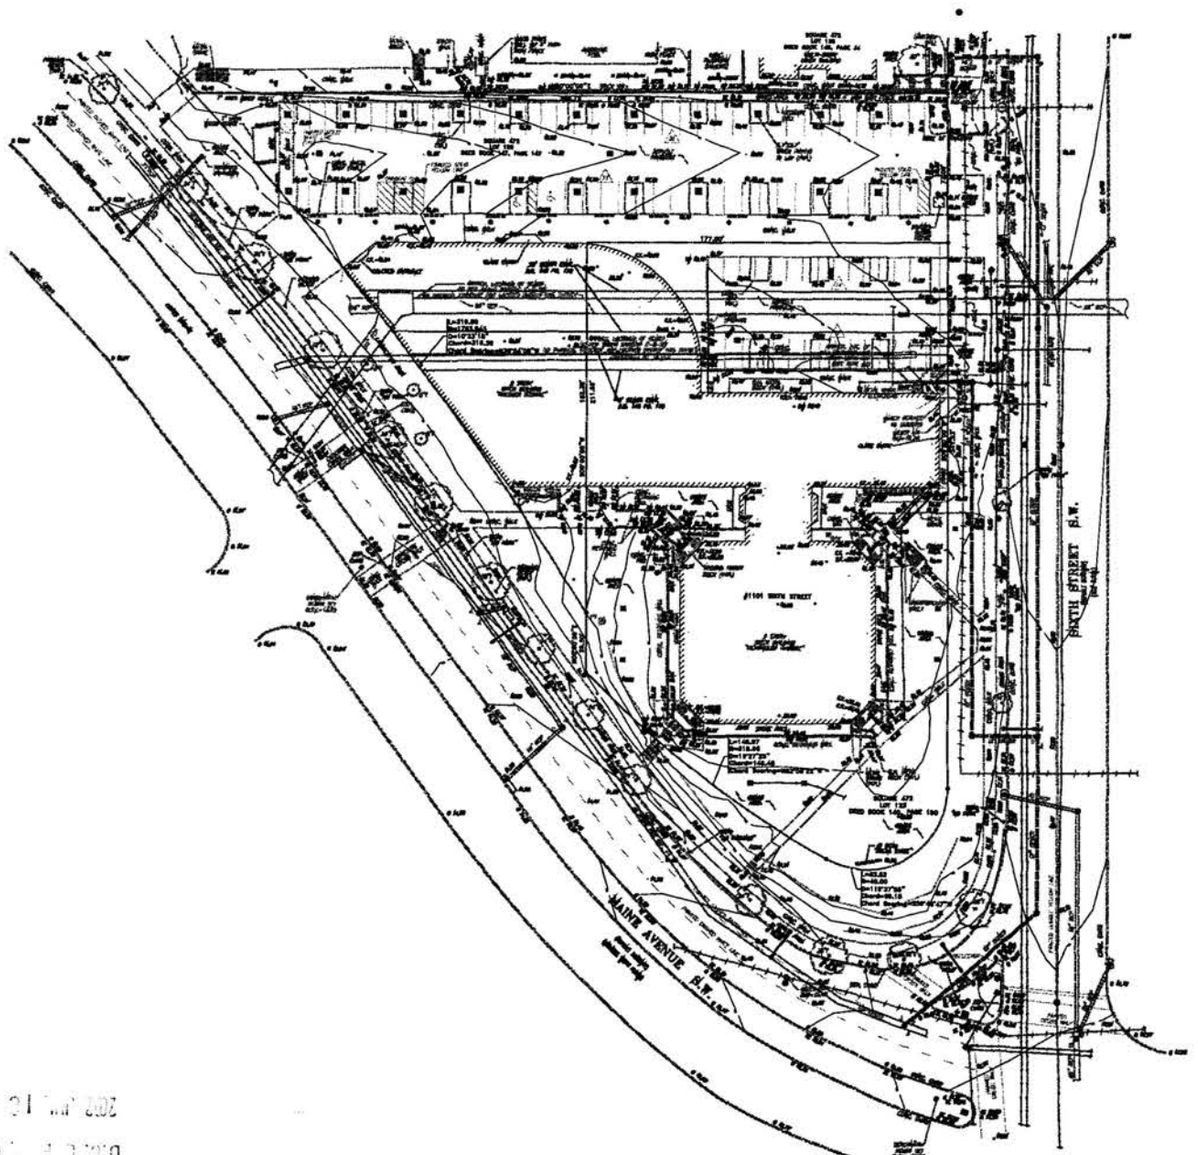


NOTE:
SITE SURVEY PLAN
PREPARED BY:

CONTROL POINT ASSOCIATES INC.
22630 DAVIS STREET
SUITE 200
STERLING, VIRGINIA
20164

0 10 30 60

KEY

NORTH

NO.	DESCRIPTION	DATE	CHK
2	Issued for meeting	21-JUN-12	
1	Issued for costing	06-APR-12	

REVISIONS

BING THOM ARCHITECTS

1430 Burrard Street Vancouver, BC V6Z 3A3

DO NOT SCALE DRAWING.

Xref Drawings :

DRAWN BY	CHK	INIT	SCALE
			1/64"=1'-0"
			DRAWING DATE
			21 JUNE 12

ARENA STAGE PROJECT

PROJECT

EXISTING DRAWINGS SURVEYOR PLAN


TITLE

PROJECT NUMBER 209

DRAWING NUMBER B100

BZA
No. 16933
Ex. No. 18

Board of Zoning Adjustment
District of Columbia
CASE NO.16933
EXHIBIT NO.10

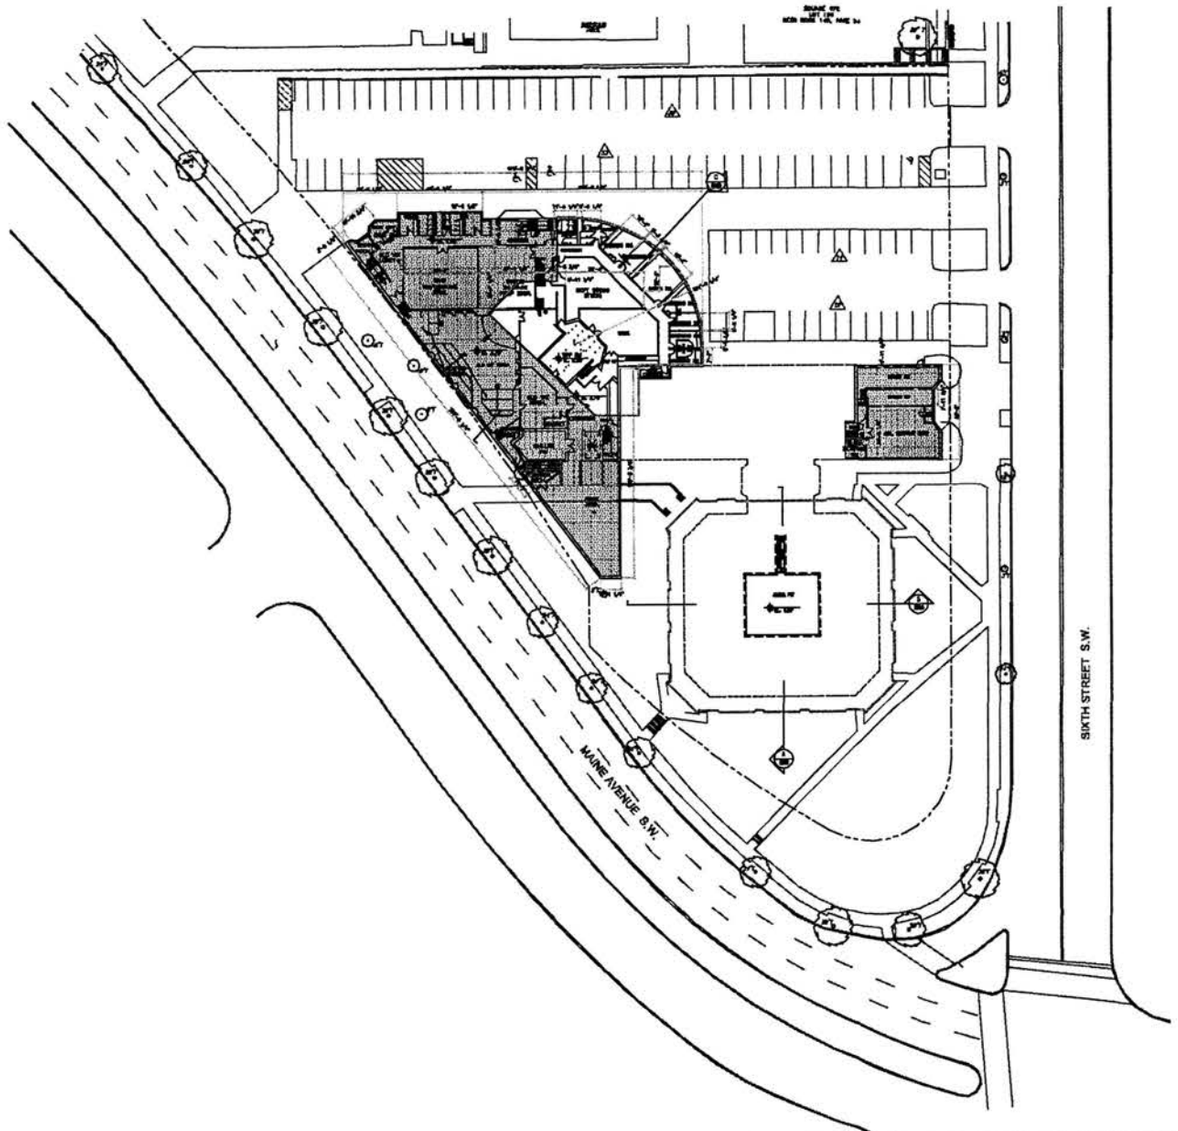


NOTE:
ALL EXISTING AS-BUILT DRAWINGS PREPARED BY:

Ai ARCHITECTURE
2100 M STREET NW
SUITE 800
WASHINGTON, DC
20037-1207

TO BE DEMOLISHED

0 5 15 30

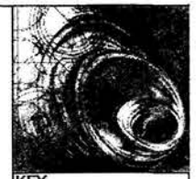

KEY

NORTH


REVISIONS

BING THOM ARCHITECTS

ARENA STAGE PROJECT

EXISTING BASEMENT FLOOR PLANS

B200

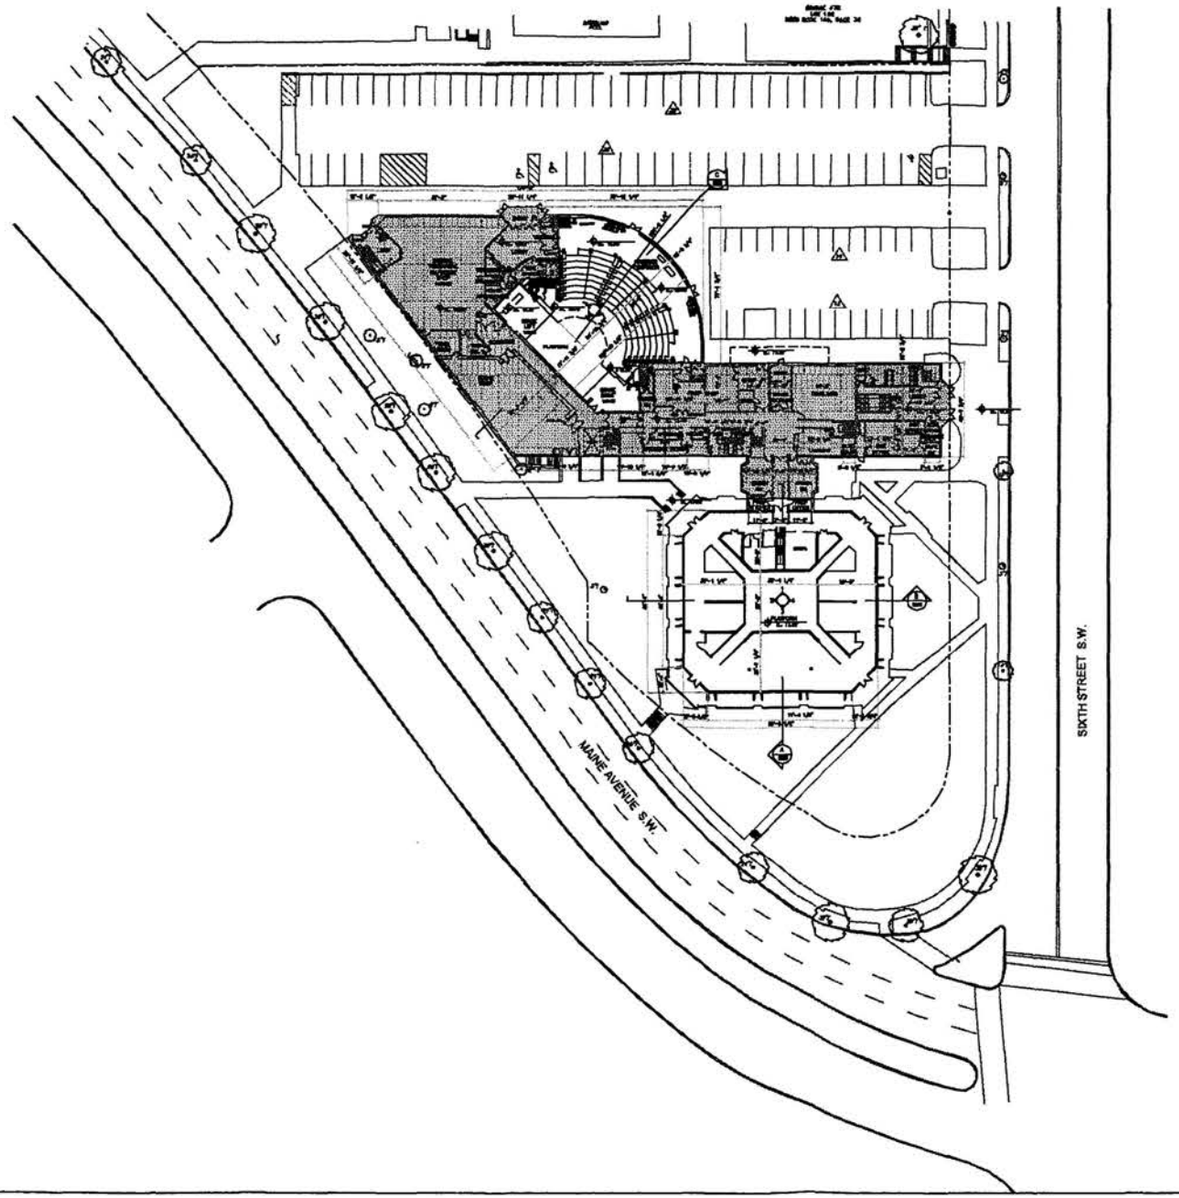

NOTE:
ALL EXISTING AS-BUILT DRAWINGS
PREPARED BY:

Ai ARCHITECTURE
2100 M STREET NW
SUITE 800
WASHINGTON, DC
20037-1207

TO BE DEMOLISHED

0 5 15 30



KEY

NORTH


REVISIONS

BING THOM ARCHITECTS

ARENA STAGE PROJECT

EXISTING FIRST FLOOR PLAN

B201

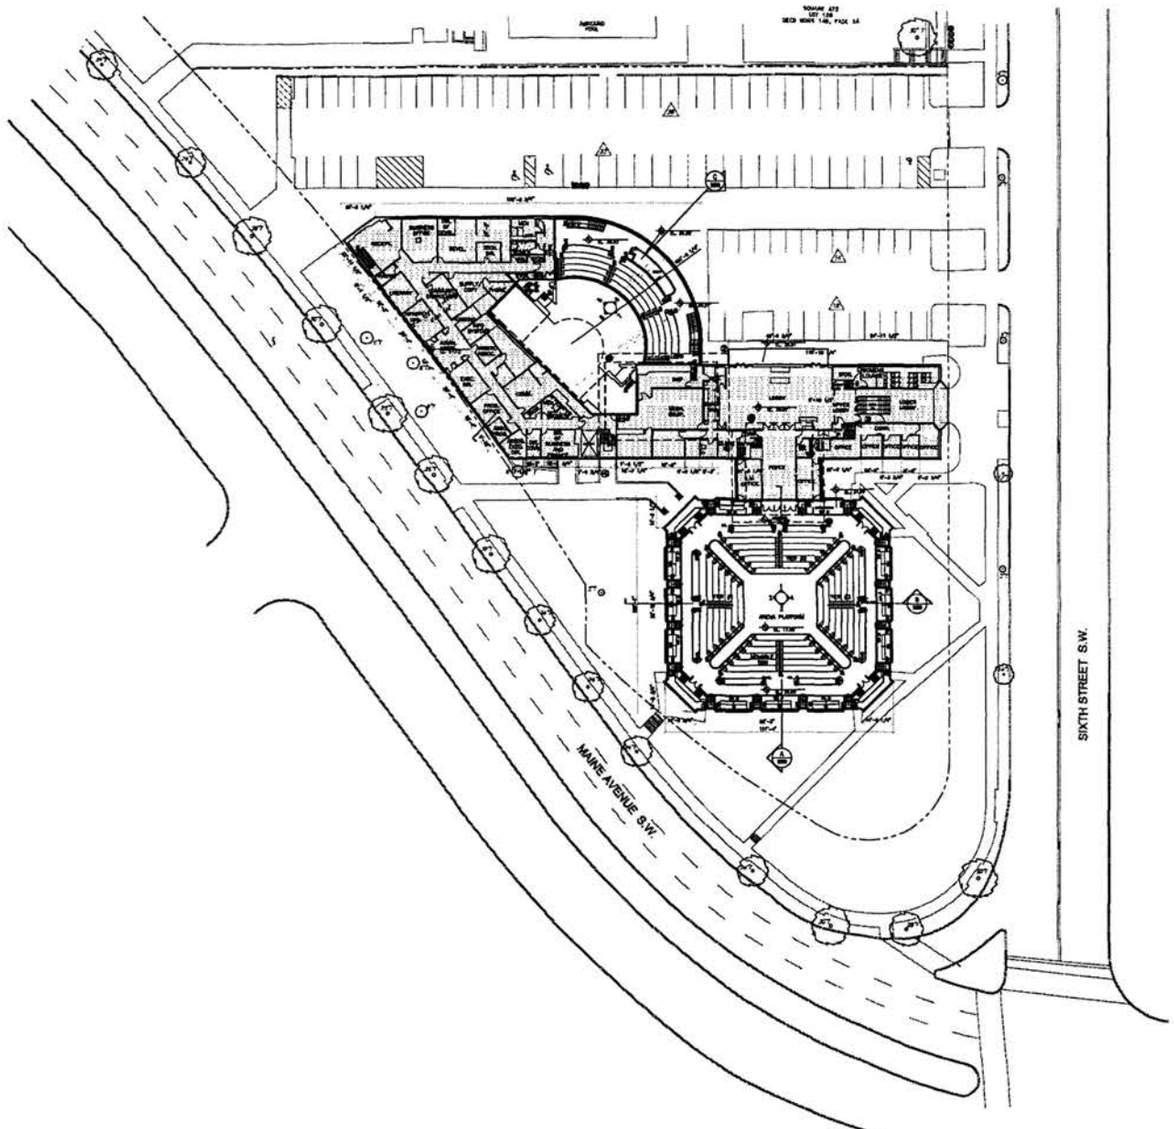

NOTE:
ALL EXISTING AS-BUILT DRAWINGS
PREPARED BY:

Ai ARCHITECTURE
2100 M STREET NW
SUITE 800
WASHINGTON, DC
20037-1207

TO BE DEMOLISHED

0 5 15 30



KEY

NORTH

NO.	DESCRIPTION	DATE	CHK
2	Issued for assembly	27-JUN-02	
1	Issued for pricing	06-SEP-02	

REVISIONS

BING THOM ARCHITECTS

1430 Burrard Street Vancouver, BC V6Z 2A3

DO NOT SCALE DRAWINGS.

Xref Drawings :

DRAWN	BY	CHK	INIT

SCALE
1/64"=1'-0"
DRAWING DATE
27 JUNE 02

ARENA STAGE PROJECT

PROJECT


EXISTING SECOND FLOOR PLANS

TITLE


PROJECT NUMBER	ISSUE NO.
3017	
CADD FILE	
2101-A202.dwg	

DRAWING NUMBER


B202

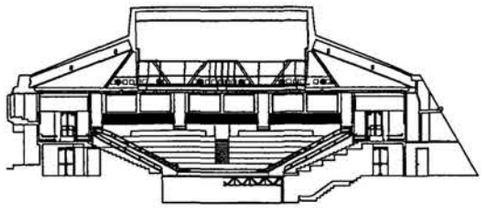

B300 / AA Section through Fichandler

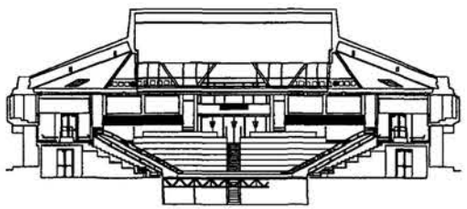

B300 / BB Section through Fichandler

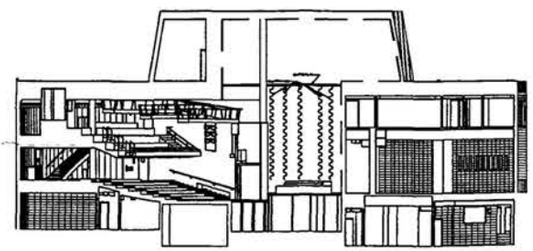

B300 / CC Section through Kreeger


NOTE:
ALL EXISTING AS-BUILT DRAWINGS
PREPARED BY:

Ai ARCHITECTURE
2100 M STREET NW
SUITE 800
WASHINGTON, DC
20037-1207

0 5 15 30



KEY

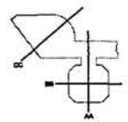

NO.	DESCRIPTION	DATE	CHK
2	ISSUED FOR ZONING	27-JUN-22	
1	ISSUED FOR COSTING	08-DEC-22	

REVISIONS

BING THOM ARCHITECTS

1430 Burrard Street Vancouver, BC V6Z 2A3

DO NOT SCALE DRAWINGS.

VERIFY ALL DIMENSIONS ON SITE. REPORT ANY DISCREPANCIES TO THE CONSULTANT PRIOR TO CONSTRUCTION.

ISSUE ONLY THOSE DRAWINGS ISSUED FOR CONSTRUCTION. REPORT WARNINGS AND FAILED SEARCH MESSAGES.

© Bing Thom Architects The reuse of drawings or parts of such thereof is restricted to the original project for which they are prepared and cannot be used without written consent.

Xref Drawings :

DRAWN	BY	CHK	INT

SCALE: AS NOTED

DRAWING DATE: 22 JUNE 22

ARENA STAGE PROJECT

PROJECT

EXISTING BUILDING SECTIONS


TITLE

PROJECT NUMBER 2017


ISSUE NO.

CADD FILE 2107-B300.dwg


DRAWING NUMBER B300

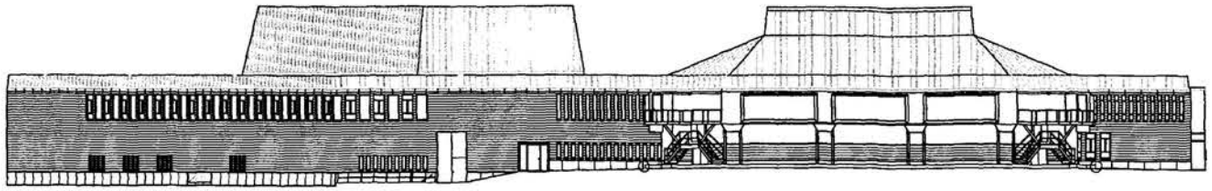


B400 / 1 SOUTH ELEVATION

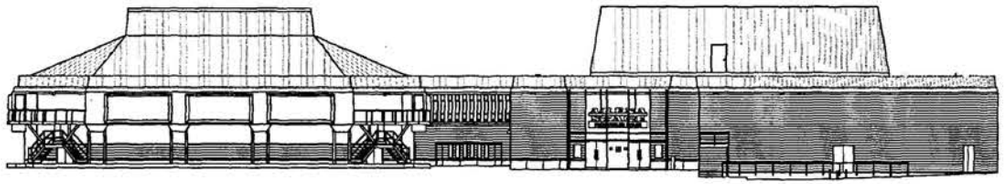

B400 / 2 WEST ELEVATION

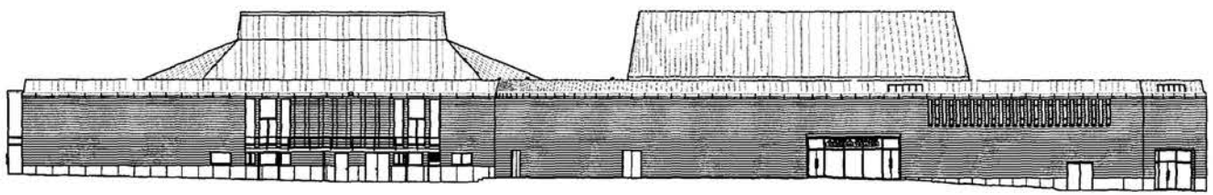

B400 / 3 NORTH ELEVATION

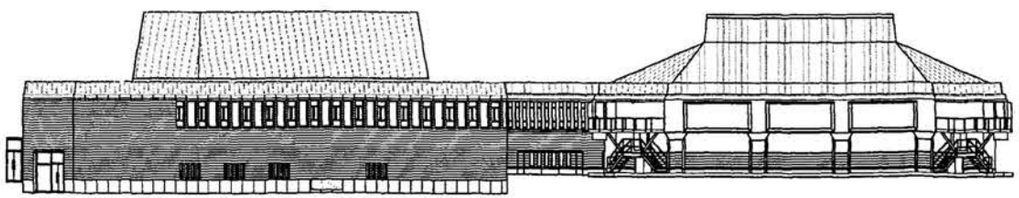


B400 / 4 EAST ELEVATION


NOTE:
ALL EXISTING AS-BUILT DRAWINGS
PREPARED BY:

Ai ARCHITECTURE
2100 M STREET NW
SUITE 800
WASHINGTON, DC
20037-1207

0 5 15 30

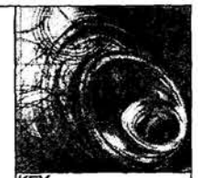

KEY

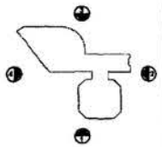

NO.	DESCRIPTION	DATE	CHK
1	ISSUED FOR PERMIT	31-JAN-02	
2	ISSUED FOR COSTING	08-MAY-02	

REVISIONS

BING THOM ARCHITECTS

1430 Burrard Street Vancouver, BC V6Z 2A3
T 604-683-1881 F 604-683-1343 E info@bingthom.com W www.bingthom.com

DRAWN BY CHK INIT SCALE 1/32" = 1'-0"
DRAWING DATE 27 JUNE 02


ARENA STAGE PROJECT

PROJECT


EXISTING ELEVATIONS

TITLE


PROJECT NUMBER 3017 ISSUE NO.
CADD FILE 3107-B400.dwg
DRAWING NUMBER B400

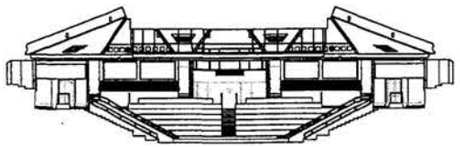


B600 / AA Interior Elevation

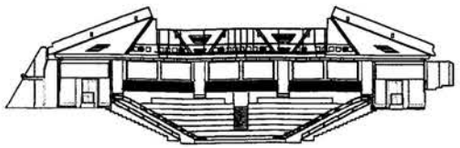


B600 / BB Interior Elevation

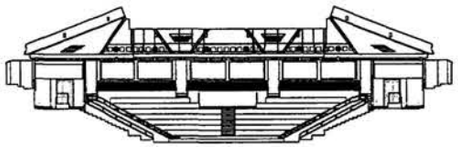


B600 / CC Interior Elevation

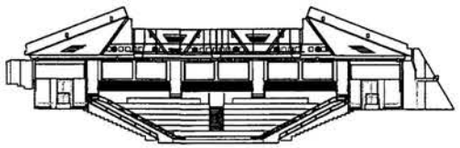


B600 / DD Interior Elevation

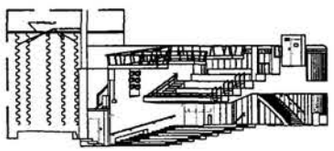


B600 / EE Interior Elevation

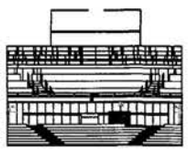

B600 / FF Interior Elevation

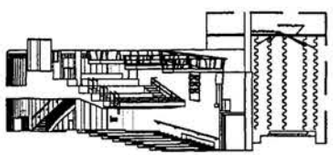

B600 / CC Interior Elevation

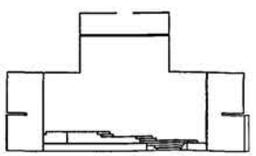

B600 / HH Interior Elevation


NOTE:
ALL EXISTING AS-BUILT DRAWINGS PREPARED BY:

Ai ARCHITECTURE
2100 M STREET NW
SUITE 800
WASHINGTON, DC
20037-1207

0 5 15 30



KEY

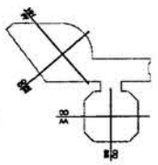

NO.	DESCRIPTION	DATE	CHK
2	ISSUED FOR BIDDING	27-JUN-02	
1	ISSUED FOR COORD	08-MAY-02	

REVISIONS

BING THOM ARCHITECTS
1430 Burrard Street Vancouver, BC V6Z 2A3

DO NOT SCALE DRAWING.

Xref Drawings :

DRAWN	BY	CHK	BRT

SCALE 1/32"=1'-0"

DRAWING DATE 27 JUNE 02

ARENA STAGE PROJECT

PROJECT

EXISTING INTERIOR ELEVATIONS


TITLE

PROJECT NUMBER 2017

ISSUE NO.

CADD FILE 2107-B600.dwg

DRAWING NUMBER B600

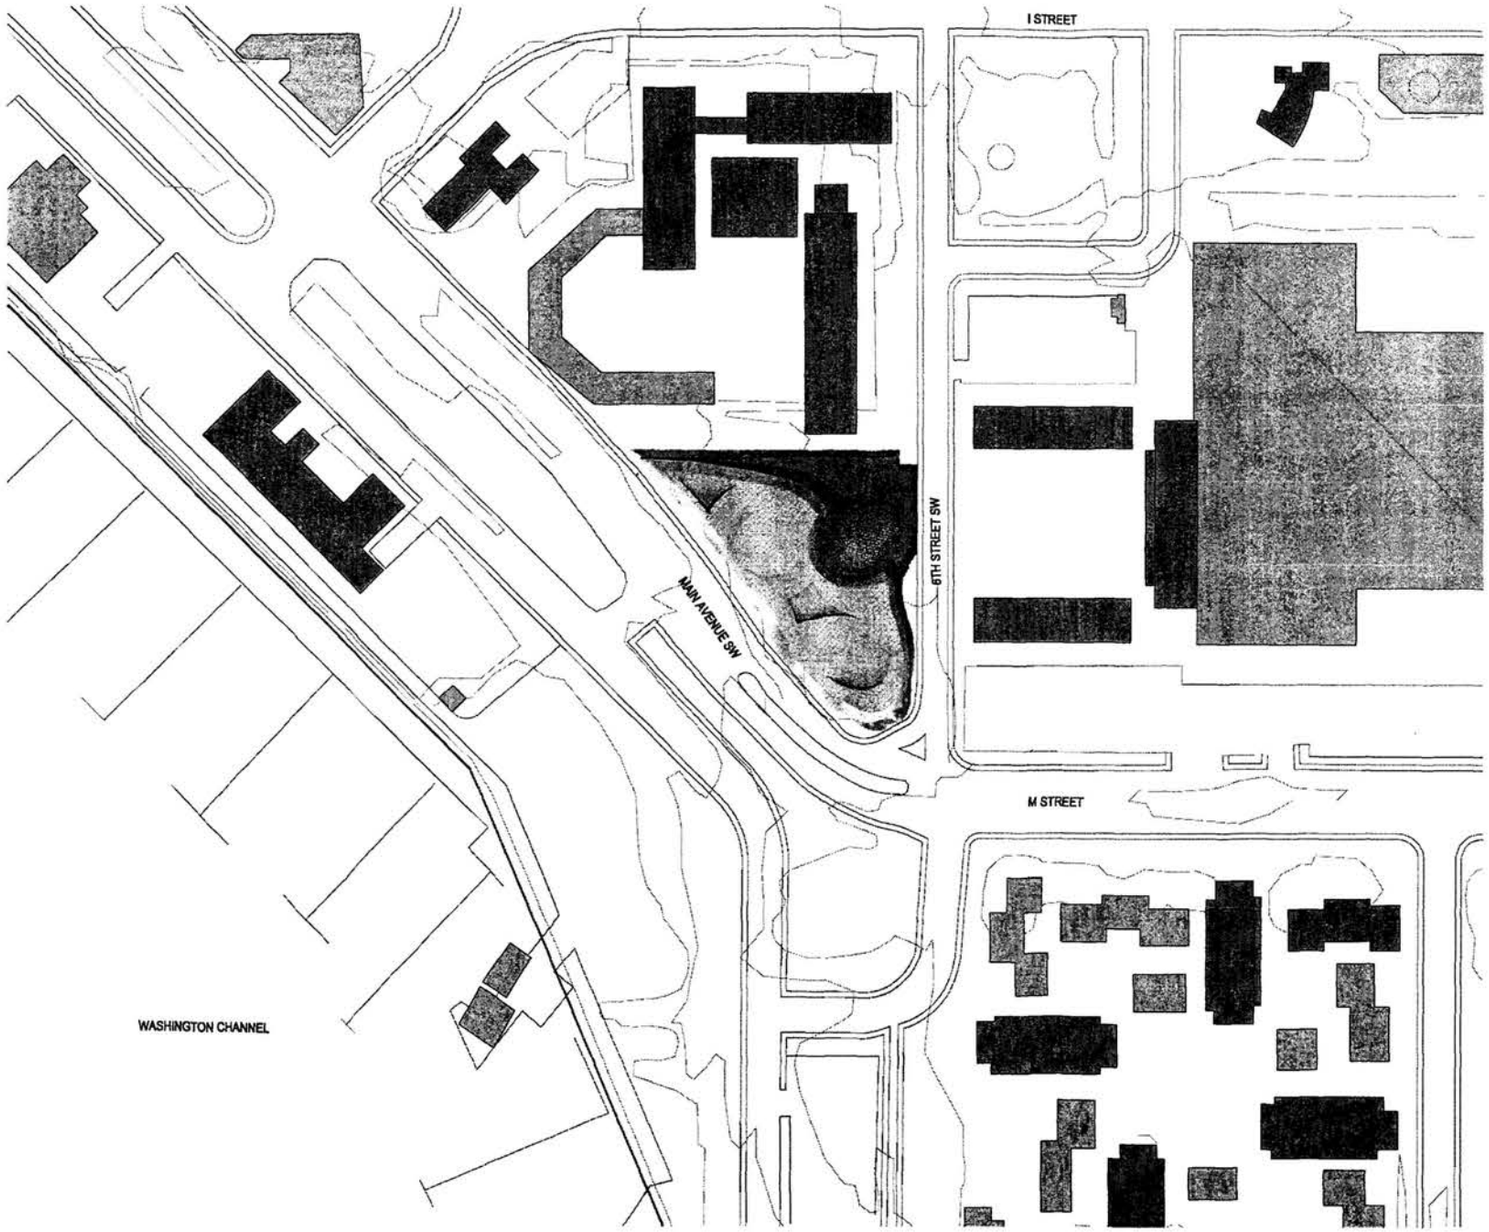

arena stage

KEY

NORTH

NO.	DESCRIPTION	DATE	CHK
2	Issued for rezoning	27-JUN-02	
1	Issued for zoning	06-MAY-02	

REVISIONS

BING THOM ARCHITECTS
1430 Burrard Street Vancouver, BC V6Z 3A3

Xref Drawings :

DRAWN	BY	CHK	BET

SCALE
1/8

DRAWING DATE
27 JUNE 02

ARENA STAGE PROJECT

PROJECT

SITE PLAN


TITLE

PROJECT NUMBER 2017

ISSUE NO.

CADD FILE 2767-A100.dwg

DRAWING NUMBER A100

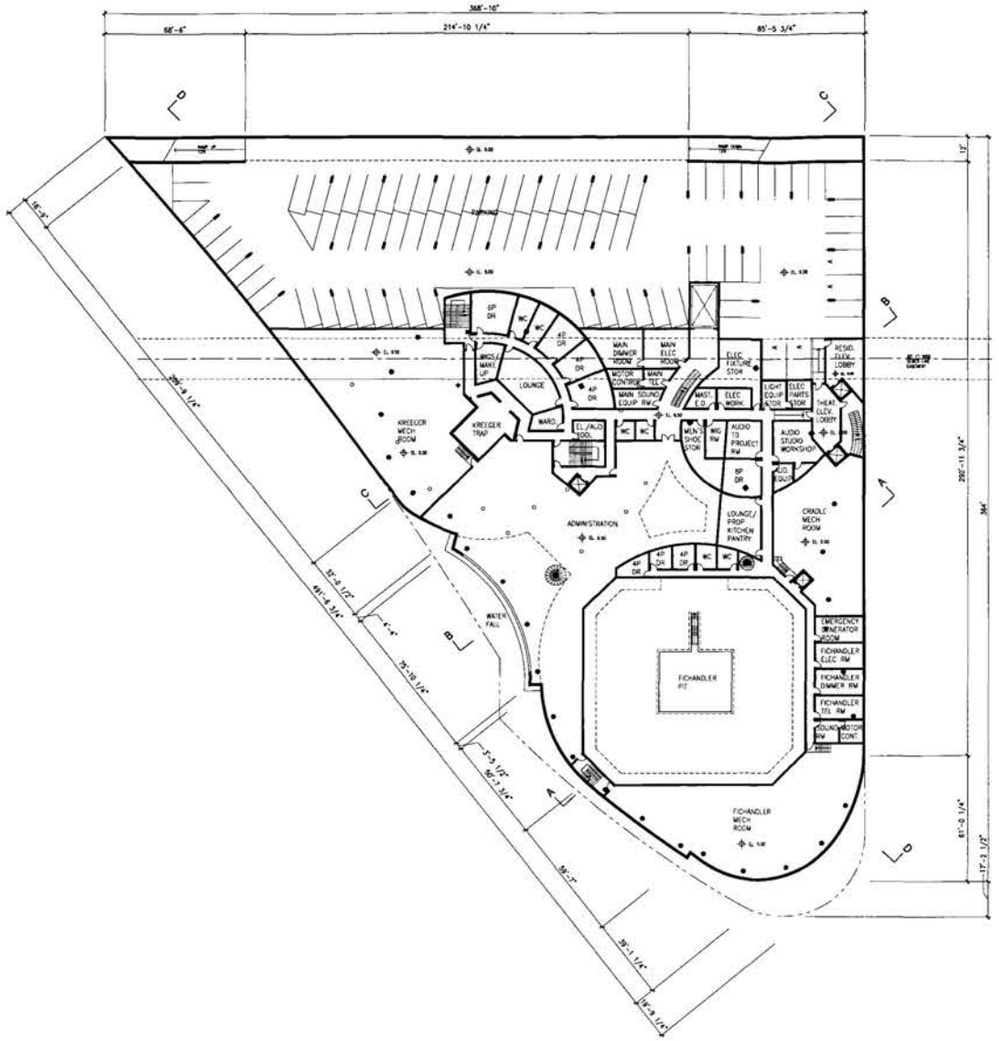

arena stage

KEY

NORTH

NO	DESCRIPTION	DATE	Cnk
2	Issued for revisions	27-JUN-02	
1	Issued for costing	06-MAY-02	

REVISIONS

BING THOM ARCHITECTS
1430 Burrard Street Vancouver, BC V6Z 2A3
T 604-682-1881 F 604-682-1540 E office@bingthom.com W www.bingthom.com

DO NOT SCALE DRAWINGS.
VERIFY ALL DIMENSIONS ON SITE. REPORT ANY DISCREPANCIES TO THE CONSULTANT PRIOR TO CONSTRUCTION.
WORK ONLY FROM DRAWINGS ISSUED FOR CONSTRUCTION. DESTROY DRAWINGS WITH EARLIER REVISION NUMBERS.

© Copyright reserved. This drawing and design is the property of Bing Thom Architects and is not to be reproduced or used in any manner whatsoever without permission.

Xref Drawings

DRAWN	BY	CHK	INT

SCALE 1/64"=1'-0"

DRAWING DATE 27 JUNE 02


ARENA STAGE PROJECT

PROJECT

LEVEL 6.5'

TITLE

PROJECT NUMBER	2017	ISSUE NO.
CADD FILE	2127-A200.dwg	
DRAWING NUMBER	A200	

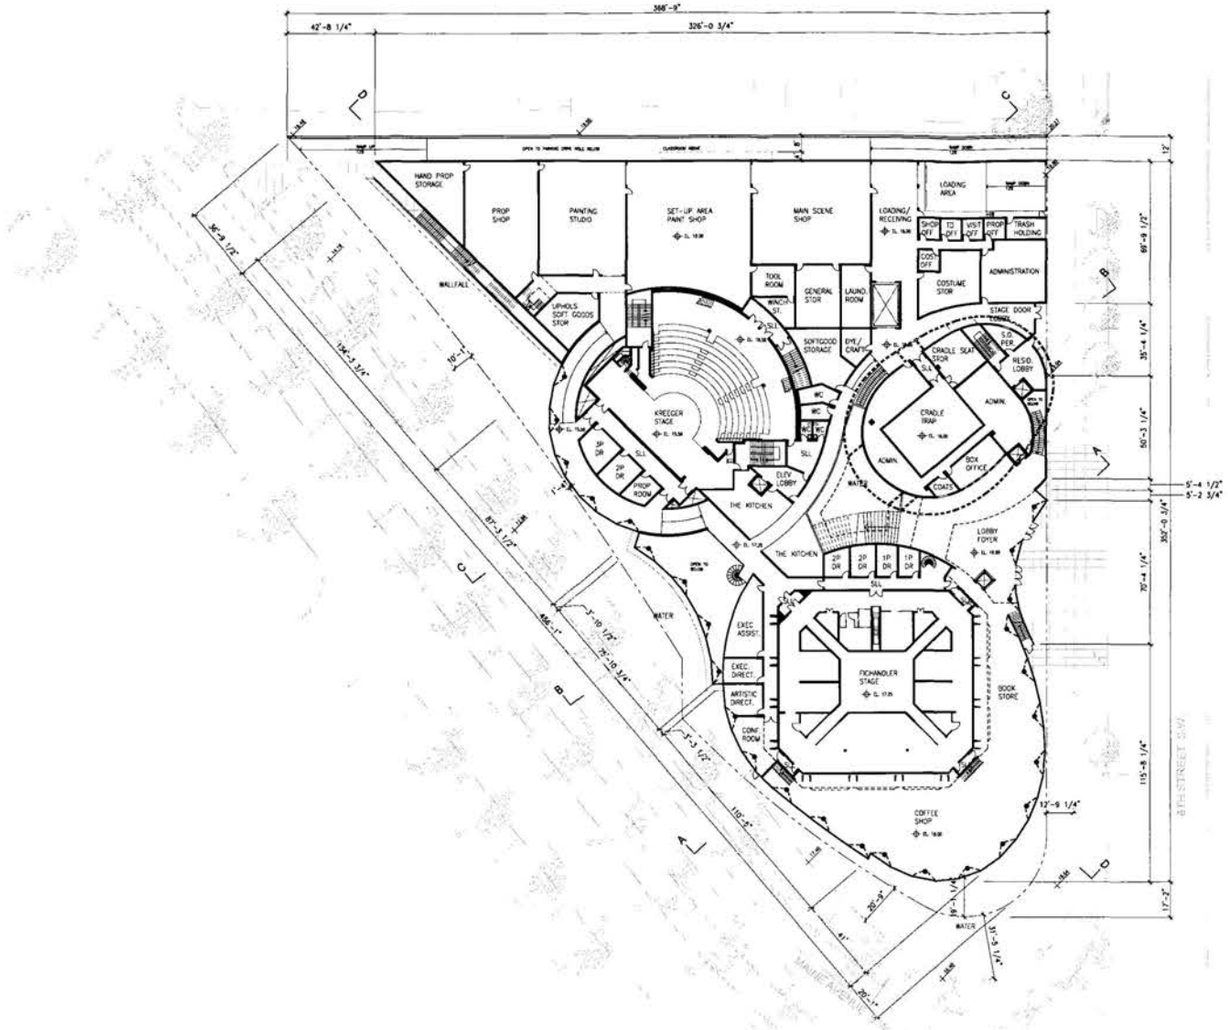

0 5 15 30 60



KEY

NORTH

NO.	DESCRIPTION	DATE	CHK
2	Issued for rezoning	27-JUN-02	
1	Issued for costing	06-MAY-02	

REVISIONS

BING THOM ARCHITECTS
1430 Burrard Street Vancouver, BC V6Z 2A3
T 604-683-1881 F 604-683-1543 E office@bingthom.com W www.bingthom.com

DO NOT SCALE DRAWINGS.
VERIFY ALL DIMENSIONS ON SITE. REPORT ANY DISCREPANCIES TO THE CONSULTANT PRIOR TO CONSTRUCTION.
WORK ONLY FROM DRAWINGS ISSUED FOR CONSTRUCTION. DESTROY DRAWINGS WITH EARLIER REVISION NUMBERS.

© Copyright reserved. This drawing and design is and at all times remains the exclusive property of BING THOM ARCHITECTS Inc and cannot be used without the Architect's written consent.

Xref Drawings :

DRAWN	BY	CHK	INT	SCALE
				1/16"=1'-0"
				DRAWING DATE
				27 JUNE 02


ARENA STAGE PROJECT

PROJECT


LEVEL 18.0'

TITLE

PROJECT NUMBER	2017	ISSUE NO.
CADD FILE	2107-A201.dwg	
DRAWING NUMBER	A201	

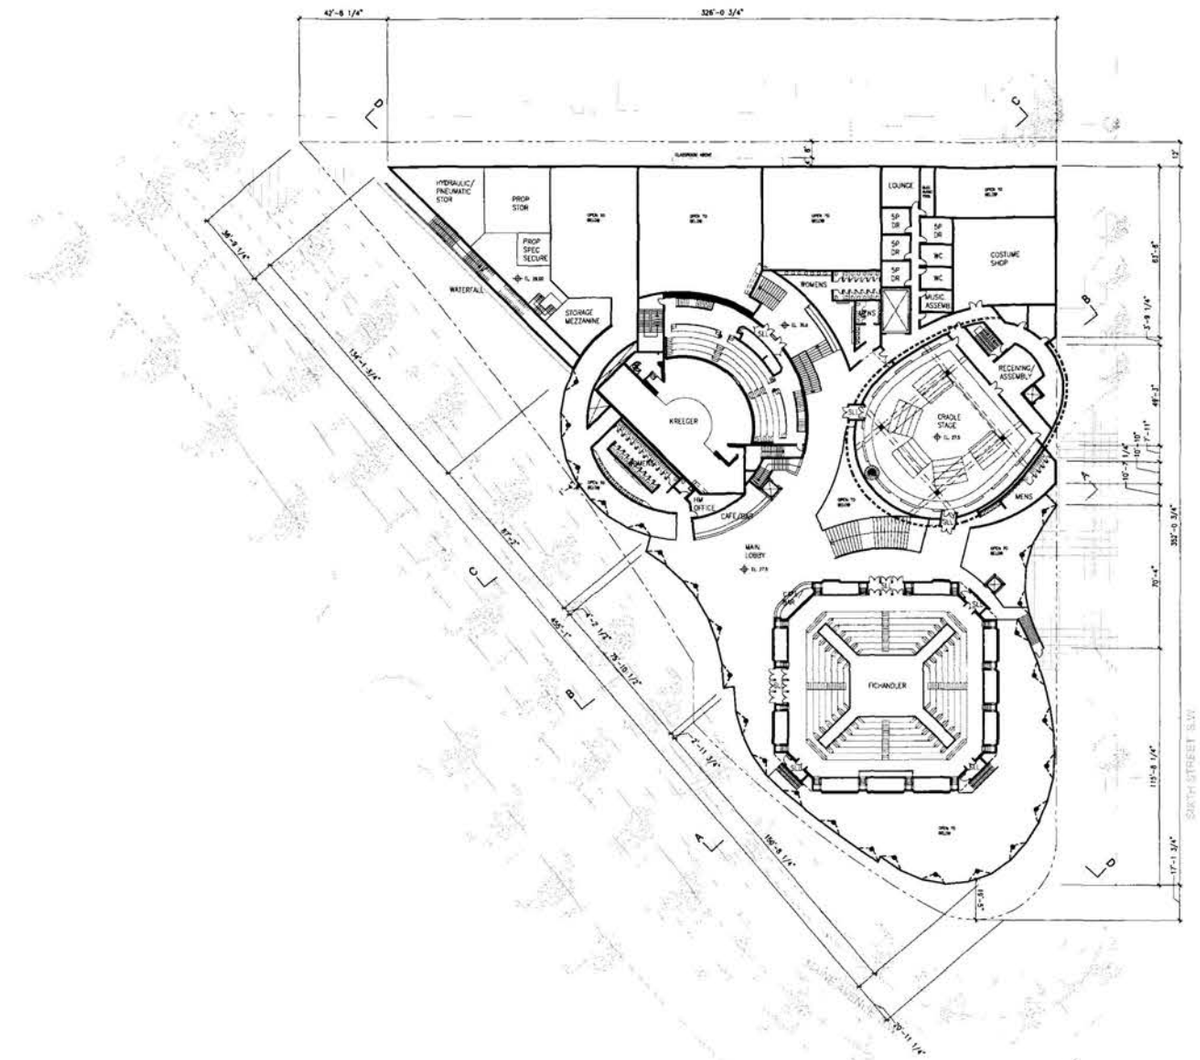

0 5 15 30 60

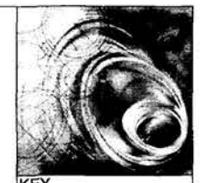

KEY

NORTH

NO	DESCRIPTION	DATE	CHK
2	Issued for rezoning	27-JUN-02	
1	Issued for rezoning	06-MAY-02	

REVISIONS

BING THOM ARCHITECTS

1430 Burrard Street Vancouver, BC V6Z 2A3

DO NOT SCALE DRAWINGS.

VERIFY ALL DIMENSIONS ON SITE. REPORT ANY DISCREPANCIES TO THE CONSULTANT PRIOR TO CONSTRUCTION.

WORK ONLY FROM DRAWINGS ISSUED FOR CONSTRUCTION. DESTROY DRAWINGS WITH EARLIER REVISION NUMBERS.

© Copyright reserved. This drawing and design is the property of BING THOM ARCHITECTS and may not be reproduced or used without the Architect's written consent.

Xref Drawings

DRAWN	BY	CHK	INT	SCALE
				1/64"=1'-0"

DRAWING DATE
27 JUNE 02

ARENA STAGE PROJECT

PROJECT


LEVEL 27.5'

TITLE

PROJECT NUMBER	2017	ISSUE NO.
CADD FILE	2107-A202.dwg	

DRAWING NUMBER

A202

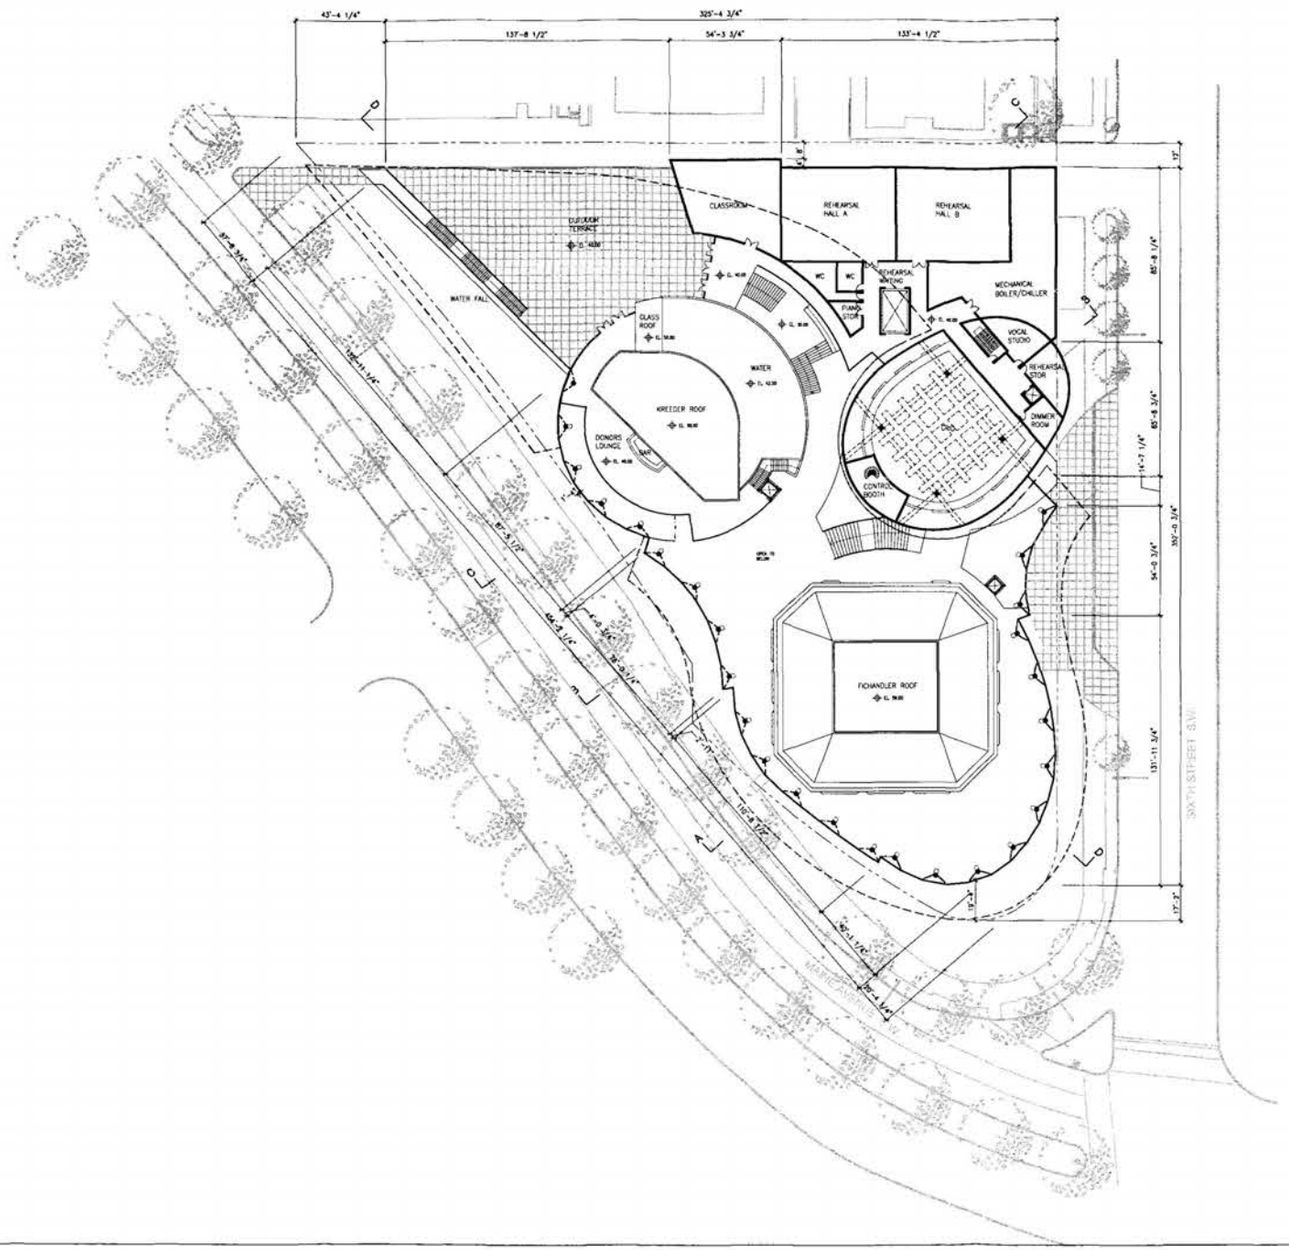



KEY

NORTH

2	issued for rezoning	22-JUN-02
1	issued for costing	06-MAY-02
NO.	DESCRIPTION	DATE CHK

REVISIONS

BING THOM ARCHITECTS

1430 Burrard Street Vancouver, BC V6Z 2A3

T 604-682-1881 F 604-682-1643 E office@bingthom.com W www.bingthom.com

DO NOT SCALE DRAWINGS

VERIFY ALL DIMENSIONS ON SITE. REPORT ANY DISCREPANCIES TO THE CONSULTANT PRIOR TO CONSTRUCTION.

WORK ONLY FROM DRAWINGS ISSUED FOR CONSTRUCTION. EXTERIOR DRAWINGS WITH EARLIER REVISION NUMBERS.

© Copyright reserved. The drawings and designs in and all of these contain the exclusive property of Bing Thom Architects Inc and cannot be used without the Architect's written consent.

Xref Drawings :

DRAWN	BY	CHK	INIT	SCALE
				1/64"=1'-0"
				DRAWING DATE
				22 JUNE 02


ARENA STAGE PROJECT

PROJECT

LEVEL 40.0'

TITLE

PROJECT NUMBER 2017	ISSUE NO.
CADD FILE 2107-A203.dwg	
DRAWING NUMBER	A203

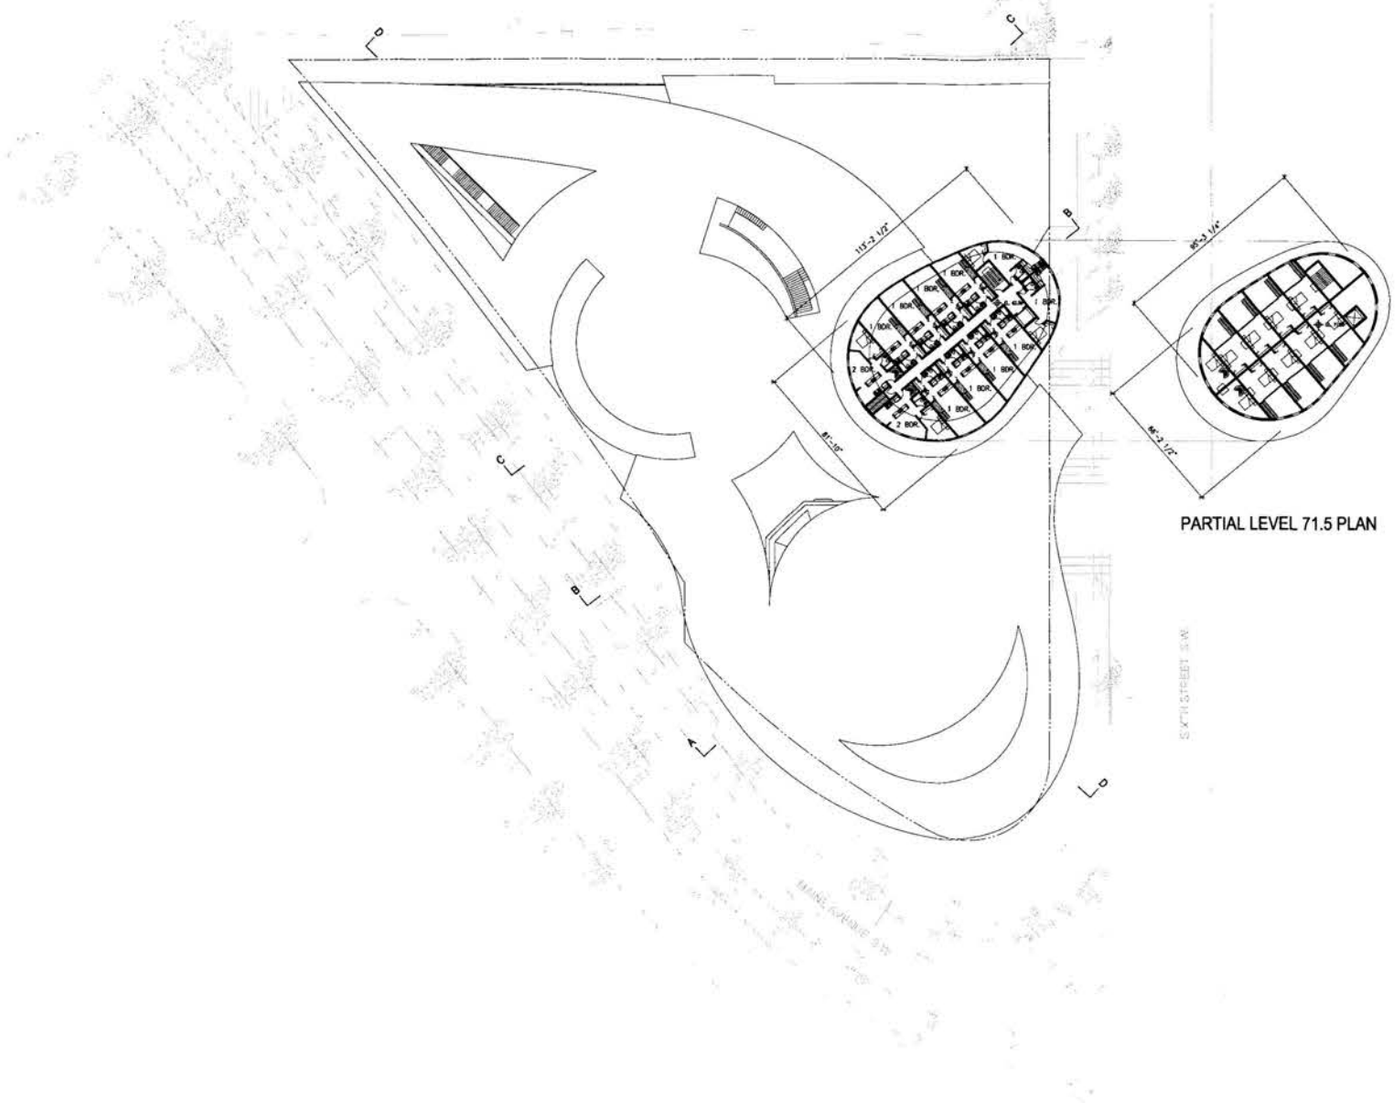

PARTIAL LEVEL 71.5 PLAN

0 5' 15' 30' 60'



KEY

NORTH

NO	DESCRIPTION	DATE	Dwn
2	Issued for rezoning	27-JUN-02	
1	Issued for costing	06-MAY-02	

REVISIONS

BING THOM ARCHITECTS
1430 Burrard Street Vancouver, BC V6Z 2A3
T 604-683-1881 F 604-683-1543 E office@bingthom.com W www.bingthom.com

DO NOT SCALE DRAWINGS.

VERIFY ALL DIMENSIONS ON SITE. REPORT ANY DISCREPANCIES TO THE CONSULTANT PRIOR TO CONSTRUCTION.

WORK ONLY FROM DRAWINGS ISSUED FOR CONSTRUCTION. DESTROY DRAWINGS WITH EARLIER REVISION NUMBERS.

© Copyright reserved. This drawing and design is the property of BING THOM ARCHITECTS and may not be reproduced or used without our written consent.

Xref Drawings :

DRAWN	BY	CHK	INIT	SCALE
				1/64"=1'-0"
				DRAWING DATE
				27 JUNE 02


ARENA STAGE PROJECT

PROJECT

LEVEL 62.5'

TITLE

PROJECT NUMBER	2017	ISSUE NO.
CADD FILE	2107-A205.dwg	
DRAWING NUMBER	A205	

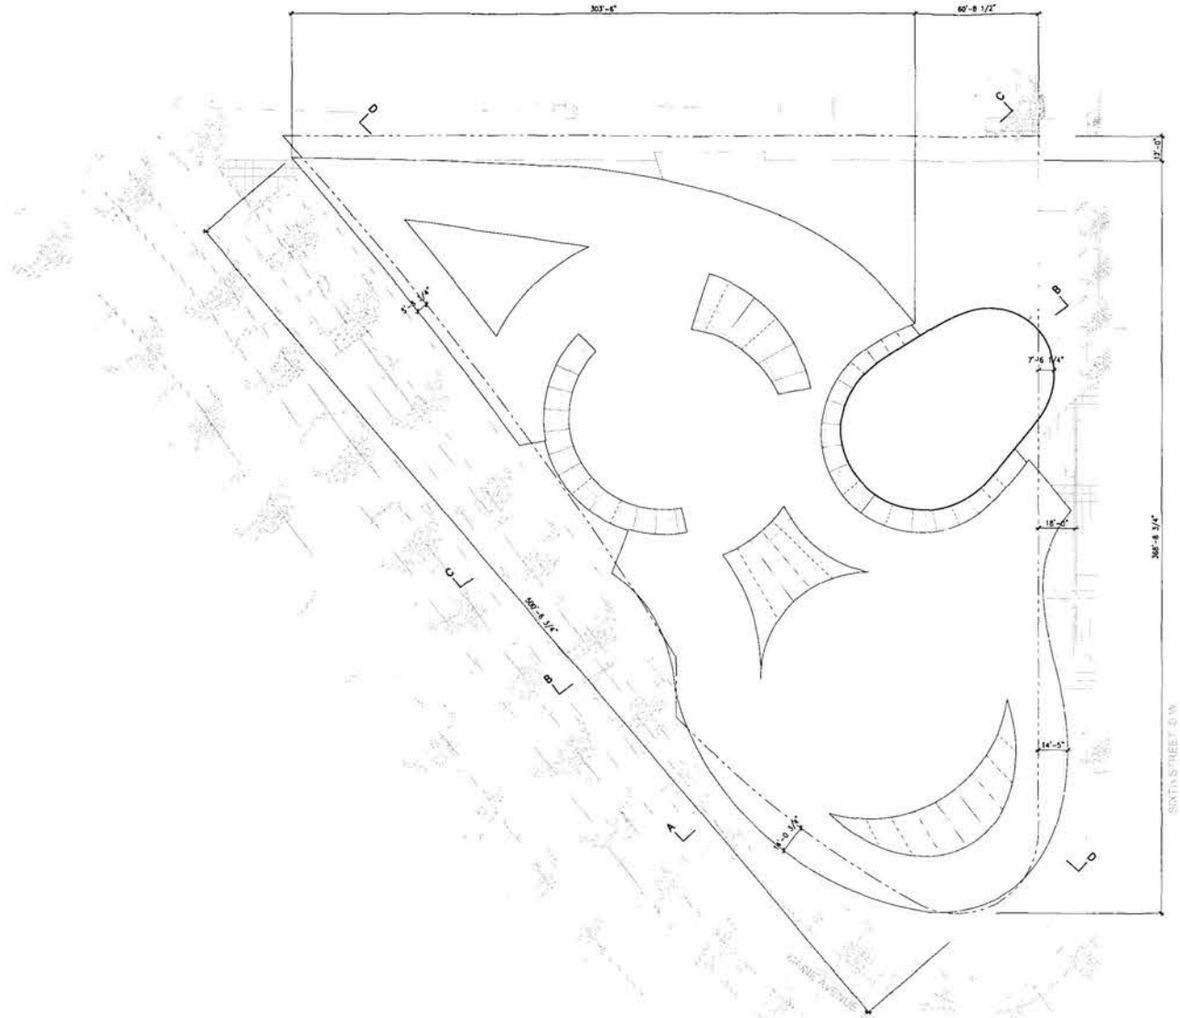

0 5 15 30 60

arena stage

KEY

NORTH

NO.	DESCRIPTION	DATE	CHK
2	issued for rezoning	27-JUN-02	
1	issued for costing	26-MAY-02	

REVISIONS

BING THOM ARCHITECTS
1430 Burrard Street Vancouver, BC V6Z 2A3

DO NOT SCALE DRAWINGS.

VERIFY ALL DIMENSIONS ON SITE. REPORT ANY DISCREPANCIES TO THE CONSULTANT PRIOR TO CONSTRUCTION.

WORK ONLY FROM DRAWINGS ISSUED FOR CONSTRUCTION. SUBMIT DRAWINGS WITH EARLIER REVISION NUMBERS.

© Copyright reserved. The drawing and design is and at all times remains the exclusive property of Bing Thom Architects Inc and cannot be used without the Architect's written consent.

Revit Drawings :

DRAWN	BY	CHK	INIT

SCALE 1/16"=1'-0"

DRAWING DATE 27 JUNE 02

ARENA STAGE PROJECT

PROJECT


ROOF PLAN

TITLE


PROJECT NUMBER 2017 | ISSUE NO.

CADD FILE 2107-A207.dwg


DRAWING NUMBER A205

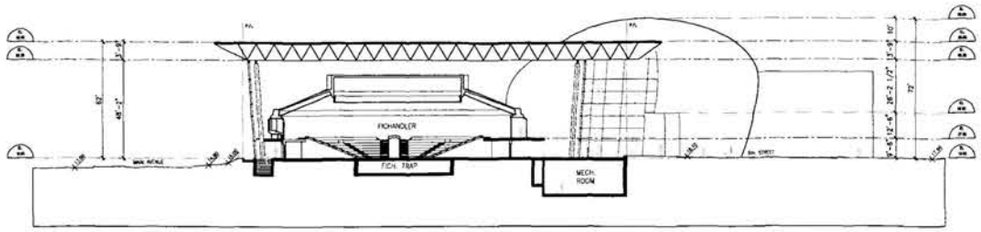


AA A300 Section through Fichandler

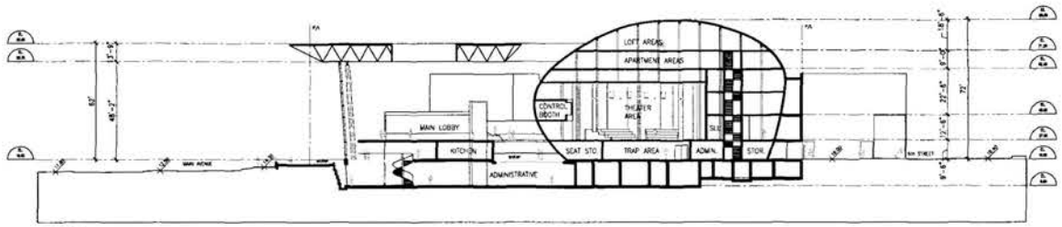

BB A300 Section through Cradle

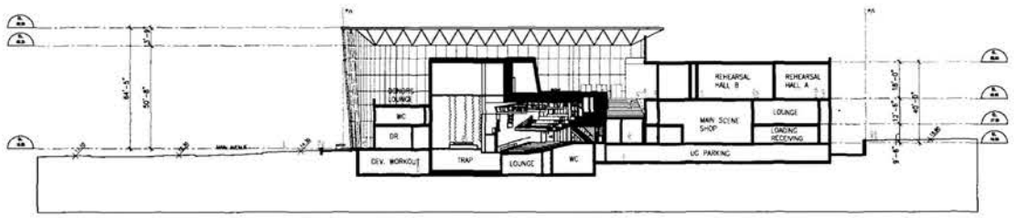

CC A300 Section through Kreeger

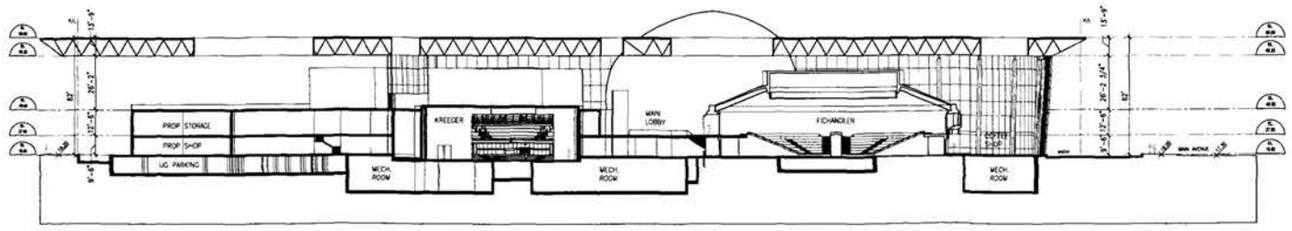


DD A300 Section through Fichandler and Kreeger

0 5 15 30 60



KEY

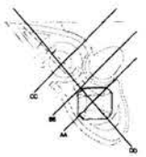

NO.	DESCRIPTION	DATE	CHK
2	Issued for rezoning	27-JUN-02	
1	Issued for costing	06-MAY-02	

REVISIONS

BING THOM ARCHITECTS
1430 Burrard Street Vancouver, BC V6Z 2A3
T 604-683-1881 F 604-683-1912 E info@bingthom.com W arenastage.com

DO NOT SCALE DRAWINGS.
VERIFY ALL DIMENSIONS ON SITE. REPORT ANY DISCREPANCIES TO THE CONSULTANT PRIOR TO CONSTRUCTION.
WORK ONLY FROM DRAWINGS ISSUED FOR CONSTRUCTION. DISTINCT DRAWINGS WITH EARLIER REVISION NUMBERS.
© Copyright reserved. This drawing and design is and at all times remains the exclusive property of BING THOM ARCHITECTS and can not be used or reproduced without permission.

Xref Drawings:

DRAWN	BY	CHK	INT.	SCALE
				1/64"=1'-0"

DRAWING DATE
27 JUNE 02

ARENA STAGE PROJECT

PROJECT


SECTIONS

TITLE


PROJECT NUMBER	ISSUE NO.
2017	
CADD FILE 2101-A300.dwg	

DRAWING NUMBER


A300

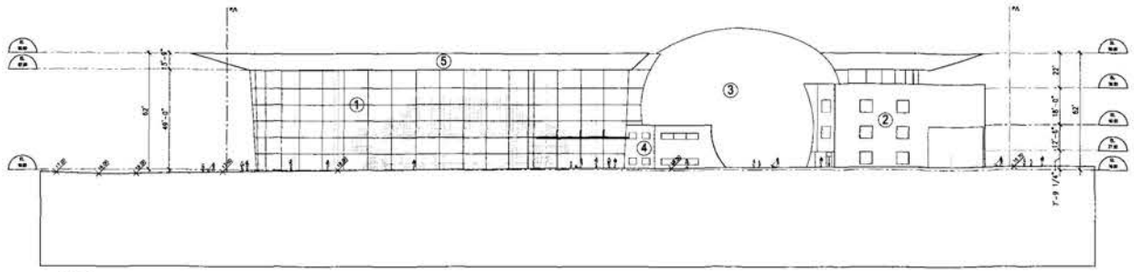

A400/1 SOUTHEAST ELEVATION

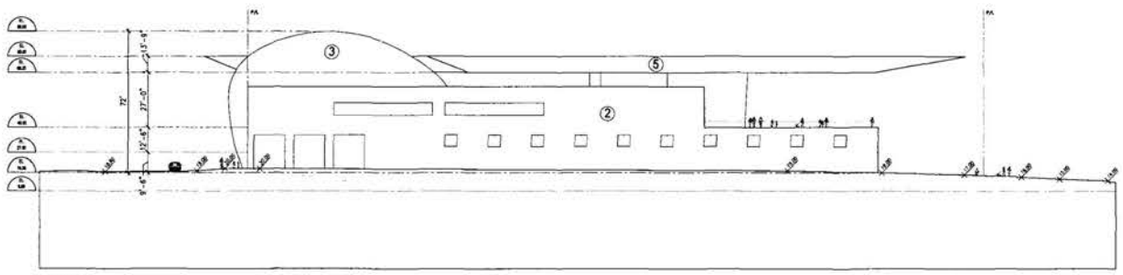

A400/2 WEST ELEVATION

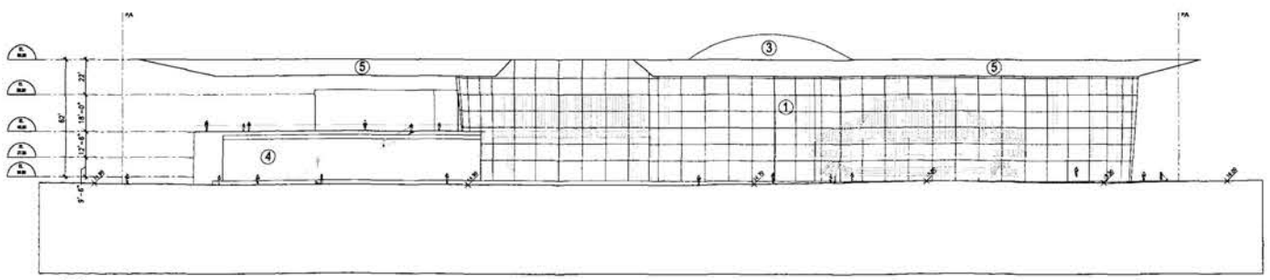

A400/3 NORTH ELEVATION


MATERIALS LEGEND

1. STRUCTURAL GLASS
2. CONCRETE BLOCK WITH ALUMINUM WINDOWS
3. METAL PANEL
4. SANDBLASTED ARCHITECTURAL CONCRETE
5. METAL SOFFIT

0 5 15 30 60



KEY

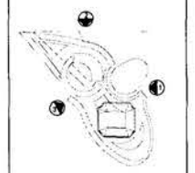

NO.	DESCRIPTION	DATE	CHK
2	Issued for rezoning	27-JUN-02	
1	Issued for rezoning	06-MAY-02	

REVISIONS

BING THOM ARCHITECTS
1430 Burrard Street Vancouver, BC V6Z 2A3

DO NOT SCALE DRAWINGS.

VERIFY ALL DIMENSIONS ON SITE. REPORT ANY DISCREPANCIES TO THE CONSULTANT PRIOR TO CONSTRUCTION.

WORK ONLY FROM DRAWINGS ISSUED FOR CONSTRUCTION. DESTROY DRAWINGS WITH EARLIER REVISION NUMBERS.

© Copyright reserved. This drawing and design is and at all times remains the exclusive property of BING THOM ARCHITECTS and cannot be used without the Architect's written consent.

Xref Drawings :

DRAWN	BY	CHK	PM	SCALE
				1/64"=1'-0"
				DRAWING DATE
				27 JUNE 02

ARENA STAGE PROJECT

PROJECT

ELEVATIONS

TITLE

PROJECT NUMBER	2017	ISSUE NO.
CADD FILE	2017-A400.dwg	

DRAWING NUMBER A400