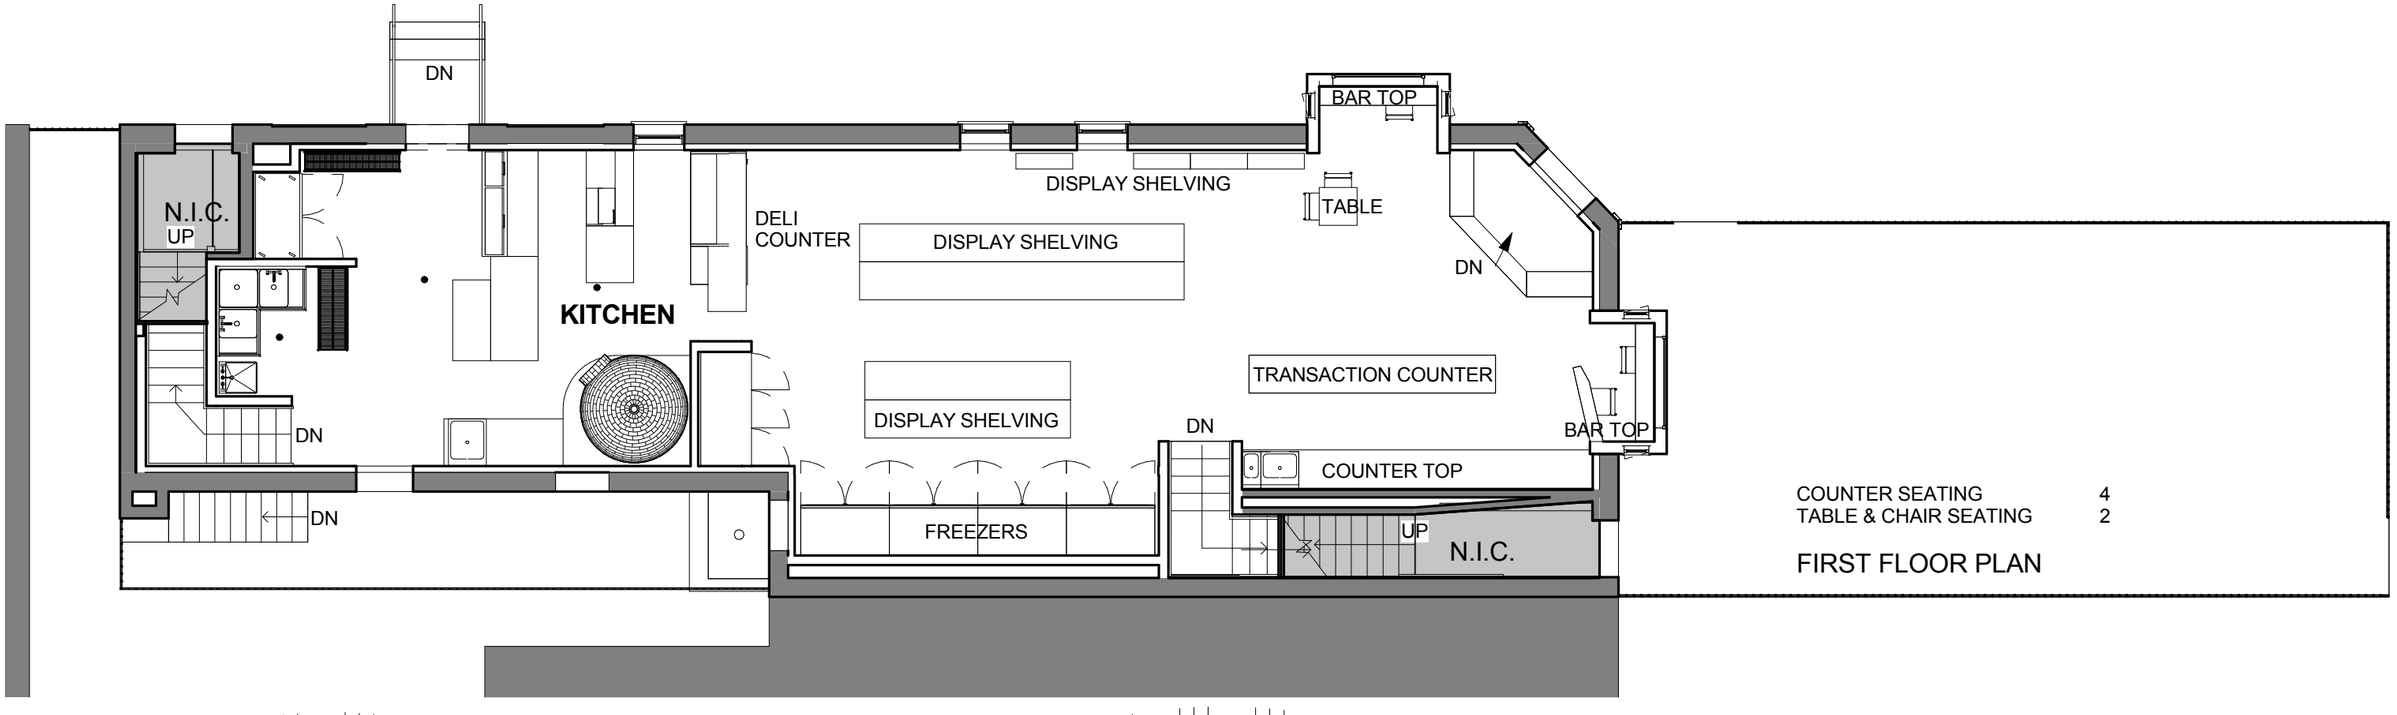

COUNTER SEATING 4
TABLE & CHAIR SEATING 2

FIRST FLOOR PLAN

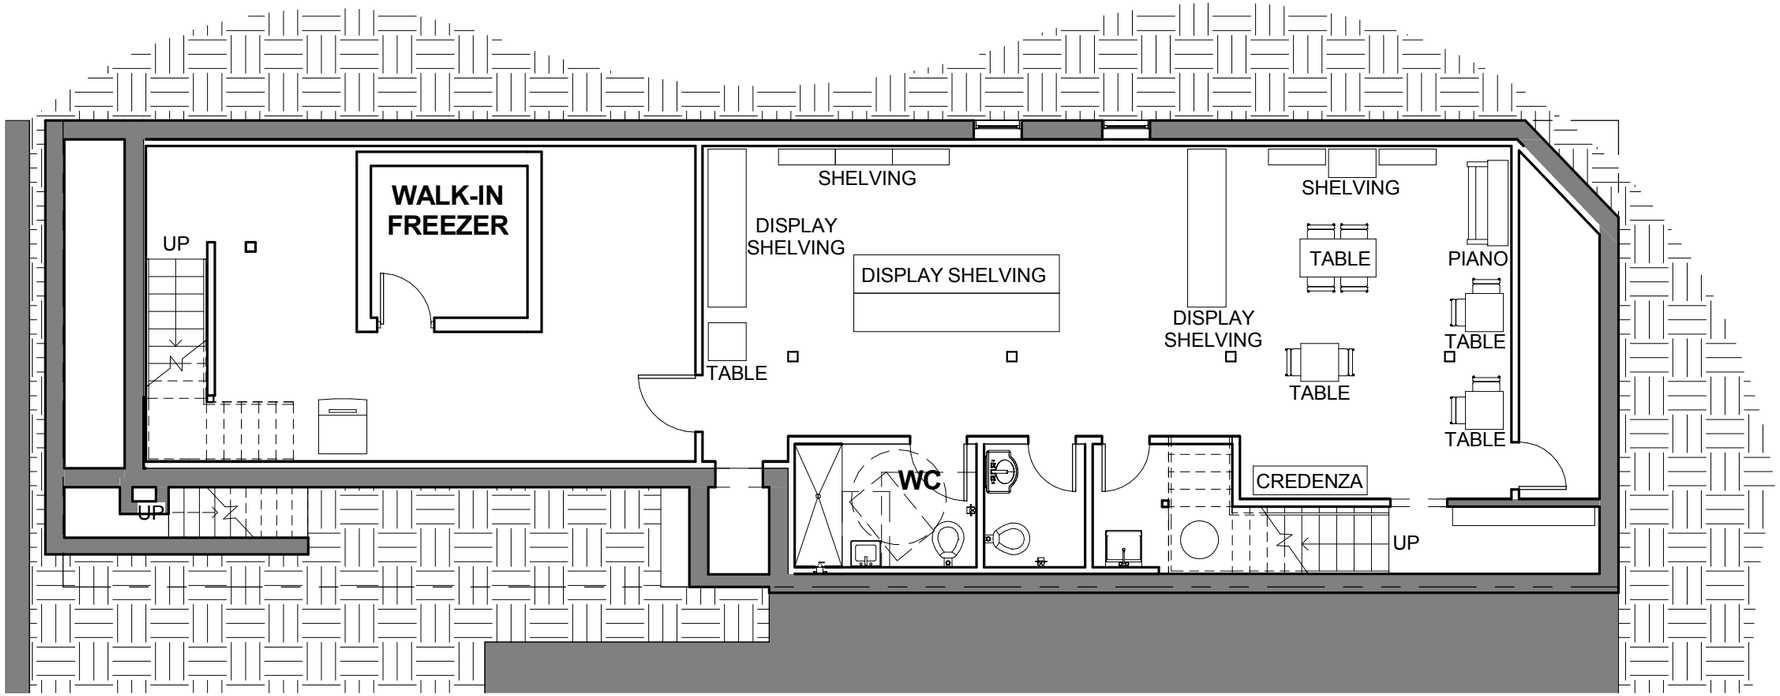

TABLE & CHAIR SEATING 10

LOWER LEVEL PLAN

K STREET MARKET

26 JAN 2017 | AS-BUILT LAYOUT

LOWER LEVER & FIRST FLOOR AS-BUILT PLANS

1/8" = 1'-0"

inscapestudio

Board of Zoning Adjustment
District of Columbia
CASE NO.13991A
EXHIBIT NO.7
© 2014