

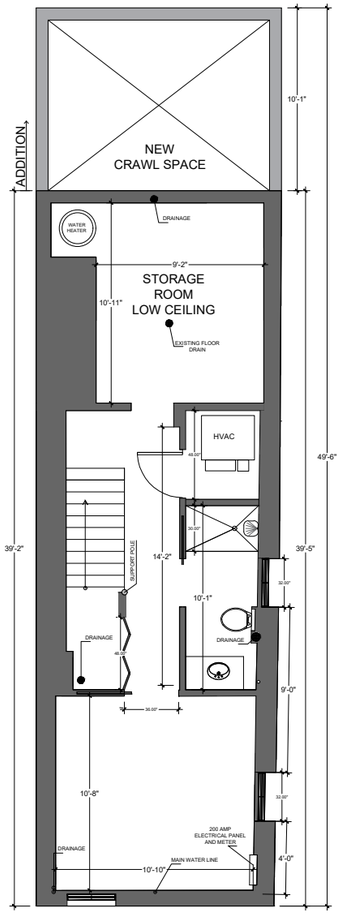



① AS-BUILT BASEMENT

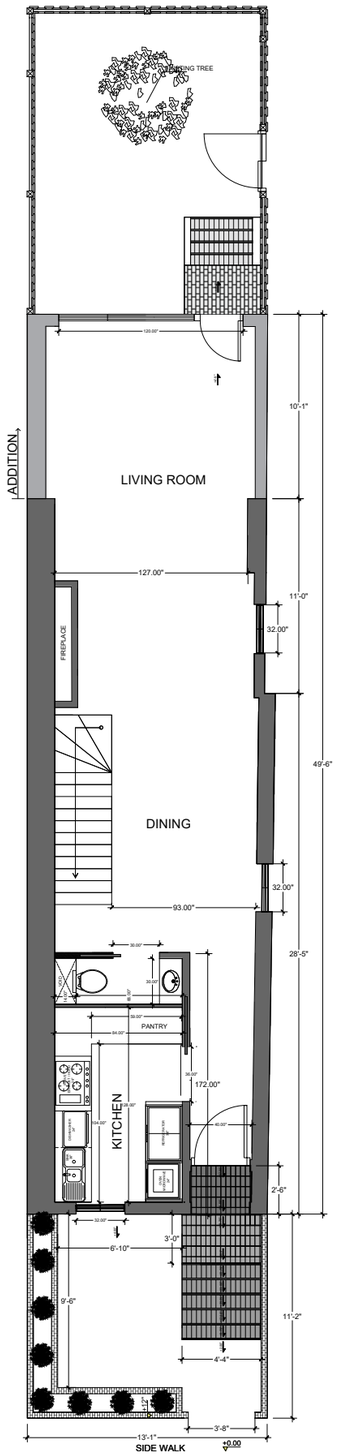

② AS-BUILT MAIN LEVEL

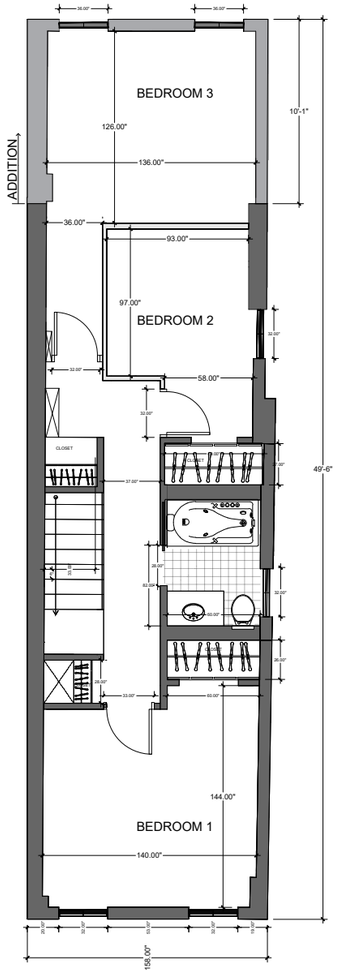

③ AS-BUILT UPPER LEVEL

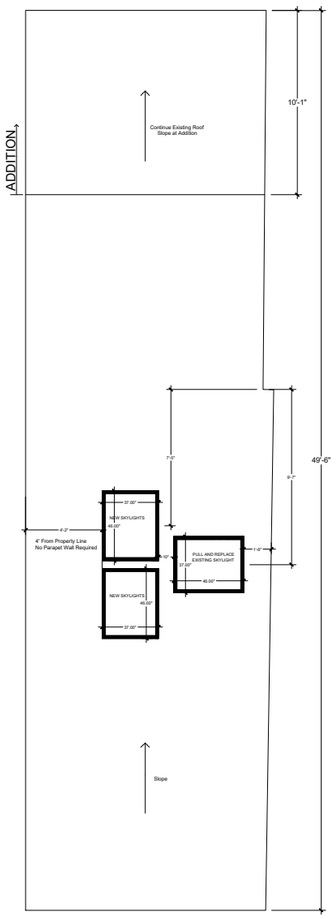

④ AS-BUILT ROOF LEVEL

NOTES:

1. BASED ON ACTUAL SITE MEASUREMENTS

PROJECT:
2413 I St. NW

OWNER
Milu Properties, LLC
2413 I St. NW
Washington, DC 20037

AS BUILT DRAWINGS

Date	09/08/2026
Drawn by	BNG

A203
AS BUILD DRAWINGS

Scale 1/4"=1'-0"

Board of Zoning Adjustment
District of Columbia
CASE NO. 21317A
EXHIBIT NO. 4